




SUPERSEDED SEE AMENDED PLAN (window detail) only

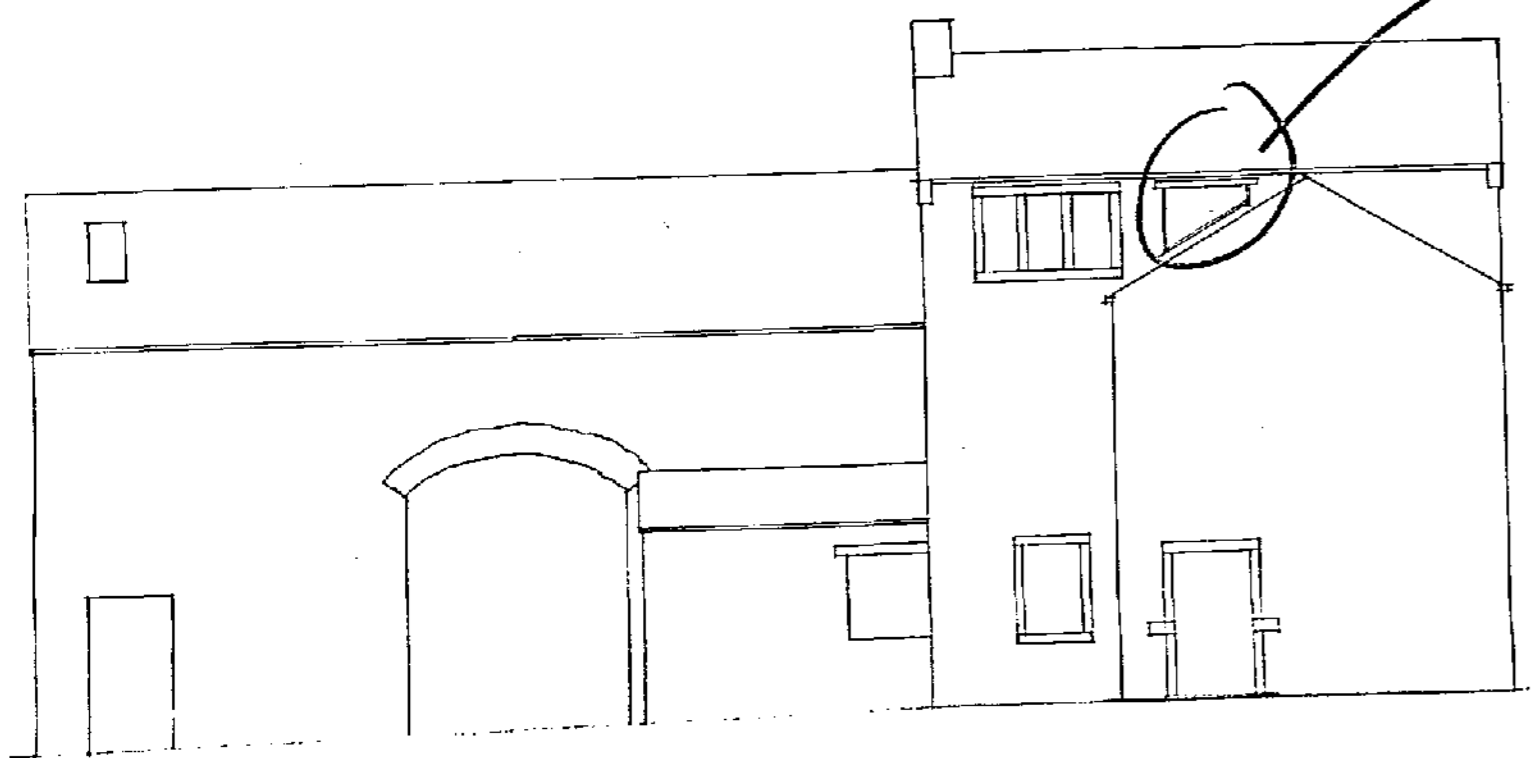


FRONT ELEVATION

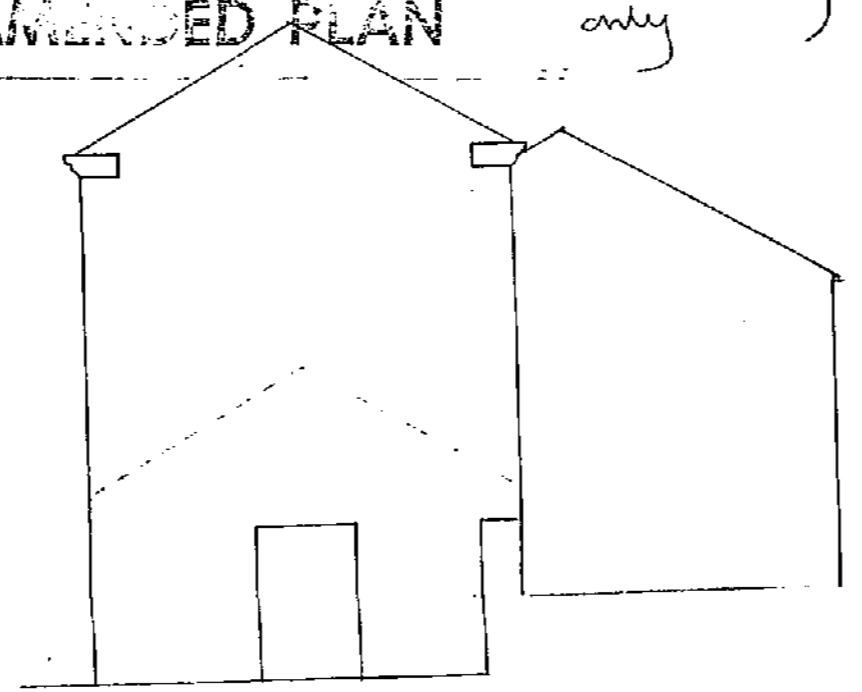

SIDE ELEVATION

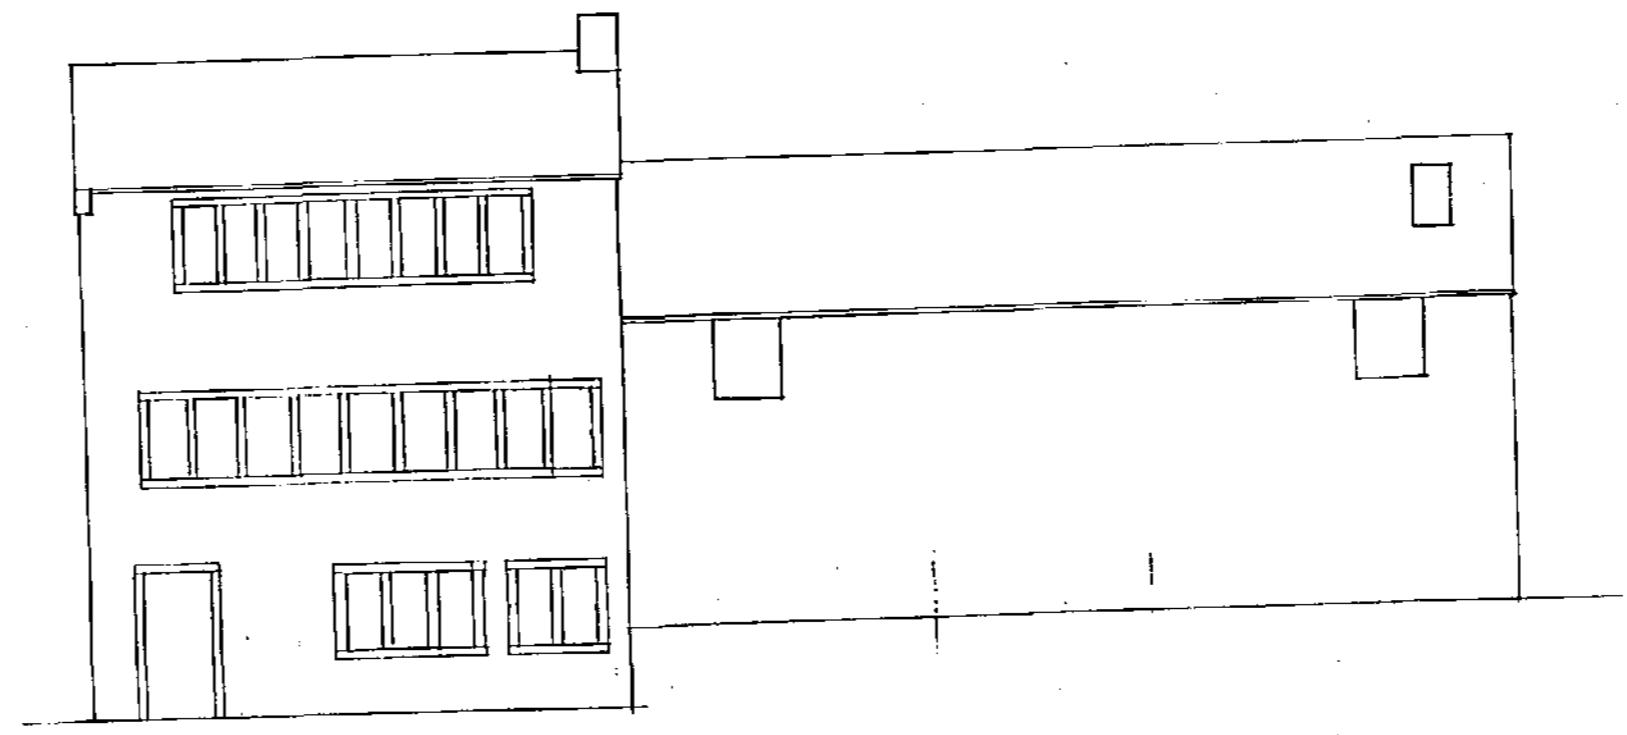


REAR ELEVATION

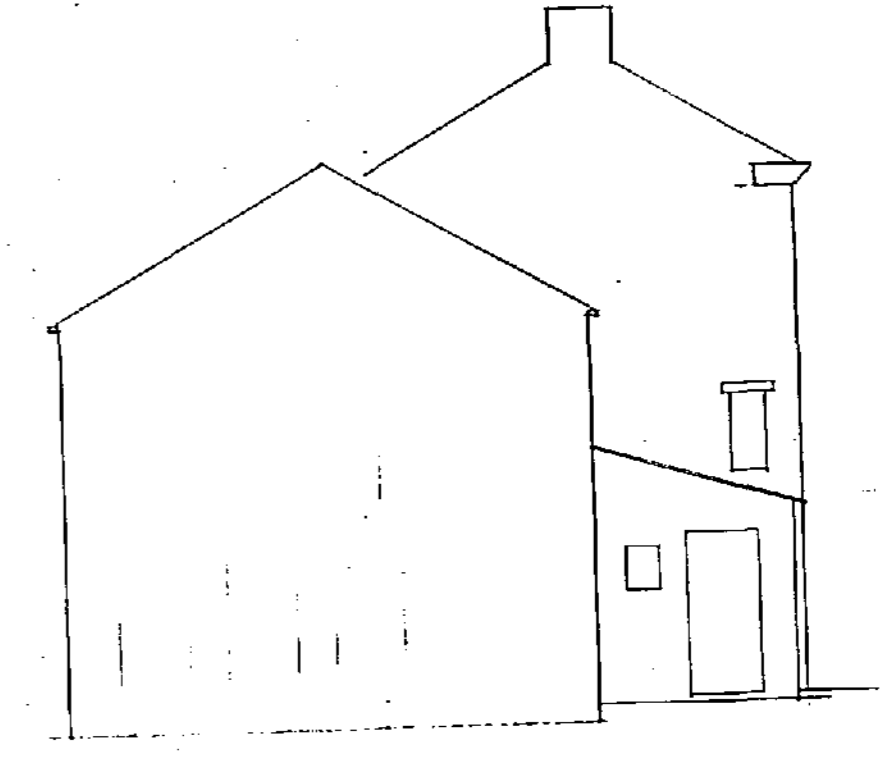

SIDE ELEVATION

KIRKLEES METROPOLITAN COUNCIL
GRANTED
23 JAN 2003
TO BE READ IN CONJUNCTION WITH THE APPLICATION AND SITE STATEMENTS
PLANNING SERVICES

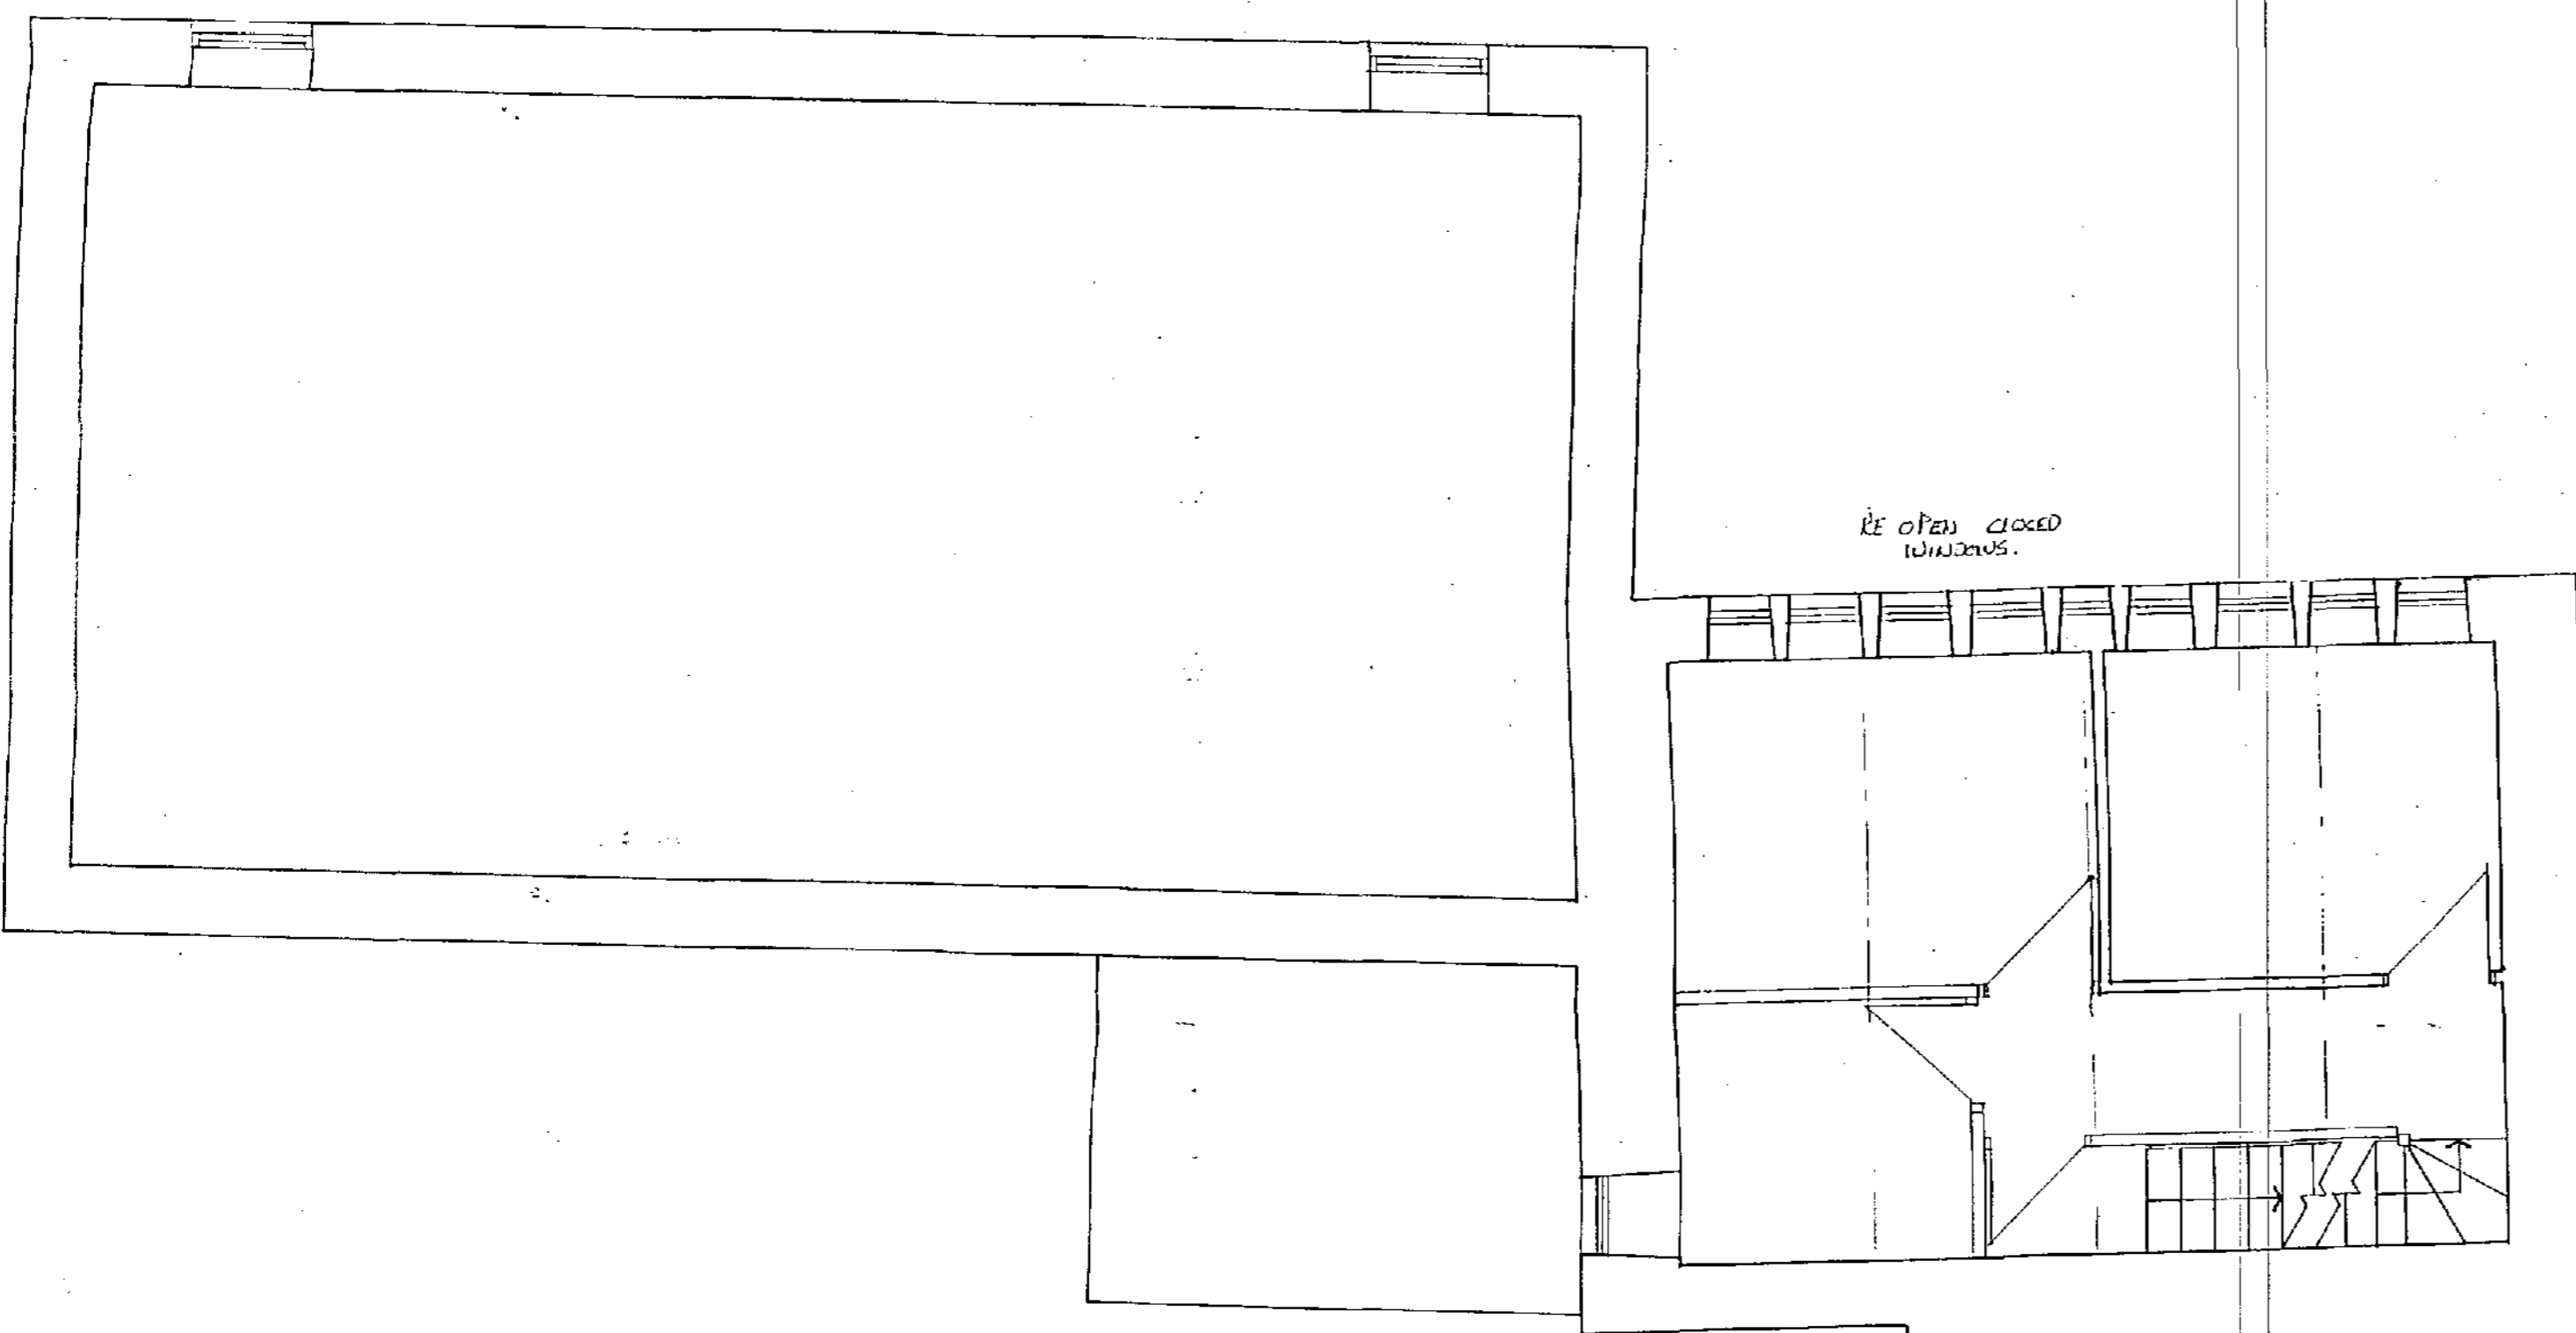


FIRST FLOOR PLAN

RE OPEN CLOSED WINDOWS.

MINOR CHANGES TO INTERNAL STUD WALLS

~~ALTERATIONS TO STAIRCASE TO BRING UP TO CORRECT BUILDING REGS~~
omitted in agreement with applicant 22/1/03 NW

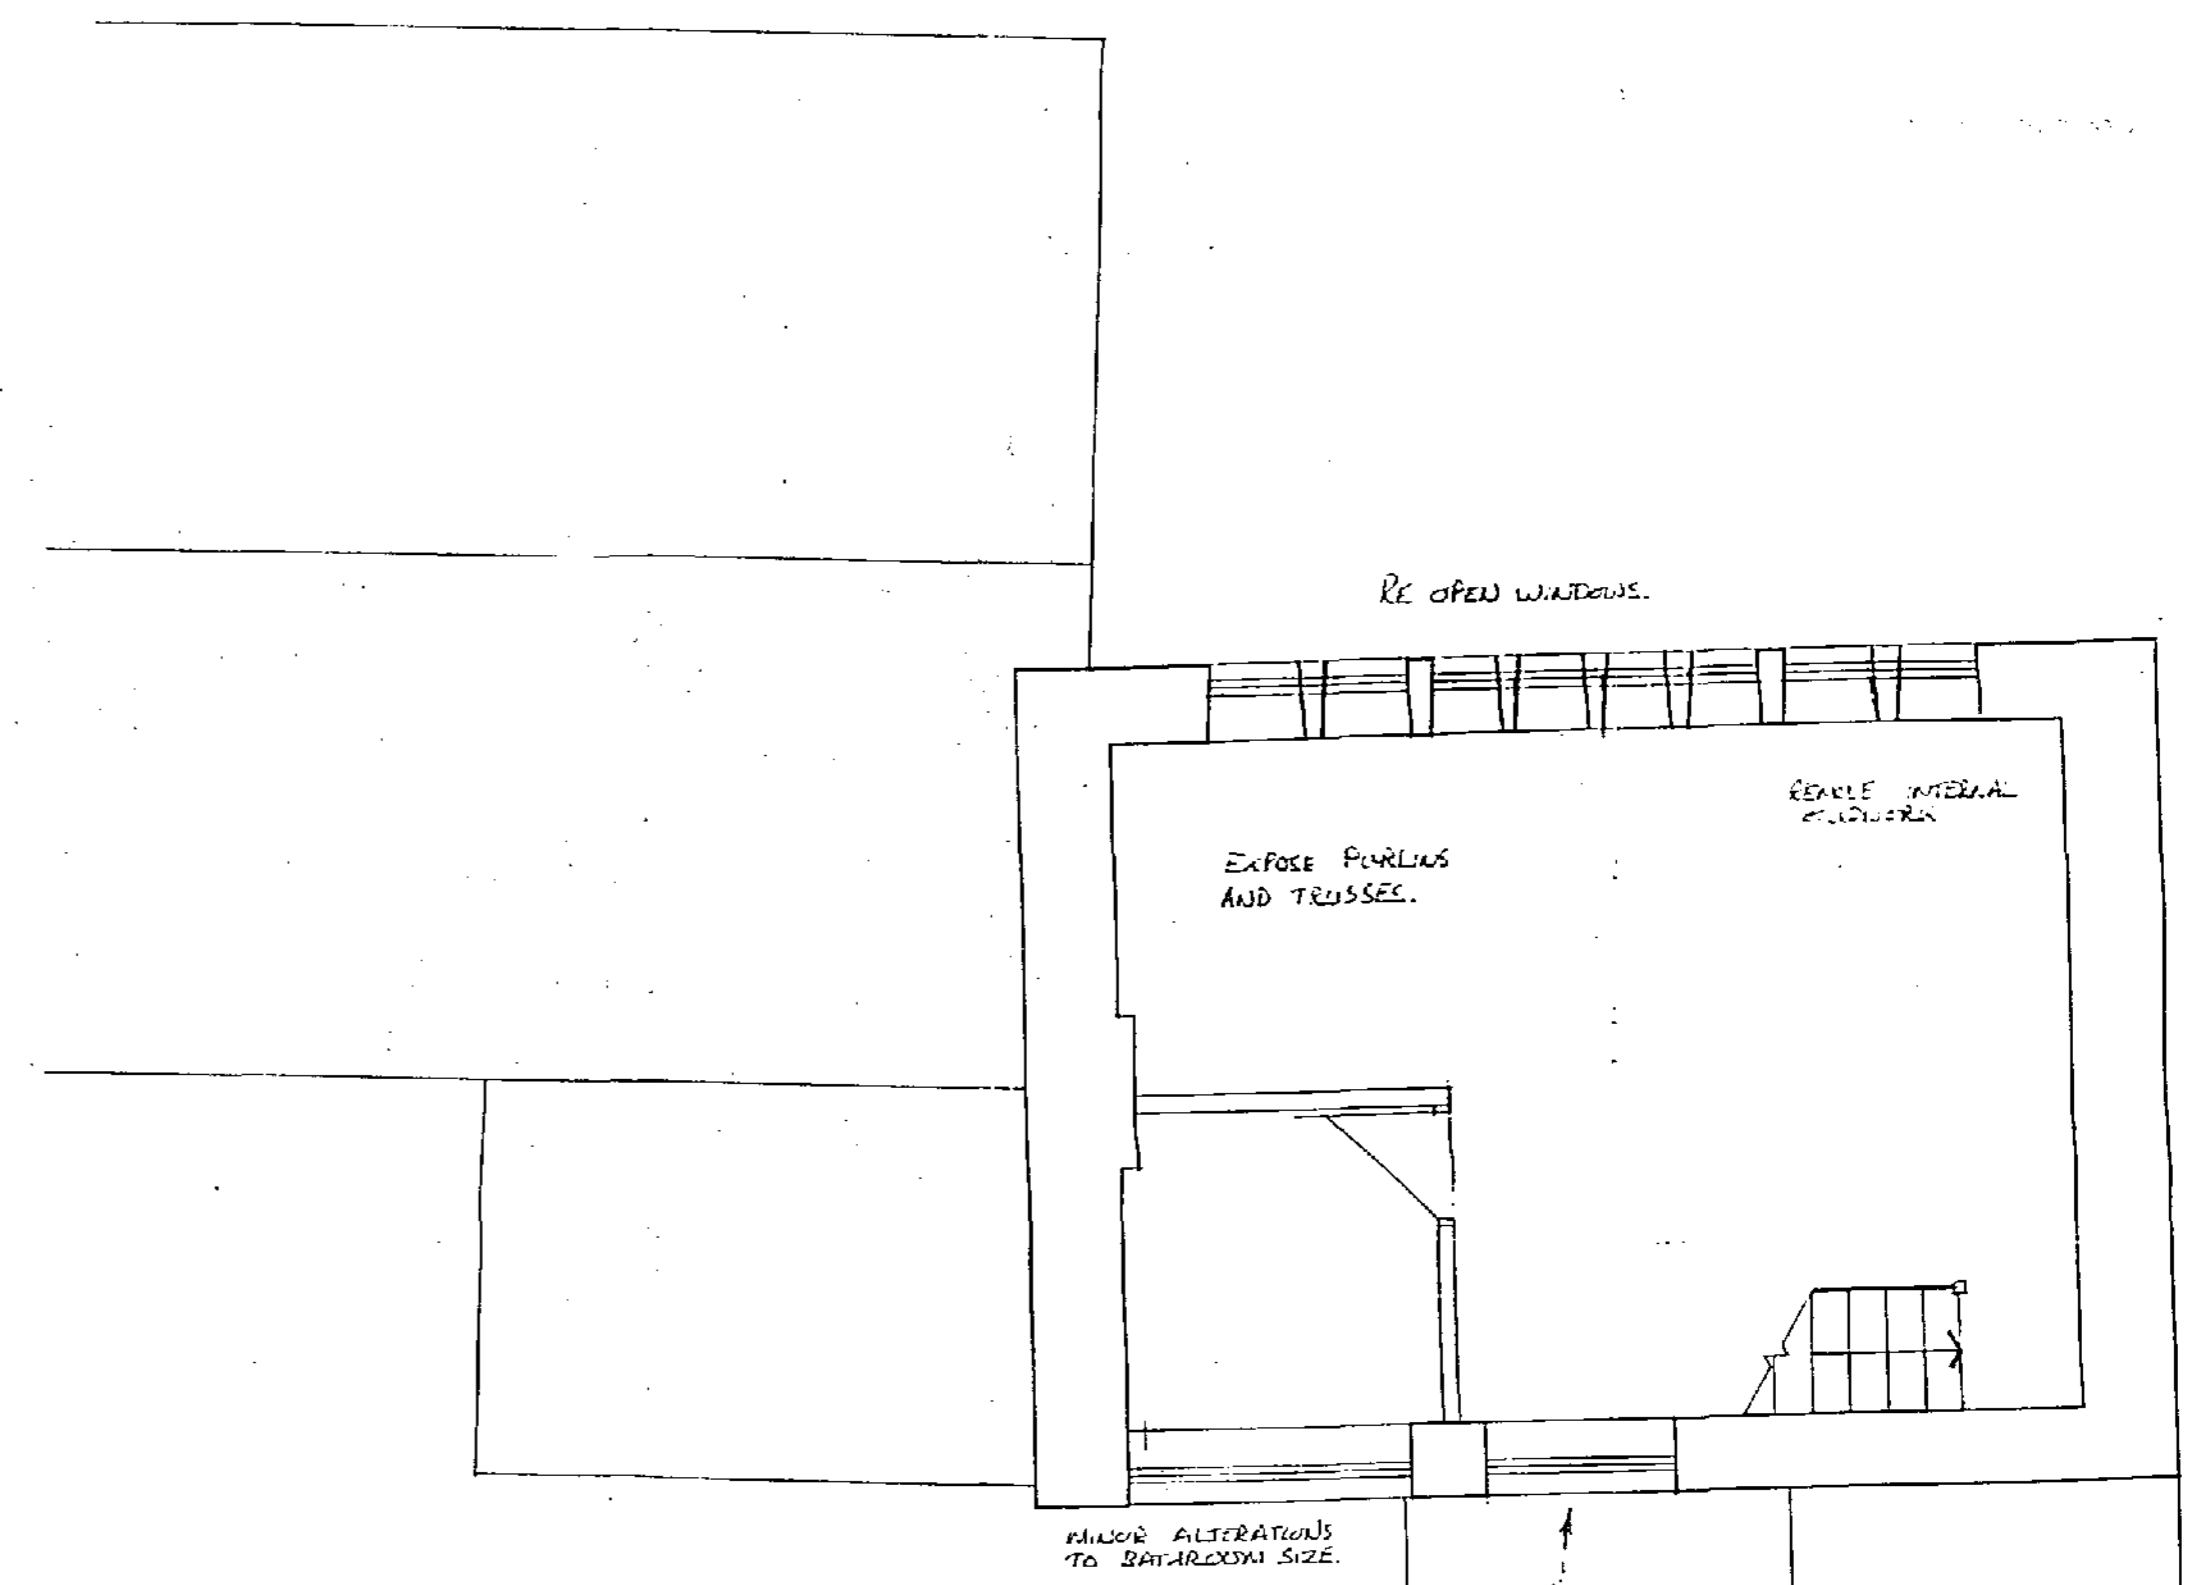

SECOND FLOOR PLAN

RE OPEN WINDOWS.


EXPOSE PURLINS AND TRUSSES.

REMOVE INTERNAL DIVIDERS

MINOR ALTERATIONS TO BAY WINDOW SIZE.

ENLARGE LANDING TO DEPTH TO MAXIMIZE LIGHT.

~~ALTERATIONS TO STAIRCASE TO BRING UP TO CORRECT BUILDING REGS~~
omitted in agreement with applicant 22/1/03

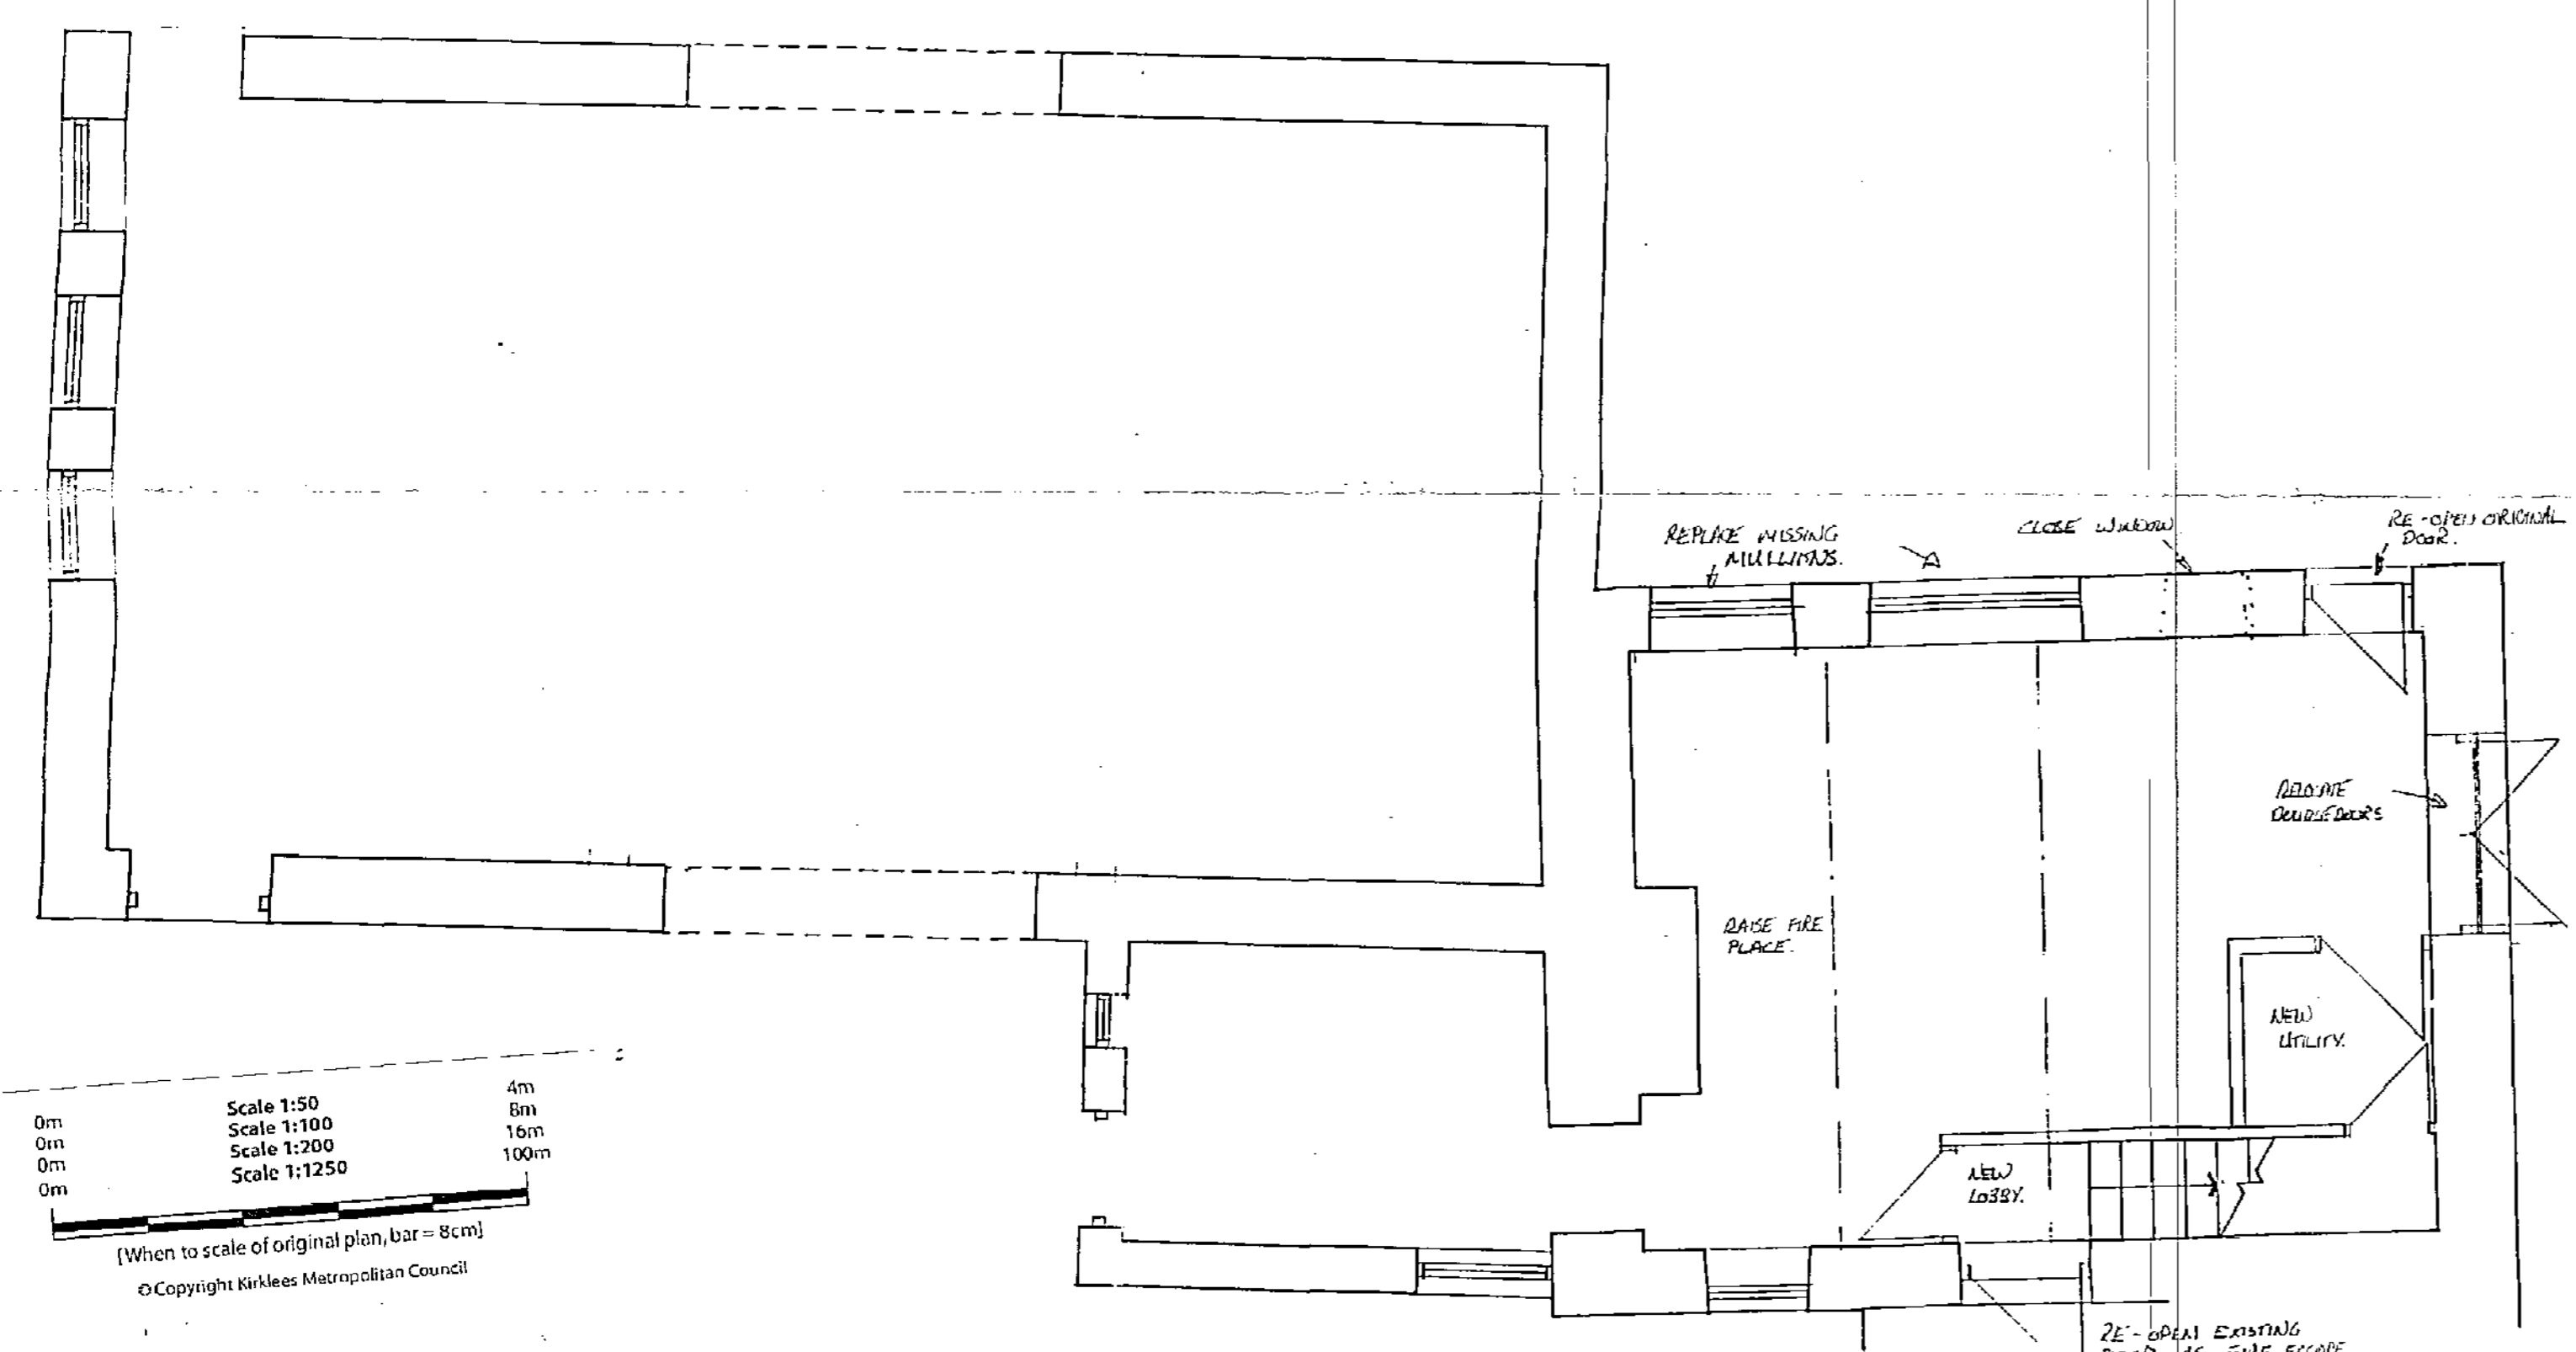

GROUND FLOOR PLAN

REPLACE MISSING PURLINS

CLOSE WINDOW

RE-OPEN ORIGINAL DOOR

REMOVE DOWNSTAIRS

BASE FIRE PLACE

NEW DRAIN

NEW LADDER

RE-OPEN EXISTING DOOR AS FIRE ESCAPE

Scale 1:50
Scale 1:100
Scale 1:200
Scale 1:1250
0m 4m
0m 8m
0m 16m
0m 100m
(When to scale of original plan, bar = 8cm)
© Copyright Kirklees Metropolitan Council

DESCRIPTION:
~~AS PER PREVIOUS~~
ALTERATIONS TO
LYDGATE FARM COTTAGE,
27 OUTLINE, NETHERTHONG,
HOLMFIRTH,
HD9 3EQ
CLIENT:
MR & MRS BARRACLOUGH
DWG: 542_02
SCALE: 1:50, 1:100, 1:200, 1:1250
DATE: 02/1/02
Mr. Greg Cross
Ash Grove House,
1 Summerville, Holmfirth,
HD9 7AG
Tel: 01484 686412
Mob: 07971 834366
This drawing together with the design it illustrates,
is copyright and may not be reproduced without
written consent.
Do not scale off this drawing - use only written dimensions