
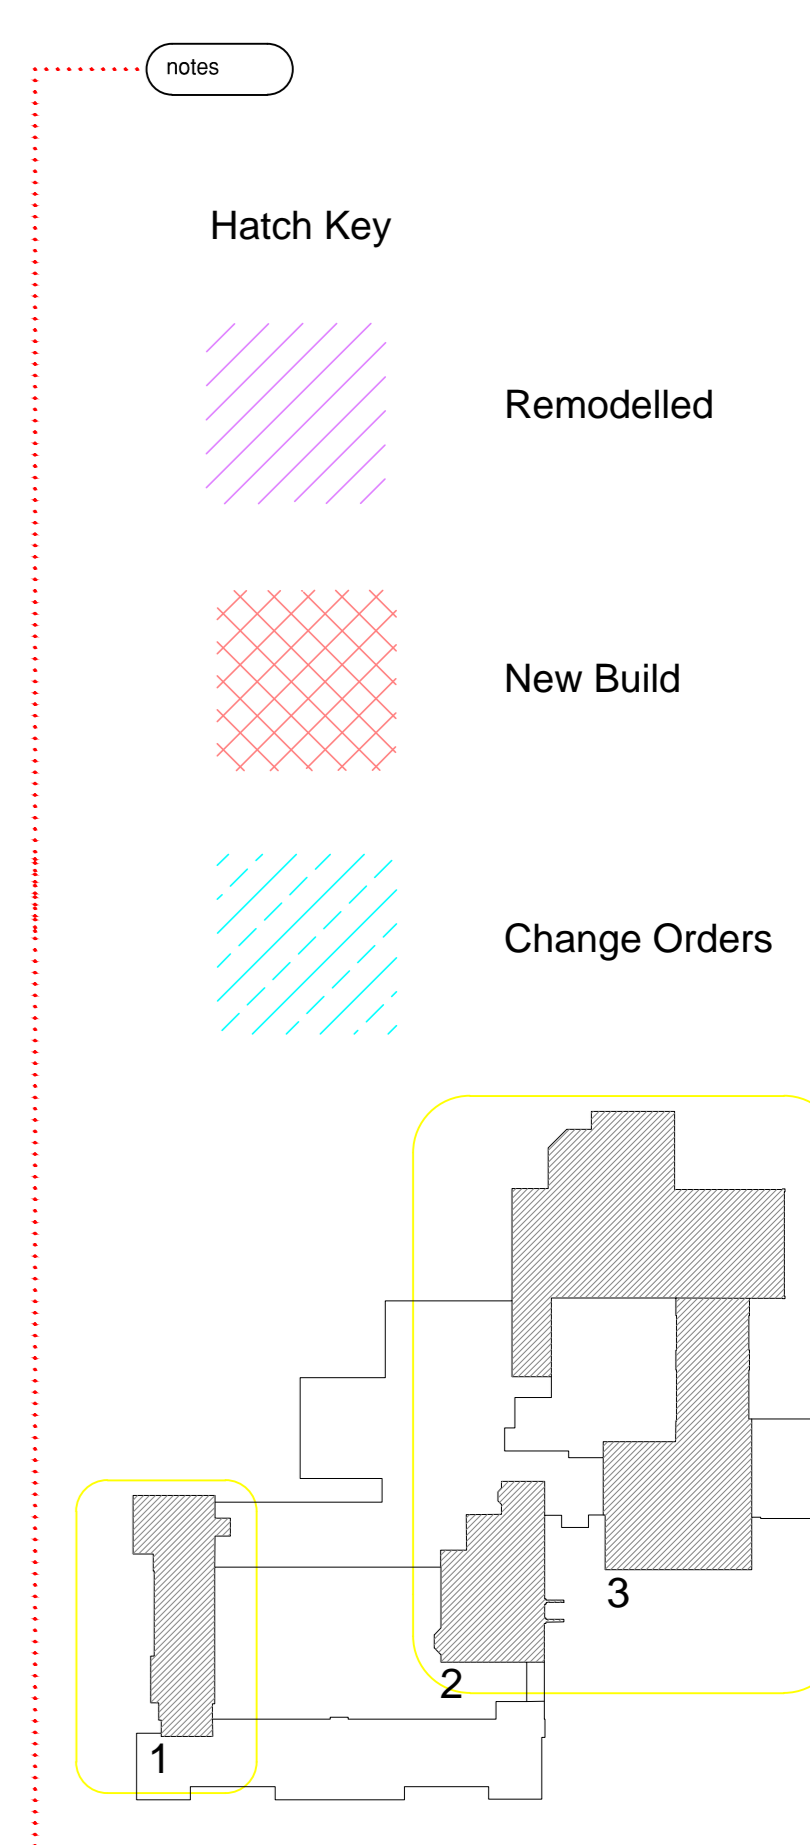
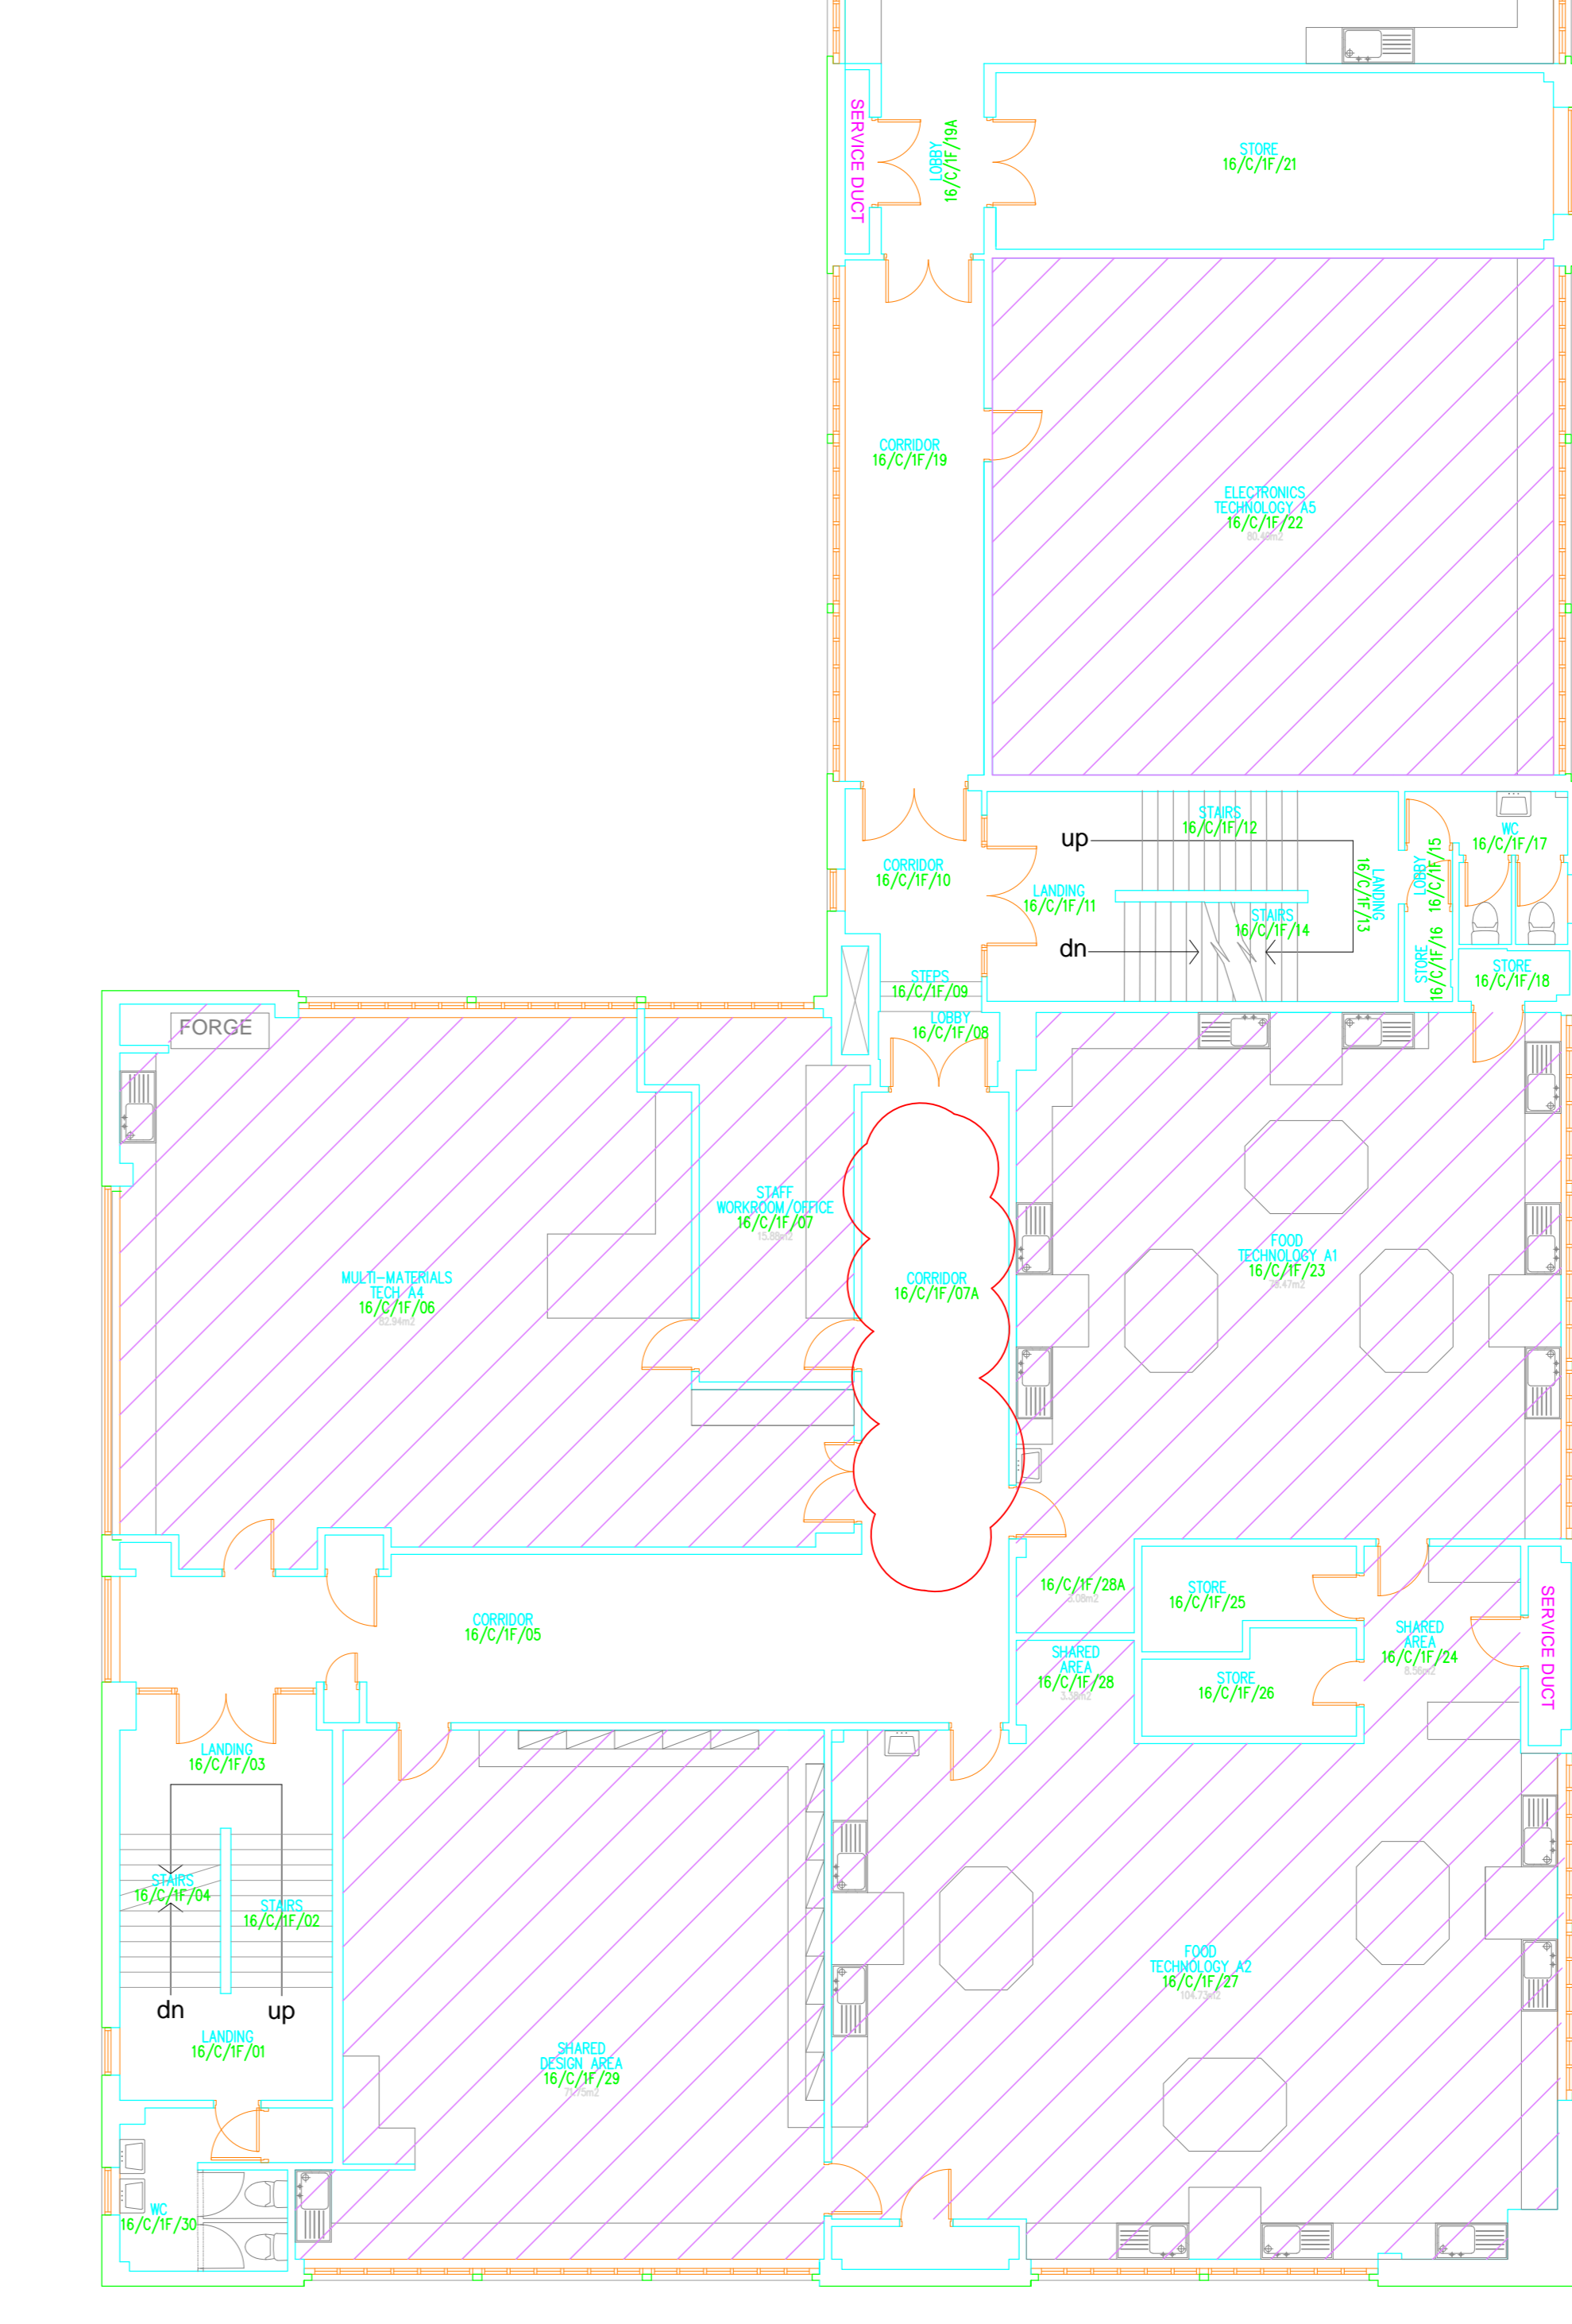
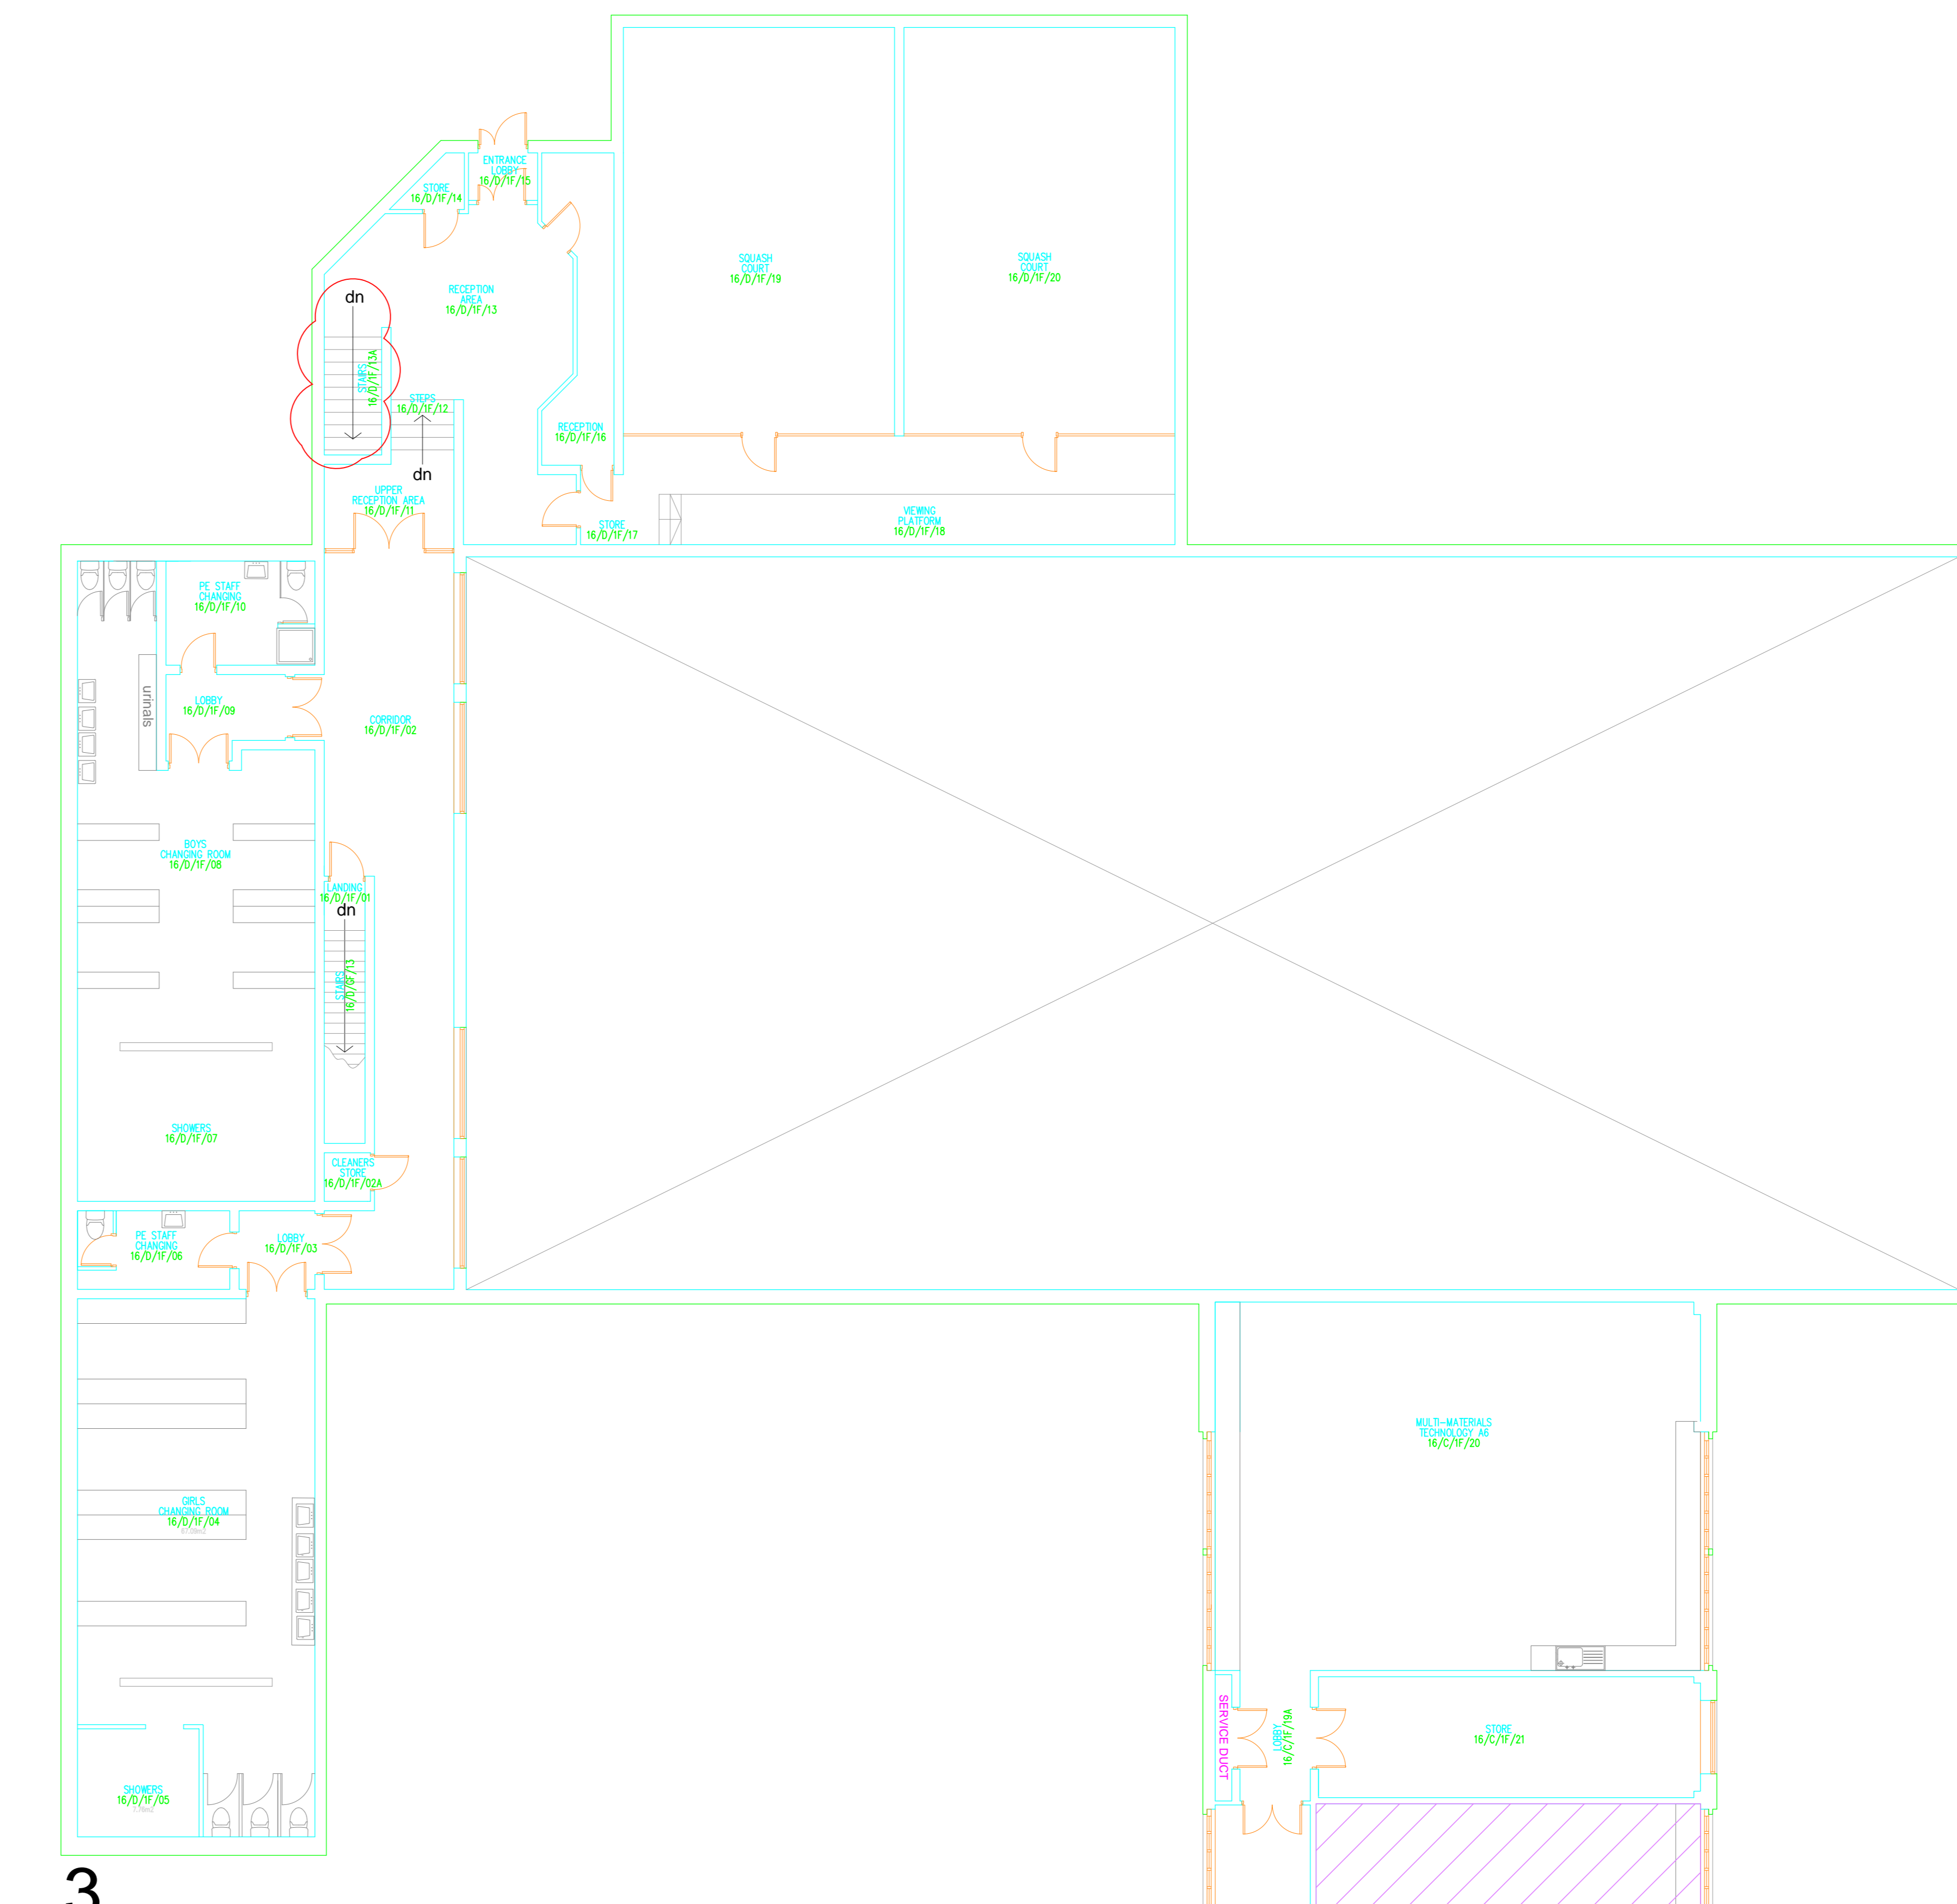
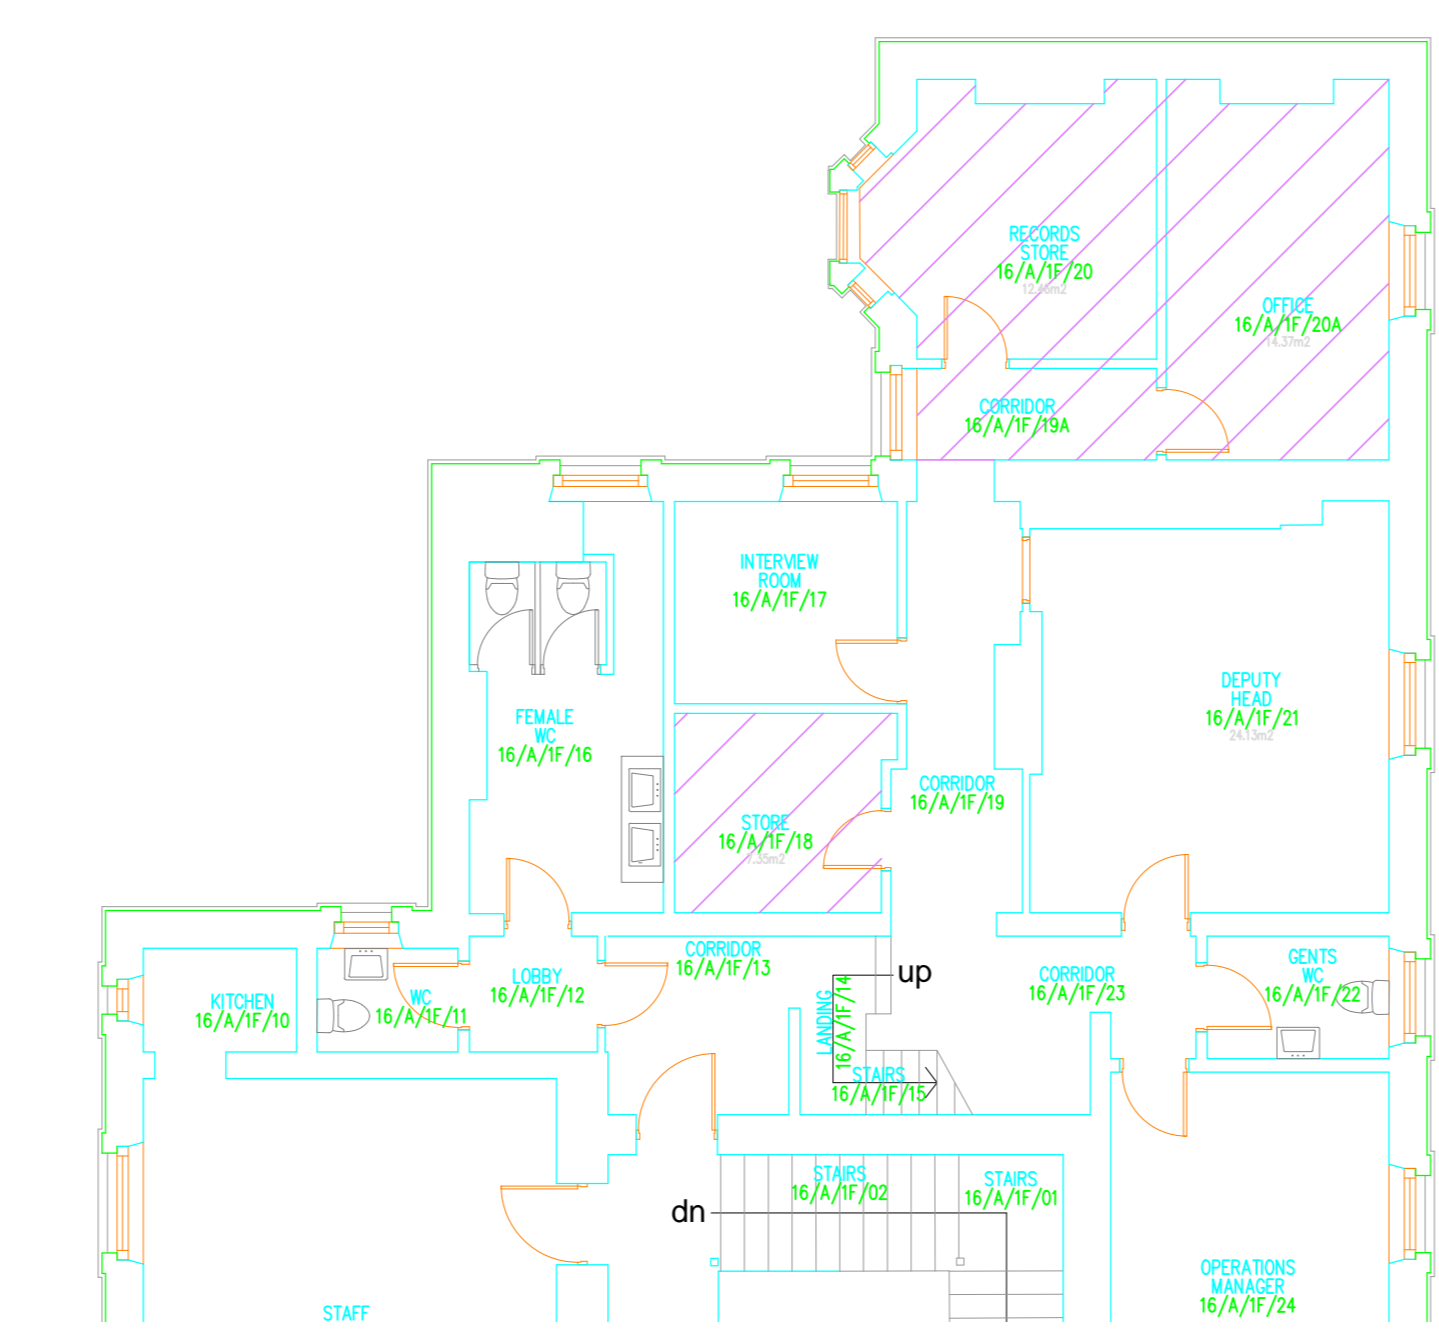
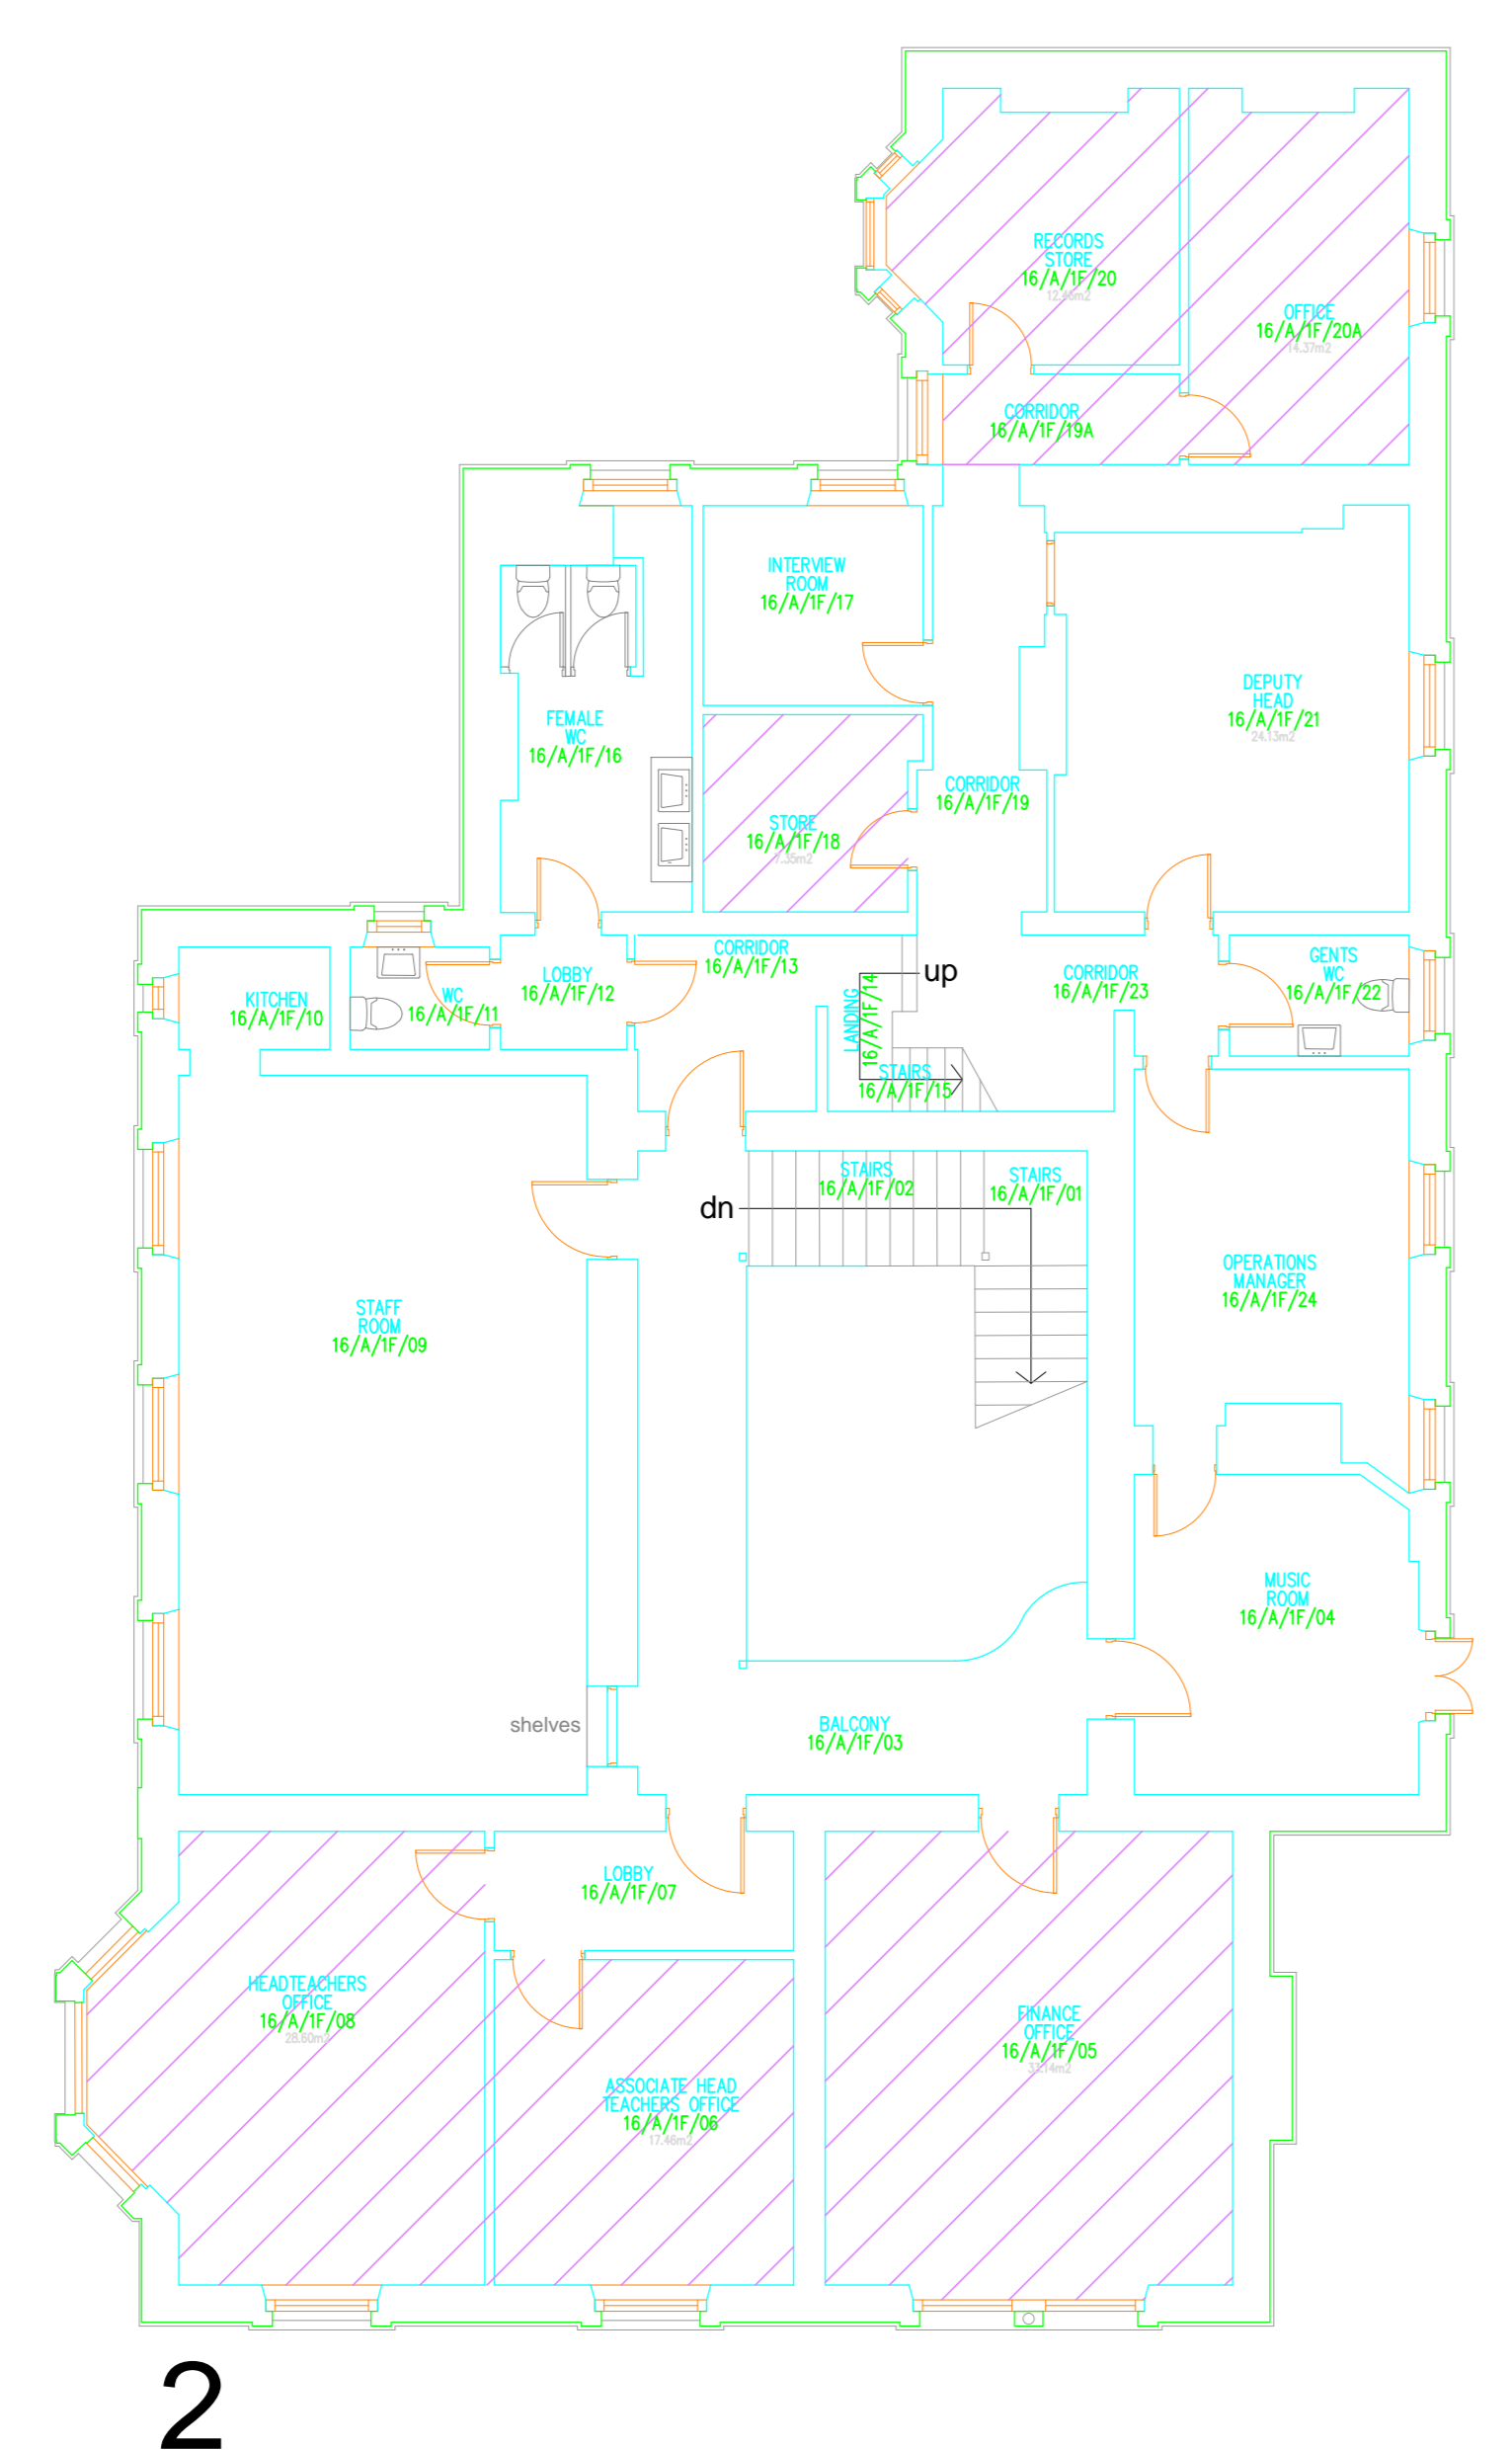


All dimensions shall be verified by the contractor on site prior to work commencing.
 Do not make any alterations to the drawing.
 Only work to written dimensions.
 This drawing is the property of SMCdr:ruk Ltd and copyright is reserved by them.
 The drawing is not to be copied, distributed or in any way published without written permission from SMCdr:ruk Ltd.

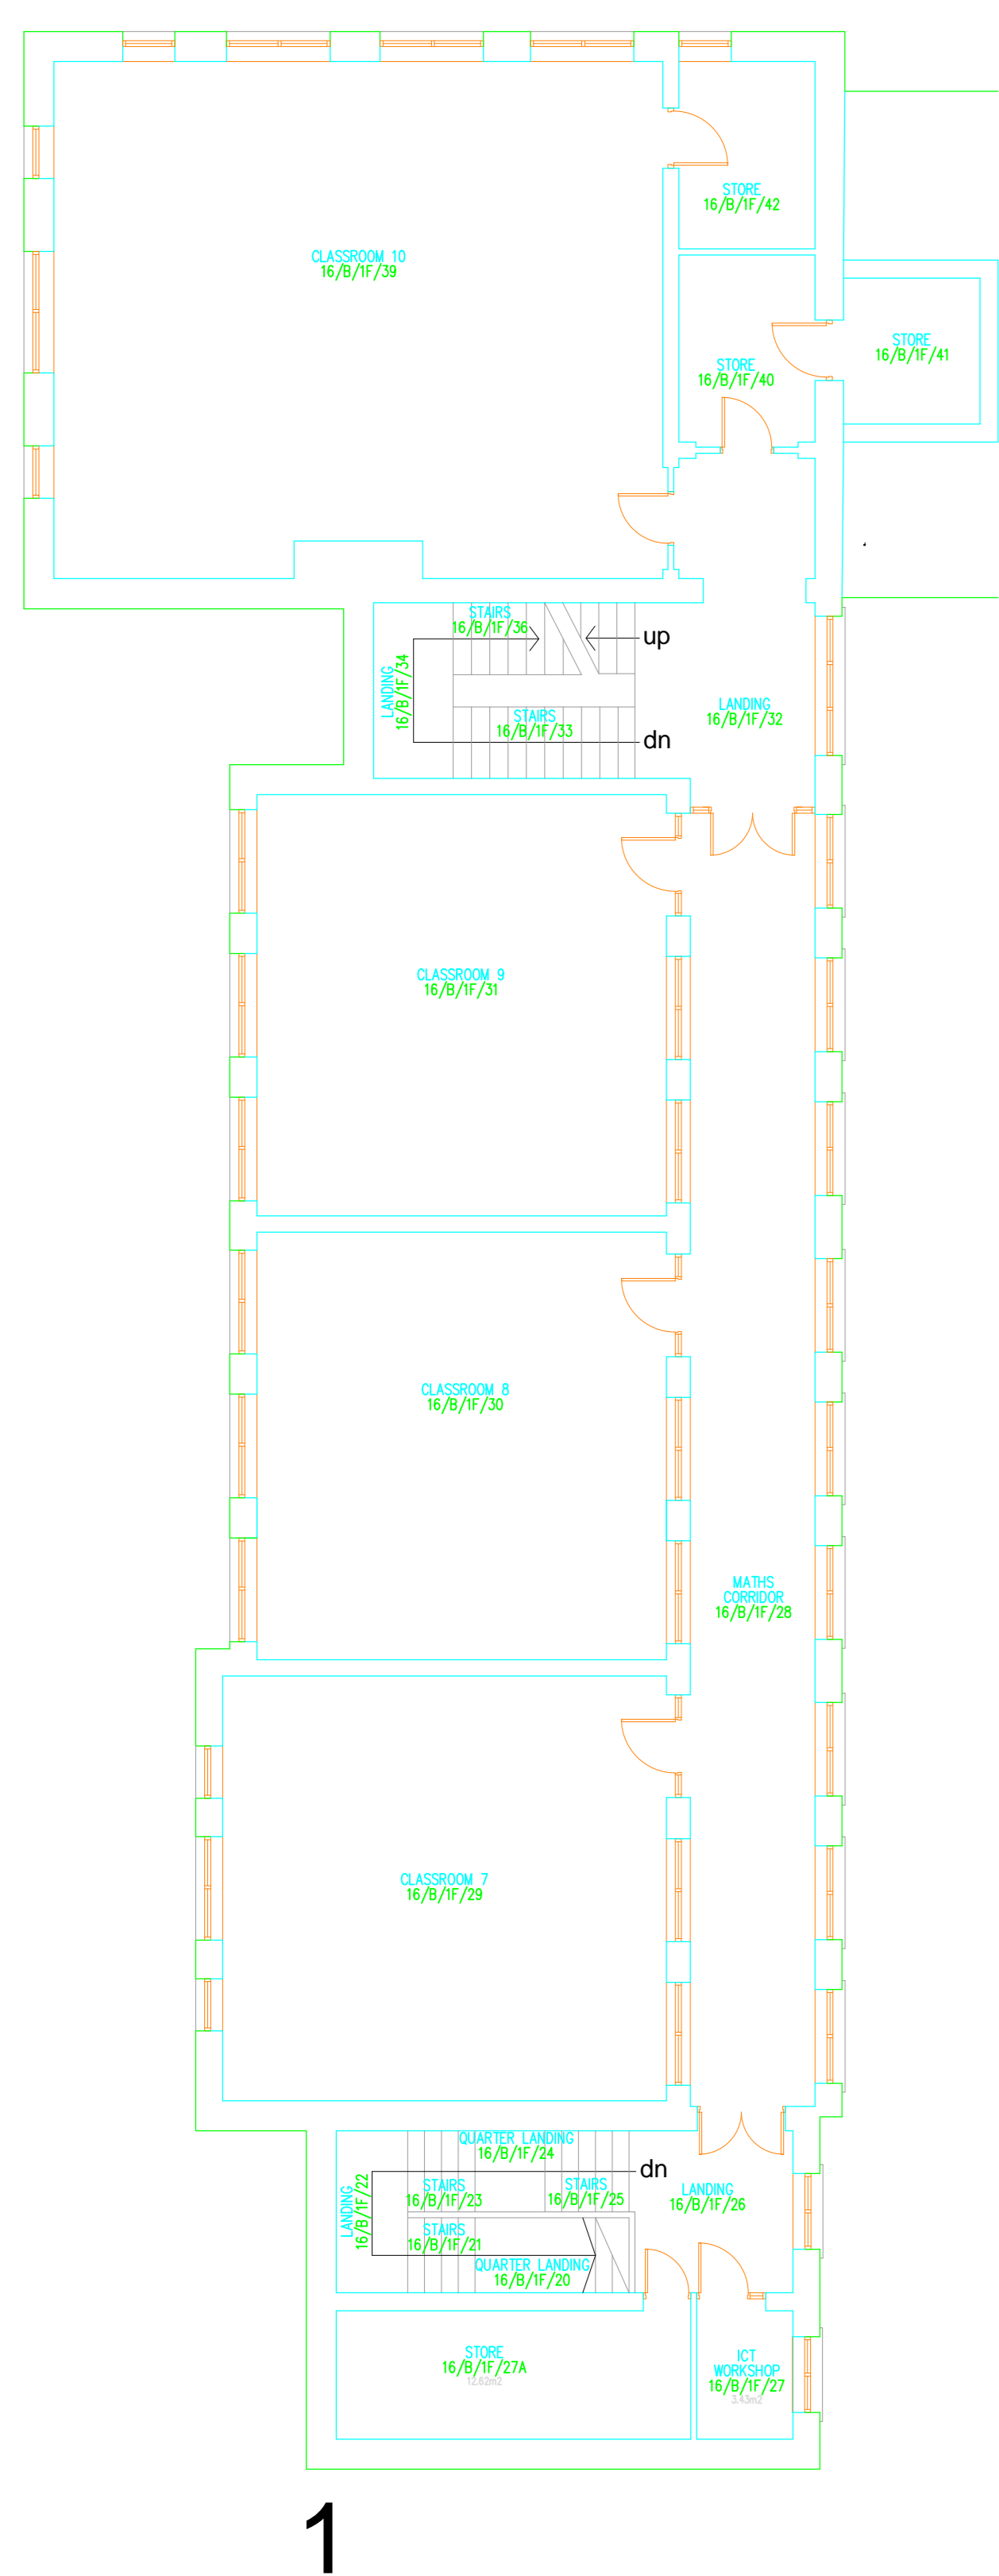

Revisions:

Status: **FINAL ISSUE**

Date: **FEB 06**

Scale @ A0: **1:100**

Checked by: **AAC:CH**

Project: **KIRKLEES SCHOOLS SERVICES LTD**
ROYD'S HALL HIGH SCHOOL

Drawing no: **H05023-02/204**

Drawing title: **AS BUILT DRAWING FIRST FLOOR PLAN**

SMCdr:ruk
 CHARTERED ARCHITECTS DESIGNERS

Advisory House, 25, Waverley Parkway, Manchester, M2 2WJ
 Tel: +44(0)161 834 6000 Fax: +44(0)161 834 6001 email: manchester@smc-dr.uk
 24 North Street, Leeds, LS2 7PR
 Tel: +44(0)113 244 0068 Fax: +44(0)113 244 0068 email: leeds@smc-dr.uk
 1st/2nd Floor, 100, Upper Street, London, E1 1DF
 Tel: +44(0)20 7261 0044 Fax: +44(0)20 7261 0044 email: london@smc-dr.uk
 The Riverside, White Cross, South Road, Luton, LU1 4JG
 Tel: +44(0)1525 492 712 Fax: +44(0)1525 492 711 email: luton@smc-dr.uk
 www.smc-dr.uk