


0m  
0m  
0m  
0m

Scale 1:50  
Scale 1:100  
Scale 1:200  
Scale 1:1250

4m  
8m  
16m  
100m

[When to scale of original plan, bar = 8cm]

© Copyright Kirklees Metropolitan Council

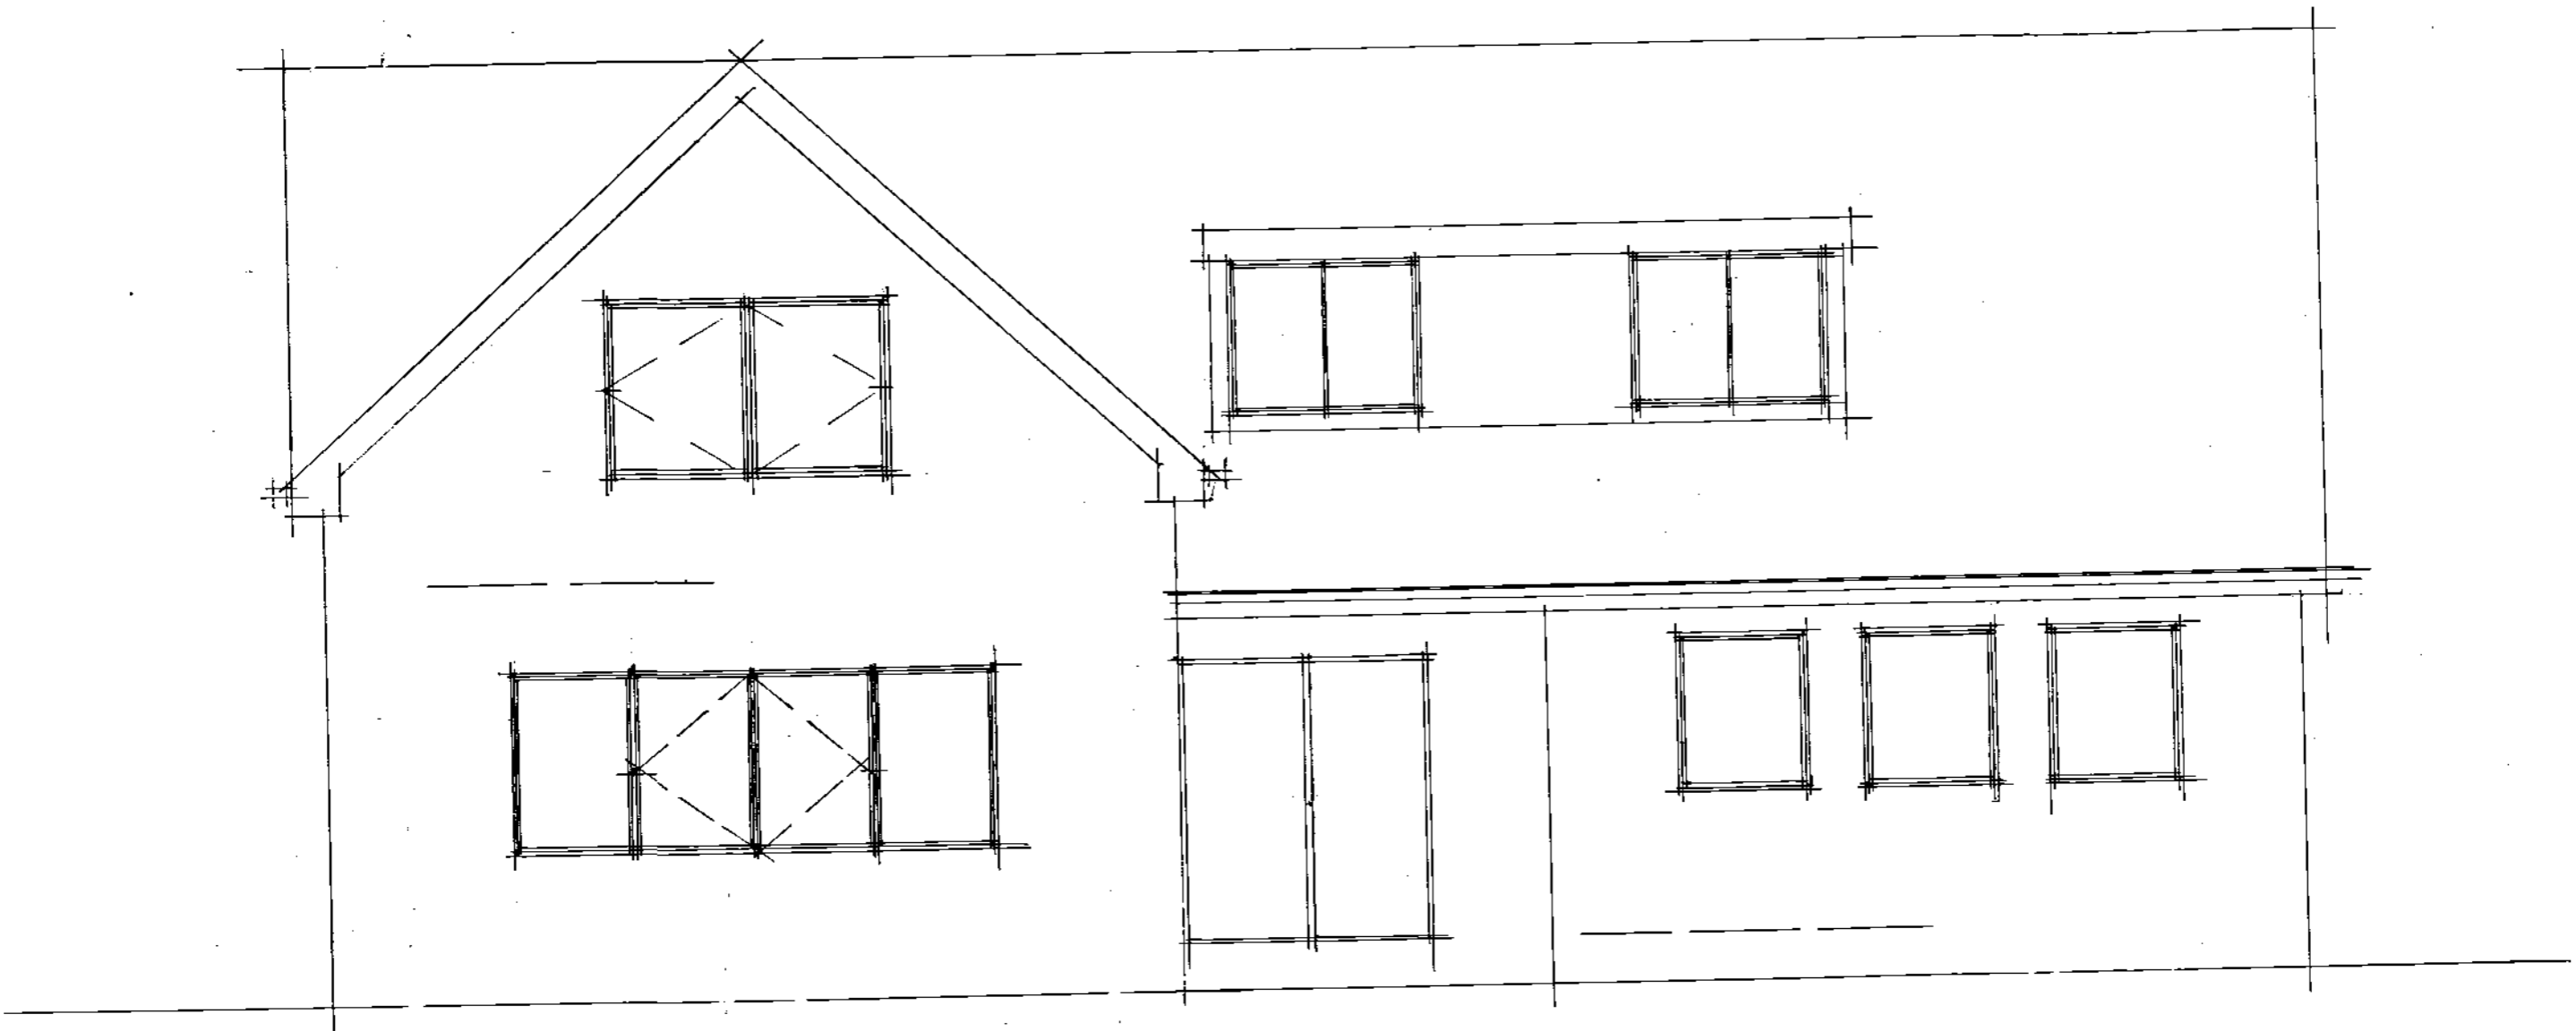

AS BUILT - FRONT ELEVATION

9 EDGERTON GREEN  
EDGERTON HUDDERSFIELD

DRG NO B73.8B SCALE 1.50