


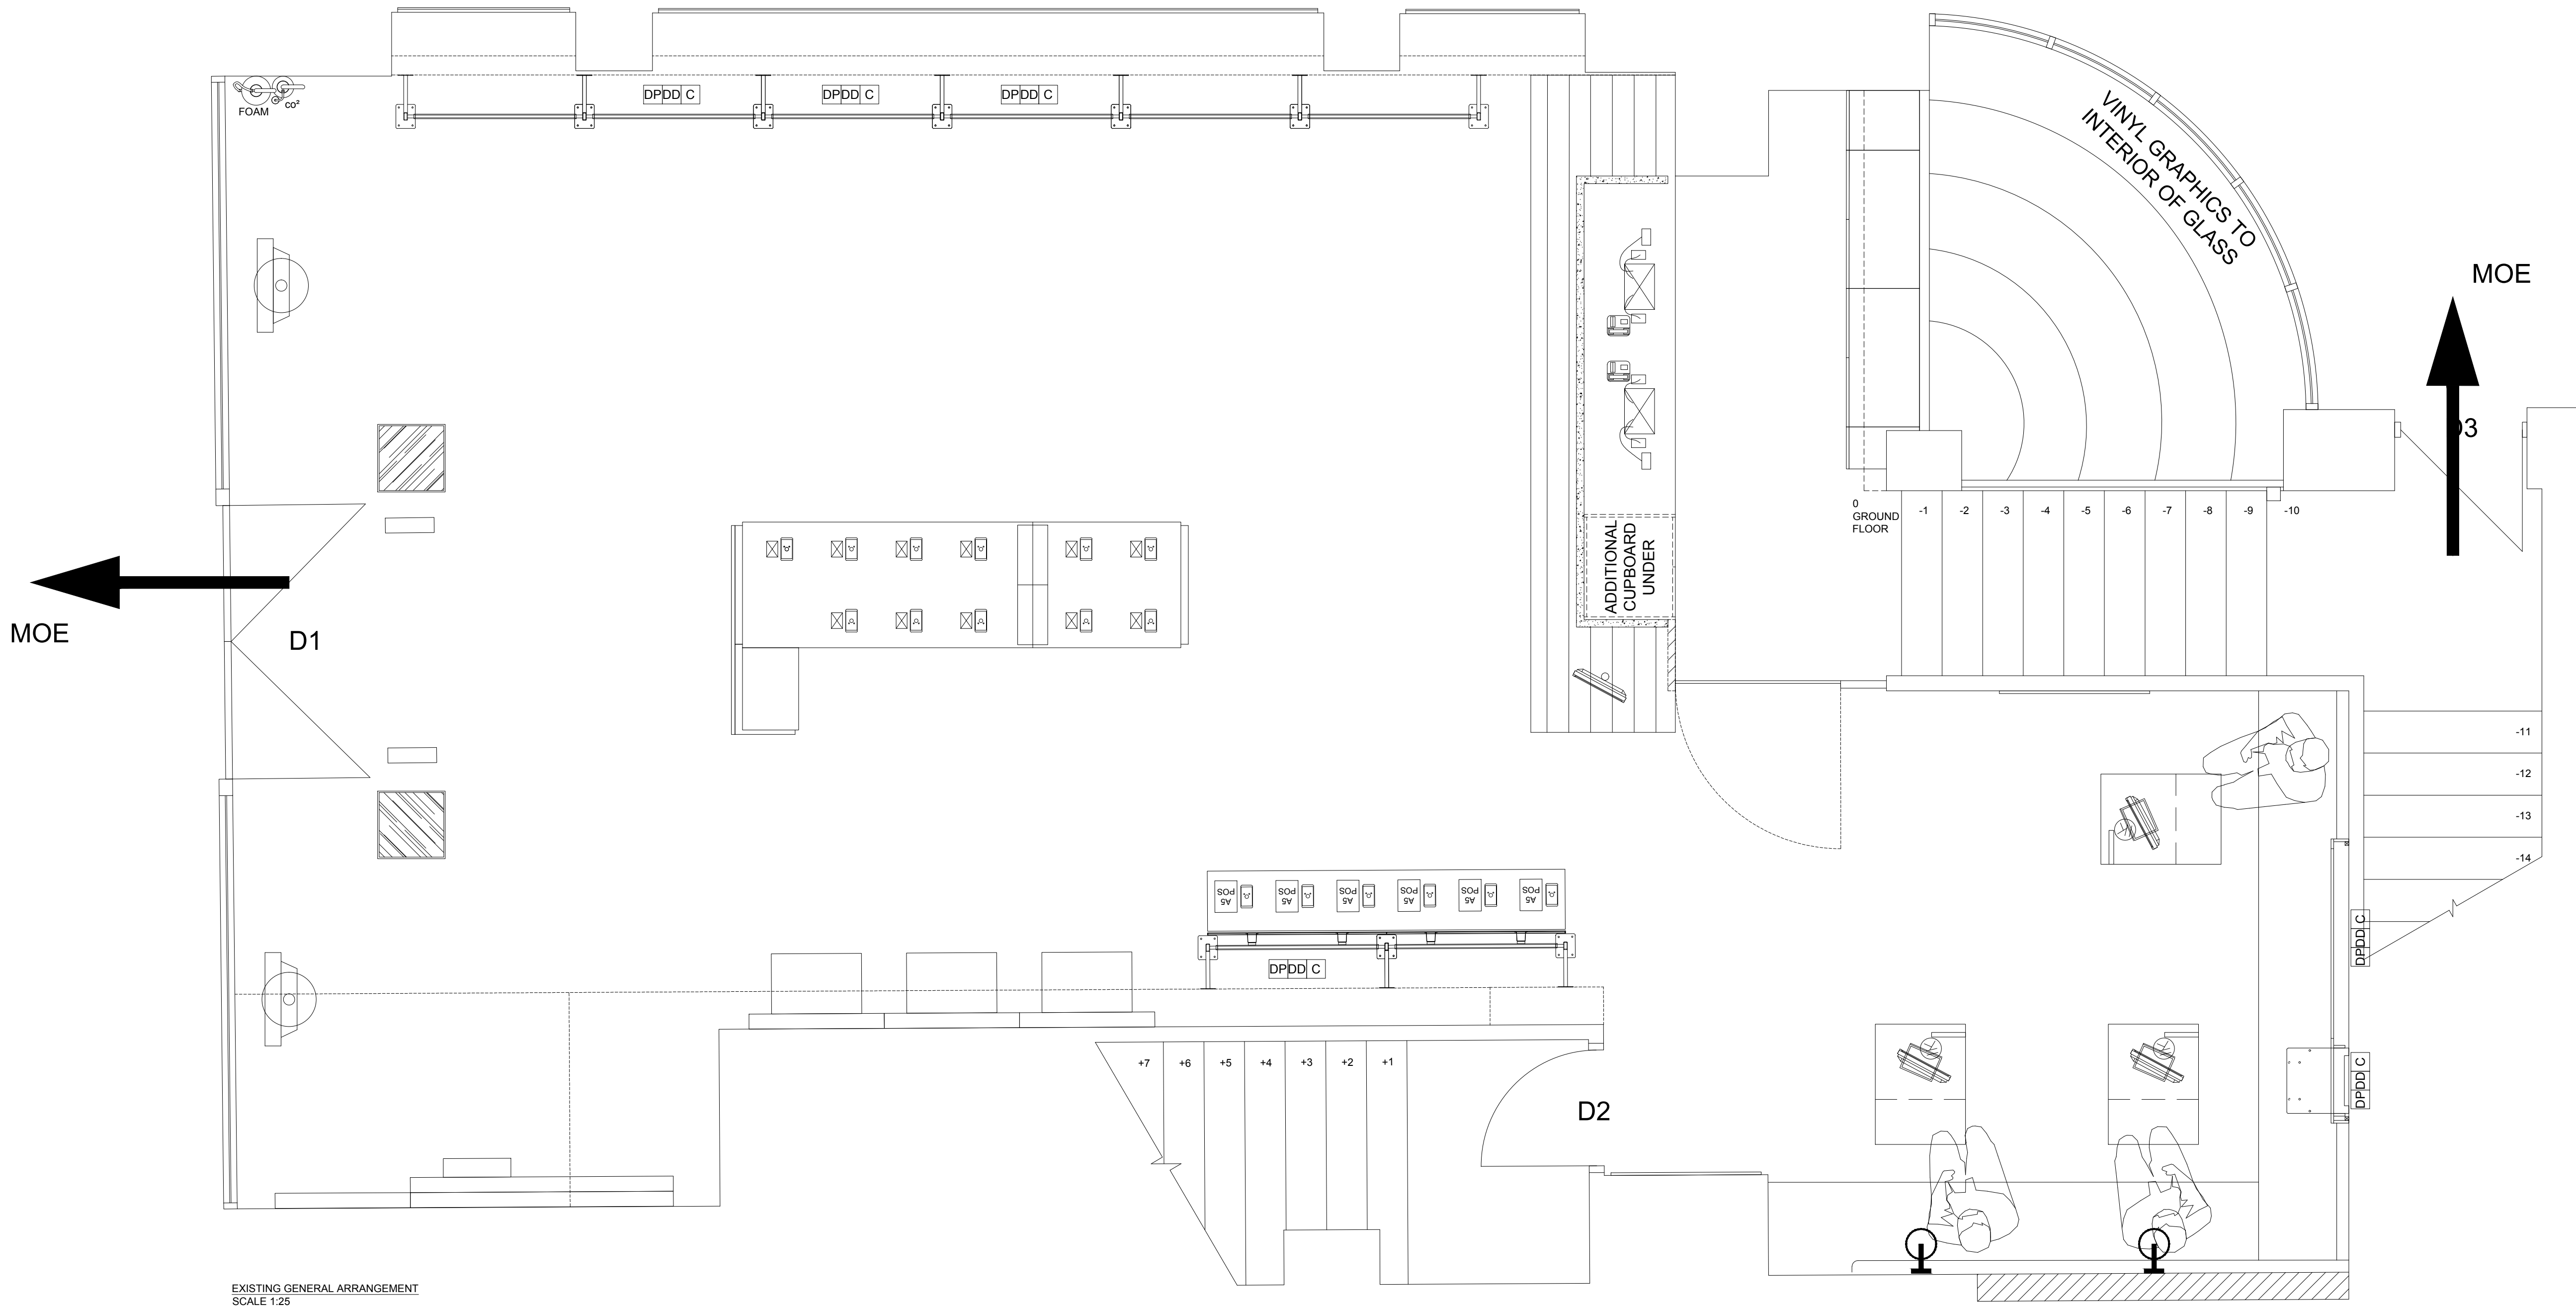

REVISIONS	DATE	INIT
-----------	------	------

Issued for
AS BUILT

Drawing project
**VIRGIN MEDIA HUDDERSFIELD
REFIT PROJECT**

Drawing title
**EXISTING GENERAL
ARRANGEMENT**

Client
VIRGIN MEDIA

Drawn by CG	Checked by -	Scale 1:25 @ A1	Date 29.09.16
-----------------------	-----------------	---------------------------	-------------------------

Drawing number
2027 - 100 - 01

Scale bar @ 1:25
0 1m 2m 2.5m



Resolution Interiors

Company Registration No. 3678965, VAT Registration No. 723652246.
Registered in England & Wales. Copyright of this drawing is reserved
by Resolution Interiors. The drawing is issued on the condition that it is
not copied, reproduced or disclosed to a third party without consent.

Luton 2000 Business Park, Yeovil,
Somerset, BA22 8QR
Call +44 1935 422700
Fax +44 1935 422724
Email - design@resolutioninteriors.com
Website - www.resolutioninteriors.com