




South East Elevation

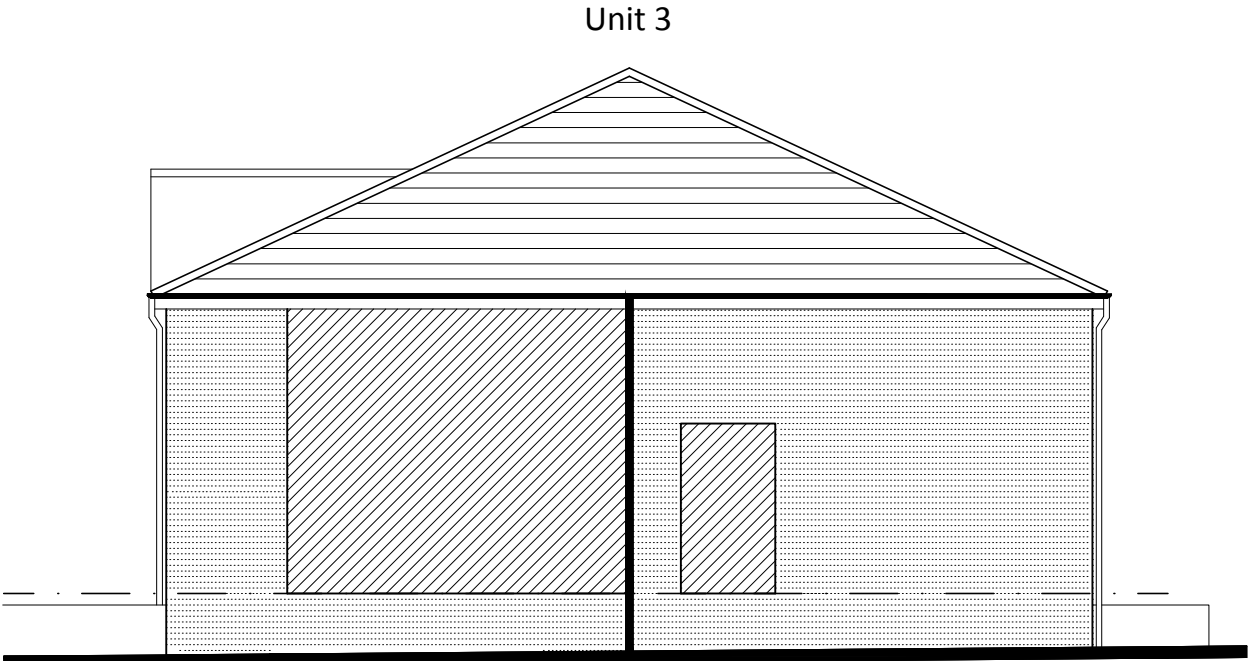



North East Elevation

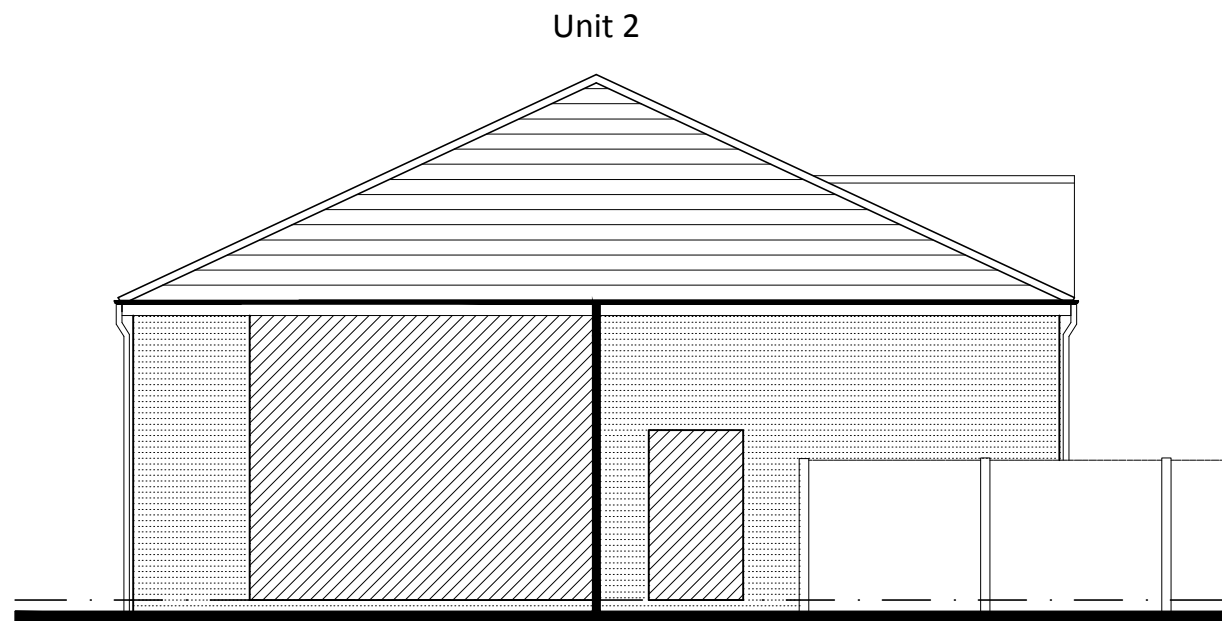

South West Elevation

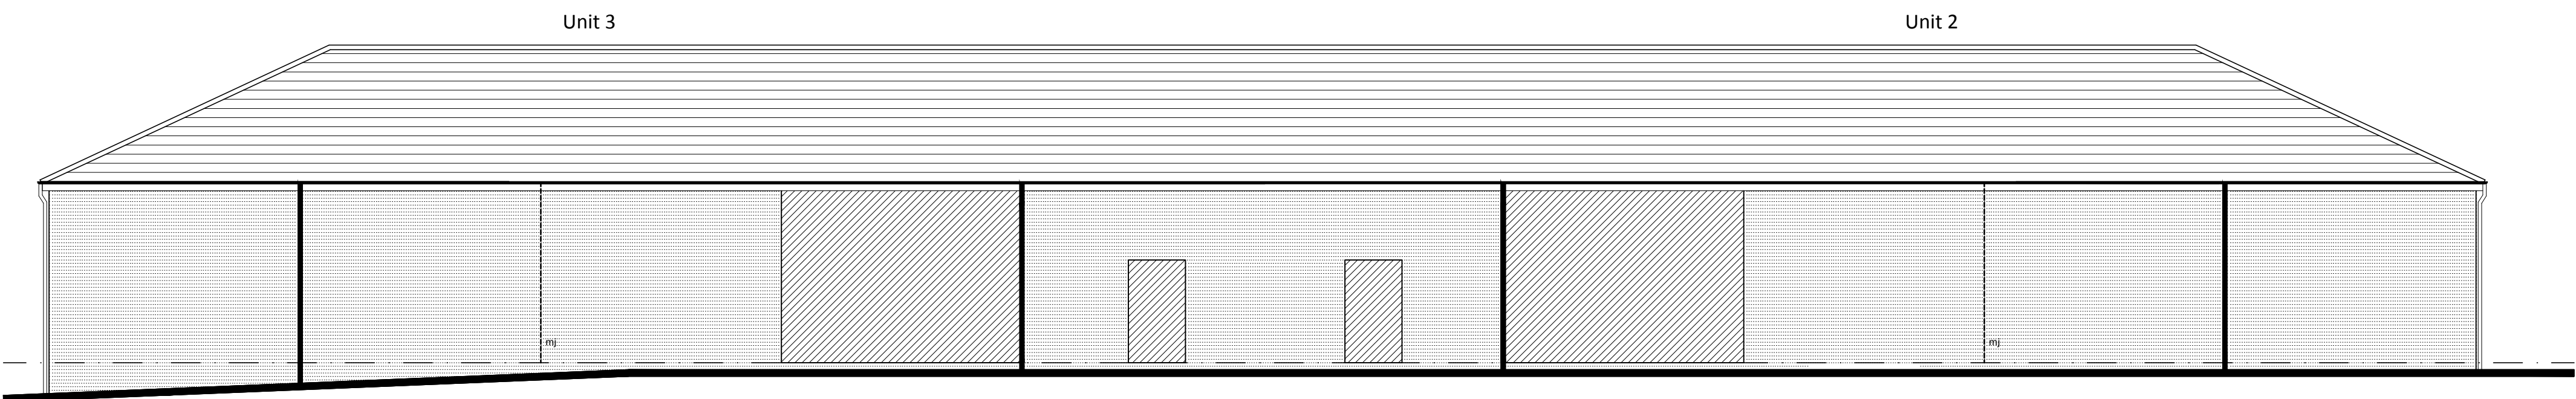

North West Elevation

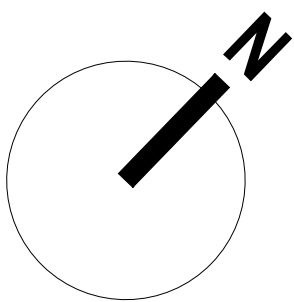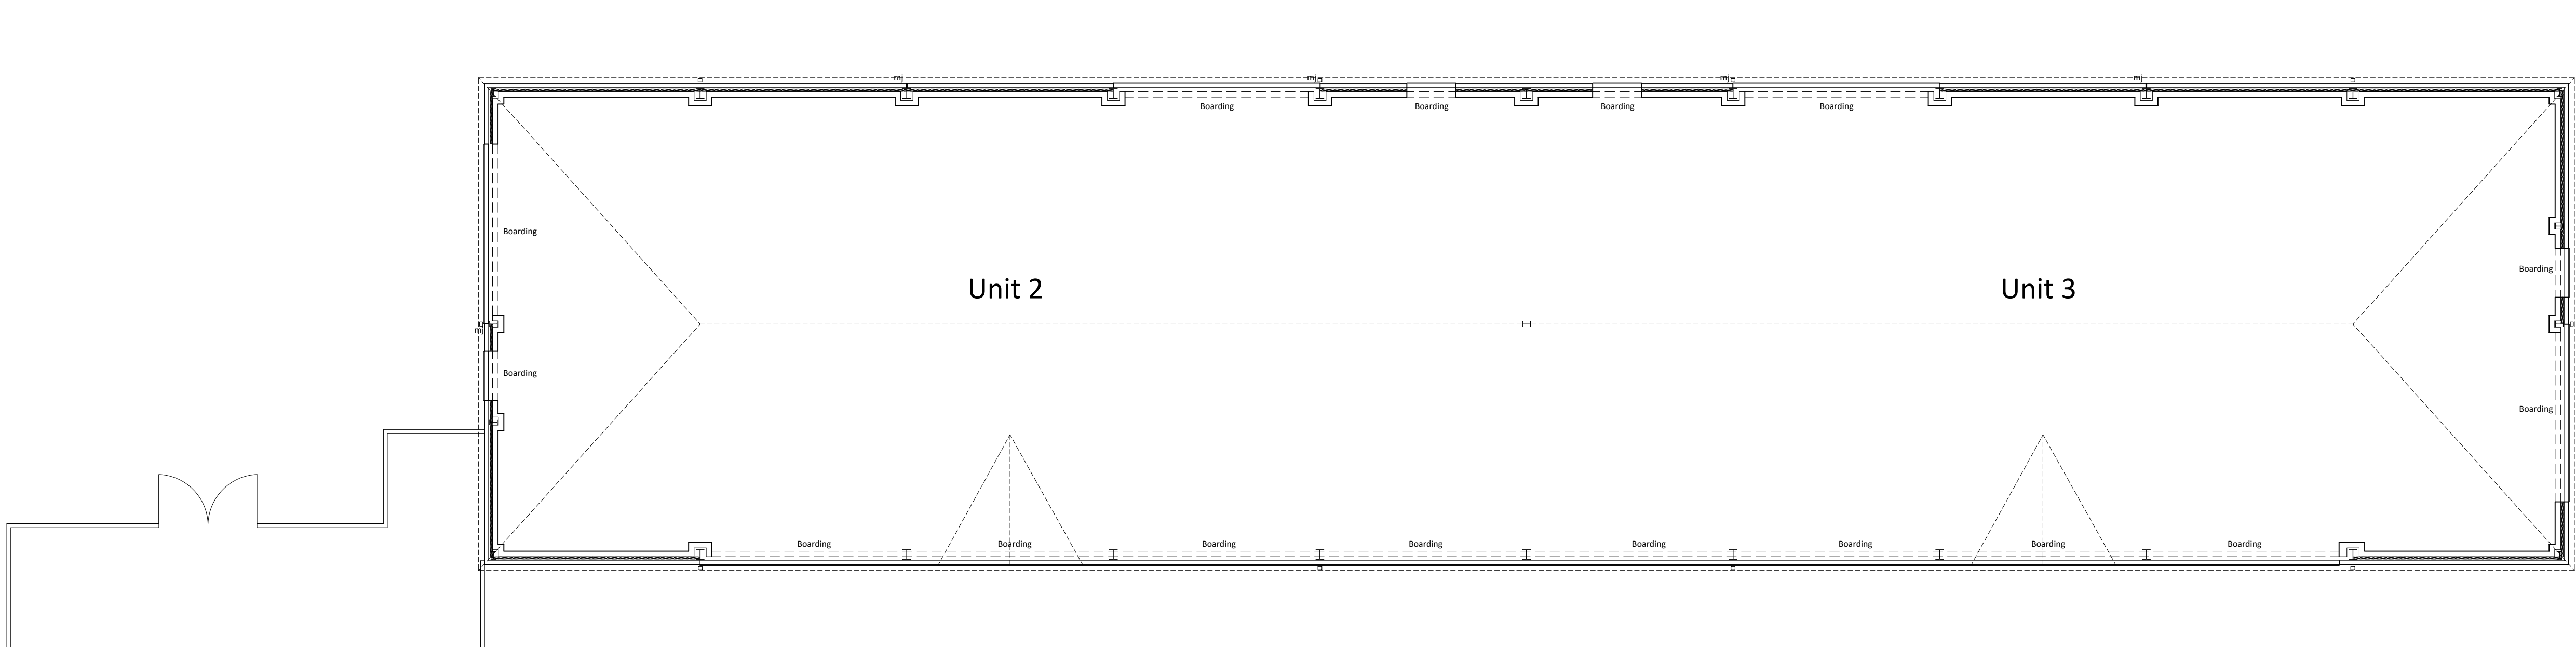

Revisions:	No.	Comment	Date	By
------------	-----	---------	------	----

Drawing Status: ☐ Preliminary ☒ Planning Permission ☐ Building Regulation ☐ Tender ☐ Construction

MWA

Martin Walsh Architectural

architecture ■ planning ■ engineering

Firth Buildings, 99-103 Leeds Road, Dewsbury, WF12 7BU

info@martinwalsh.co.uk

01924 464342

www.martinwalsh.co.uk

Job Title
Proposed Mixed Use Development (Phase 2) at Fountain Court,
Huddersfield Road, Robbottown, Liversedge WF15 7QQ

Drawing Title
As-built Units 2 and 3 Plan and Elevations

Client
Wharfedale Properties Limited

Drawn	Checked	Date	Scale	Sheet Size	Drawing No.	Rev.
MW(J)		11/16	1:100	A1	10/K16/5991/04	

Copyright © 2013 Martin Walsh Architectural. All Rights Reserved.
Martin Walsh Architectural is the trading name of Martin Walsh Architectural Limited. Registered in England Number 488048