


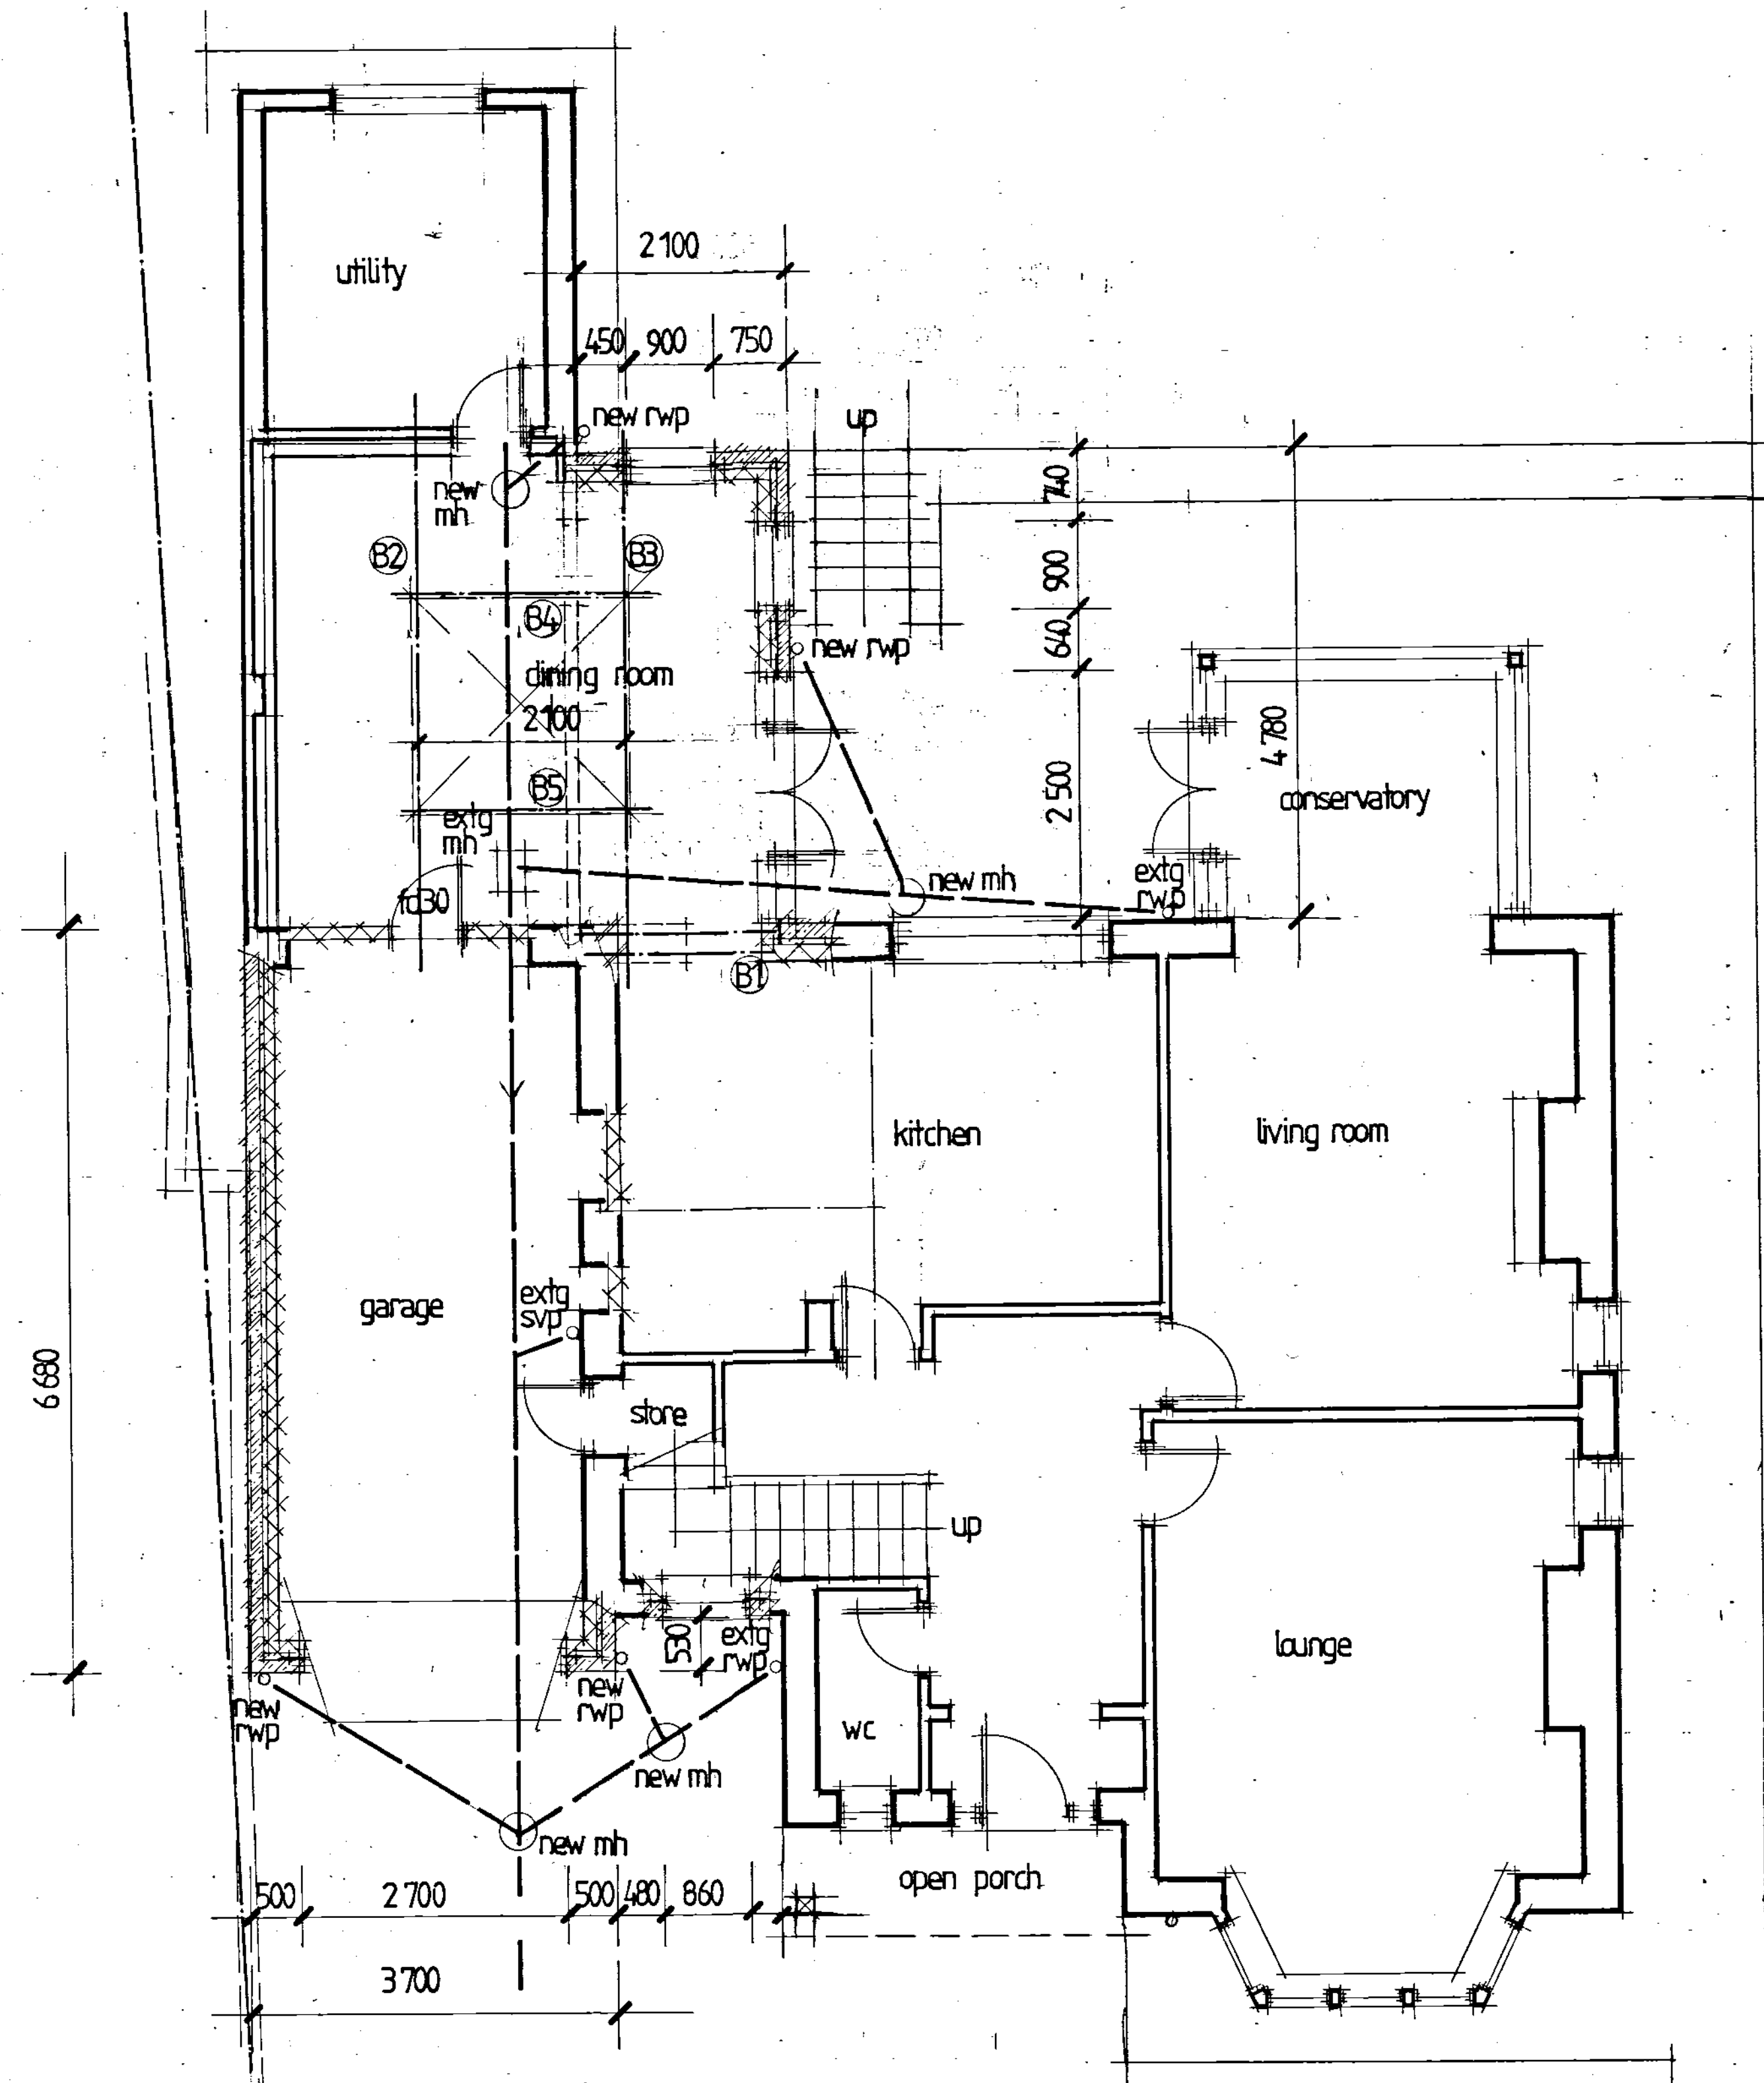

AS BUILT FLOOR PLANS

Proposed Extensions & Alterations

2 Cedar Mount
Edgerton Huddersfield


Drg no 0972 40 Scale 1:50

Ground Floor

PARKING



Front Elevation

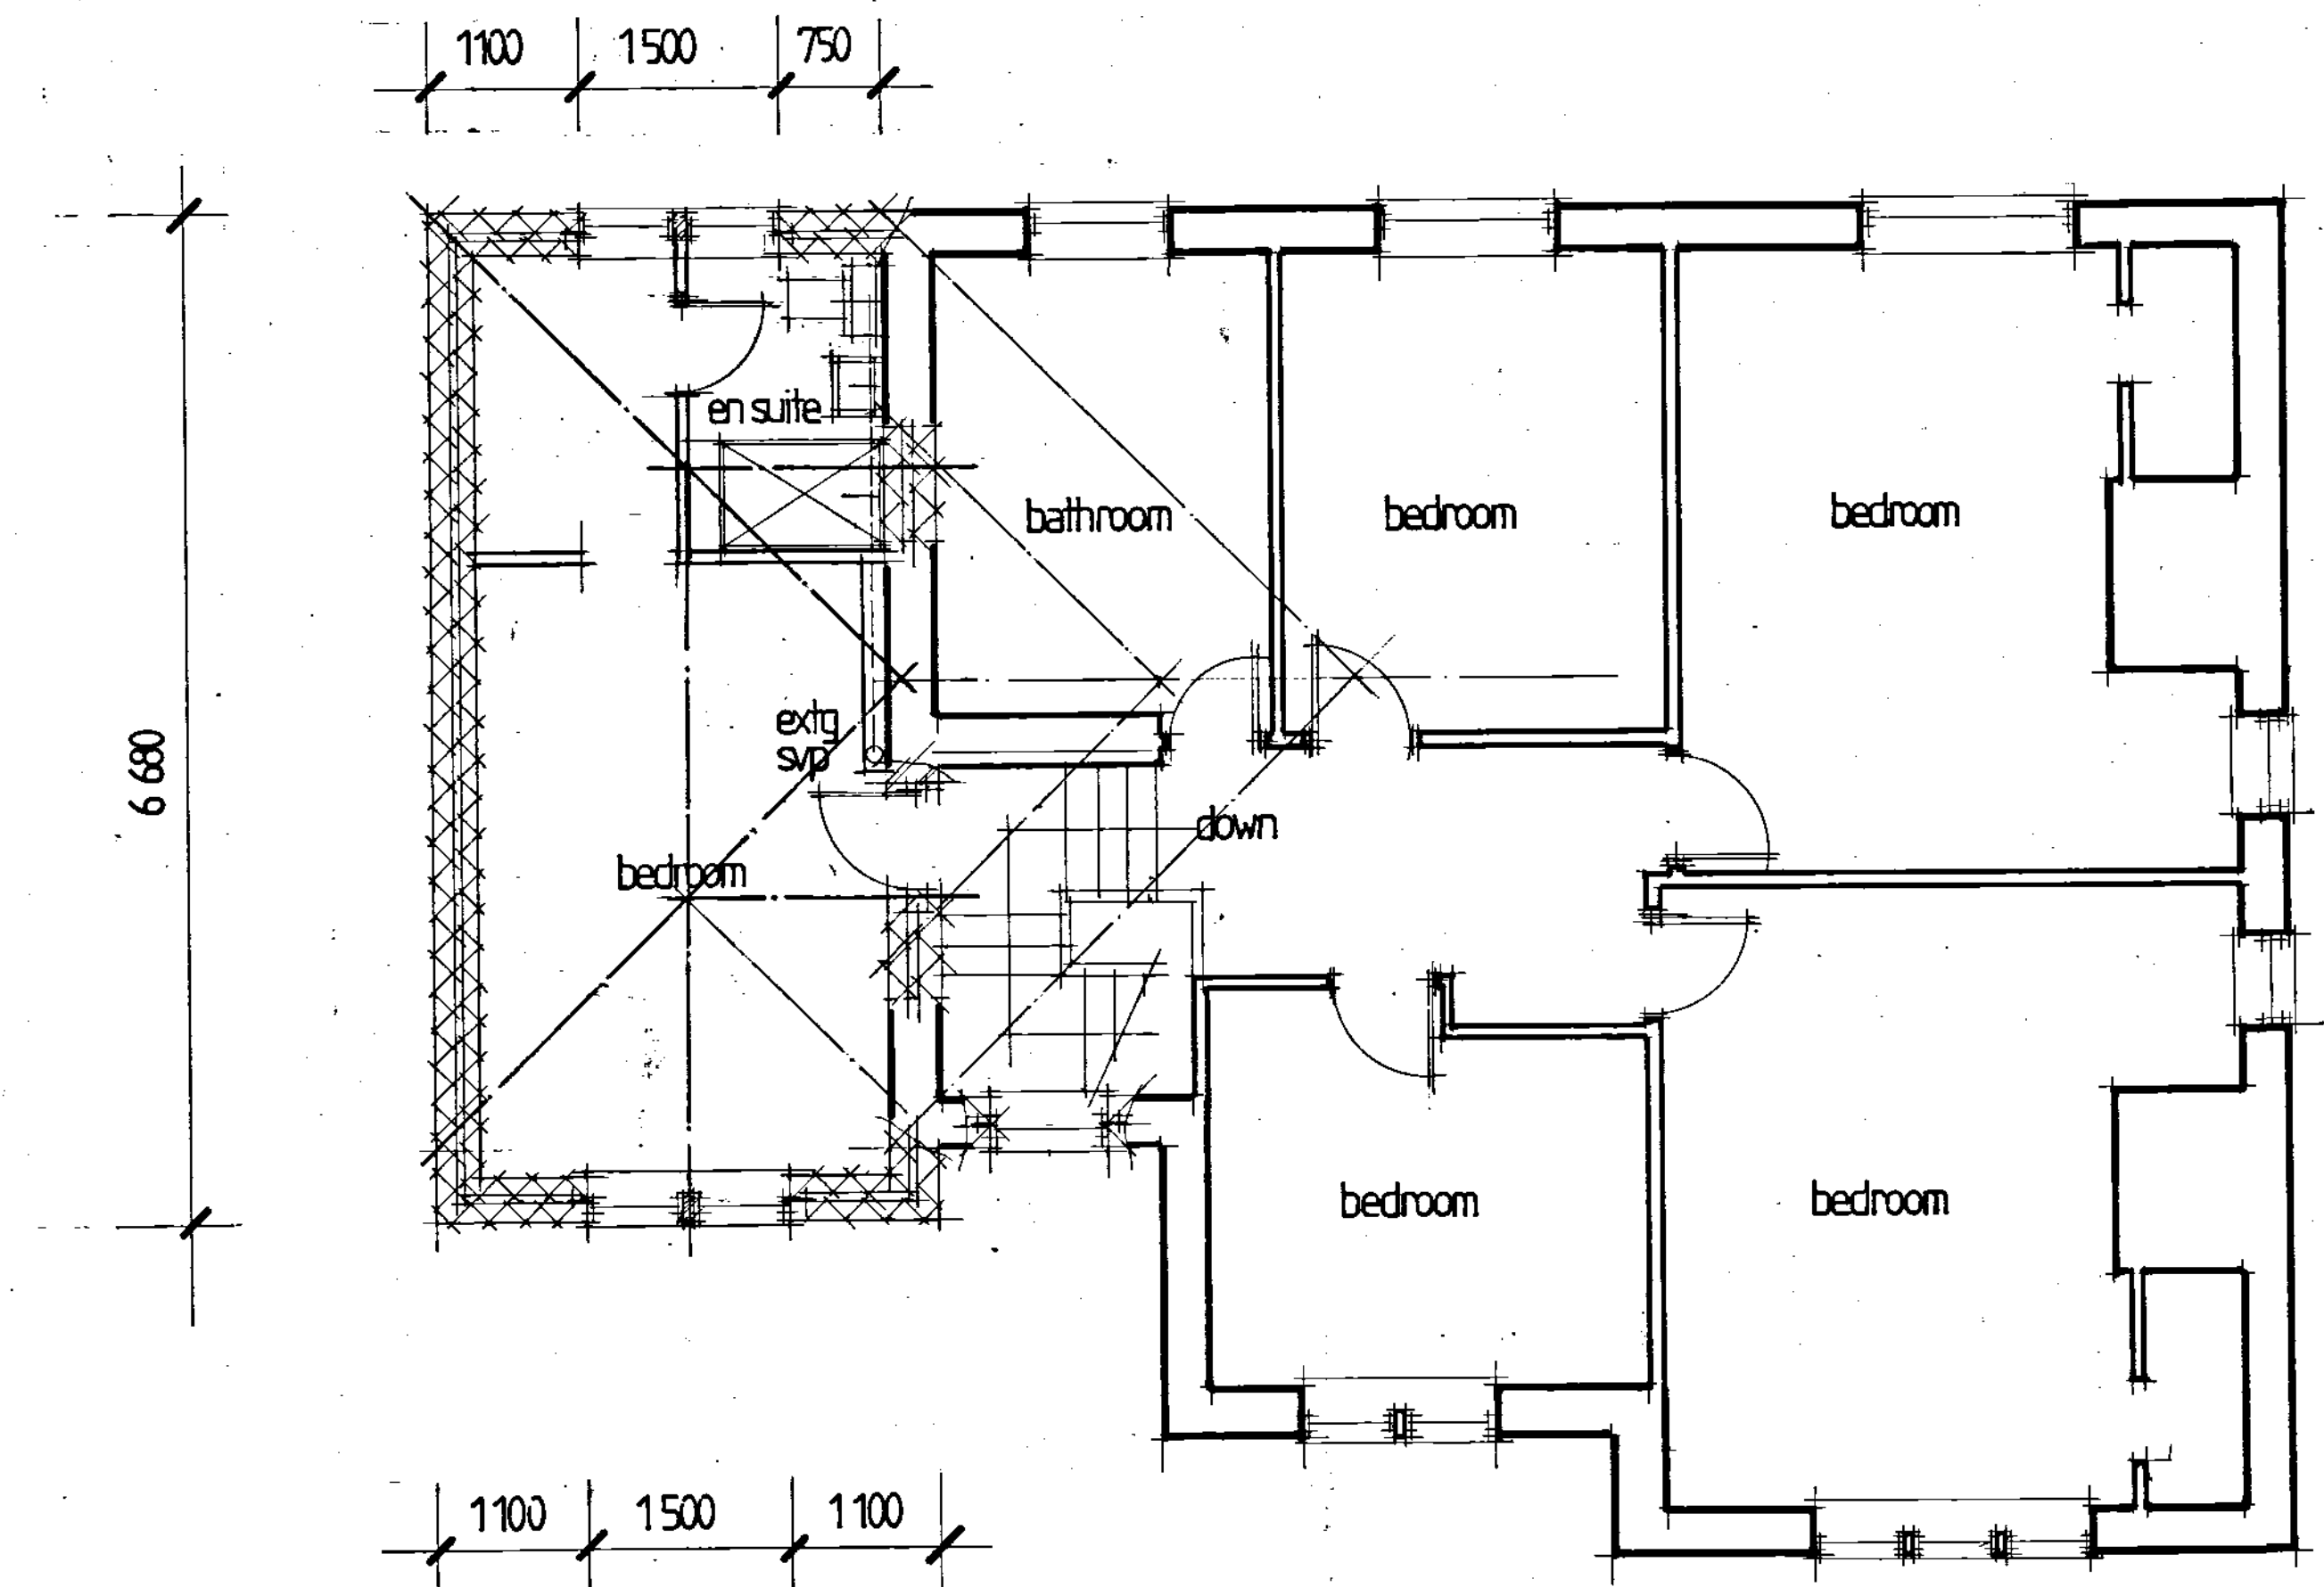

First Floor