


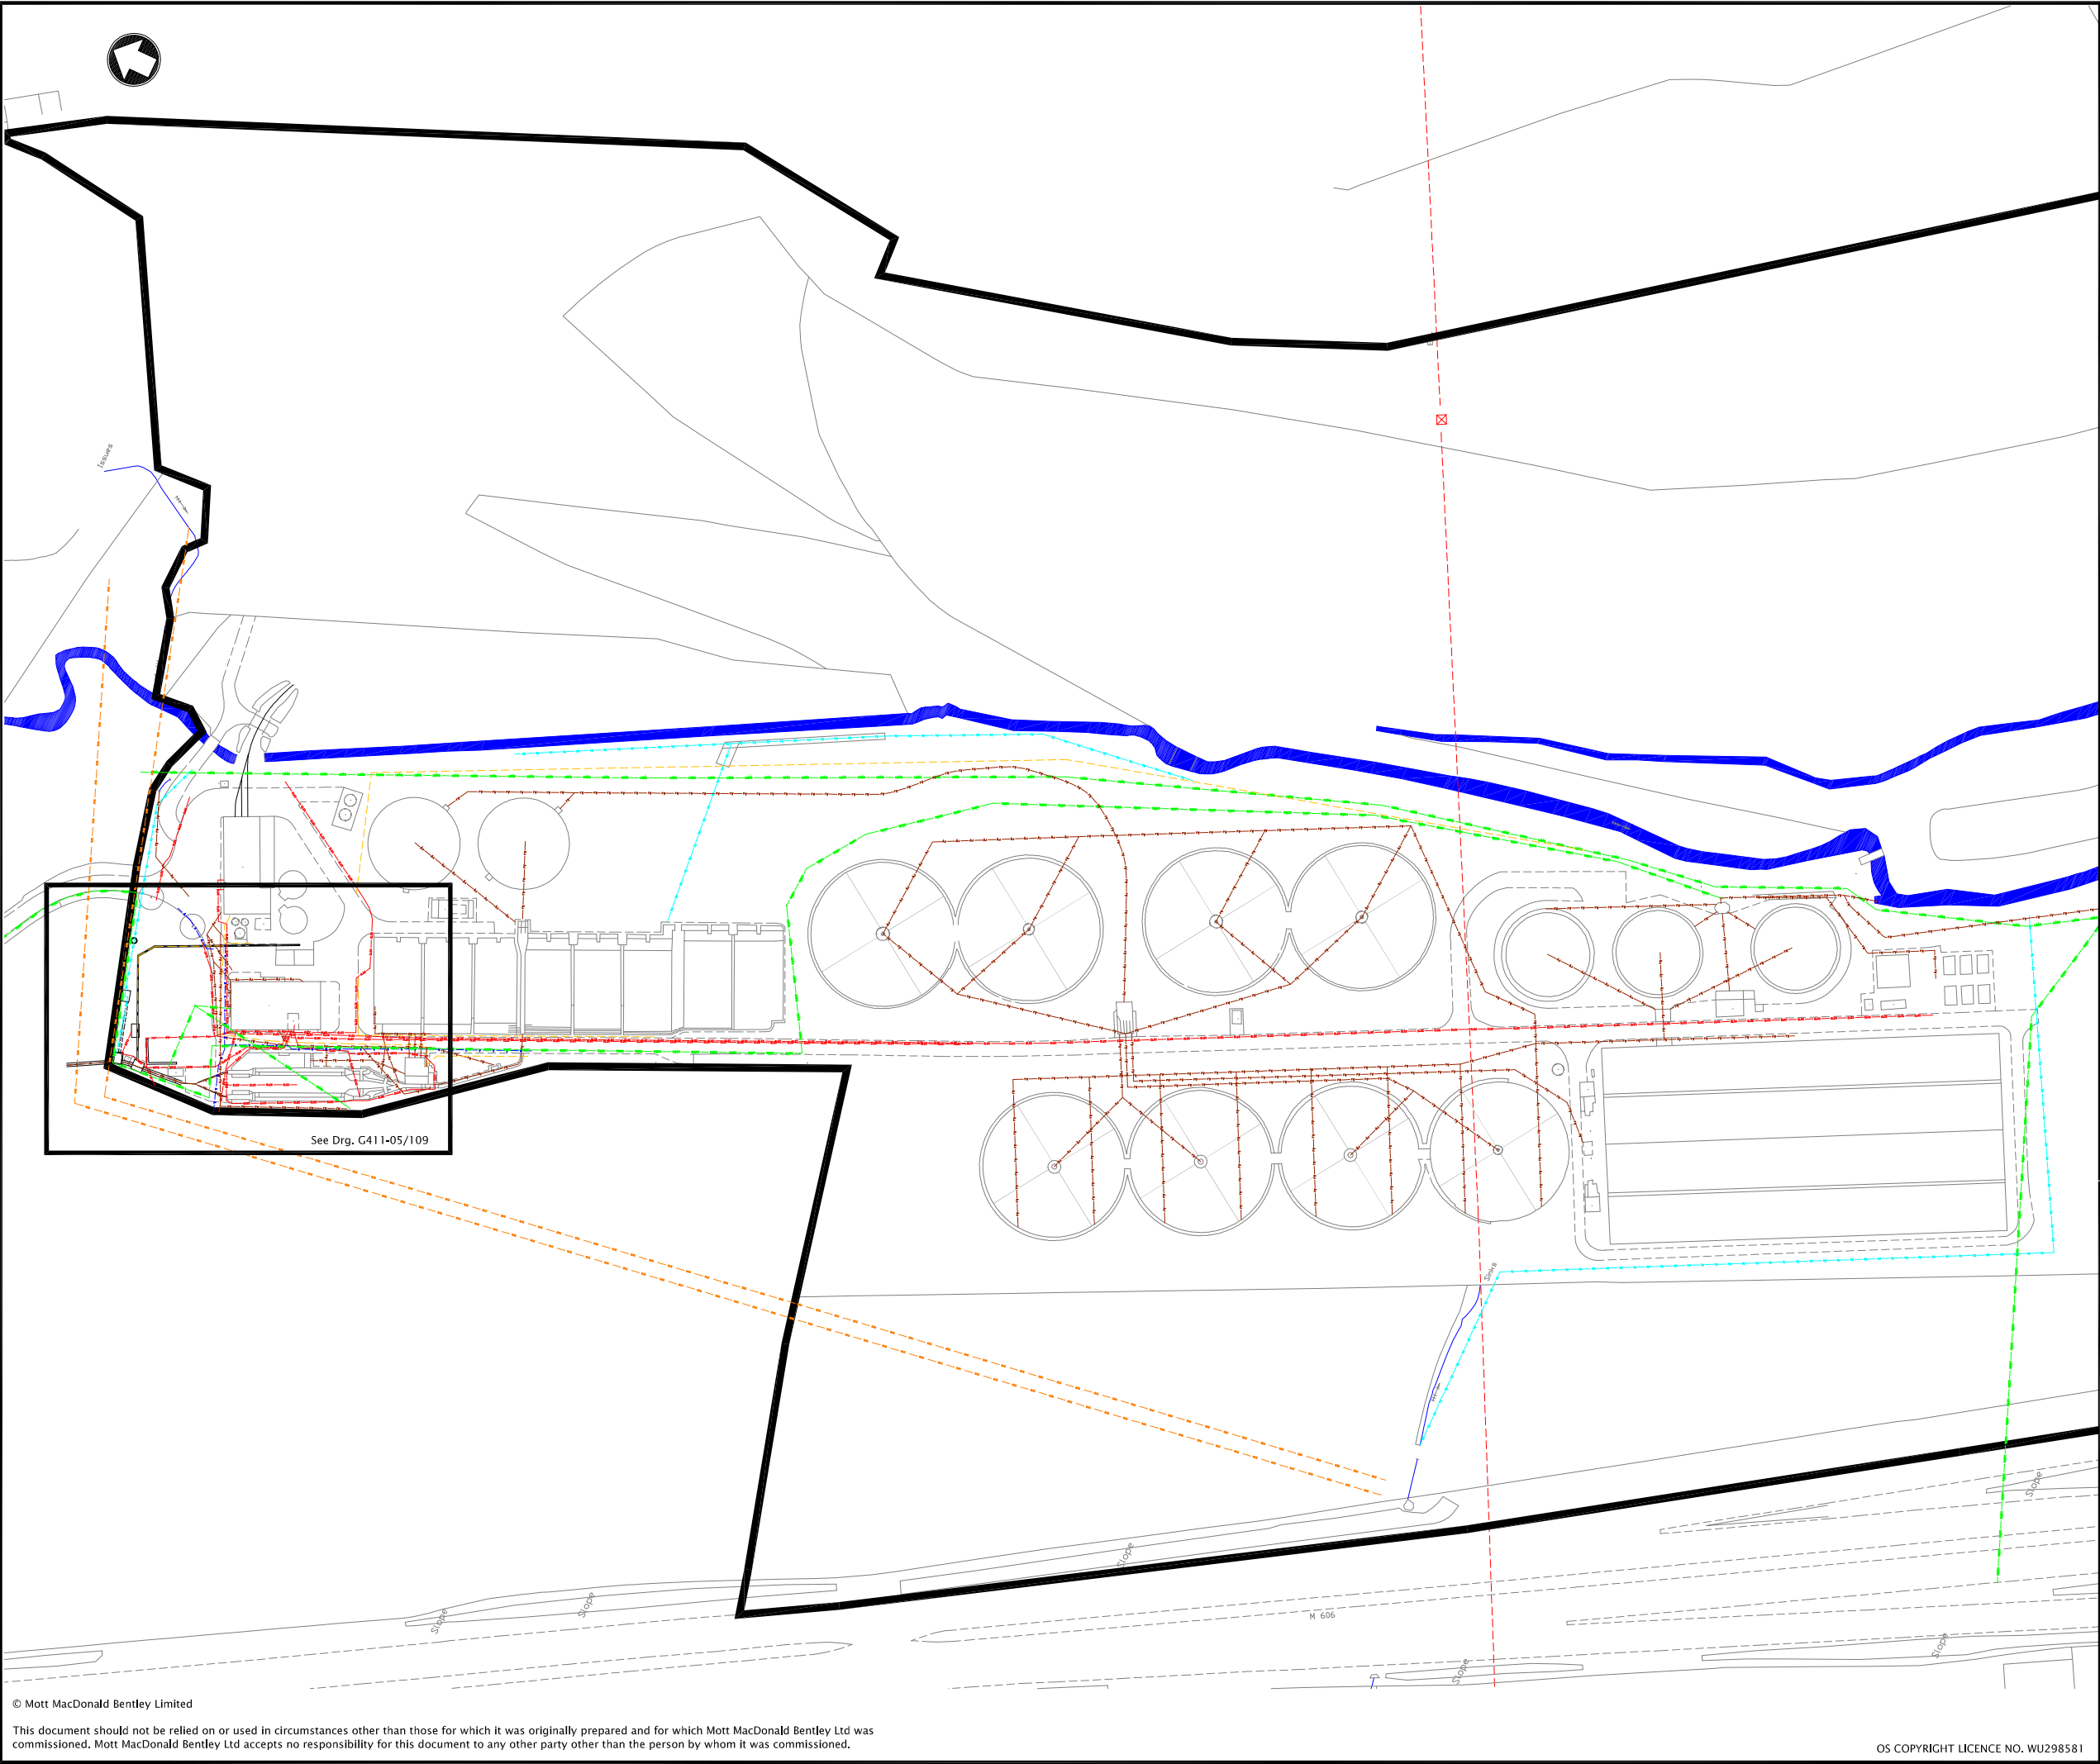


- Notes
1. This drawing to be read in conjunction with all relevant drawings & together with the specifications.
 2. All dimensions are shown in millimetres (mm), unless noted otherwise.
 3. All levels are shown in metres (m) relative to AOD, unless noted otherwise.
 4. No dimensions are to be scaled from this drawing.

Key to symbols	
	Site boundary
	Electric cable / duct
	High Voltage electric cable / duct
	Sewer (combined water)
	Sewer (foul water)
	Sewer (surface water)
	Telecomms cable / duct
	Unknown utility / duct
	Water main
	Rising main
	Gas main
	Overhead Power Lines

Reference drawings

G411-05/104 - Site Layout

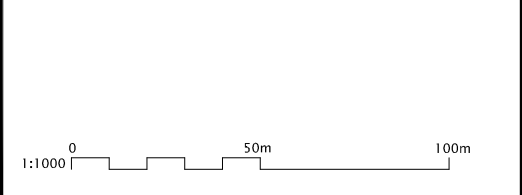

AB	12/09/11	PTW	As Built	PL	PL
Rev	Date	Drawn	Description	Ch'k'd	App'd

Large Schemes Delivery Team

Mott MacDonald Bentley Limited

Telephone - 01756 799425
Facsimile - 01756 798068
E-mail - info@mmb.co.uk
Website - www.mmb.co.uk

Kelighley Road
Skipton,
North Yorkshire, BD23 2QR,

Client

Western House
Western Way
Halifax Road
Bradford BD6 2SZ
Tel (01274) 691111
Fax (01274) 604764

Title **Spen Valley Strategy - Phase II - Flow Transfer**
North Bierley WwTW
Existing Services

Scheme Address : North Bierley WwTW, Bradford Road, Oakenshaw, Bradford BD12 7EP						
OS Ref: 417897,427638			Date Outputs Achieved:		JULY 2010	
Designed	JPD	M & E Chk.			Program Mng.	PL
Drawn	PTW	Process Chk.			Design Mng.	SJB
Dwg. Chk.	EM	Eng. Chk.	EM	DAZ Ref:	260	
Scale at A1 1:1000		YWS Ref:	A8016	MMB Ref:	G411	Status
		CAD File: L:/Large Schemes/G Contracts				AsB
Drawing No G411-05/103						



-

Hunsworth Beck
Manhole

1:1000 0 50m 100m

mmB

Telephone - 01756 799425
Facsimile - 01756 798068
E-mail - info@mm-b.co.uk
Website - www.mm-b.co.uk

YorkshireWater

OS Ref: SE 178 276		Date Outputs Achieved:		JULY 2010	
Designed	JPD	M & E Chk.			Program Mng.
Drawn	IA	Process Chk.			Design Mng.
Dwg. Chk.	EM	Eng. Chk.	EM	DAZ Ref:	260
Scale at A1 1:1000		YWS Ref: A8016	MMB Ref: G411	Status AsB	
		CAD File: L:/Large Schemes/G/ Contracts			
Drawing No G411-05/104		Rev AB			