


This drawing is the copyright of Square One Architecture and must not be reproduced without their written consent. All rights reserved.
Contractors must verify all relevant dimensions on site before commencing work / prefabricated work / preparing shop drawings.
In all cases figured dimensions shall be taken in preference to scaled dimensions Square One Architecture to be notified of any discrepancies


Revisions	Date	No.




FRONT ELEVATION

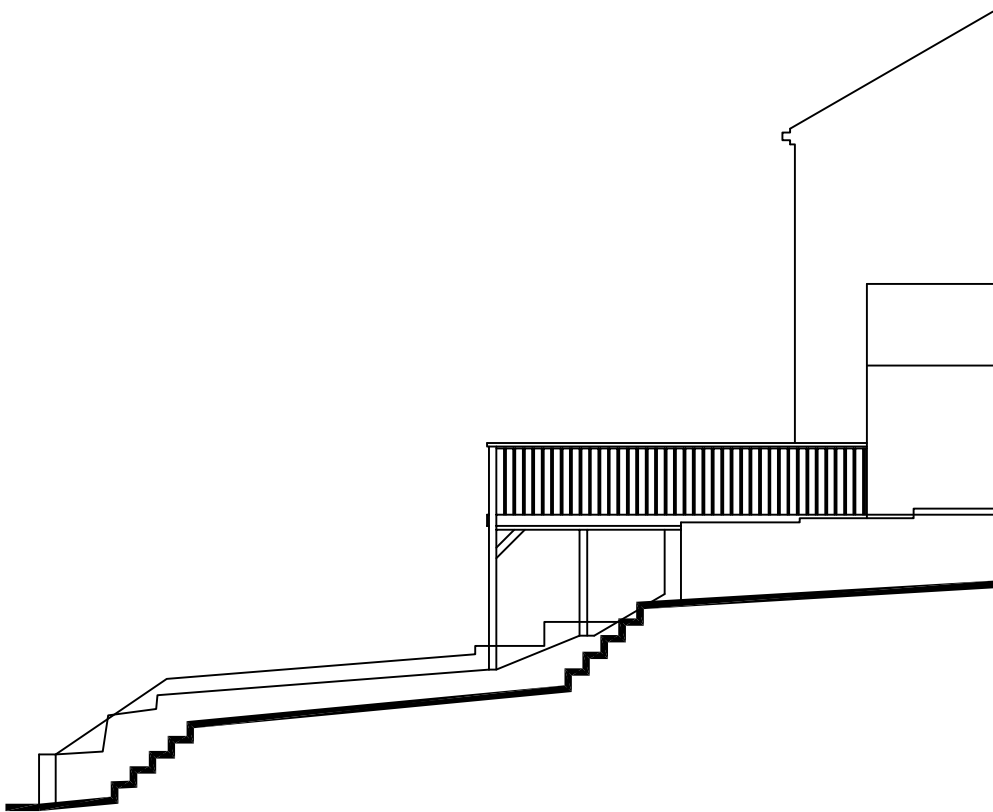


SIDE ELEVATION

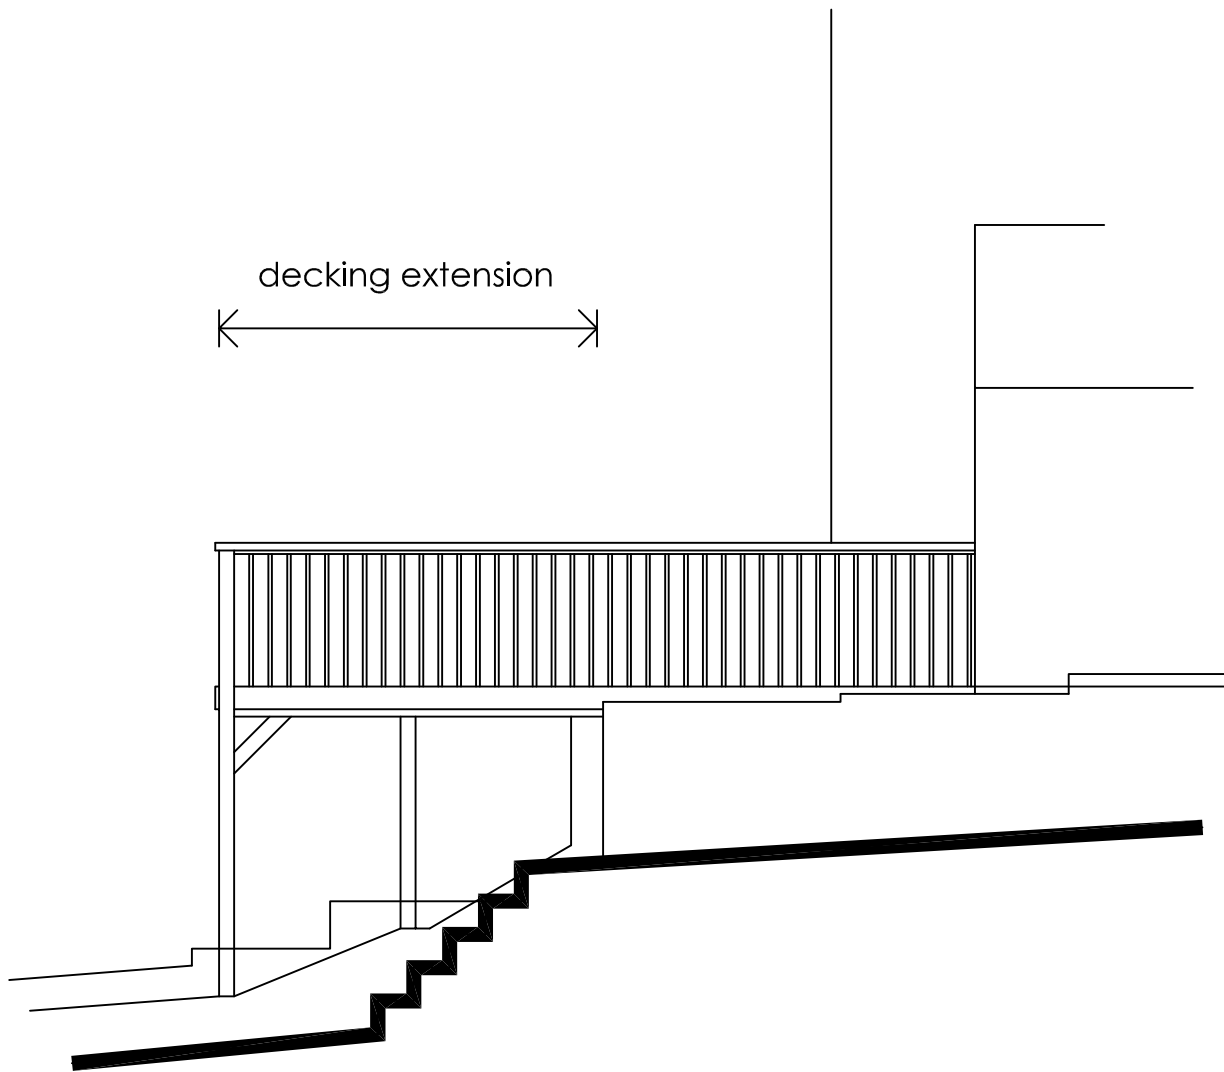

SIDE ELEVATION 1:50

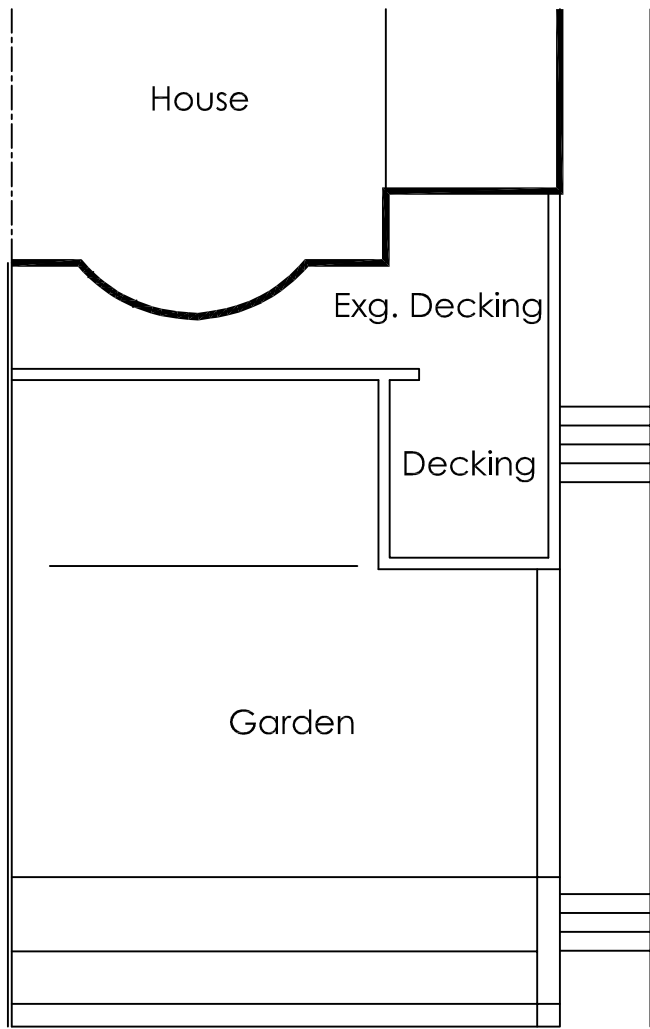


SITE PLAN

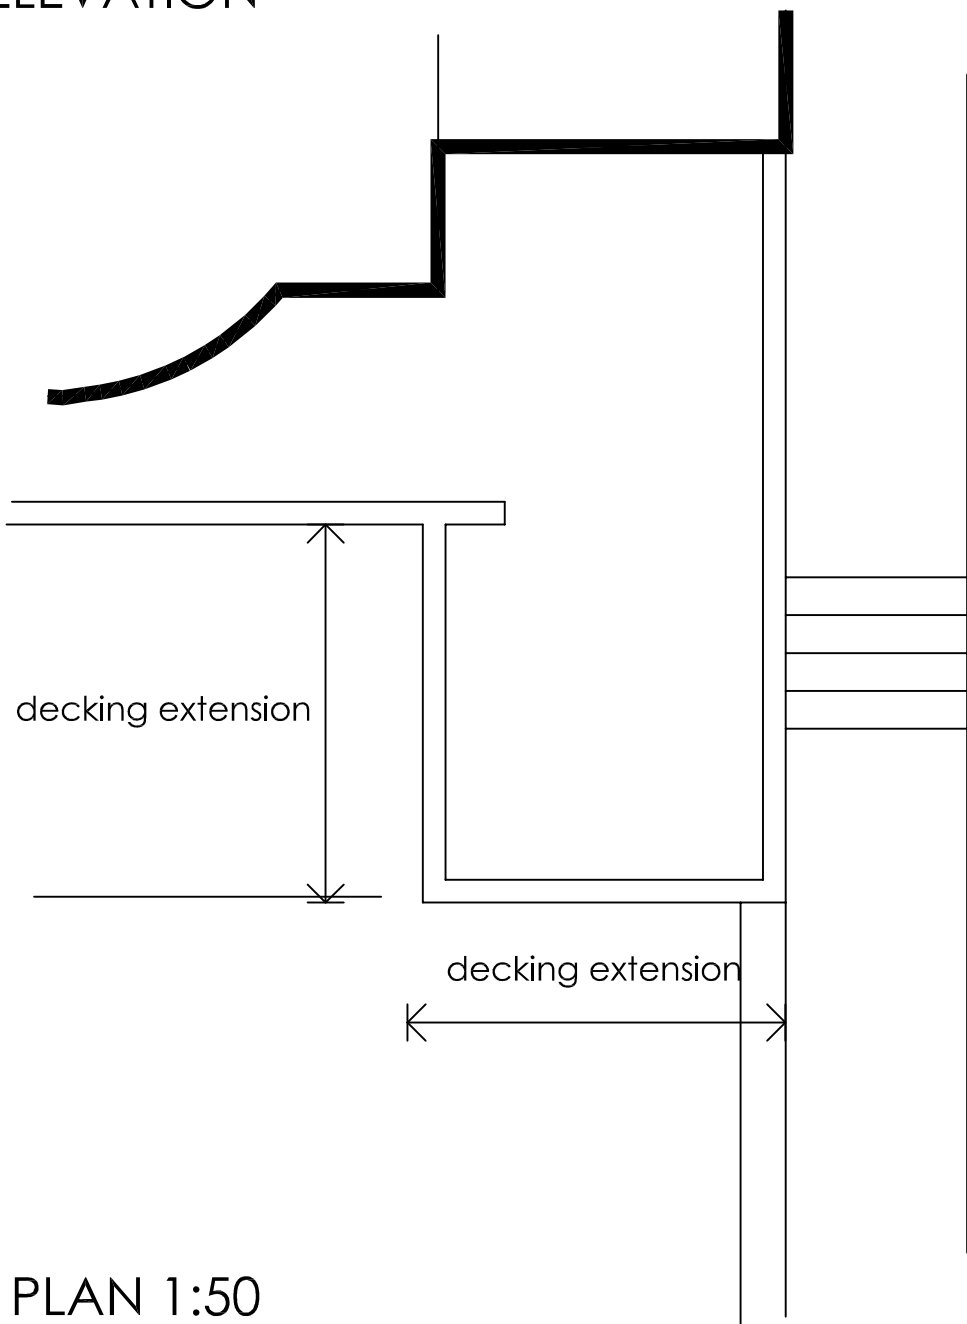

PLAN 1:50

Square One Architecture

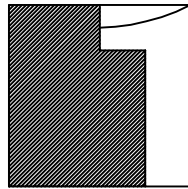

ARCHITECTURE

Architecture | Designers | Project Management

7 Hoyle Ing, Linthwaite, Huddersfield, HD7 5RX

Tel: (01484) 843346

Email: square1architecture@outlook.com

Web: squareonearchitecture.co.uk

Client.	L Wimpenny	Issue.	Retrospective App
---------	------------	--------	-------------------

Drawing Title

AS BUILT SURVEY DRAWING

This drawing is copyright

Job No.	W21074	Sheet No.	01	Revisions.	-
---------	--------	-----------	----	------------	---

Scale.	1:50, 1:100	Sheet Size.	A2	Date.	FEB 21	Drawn.	PDL
--------	-------------	-------------	----	-------	--------	--------	-----

Project.

RETROSPECTIVE APPLICATION FOR EXTENSION TO BALCONY / DECKING AREA AT 42 BRITANNIA RD, MILNSBRIDGE.