




THIS DRAWING IS COPYRIGHT, AND REMAINS THE PROPERTY OF
HTC ARCHITECTS. IT MUST NOT BE REPRODUCED, USED,
DISCLOSED OR TRANSMITTED TO THIRD PARTIES IN ANY FORM, IN
WHOLE OR IN PART, WITHOUT PRIOR WRITTEN PERMISSION.

DO NOT SCALE!
ALL DIMENSIONS SHOULD BE CHECKED ON SITE BEFORE
WORK COMMENCES

BOUNDARY SUBJECT TO TITLE PLAN CHECK

SUBJECT TO REVIEW OF LEVELS AND FALLS

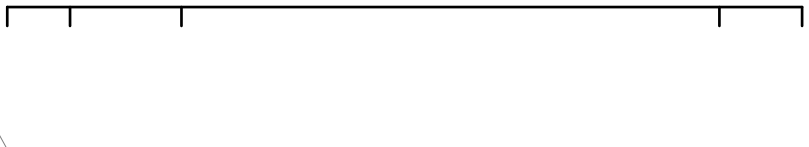

Rev.	Date	Description	Drawn
------	------	-------------	-------

htcarchitects

York Place Studio
8 Britannia Street
Leeds
LS1 2DZ

T: (0113) 244 3457

W: www.htcarchitects.co.uk

E: info@htcarchitects.co.uk

client
Tungsten Properties

project
M606 Bradford

drawing title
Previous scheme overlay

date **February 2021**
status **S73 Issue**
scale **1:500 @ A0**
drawn **AJ** checked **DW**
job no. **2454** dwg no. **PSK05** rev. -