




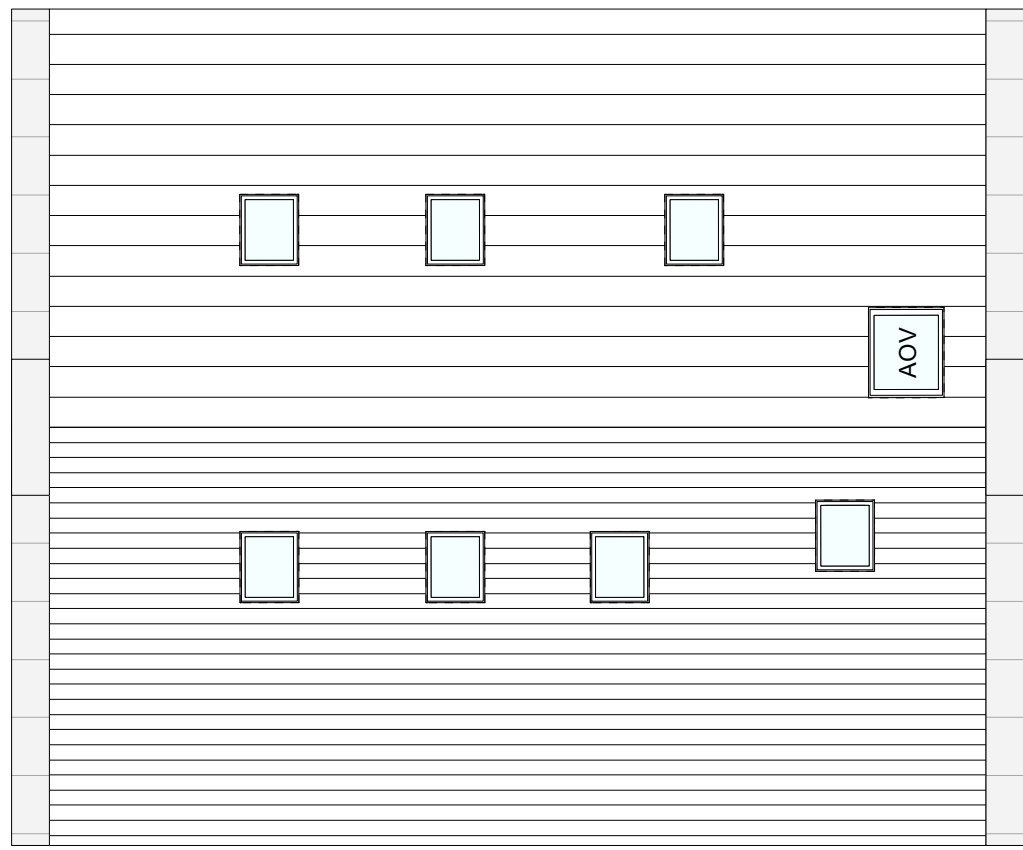


Roof Plan As Proposed
Scale 1:100

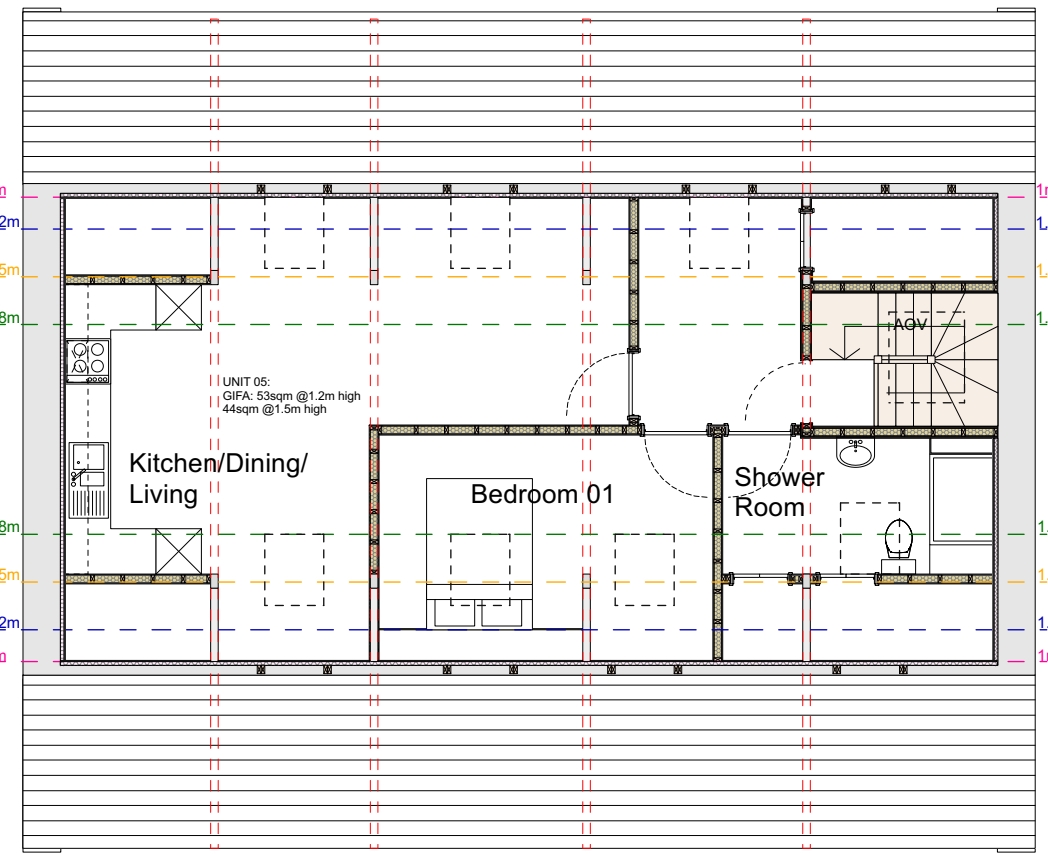

Second Floor As Proposed
Scale 1:100

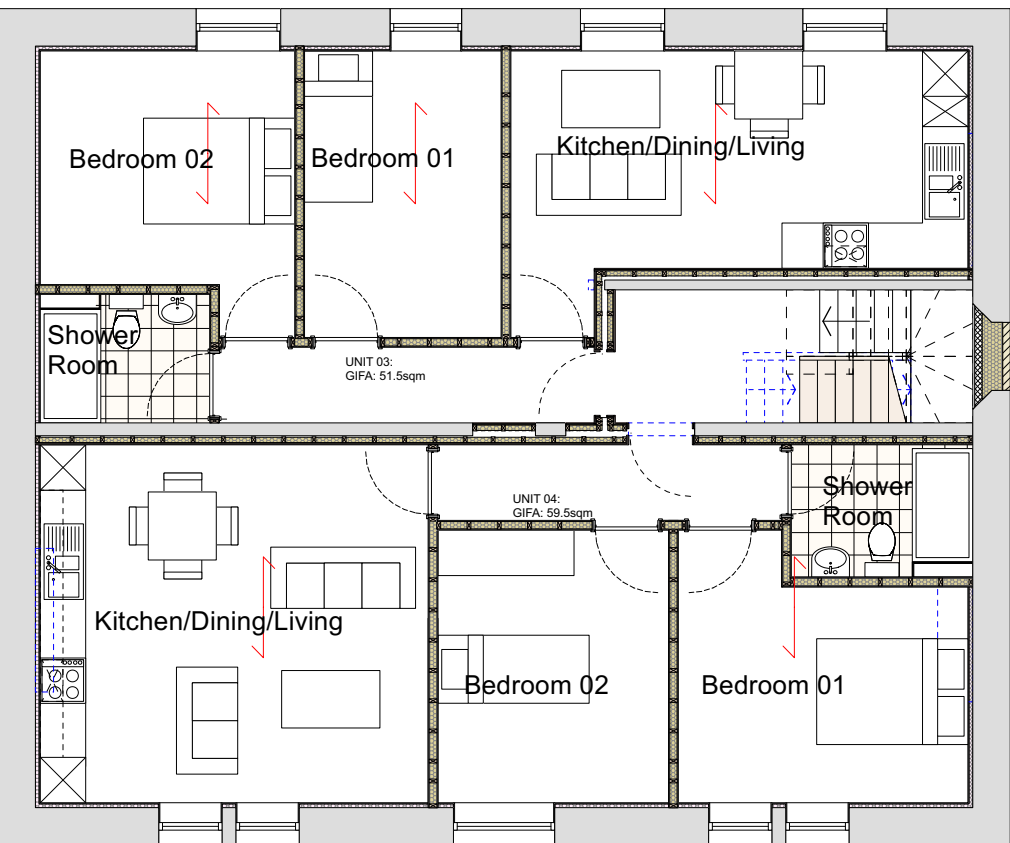

First Floor As Proposed
Scale 1:100

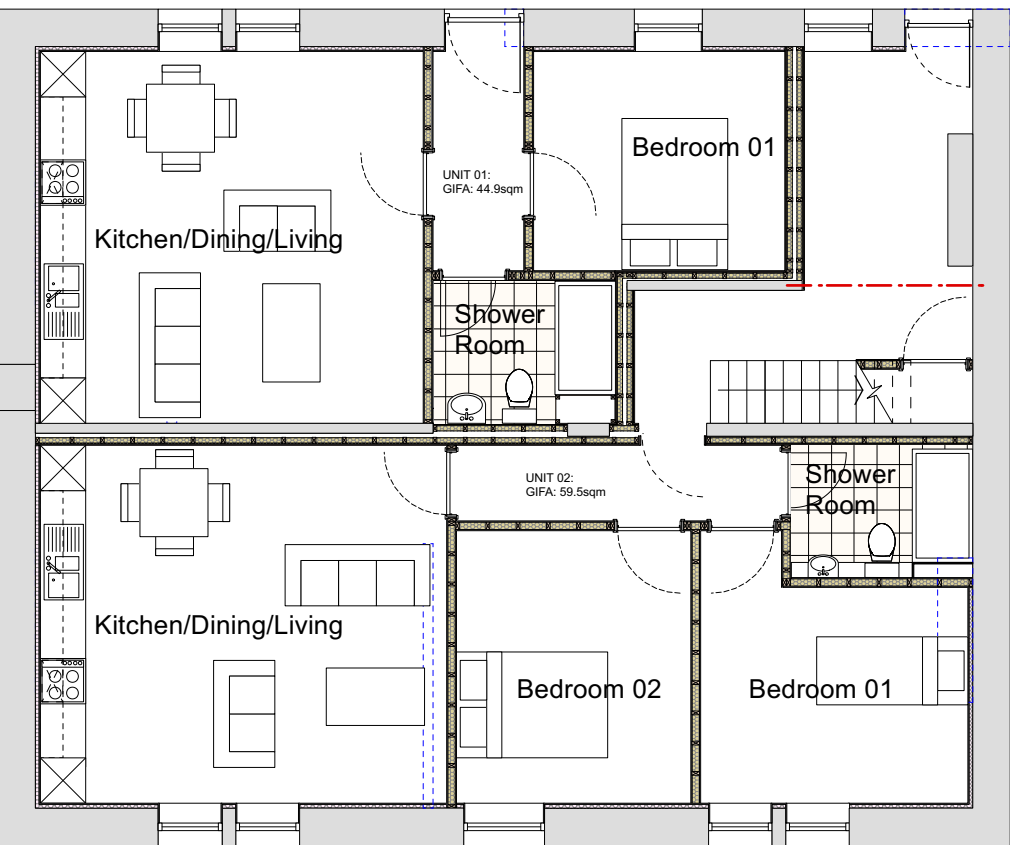


Ground Floor As Proposed
Scale 1:100




Rear Elevation As Proposed
Scale 1:100




Front Elevation As Proposed
Scale 1:100

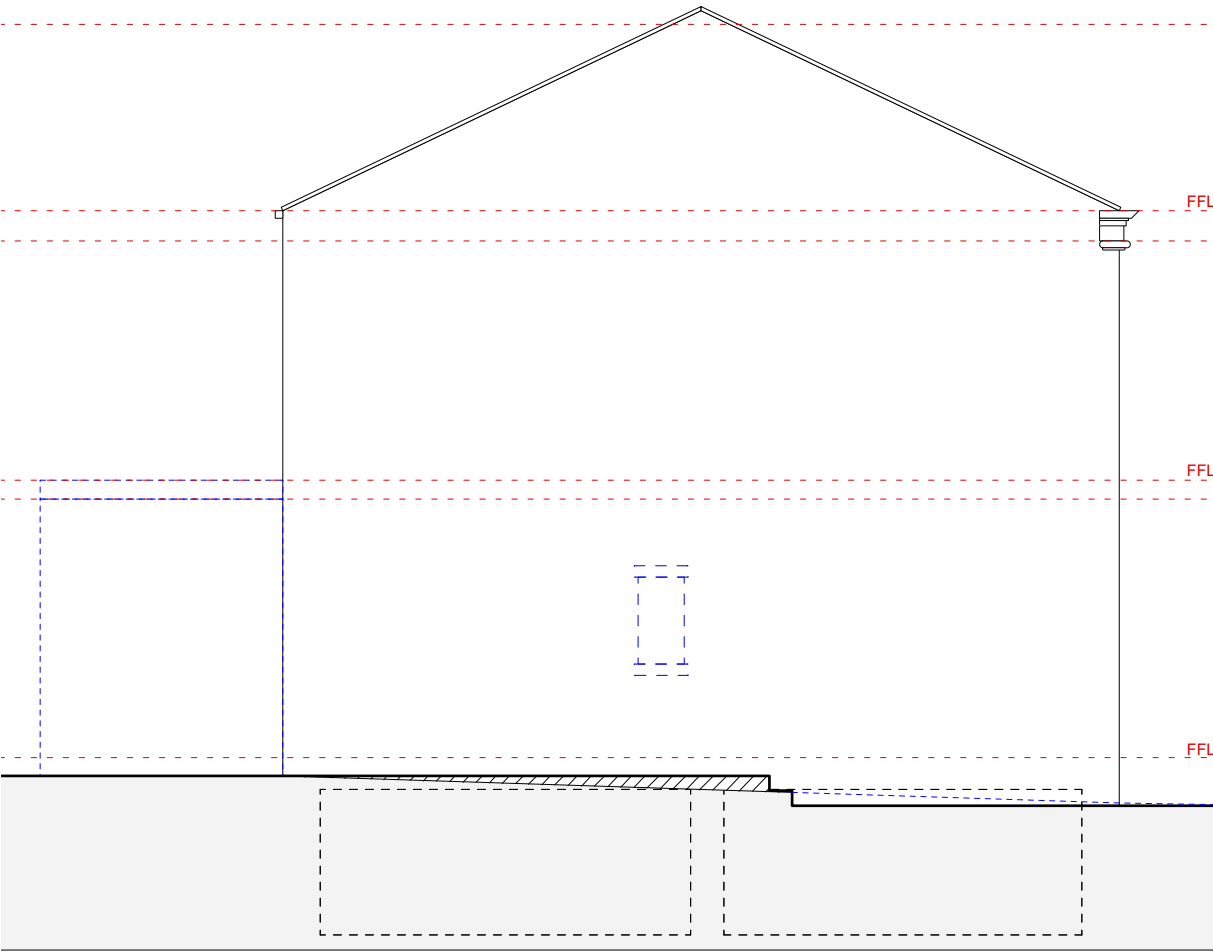


Side Elevation As Proposed
Scale 1:100

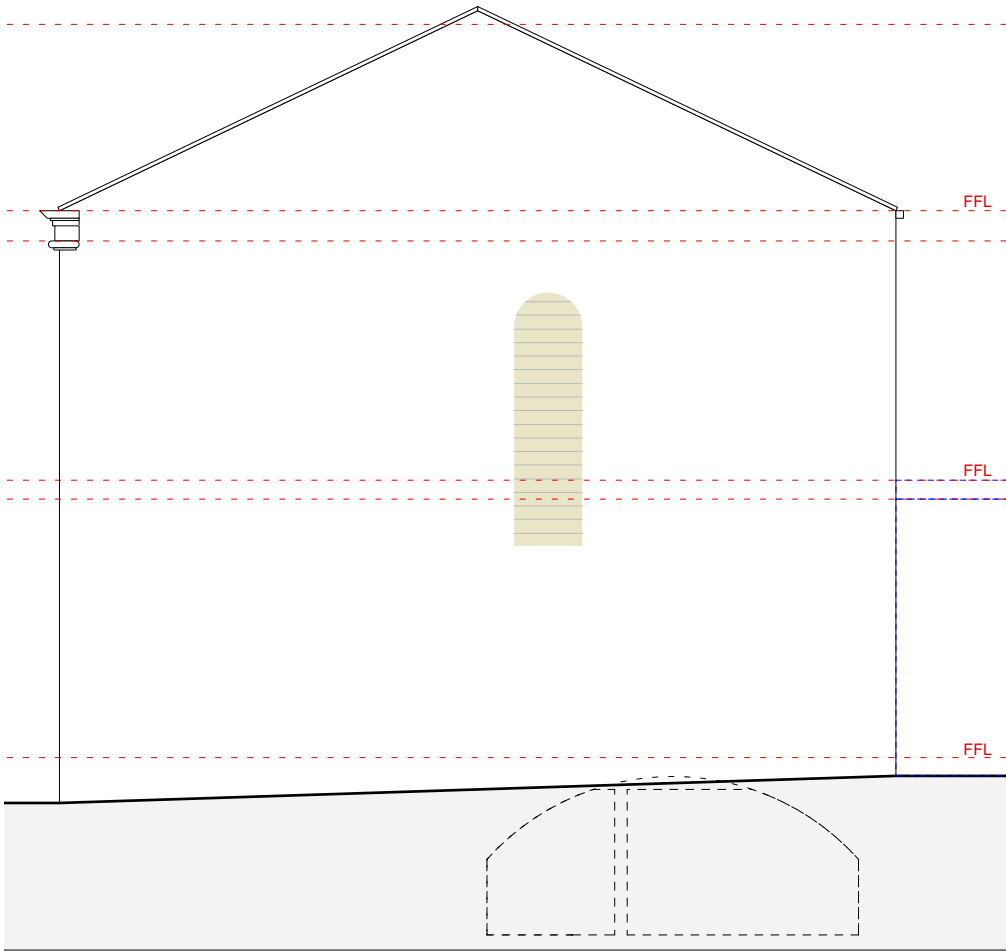

Side Elevation As Proposed
Scale 1:100

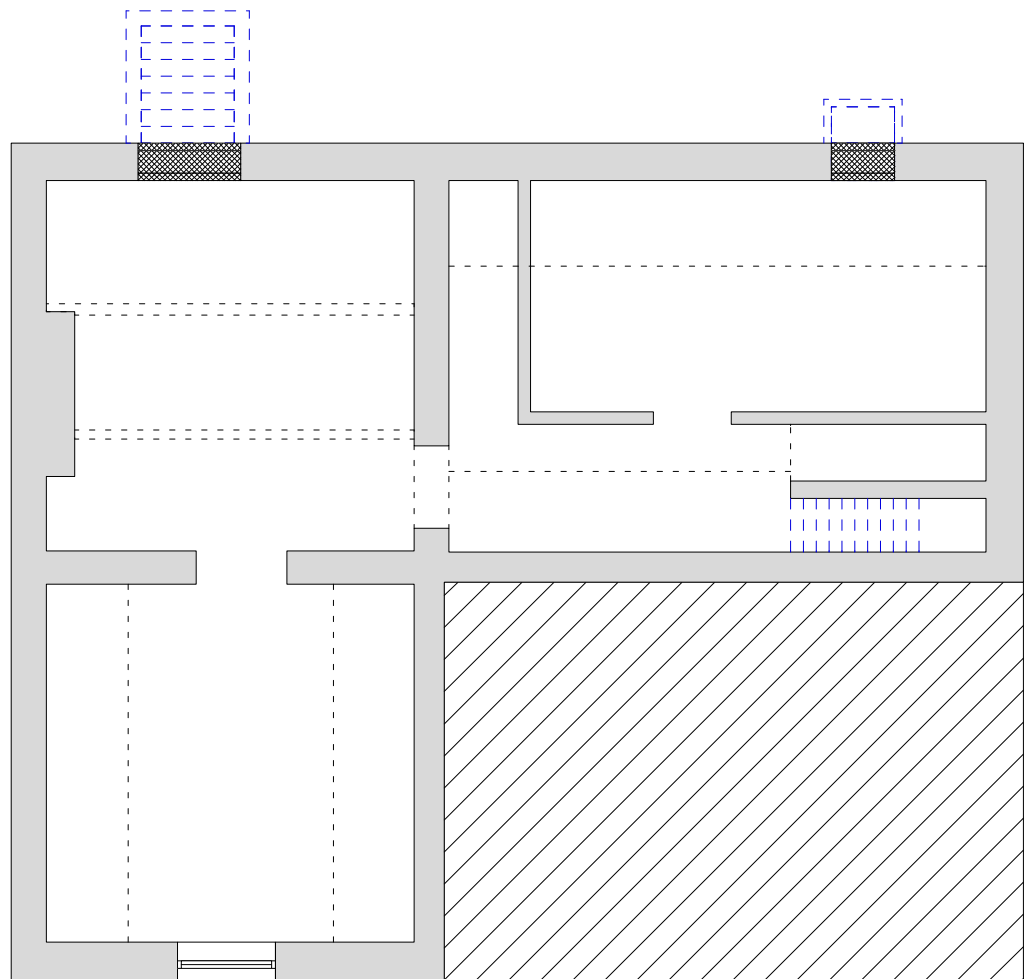

Basement No Change
Scale 1:100

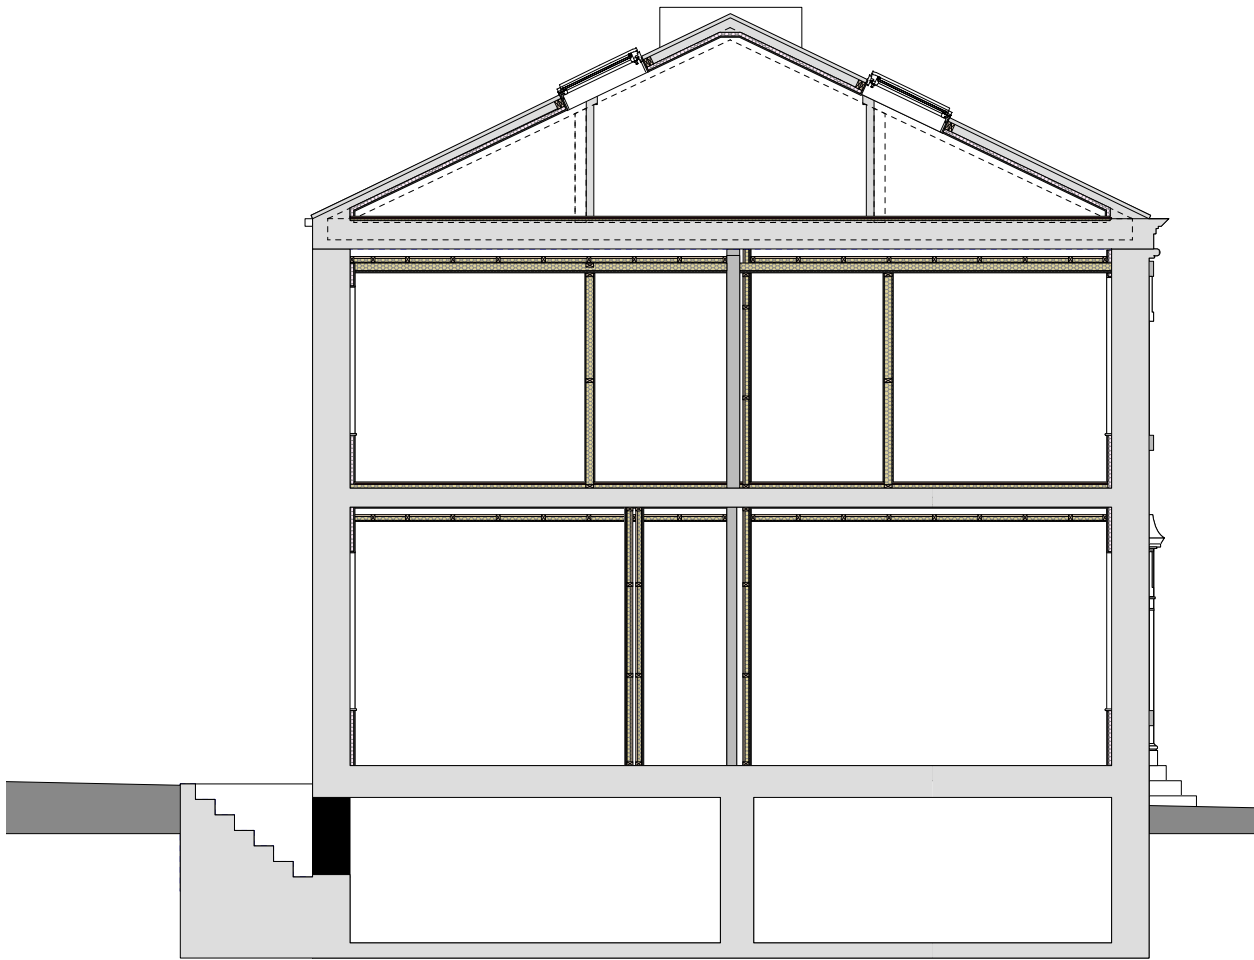

Typical Section As Proposed
Scale 1:100

AS PROPOSED/ AS BUILT

NOTES:
Any errors or omissions to be reported to Code L6 immediately.
This drawing and design is the copyright of Code L6 and is not to be used for any purpose without their consent.