

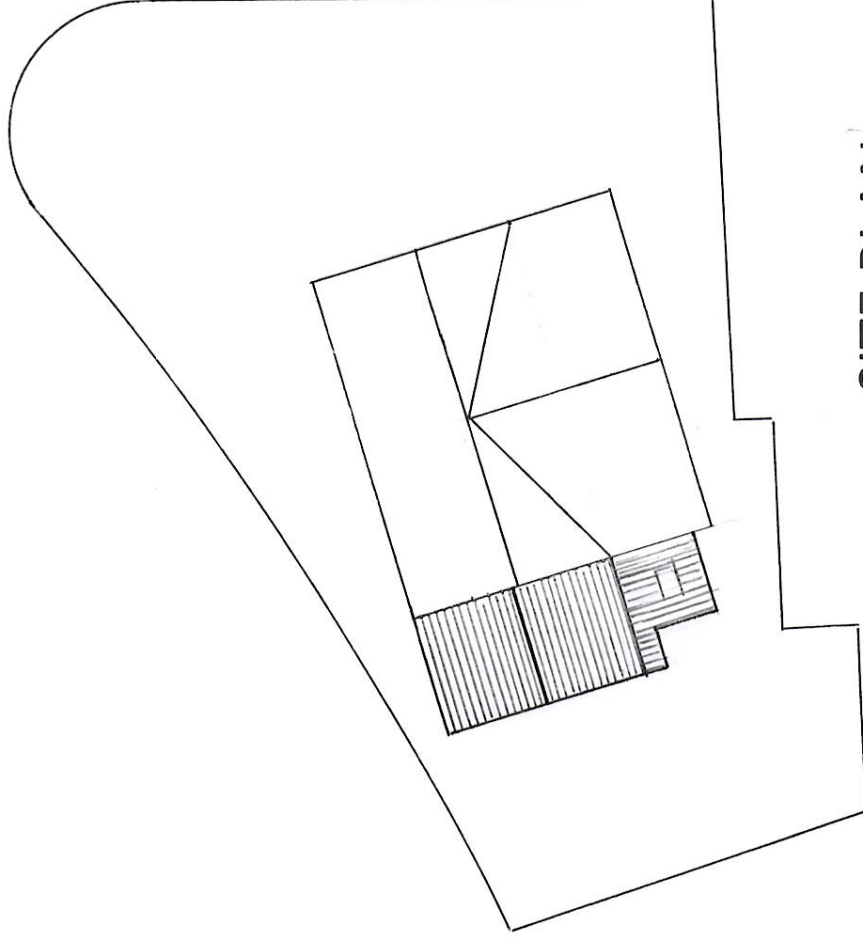


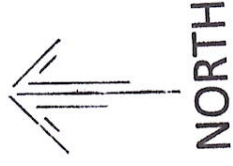

SITE PLAN  
1 : 200

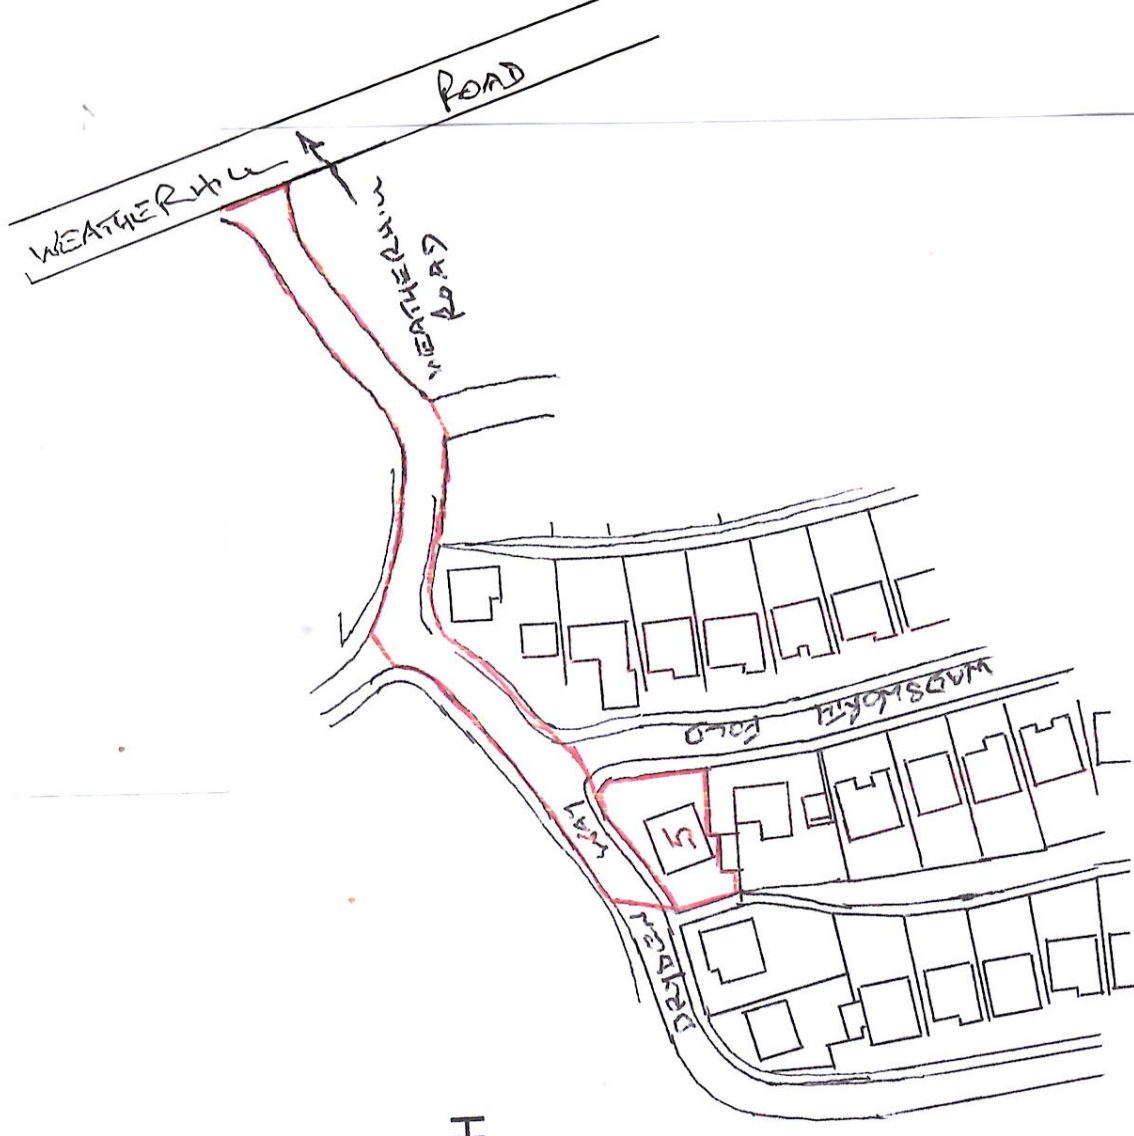

LOCATION PLAN  
1 : 1250

The information on this drawing is copyright. No part of which may be reproduced in any form, or stored in any retrievable system without prior permission from GH Drawing Service. The Contractor and Sub-Contractors are responsible for informing GH Drawing Service of any discrepancy on the relevant drawing/s and relevant documents. Works to comply with "The Party Wall Act 1996" as appropriate. Boundaries, dimensions and angles to be checked, on site, by the main contractor.

DESCRIPTION: Two Storey Side Extension

NAME: Afsaneh Eateessami

ADDRESS: 5 Dryden Way  
Huddersfield  
HD3 3YF

SCALE: As Shown DATE: May 2021

DRG No. GH/21/11/01 REV: ~~A~~ C

Geoff Haw. 44 Ash Tree Gardens, Halifax. HX2 8RS  
Tel: 01422 245491 email: [geoff.haw@sky.com](mailto:geoff.haw@sky.com)

REV. B Red Line EXTENDED