

Heritage Impact Statement


Lewisham Road, Slaithwaite

September 2022.


- 1.1 This statement has been prepared to accompany a planning application for a detached quite room at Empire House, Lewisham Road, Slaithwaite HD7 5AL and is to be read in conjunction with the Supporting Statement which accompanies the application.
- 1.2 The site is within the conservation of Slaithwaite (plan attached) and, whilst not defined as being within the District Centre, it is an important building in a prominent position which has a positive contribution to the conservation area.
- 1.3 The existing building is a large, imposing building with a lot of ornate stone detailing such as quoin corners, cornices, string courses, corbels and ashlar window surrounds.
- 1.4 The location of the extension is set back quite a distance from the road and due to this, and the existing retaining wall and foliage above it, the proposal will barely be seen from Lewisham Road.
- 1.5 Regardless of the above, the extension will contribute to the conservation area due to the nature of it's design, this being stone plinth with ornate timber pillars and cornices which are more in keeping than the original proposal.

As	Scale 1:50	As
On	Scale 1:100	On
On	Scale 1:200	On
On	Scale 1:500	On
On	Scale 1:1000	On
On	Scale 1:2500	On


(When 1/2 scale of original plan has been used)

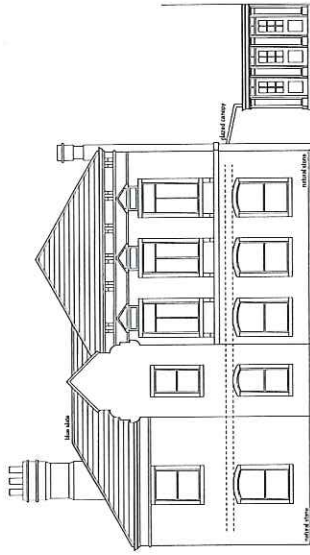


Proposed front elevation (1:100)

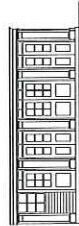

Proposed side elevation (1:100)

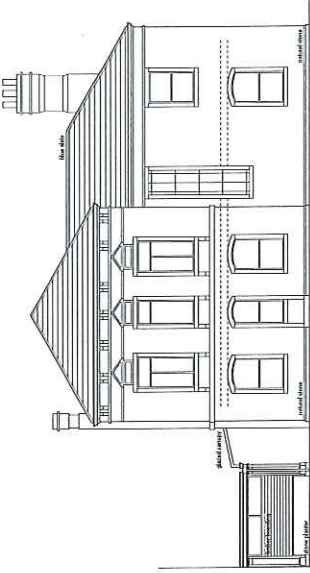


Proposed rear elevation (1:100)

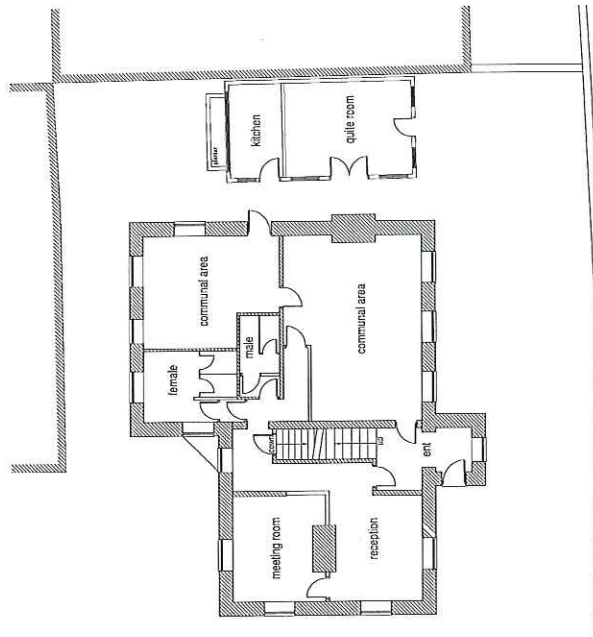

Proposed ground floor layout (1:100)




Location plan (1:1250)

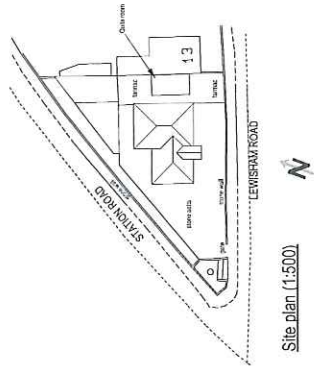

Site plan (1:500)

Rev B 10/05/2020 As built layout and elevations drawn.
Rev A 05/05/2020 Amended following comments from conservation officer.

Project	Proposed Extension.
Address	Former Town Hall Lewisham Road Slathwaite.
Title	Planning Drawing.
Drawing number	P 01 B.
Date	Feb 2020.

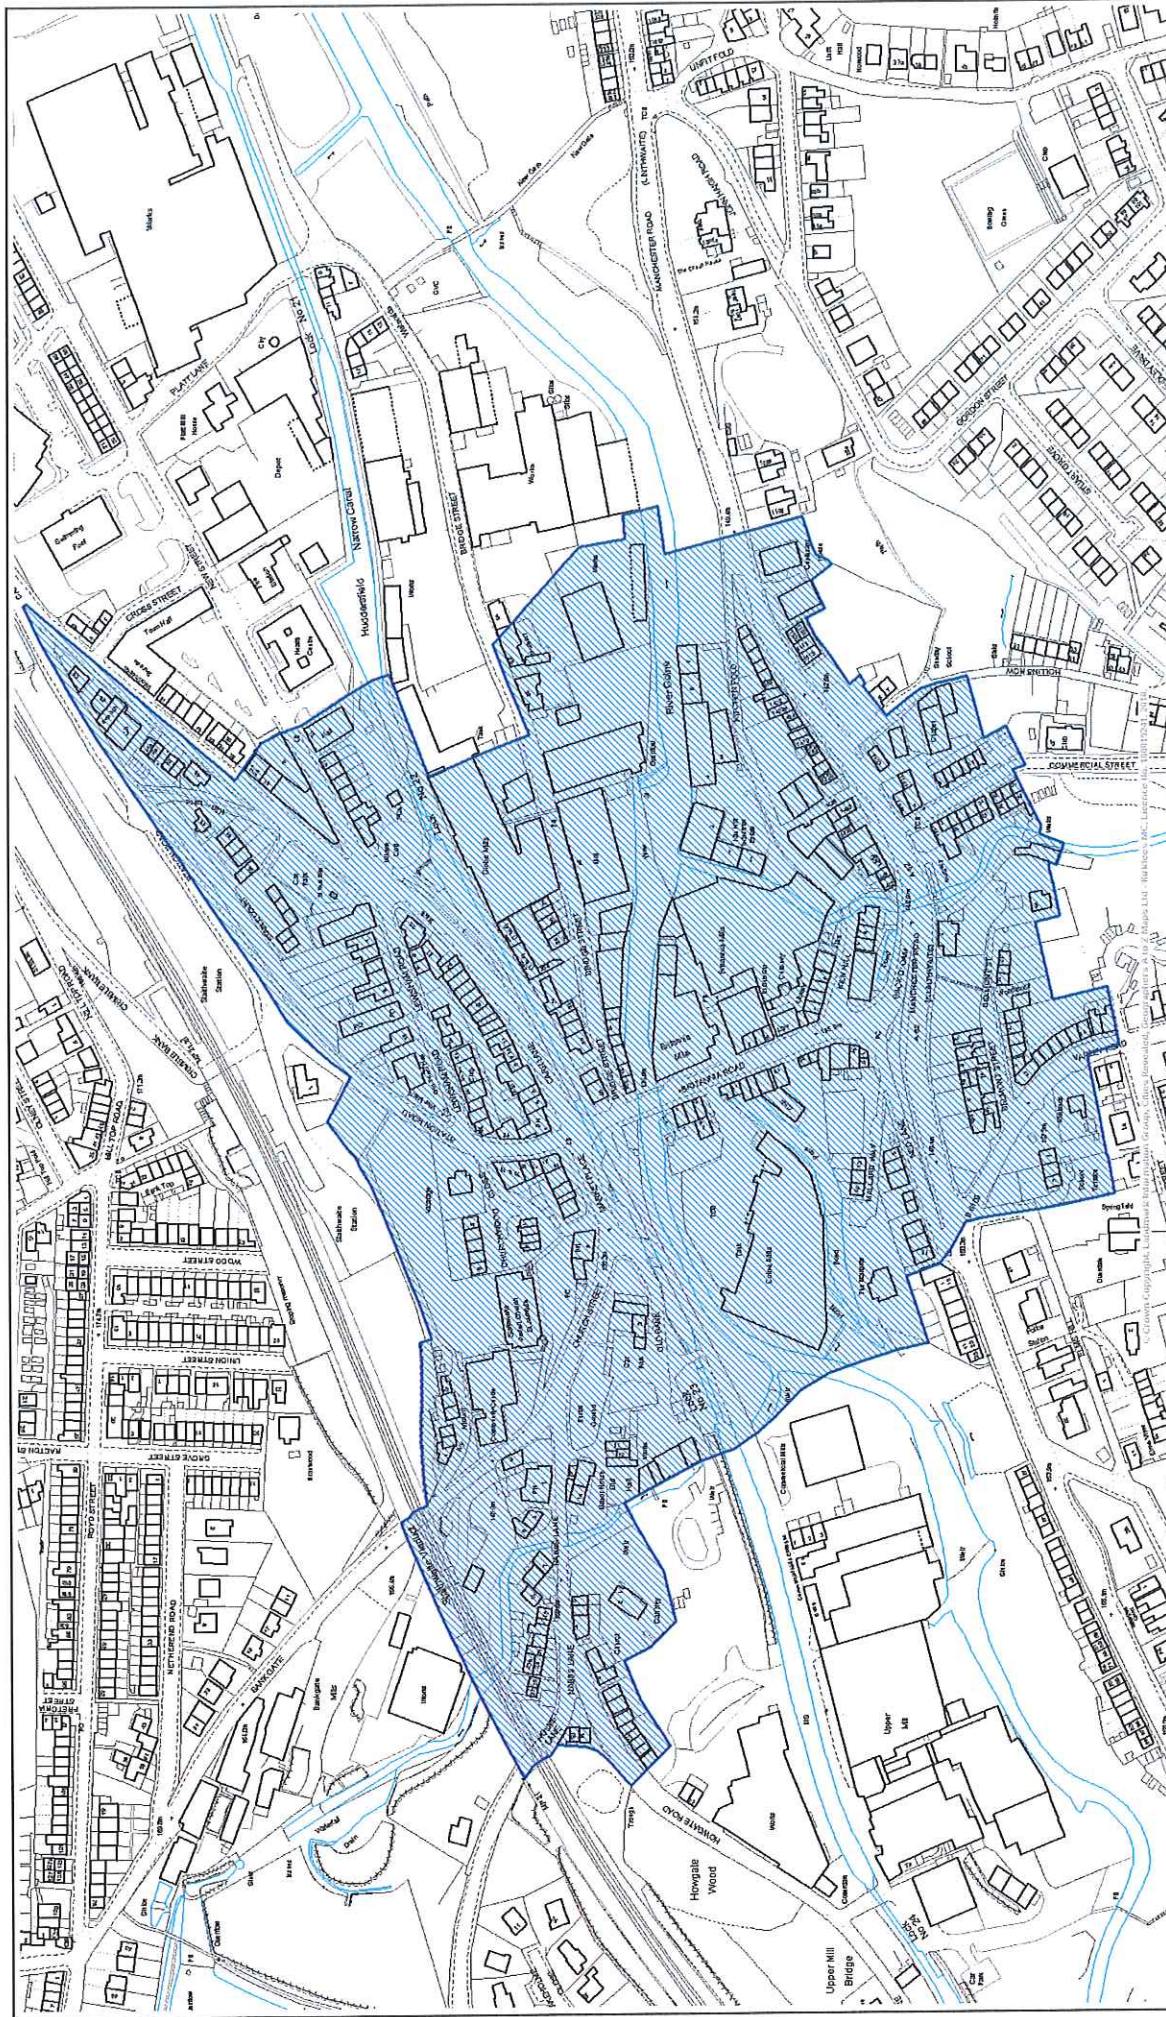

Kirklees MC - Planning Service

Scale 1/3500

Date 14/4/2010

OS Grid Ref of Centre = 408005 E 413984 N

This copy has been produced for Planning and Building Control purposes only.

NO FURTHER COPIES MAY BE MADE

Reproduced from the Ordnance Survey mapping with the permission of the Controller of Her Majesty's Stationery Office © Crown Copyright.
Unauthorised reproduction infringes Crown Copyright and may lead to prosecution or civil proceedings.

Kirklees Metropolitan Council - Licence Number: 100019241, 2009