





Proposed front elevation (1:100)




Proposed side elevation (1:100)

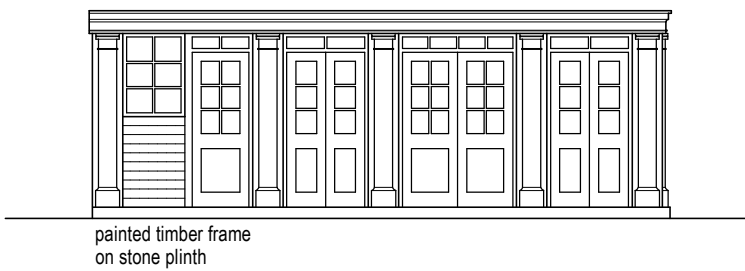


Proposed rear elevation (1:100)

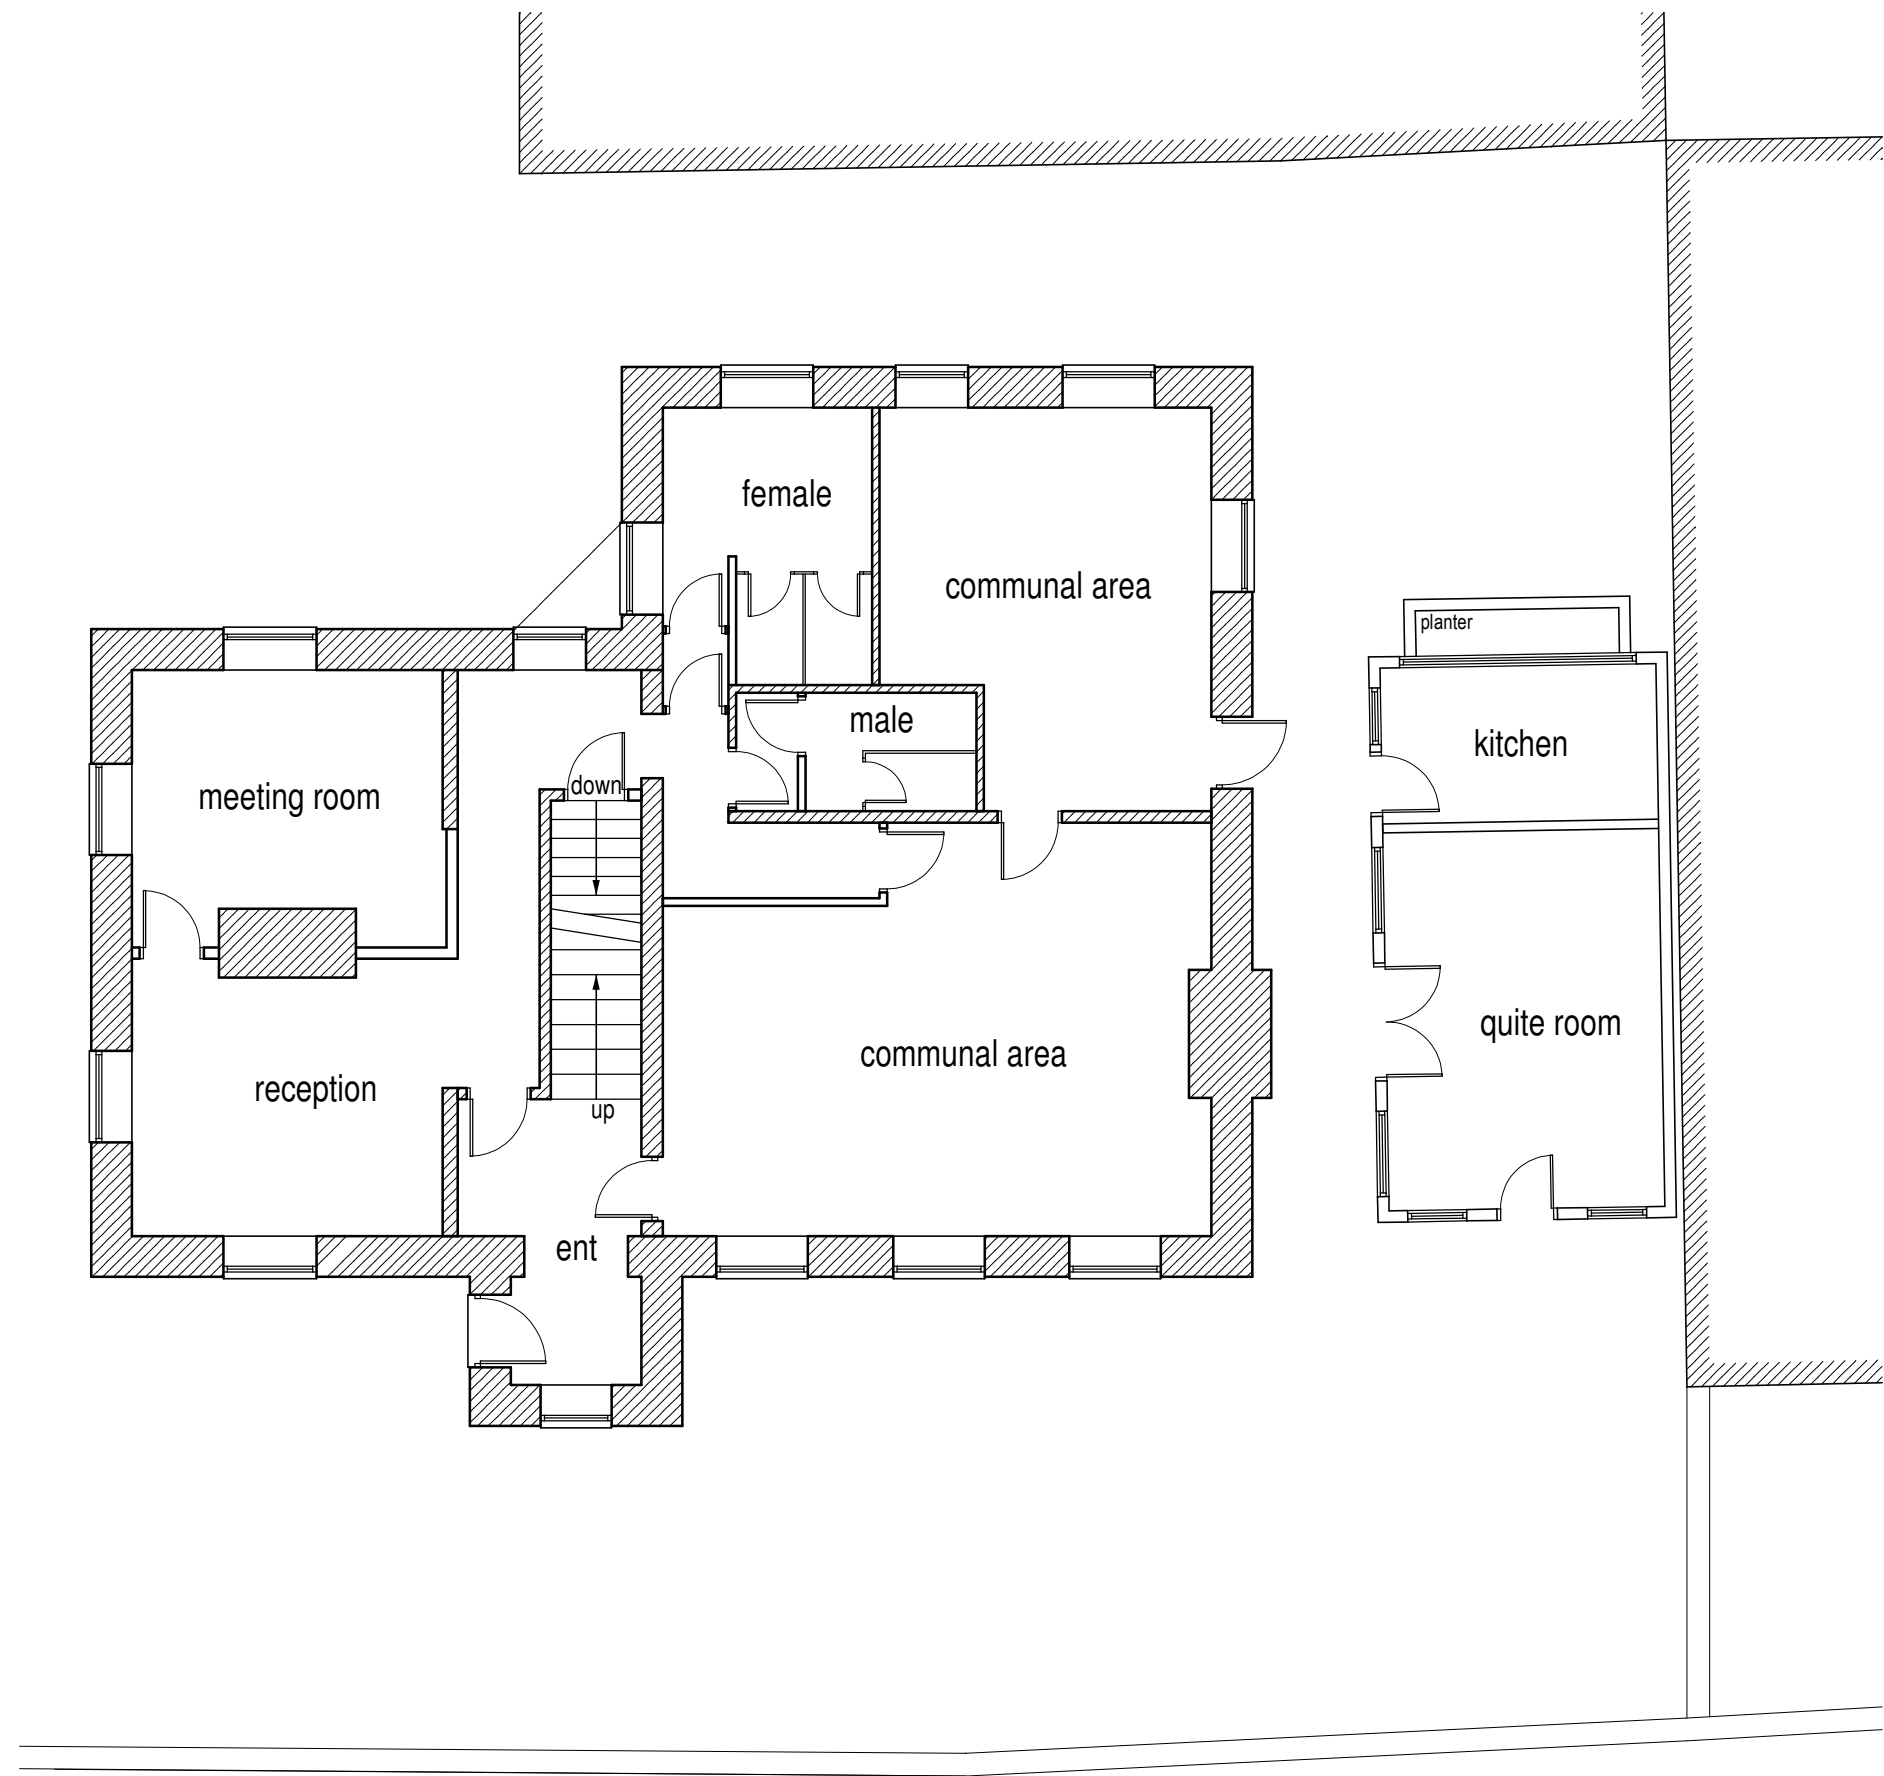

Proposed ground floor layout (1:100)

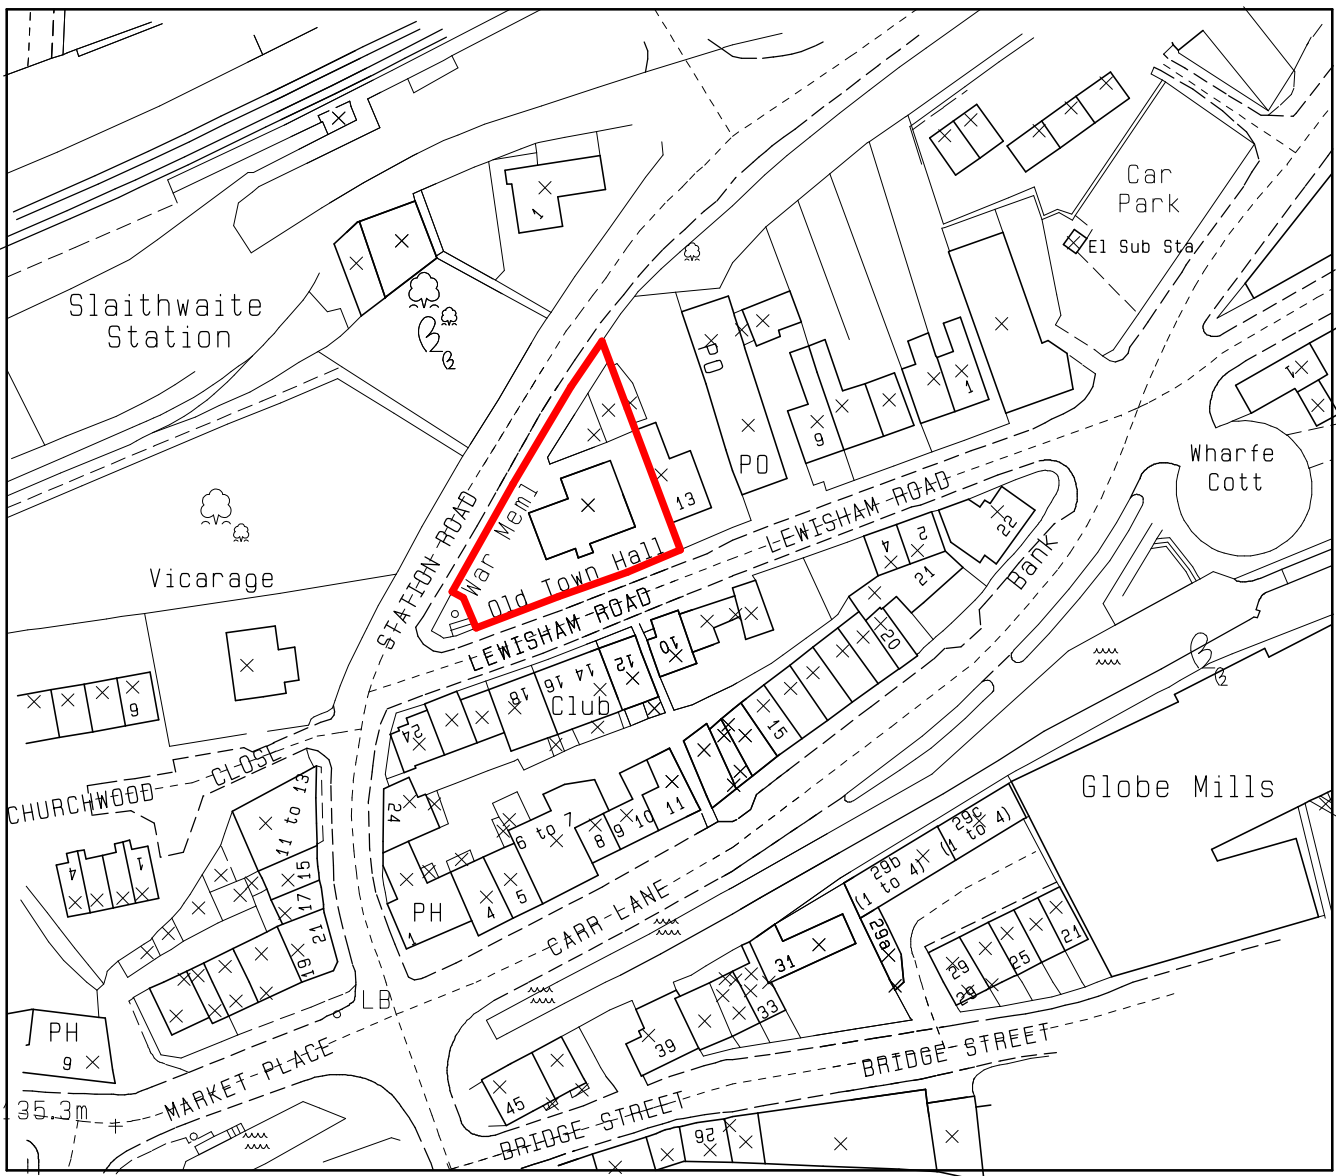

Location plan (1:1250)

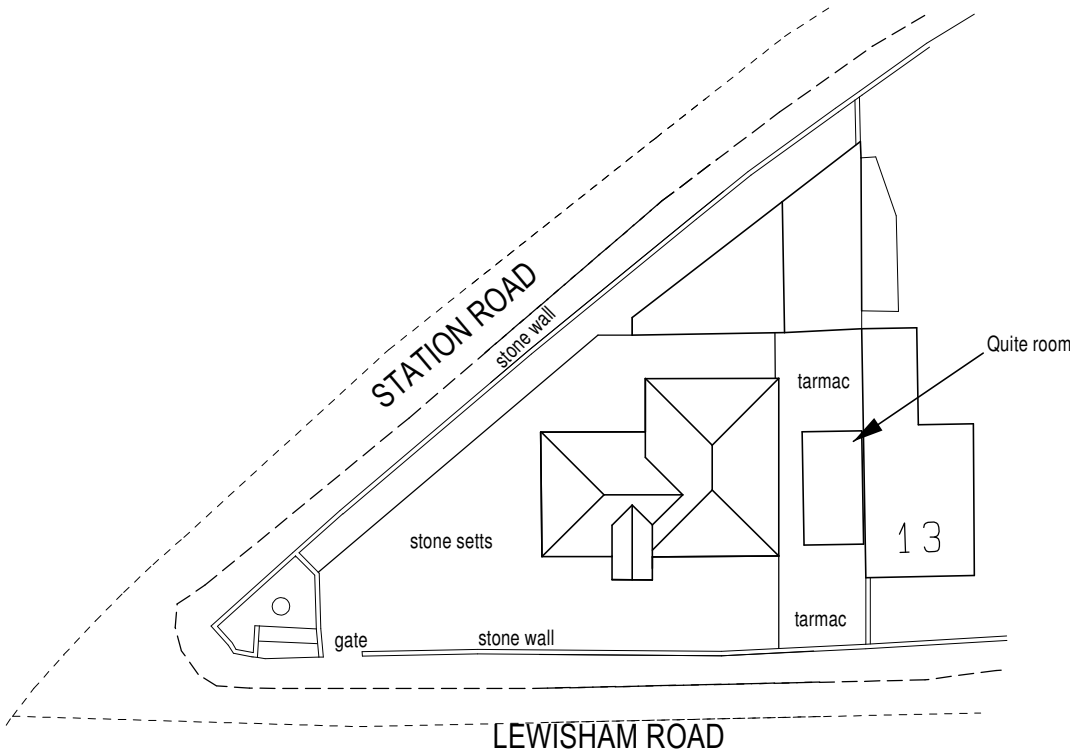

Site plan (1:500)

Rev B 10/08/2020 As built layout and elevations drawn.
Rev A 05/05/2020 Amended following comments from conservation officer.

Project Proposed Extension.	
Address Former Town Hall Lewisham Road Slaithwaite.	
Title Planning Drawing.	
Drawing number P 01 B.	Date Feb 2020.