
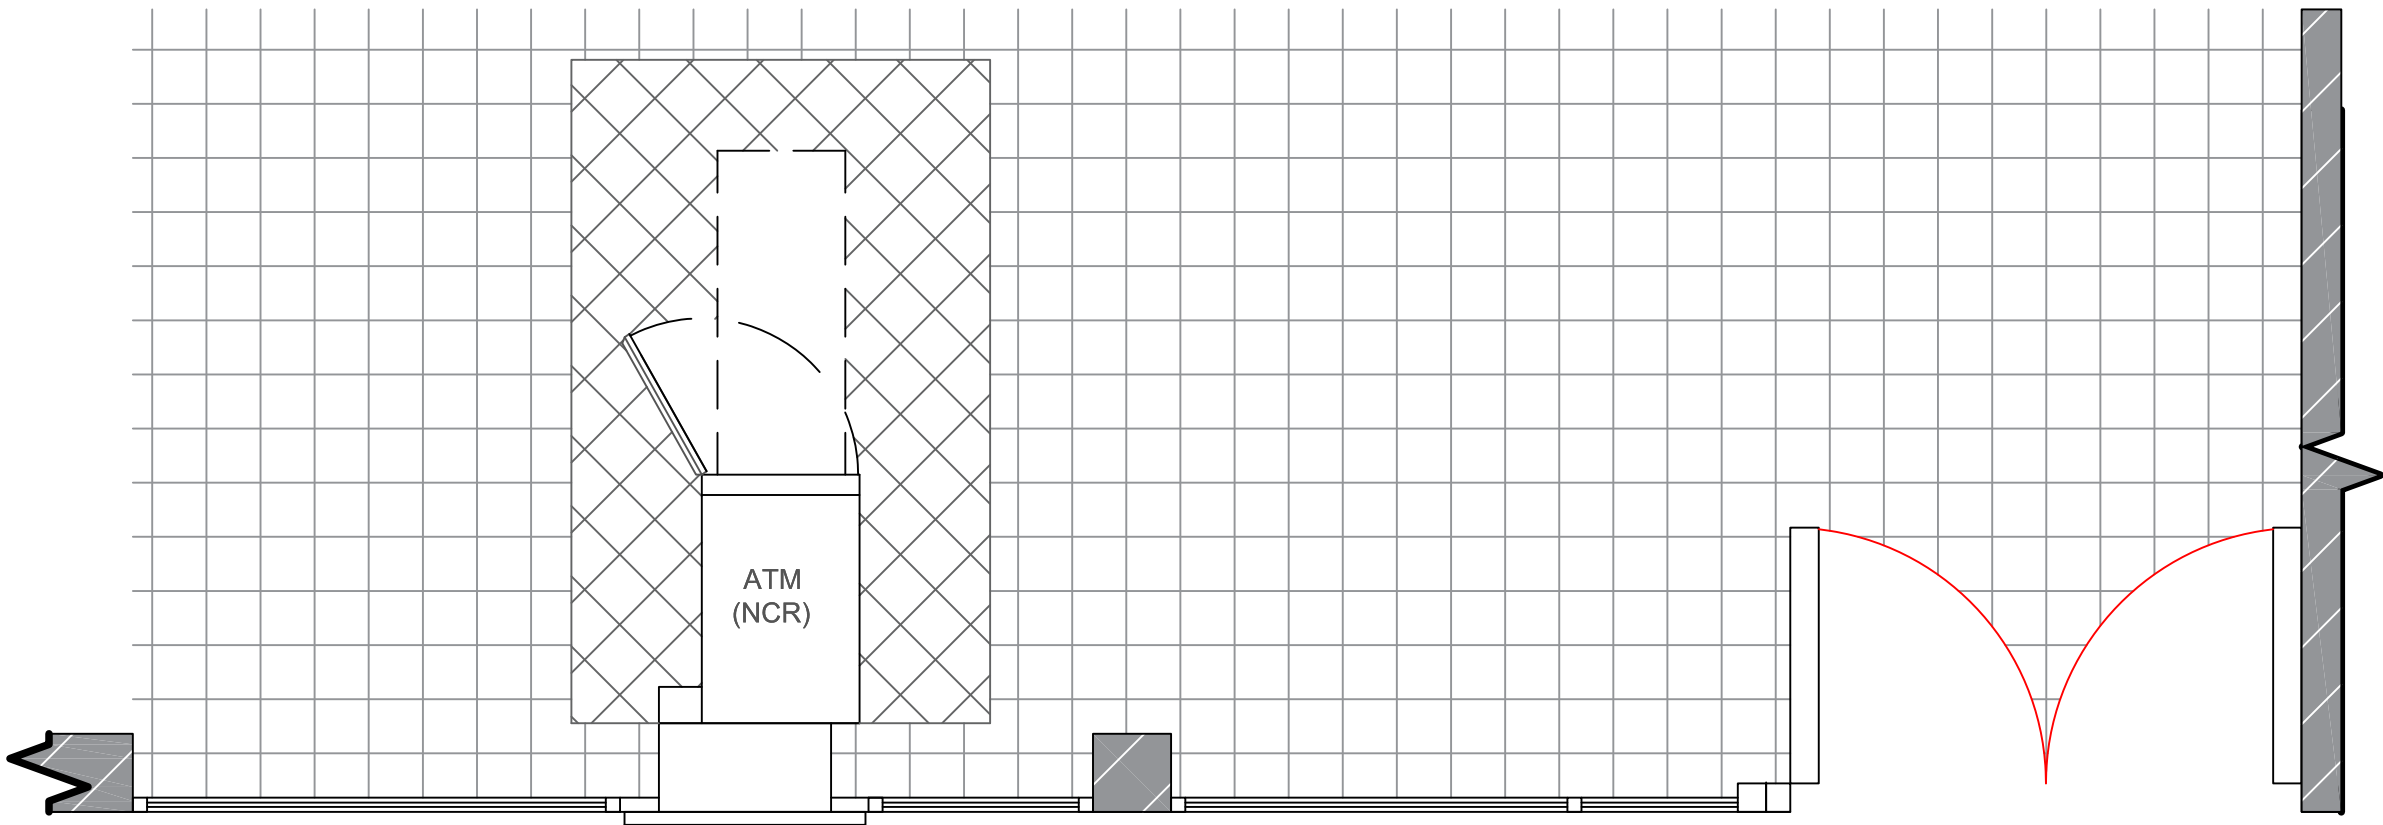


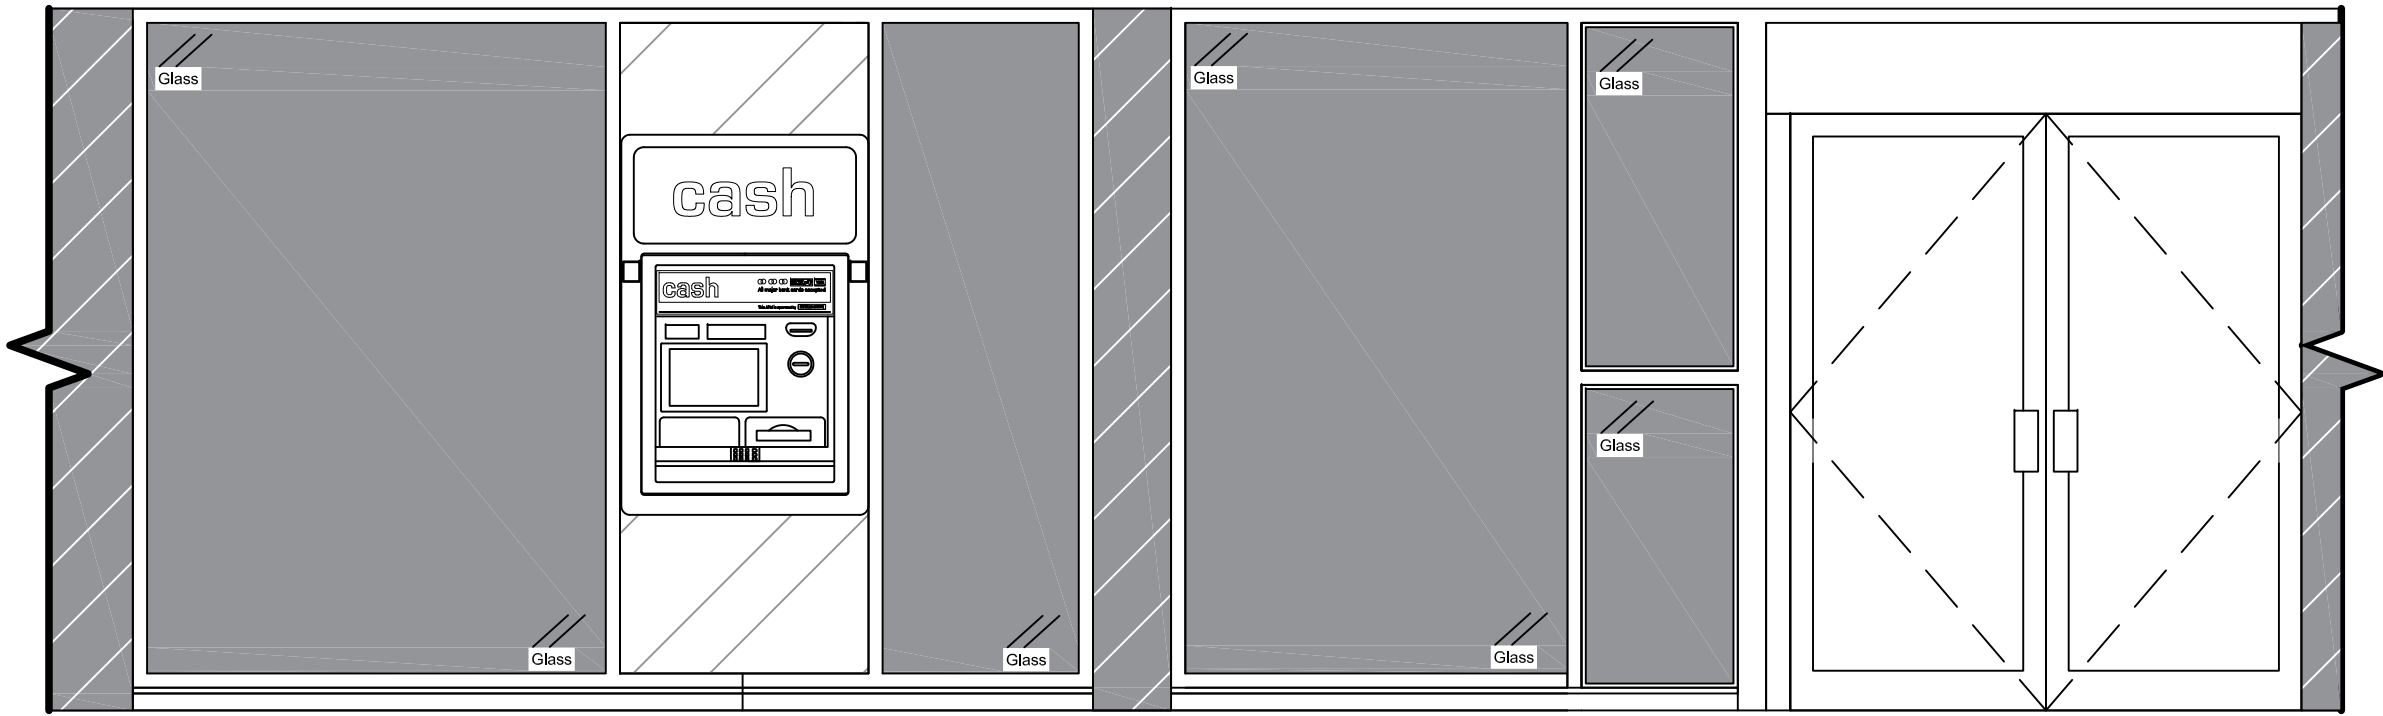

DATE:	COMMENTS:	BY:
-------	-----------	-----

SITE:
PREMIER
30 CHURCH STREET
DEWSBURY
WF13 1LB

DRAWING TITLE:
AS INSTALLED PLAN
AND ELEVATION

REF: 3476693_AI	DATE: 19/01/2023
---------------------------	----------------------------

SCALE: 1:50	PAPER: A3
-----------------------	---------------------