


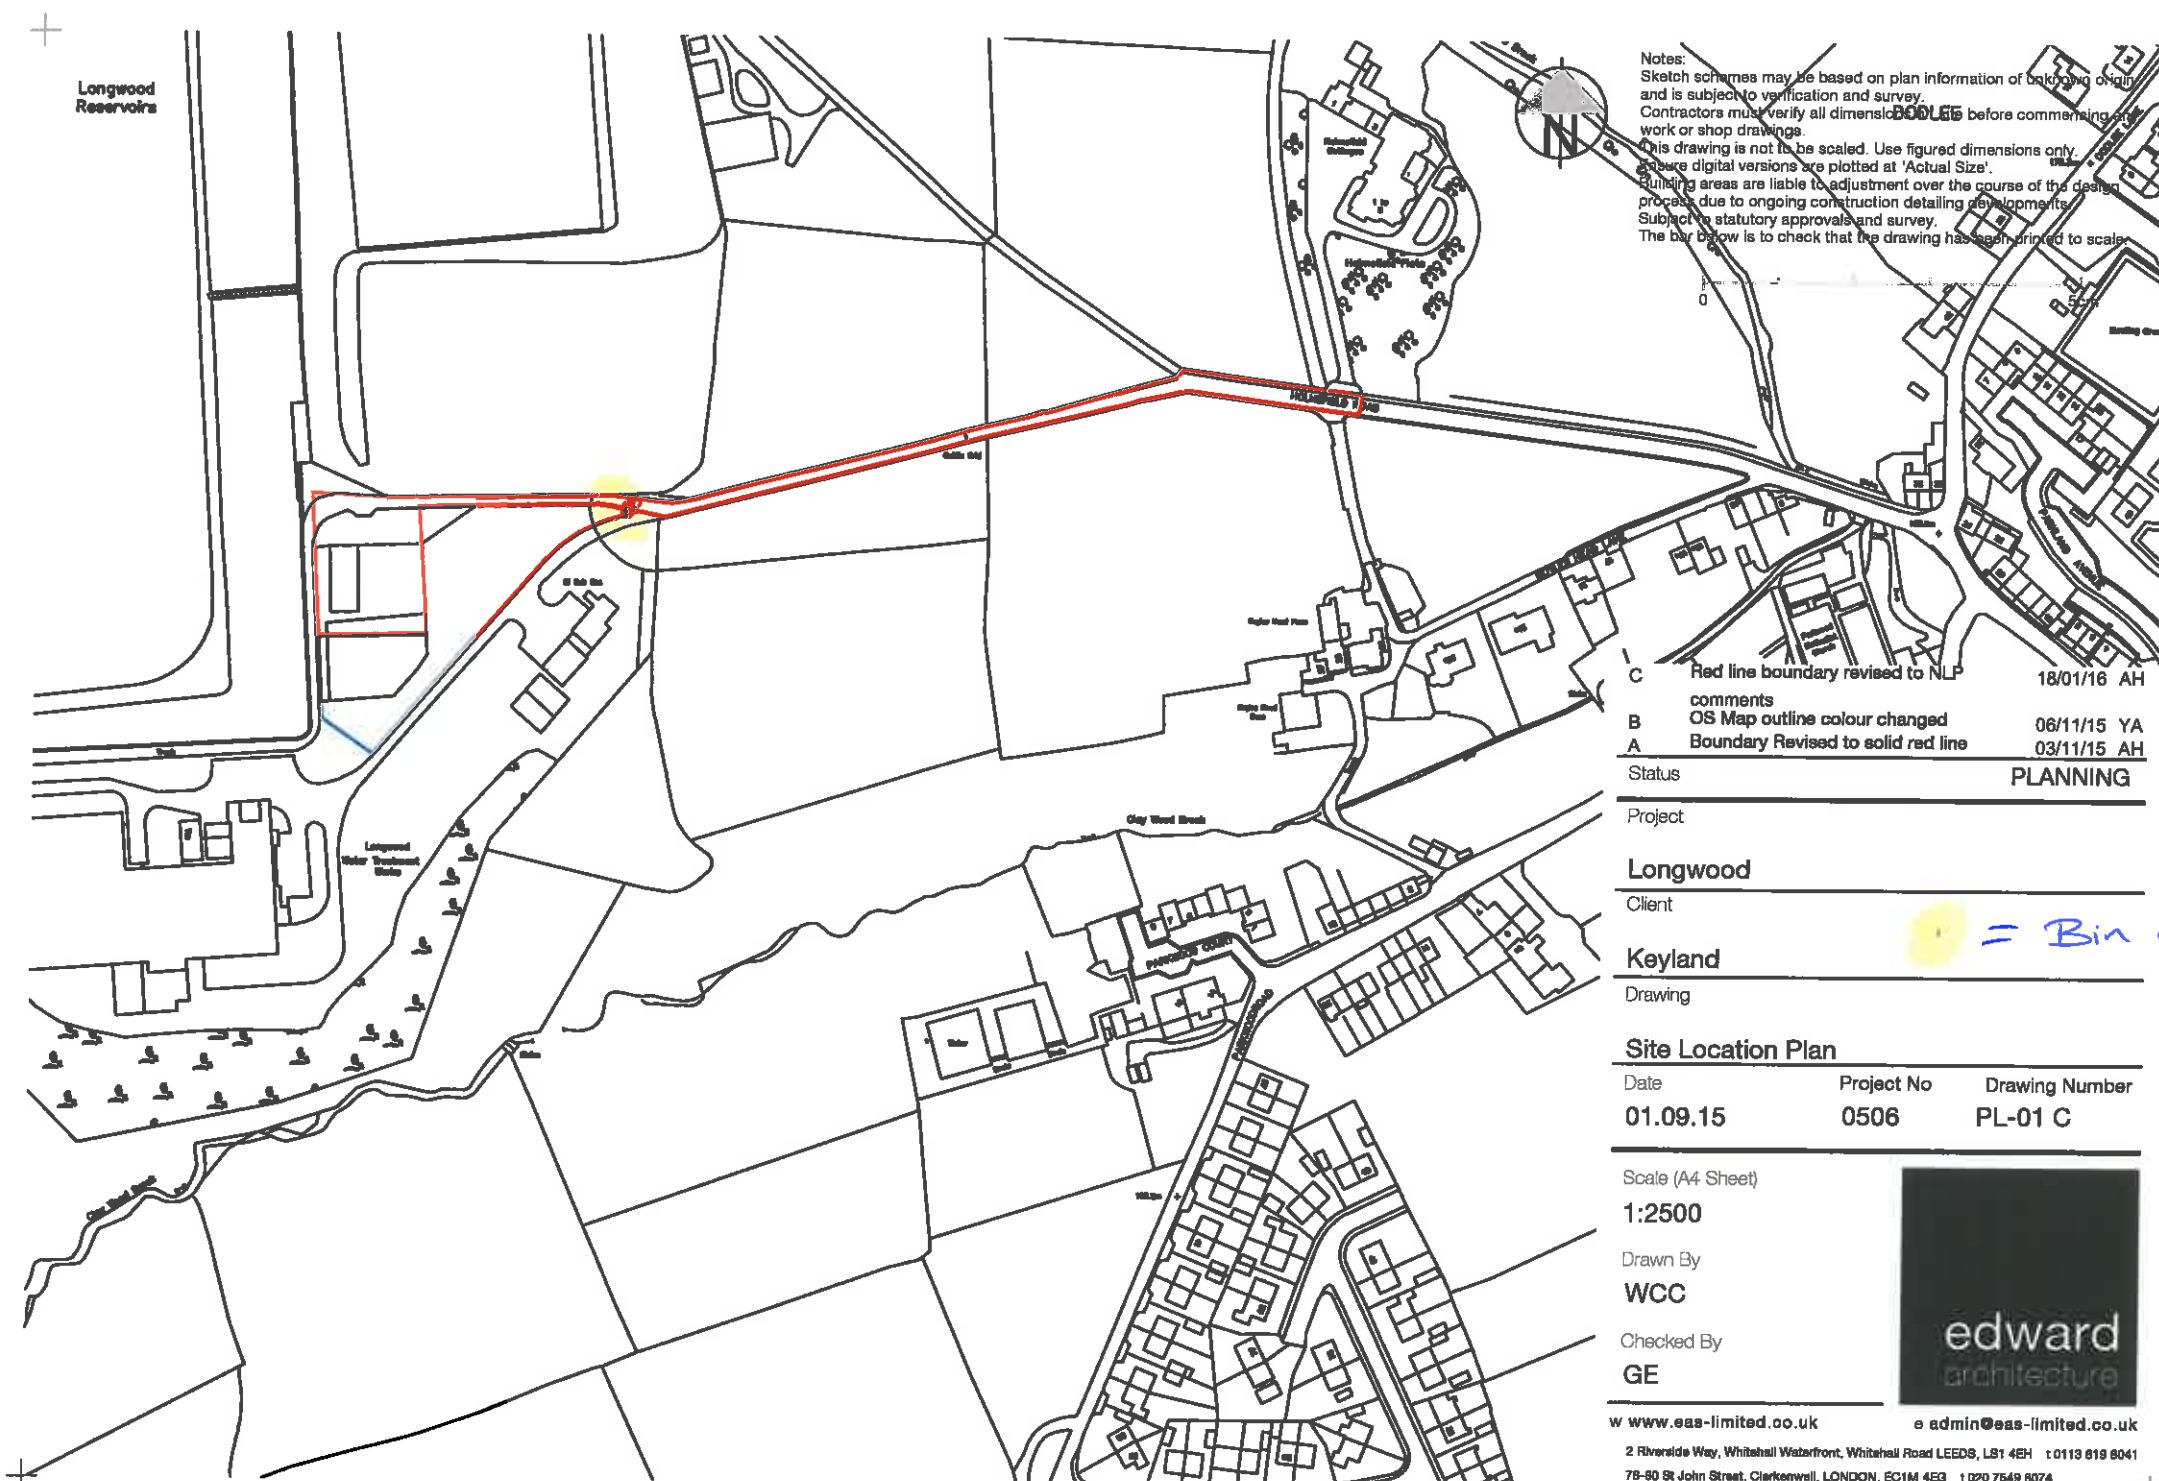


Notes:
Sketch schemes may be based on plan information of unknown origin and is subject to verification and survey.
Contractors must verify all dimensions before commencing any work or shop drawings.
This drawing is not to be scaled. Use figured dimensions only.
Where digital versions are plotted at 'Actual Size'.
Building areas are liable to adjustment over the course of the design process due to ongoing construction detailing developments.
Subject to statutory approvals and survey.
The bar below is to check that the drawing has been printed to scale.

C	Red line boundary revised to NLP	18/01/16	AH
B	OS Map outline colour changed	06/11/15	YA
A	Boundary Revised to solid red line	03/11/15	AH
Status		PLANNING	

Project
Longwood
Client
Keyland
Drawing

Site Location Plan		
Date	Project No	Drawing Number
01.09.15	0506	PL-01 C

Scale (A4 Sheet)
1:2500
Drawn By
WCC
Checked By
GE

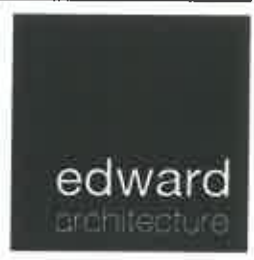

w www.eas-limited.co.uk e admin@eas-limited.co.uk
2 Riverside Way, Whitehall Waterfront, Whitehall Road LEEDS, LS1 4EH t 0113 819 8041
78-80 St John Street, Clerkenwell, LONDON, EC1M 4EQ t 020 7549 8074

= Bin collection point