



SECTION LOCATION PLAN SCALE 1:500

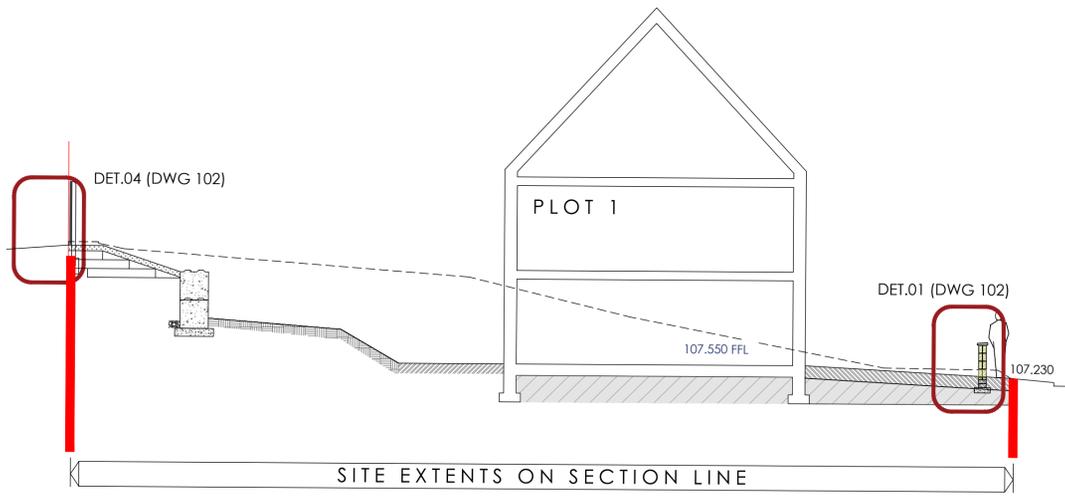

SITE SECTION 1 SCALE 1:100
section details taken from structural engineers drawing 5879-101 and AIP as agreed with highways dept.

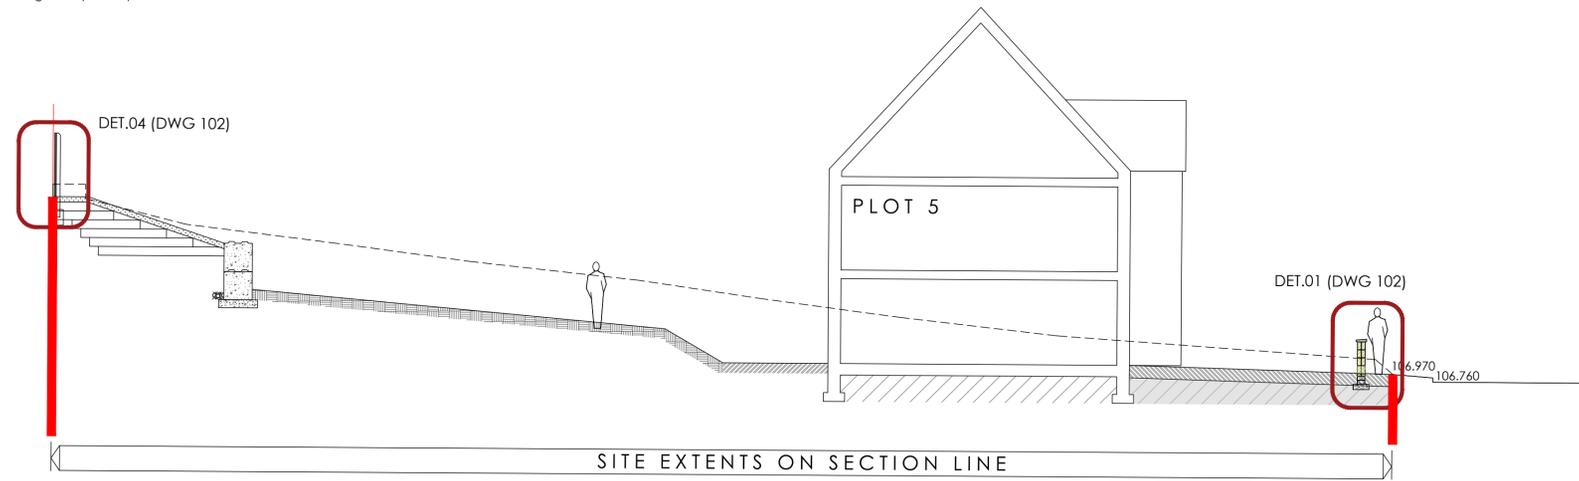

SITE SECTION 2 SCALE 1:100
section details taken from structural engineers drawing 5879-101 and AIP as agreed with highways dept.

A	20.08.25	details updated to reflect AIP agreement with highways dept	-	-
Rev	Date	Details	Drawn	Checked

Issued For:

PLANNING

Project/Client:	Project No:
Residential Development	23-035
Land at Britannia Road	Dwg No:
Golcar, HD3 4QB	101
Rev:	A
Scale:	A.S. @A1
Drawing:	Proposed Site Sections
Drawn By:	Date:
RJ	02/01/24
Checked By:	Date:
SC	

SCIPROPERTY

SCI Property Limited
Flockton Chapel, Barnsley Road, Flockton, WF4 4DP
T: +44 (0)1924 842747 F: +44 (0)1871 733 4738
studio@sciproperty.co.uk

© SCI Property Limited. Contractors must work only to figured dimensions which are to be checked on site.
Registered Office: The Studio, Flockton Chapel, Barnsley Road, Flockton, WF4 4DP Registered Number: 1235037
STANDARD NOTES:
• Contractor must verify all dimensions on site before commencing any work or shop drawings.
• If this drawing exceeds queries raised in any way, the building department are to be informed before work is started.
• Only figured dimensions to be taken from this drawing. Do not scale off this drawing.
• Drawing based on Ordnance Survey and/or existing record drawings - design and drawing content subject to site survey, structural survey, site investigations, planning and statutory requirements and approvals.