



NOTES  
 DO NOT SCALE FROM THIS DRAWING.  
 It is the Contractor's responsibility to check all governing dimensions and verify all dimensions on site before commencing any work or making any shop drawings.  
 This drawing is to be read in conjunction with schedules of work, specifications, bills of quantities and other relevant information. Any discrepancies are to be reported to the Project Architect.  
 Work and materials are to be in accordance with the Building Regulations and to comply with the relevant British Standards.  
 This drawing is copyright of Mark Brotherton Ltd and should not be reproduced in whole or part without their written permission.

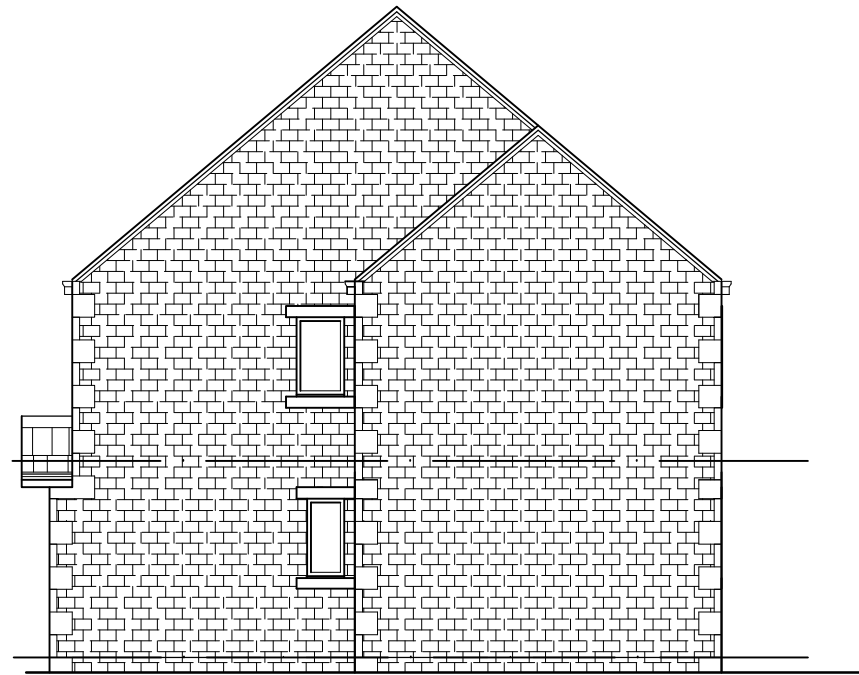

North Elevation

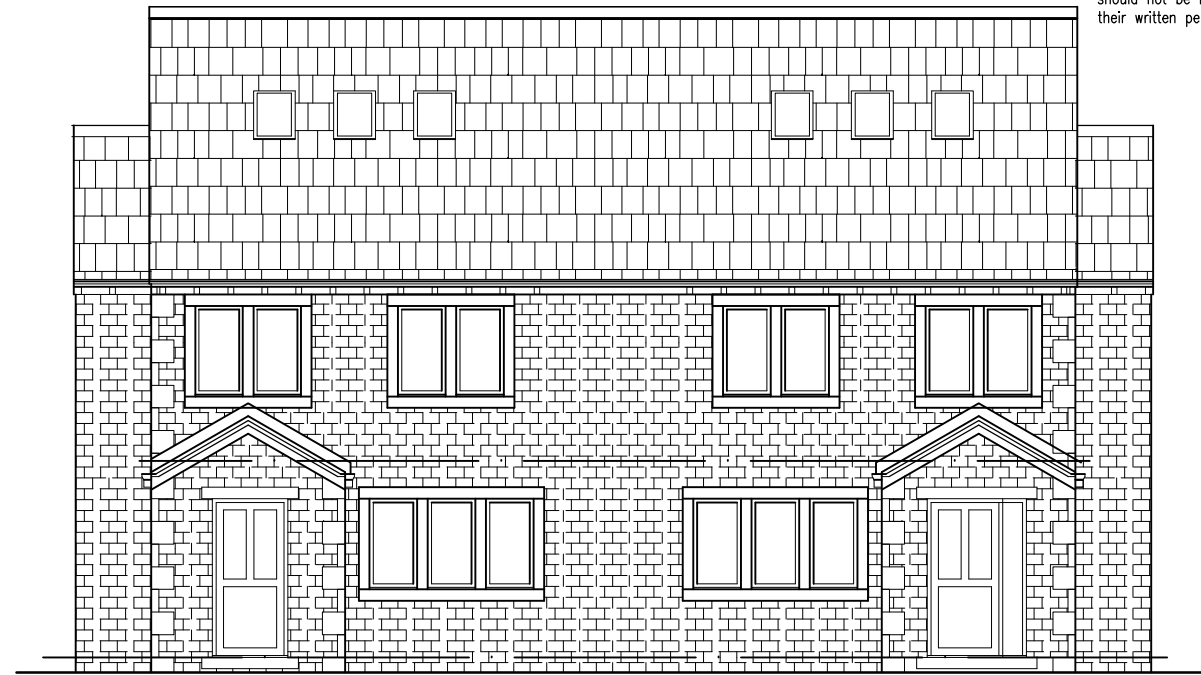

Front Elevation


4KW INTEGRATED SOLAR ROOF TILES



Rear Elevation

Construction

Walls - Regular coursed stone  
 Roof - Thin concrete plain tiles  
 Windows - Coloured U/PVC with double glazed units  
 Drainage - modify existing foul & surface water, drainage to suit

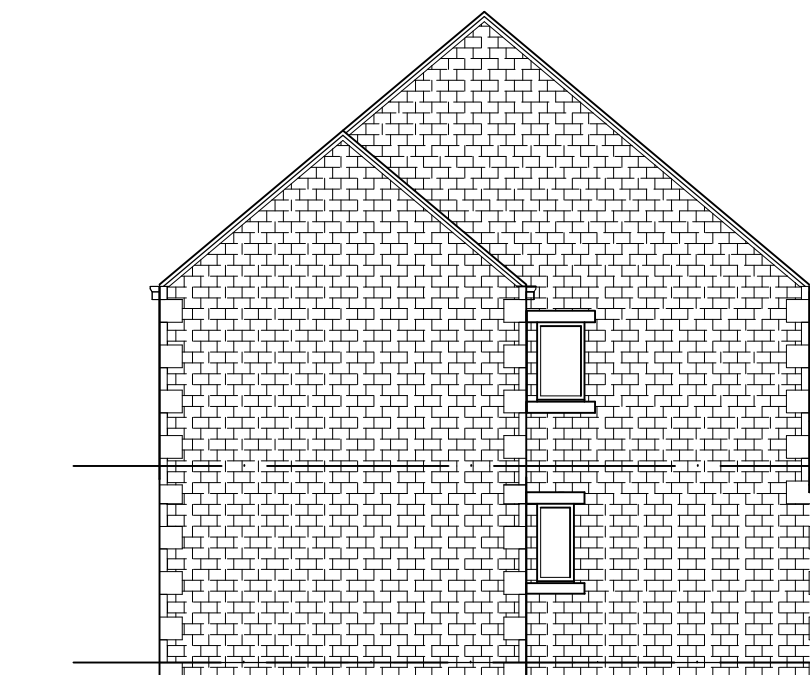

South Elevation

Rev:	Date:	Notes:
------	-------	--------

**FOX** ARCHITECTURE & DESIGN  
 Fox Cottage, Whitley Road, Whitley West Yorkshire, WF12 6LU  
 T 01924 459231  
 E info@foxarchitecture.co.uk  
 www.foxarchitecture.co.uk

Client: John Brooke Builders

Project: 230 Roberttown Lane Liversedge WF15 7LL

Drawing: As built Elevations

Date: Feb 2024 Scale: 100 @ A3

Drawing No: 2067/311 Rev: