


NOTES  
 DO NOT SCALE FROM THIS DRAWING.  
 It is the Contractor's responsibility to check all governing dimensions and verify all dimensions on site before commencing any work or making any shop drawings.  
 This drawing is to be read in conjunction with schedules of work, specifications, bills of quantities and other relevant information. Any discrepancies are to be reported to the Project Architect.  
 Work and materials are to be in accordance with the Building Regulations and to comply with the relevant British Standards.  
 This drawing is copyright of Mark Brotherton Ltd and should not be reproduced in whole or part without their written permission.

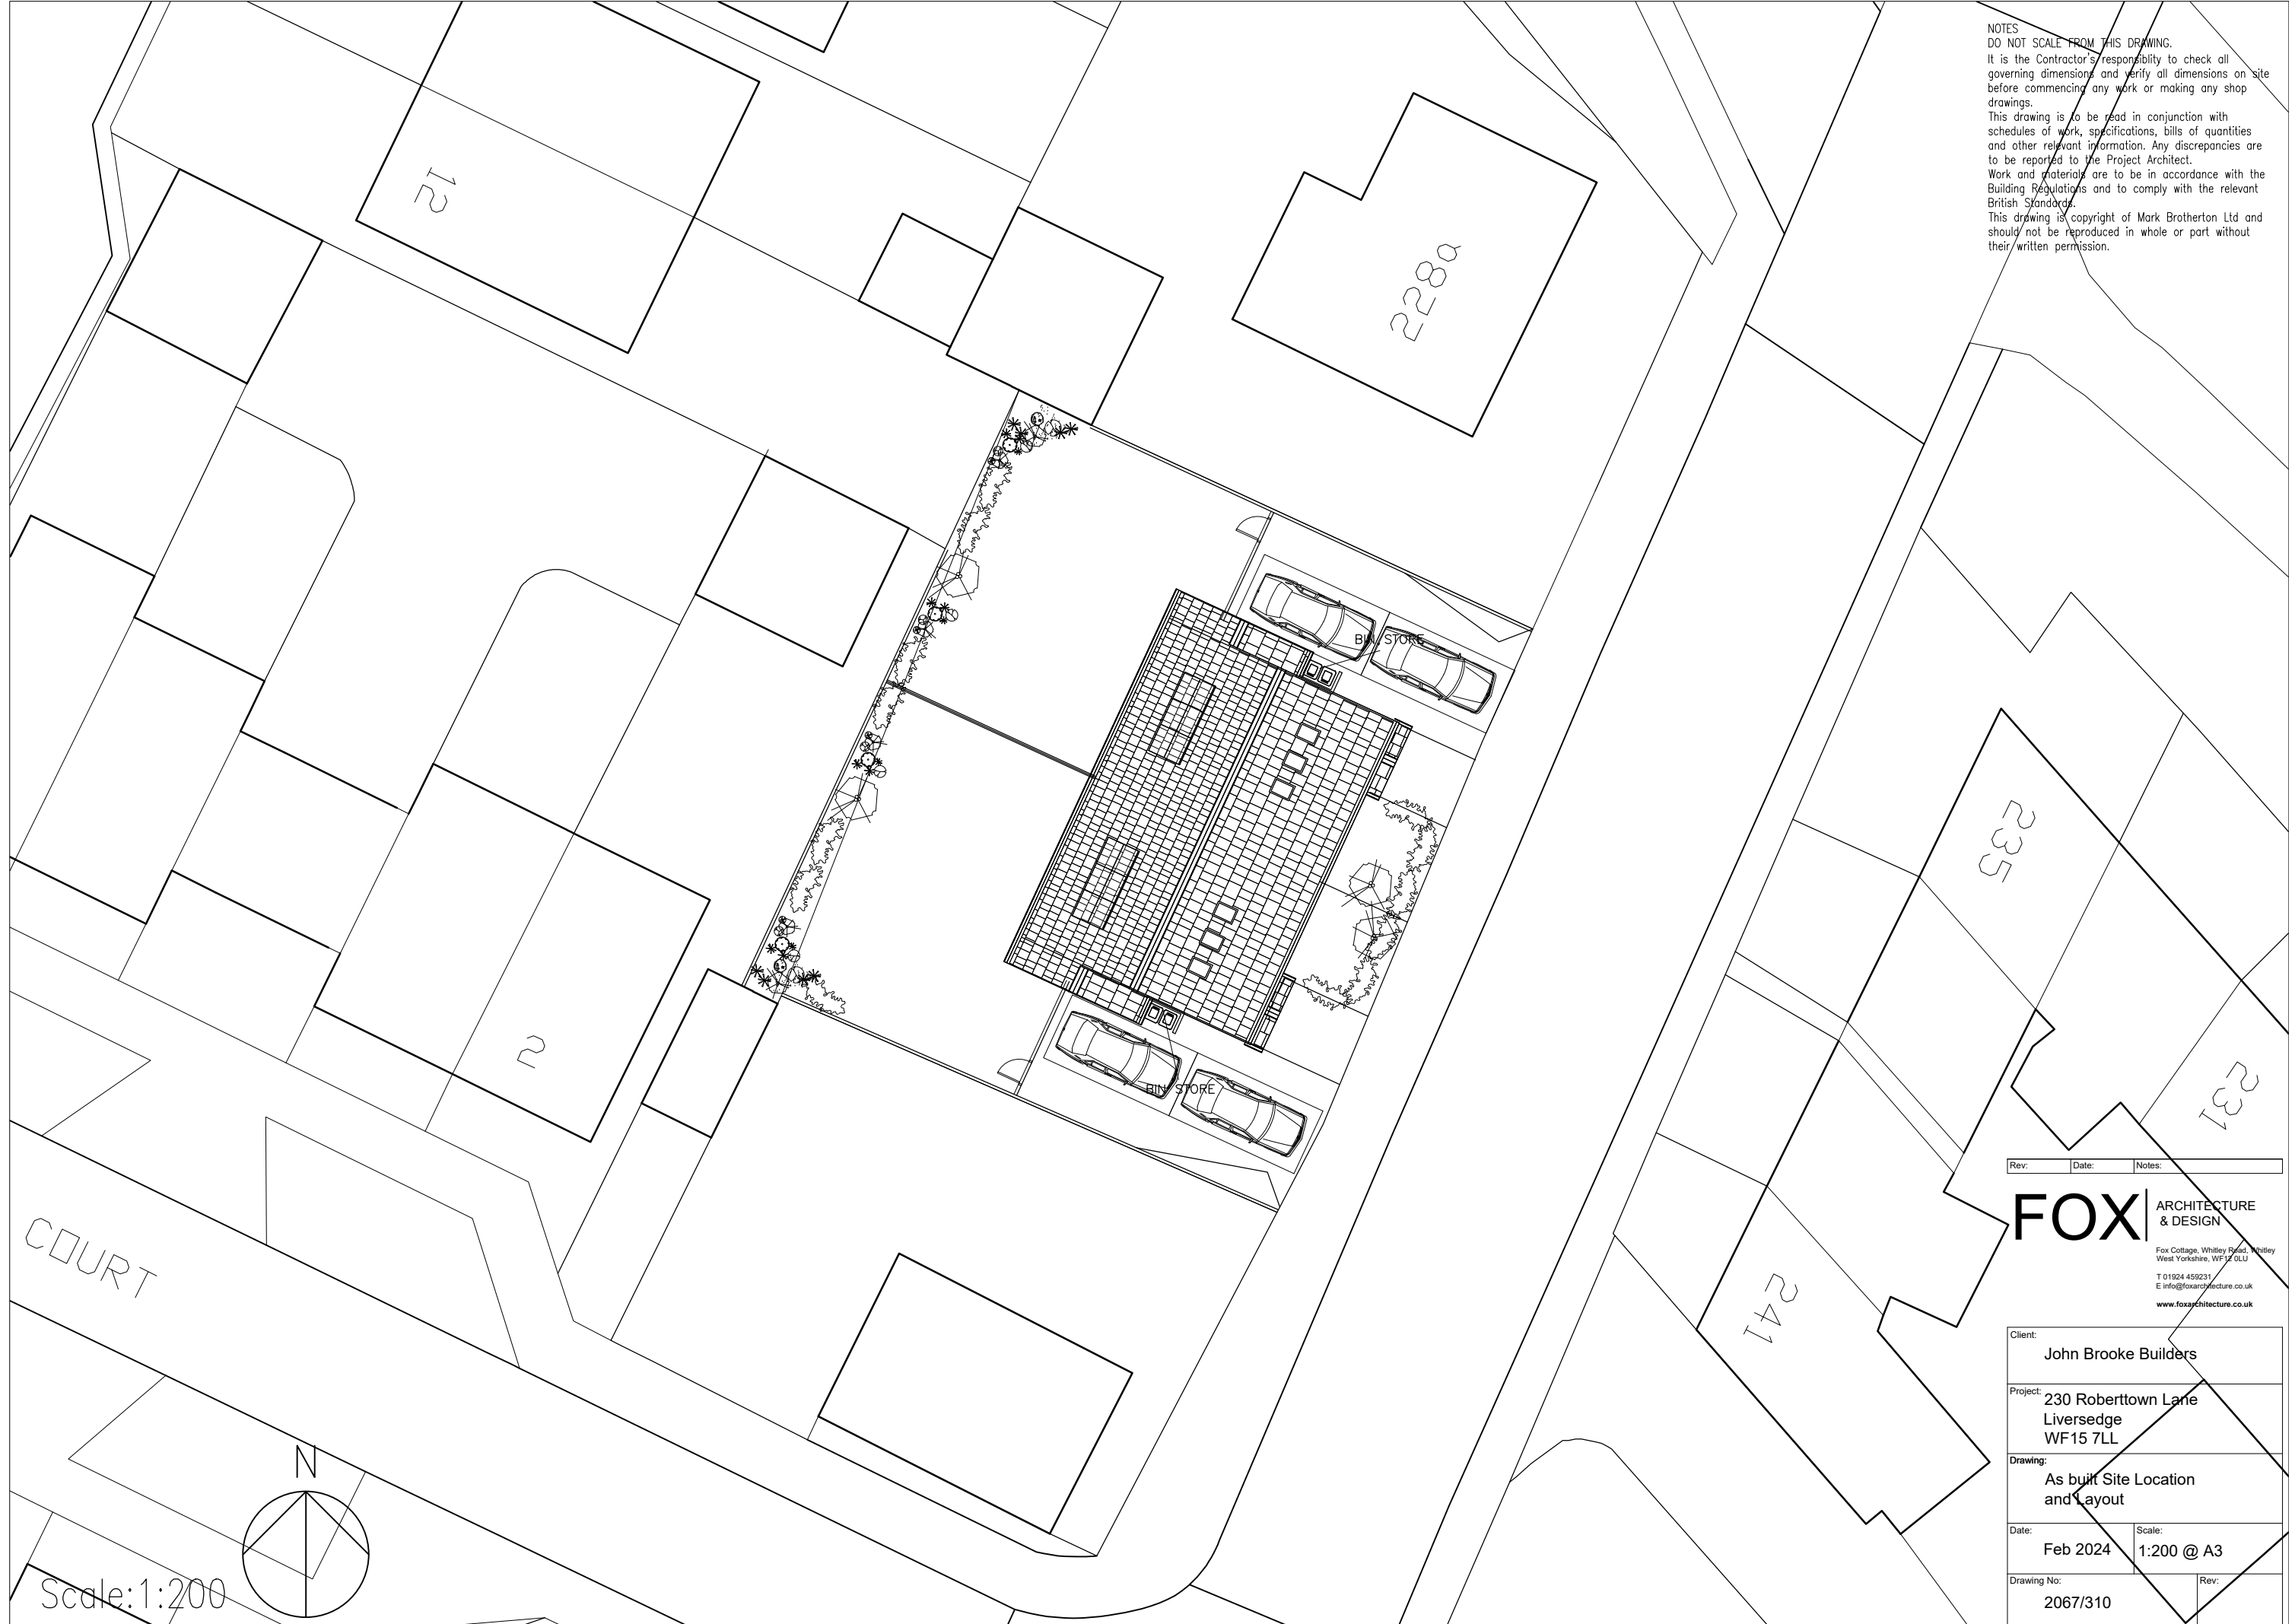


Rev:	Date:	Notes:
------	-------	--------

**FOX** ARCHITECTURE & DESIGN  
 Fox Cottage, Whitley Road, Whitley West Yorkshire, WF12 6LU  
 T 01924 459231  
 E info@foxarchitecture.co.uk  
 www.foxarchitecture.co.uk

Client: <b>John Brooke Builders</b>	
Project: <b>230 Roberttown Lane Liversedge WF15 7LL</b>	
Drawing: <b>As built Site Location and Layout</b>	
Date: <b>Feb 2024</b>	Scale: <b>1:200 @ A3</b>
Drawing No: <b>2067/310</b>	Rev:

COURT

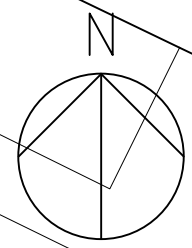

Scale: 1:200