




NOTES
 DO NOT SCALE FROM THIS DRAWING.
 It is the Contractor's responsibility to check all governing dimensions and verify all dimensions on site before commencing any work or making any shop drawings.
 This drawing is to be read in conjunction with schedules of work, specifications, bills of quantities and other relevant information. Any discrepancies are to be reported to the Project Architect.
 Work and materials are to be in accordance with the Building Regulations and to comply with the relevant British Standards.
 This drawing is copyright of Mark Brotherton Ltd and should not be reproduced in whole or part without their written permission.

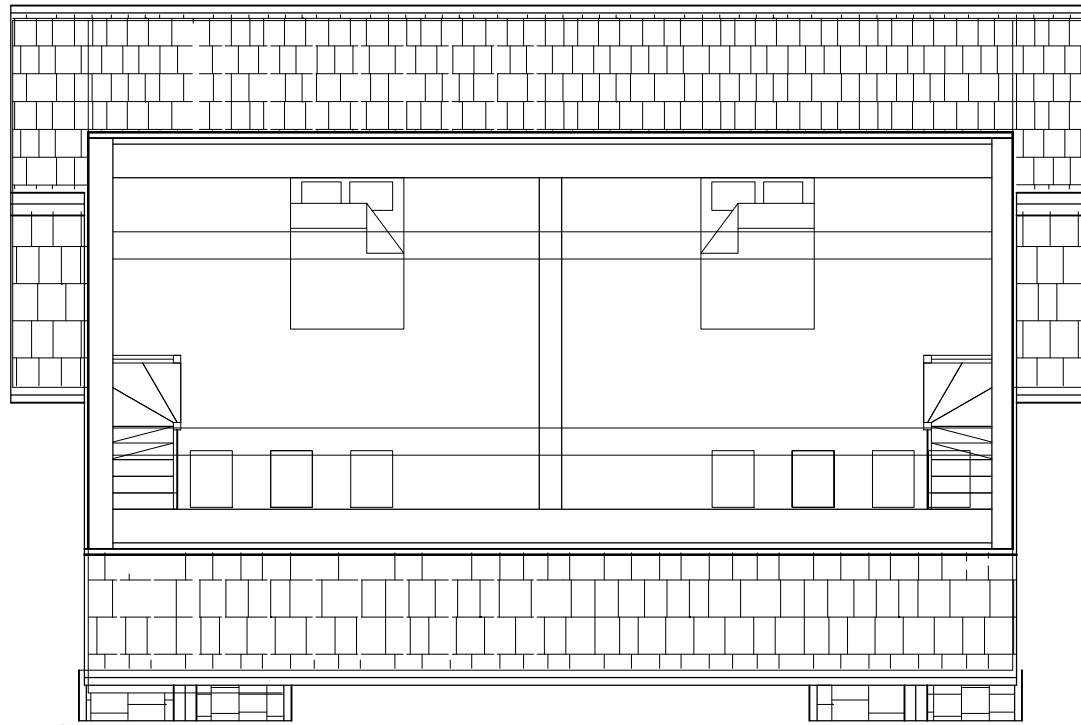

Second Floor Layout

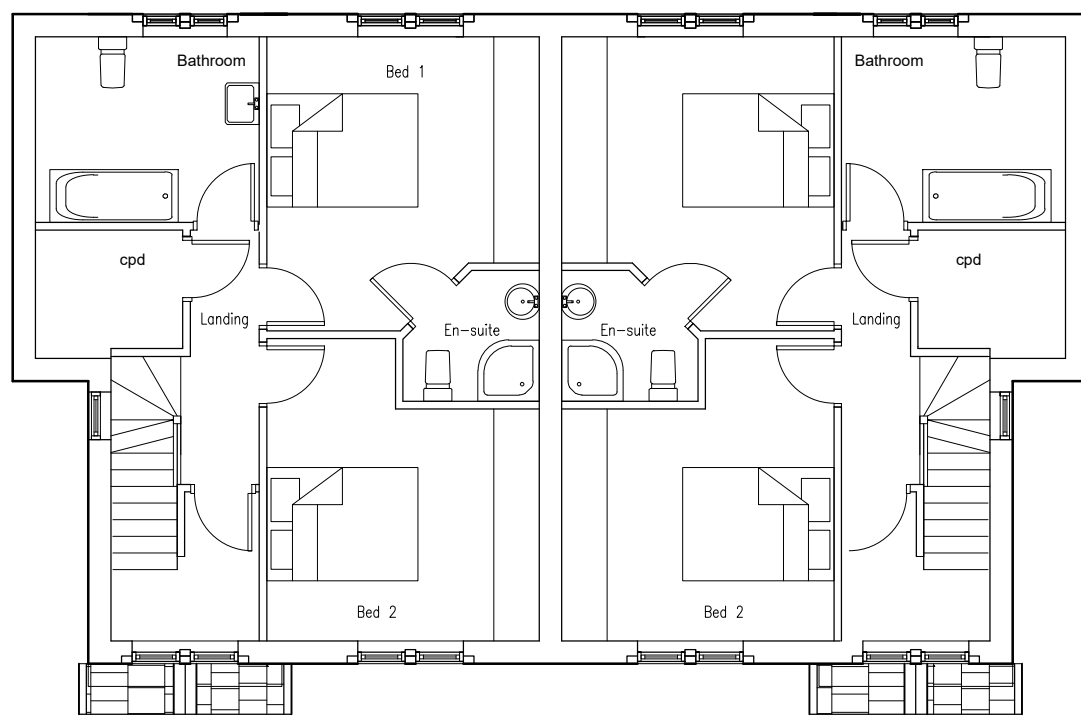

First Floor Layout

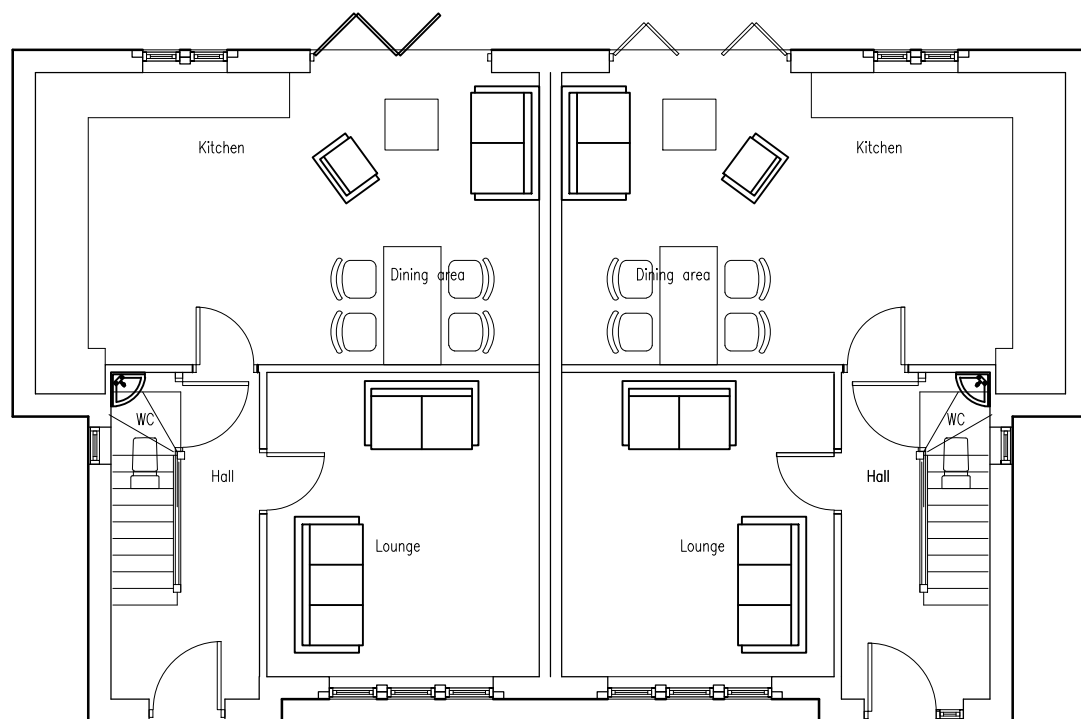

Ground Floor Layout

Rev:	Date:	Notes:
------	-------	--------

FOX ARCHITECTURE & DESIGN
 Fox Cottage, Whitley Road, Whitley
 West Yorkshire, WF12 0LU
 T 01924 459231
 E info@foxarchitecture.co.uk
 www.foxarchitecture.co.uk

Client:	John Brooke Builders	
Project:	230 Roberttown Lane Liversedge WF15 7LL	
Drawing:	As built Layouts	
Date:	Feb 2024	Scale: 100 @ A3
Drawing No:	2067/312	Rev: