


THIS DRAWING TOGETHER WITH THE DESIGN IS THE PROPERTY AND COPYRIGHT OF BRT SERVICES AND MUST NOT BE REPRODUCED WITHOUT WRITTEN PERMISSION

ONLY FIGURED DIMENSIONS TO BE USED
SCALED DIMENSIONS TO BE CHECKED WITH
BRT SERVICES


EXISTING BUILDING DIMENSIONS ARE FOR INDICATION
ONLY AND SHOULD BE PHYSICALLY CHECKED ON SITE
PRIOR TO WORK COMMENCING

PARTY WALL SURVEYOR..... NOT REQUIRED
PLANNING SUPERVISOR..... NOT REQUIRED
M&E ENGINEER NOT REQUIRED
STRUCTURAL ENGINEER..... NOT REQUIRED


PLANNING APPLICATION

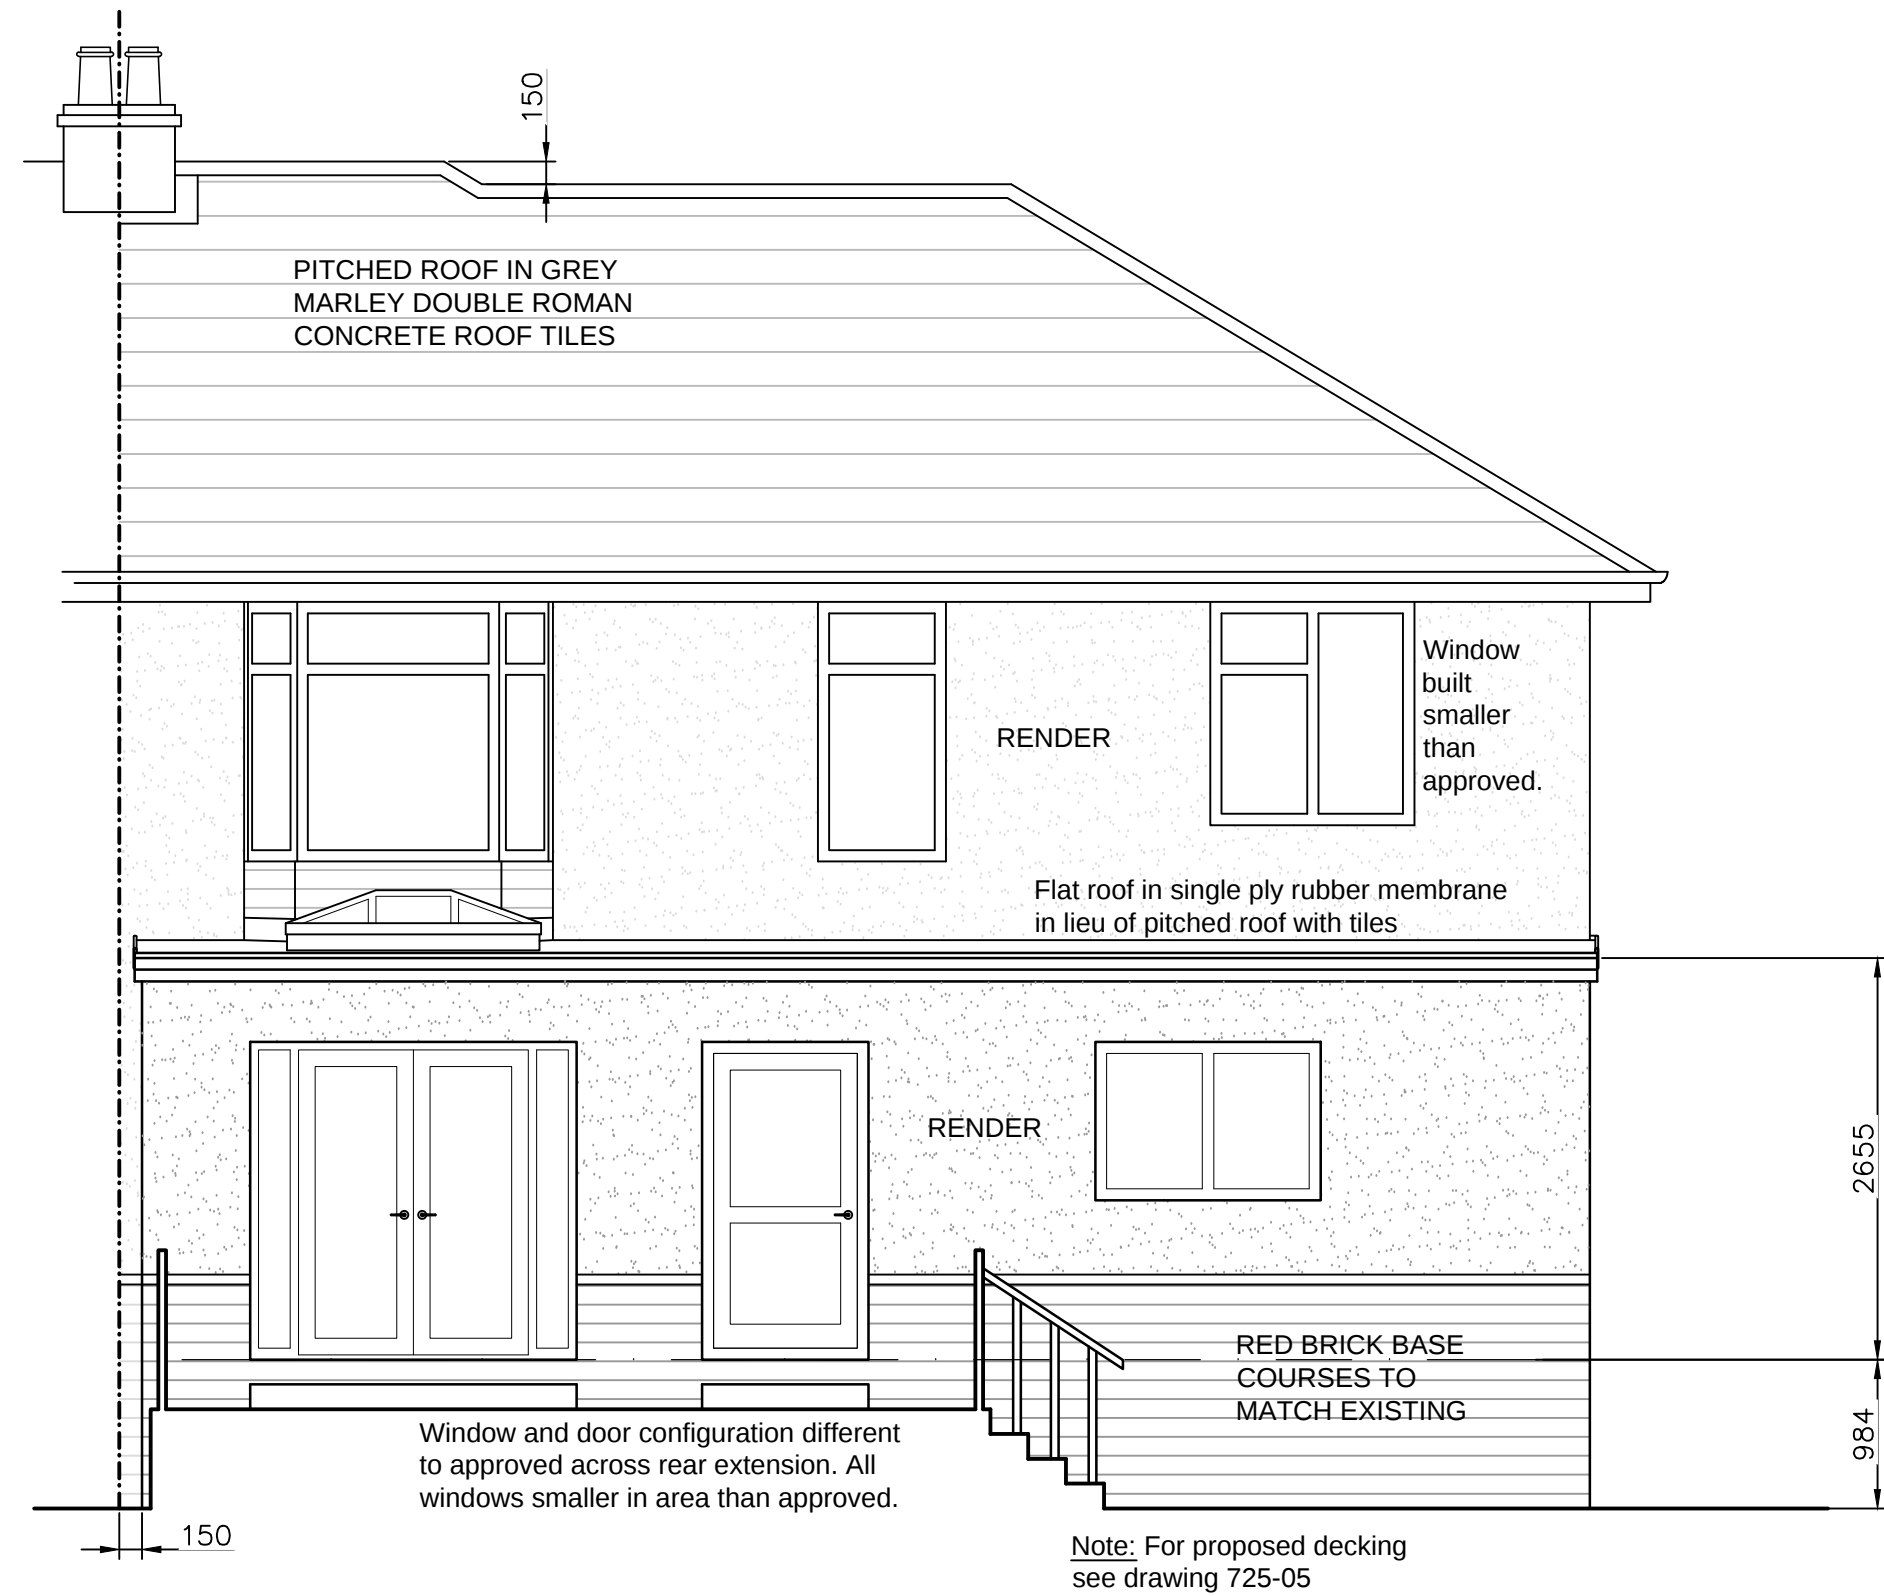


WEST (REAR) ELEVATION

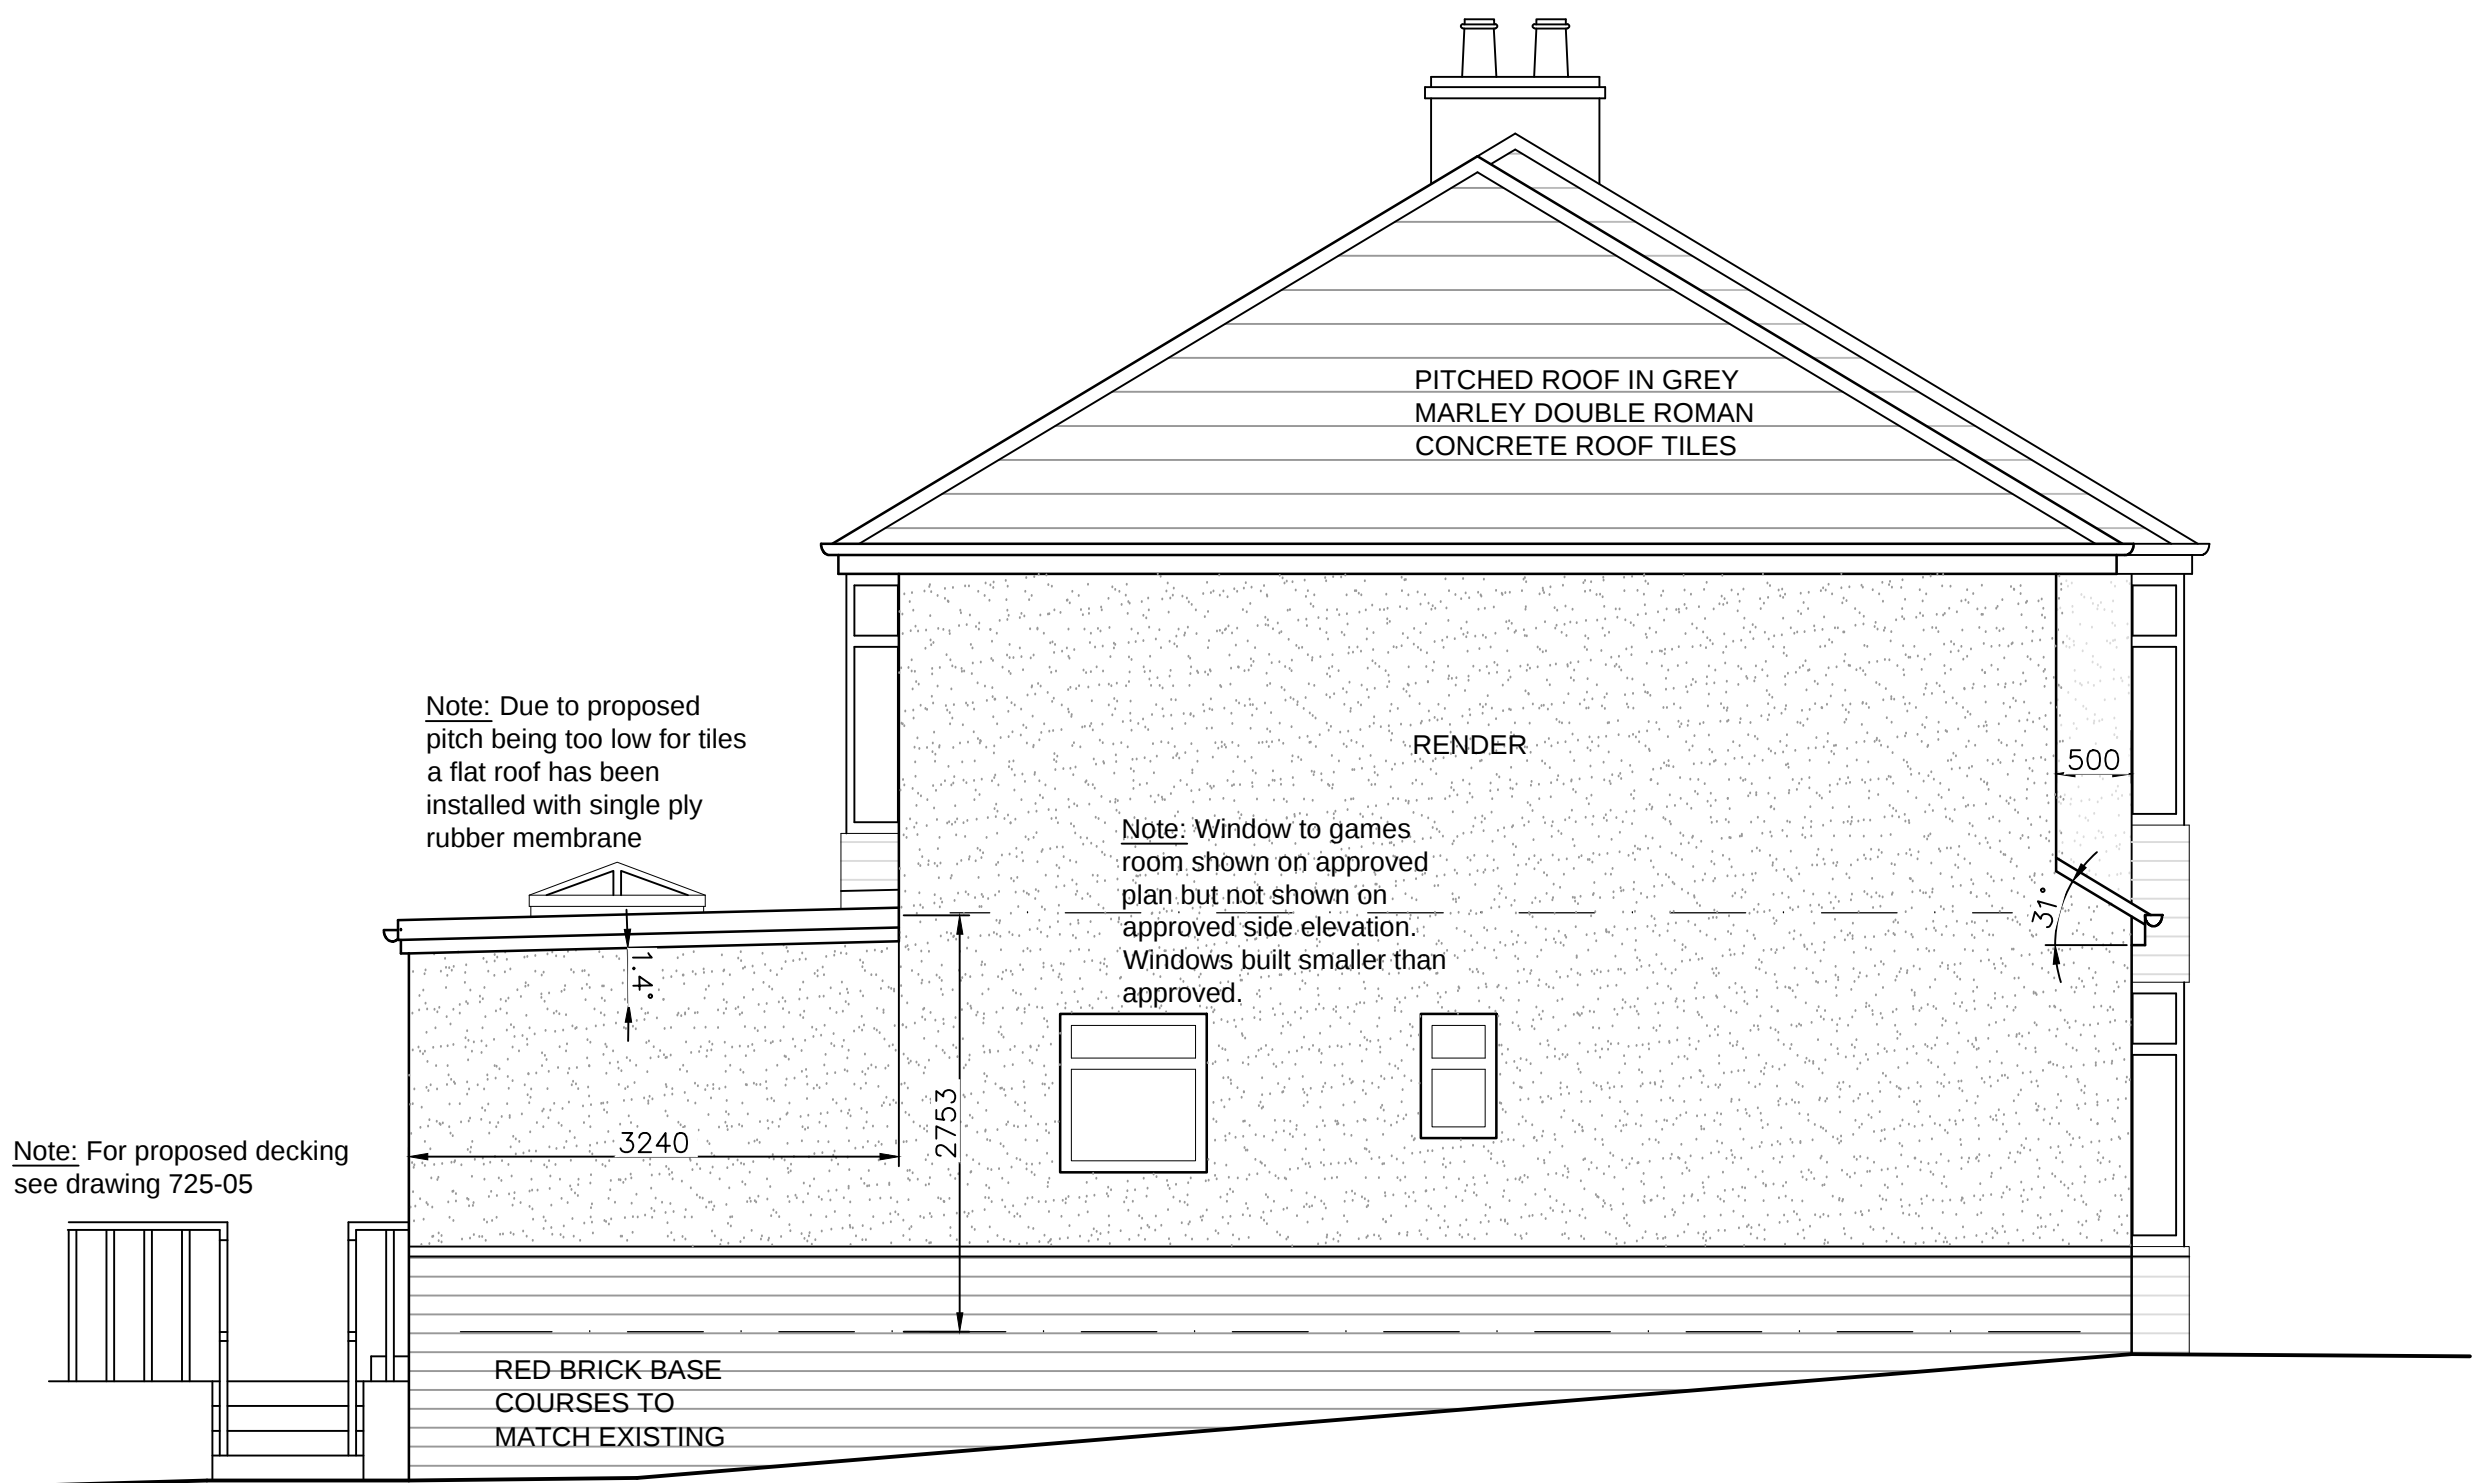

SOUTH (SIDE) ELEVATION

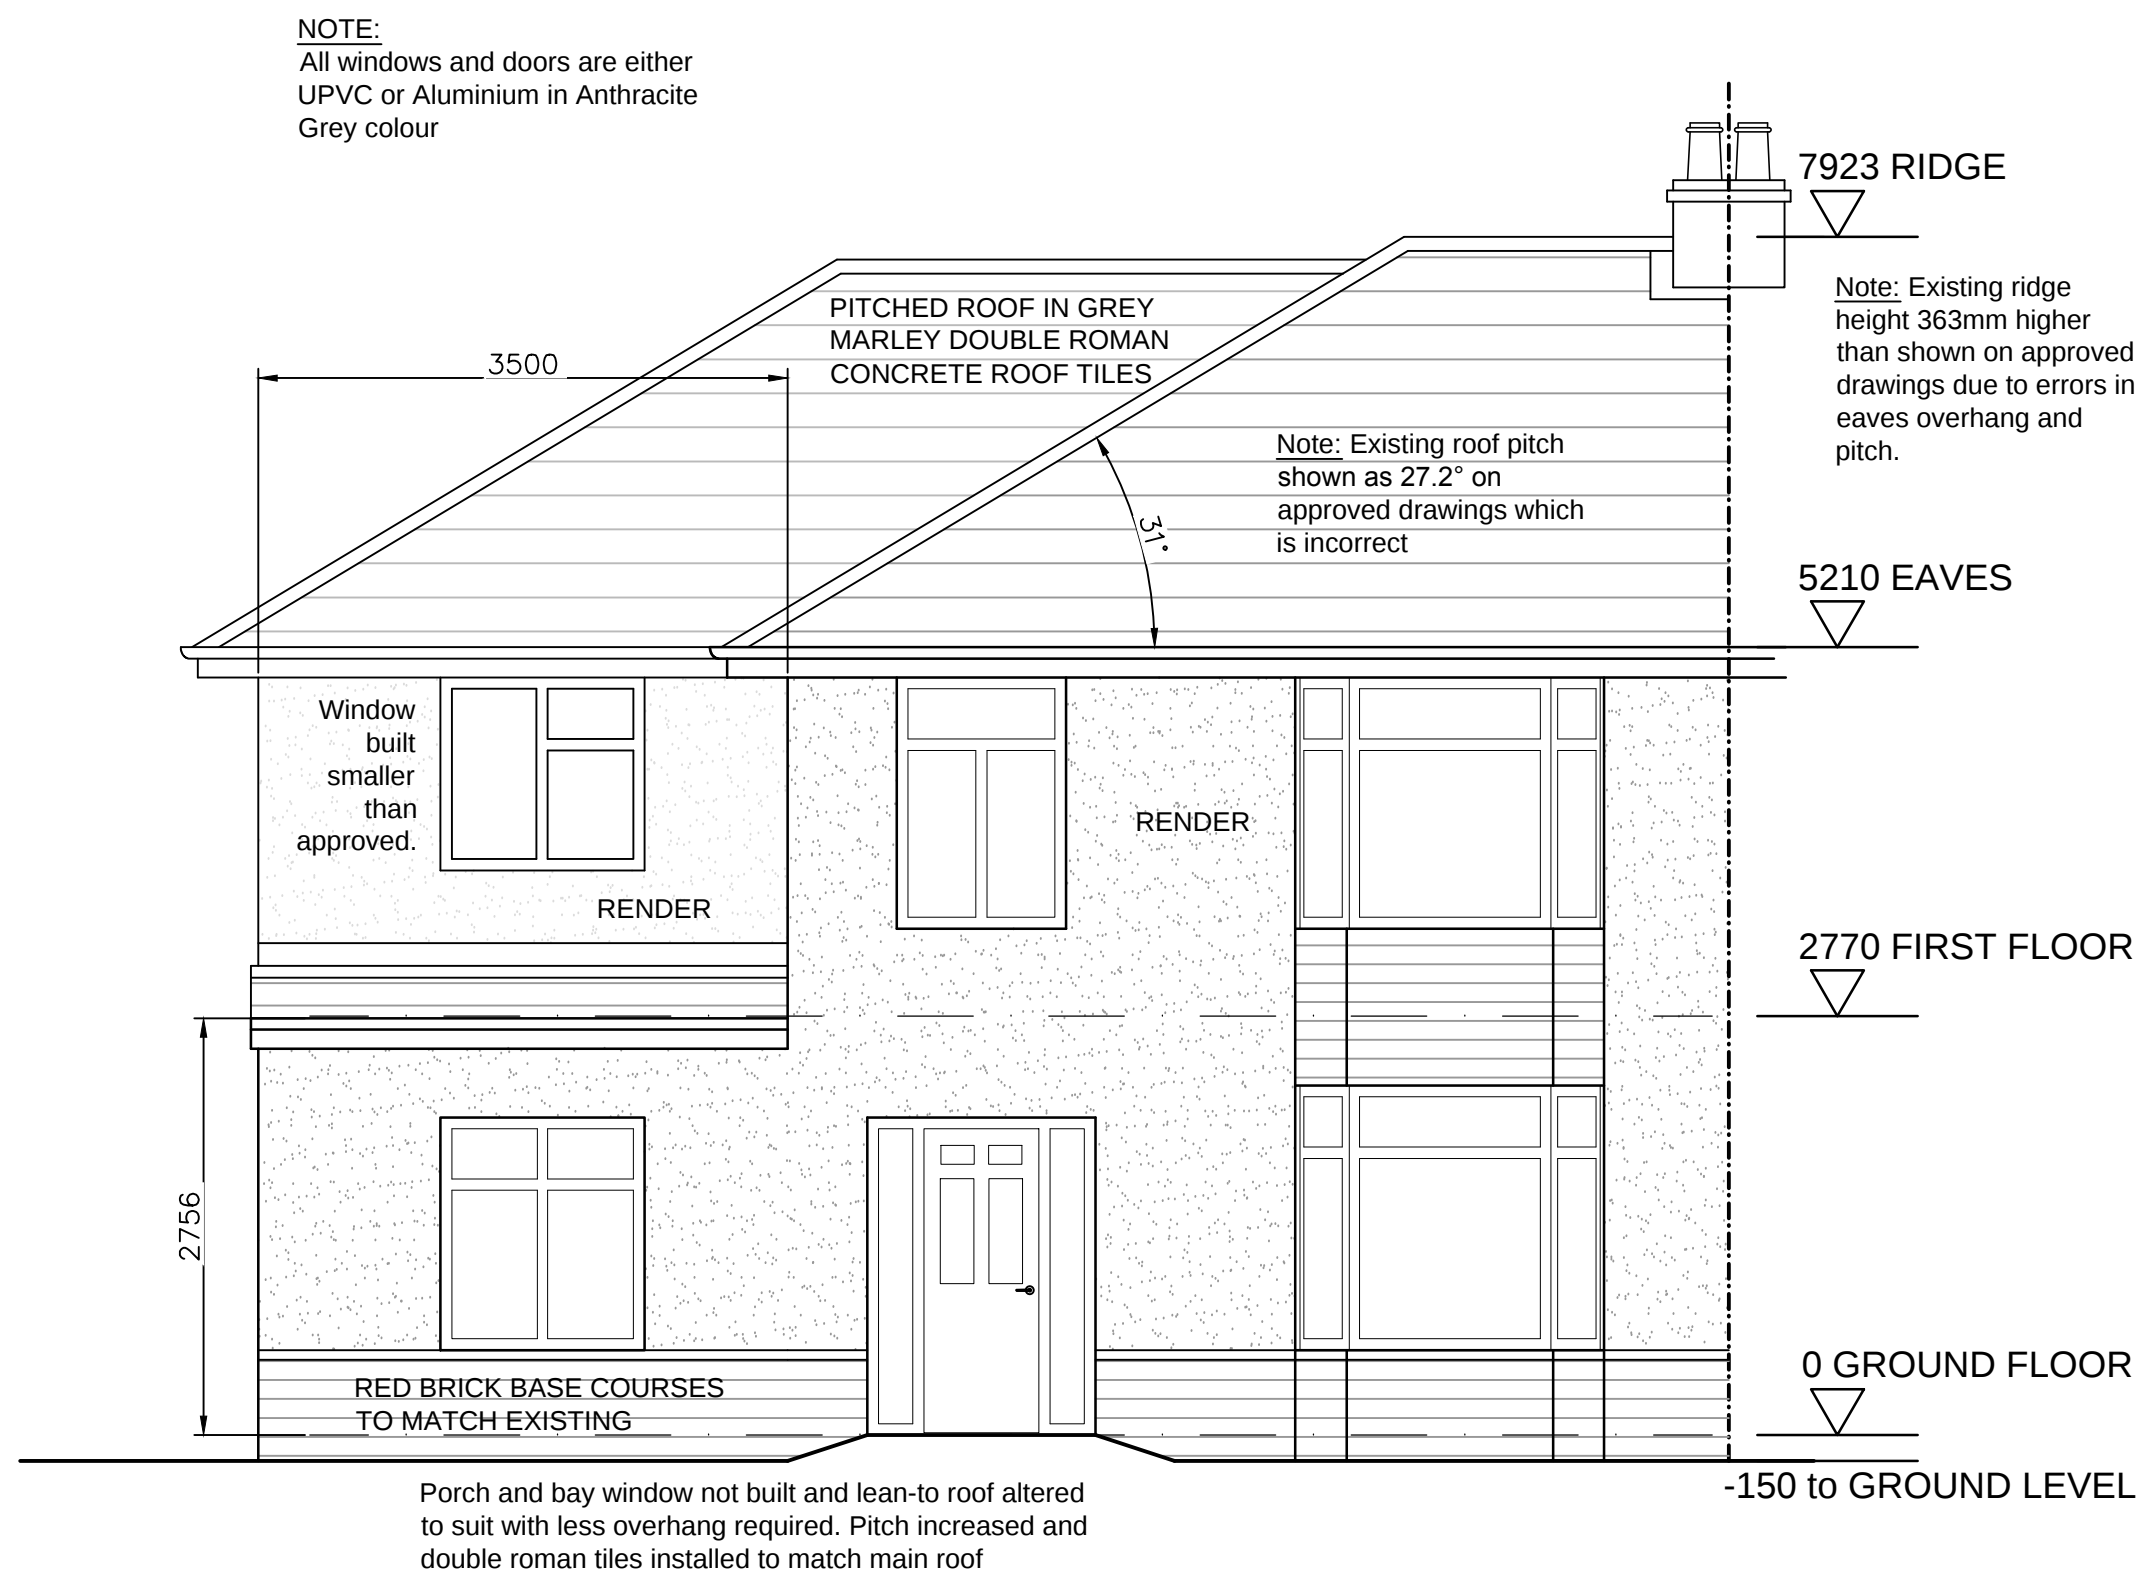


EAST (FRONT) ELEVATION

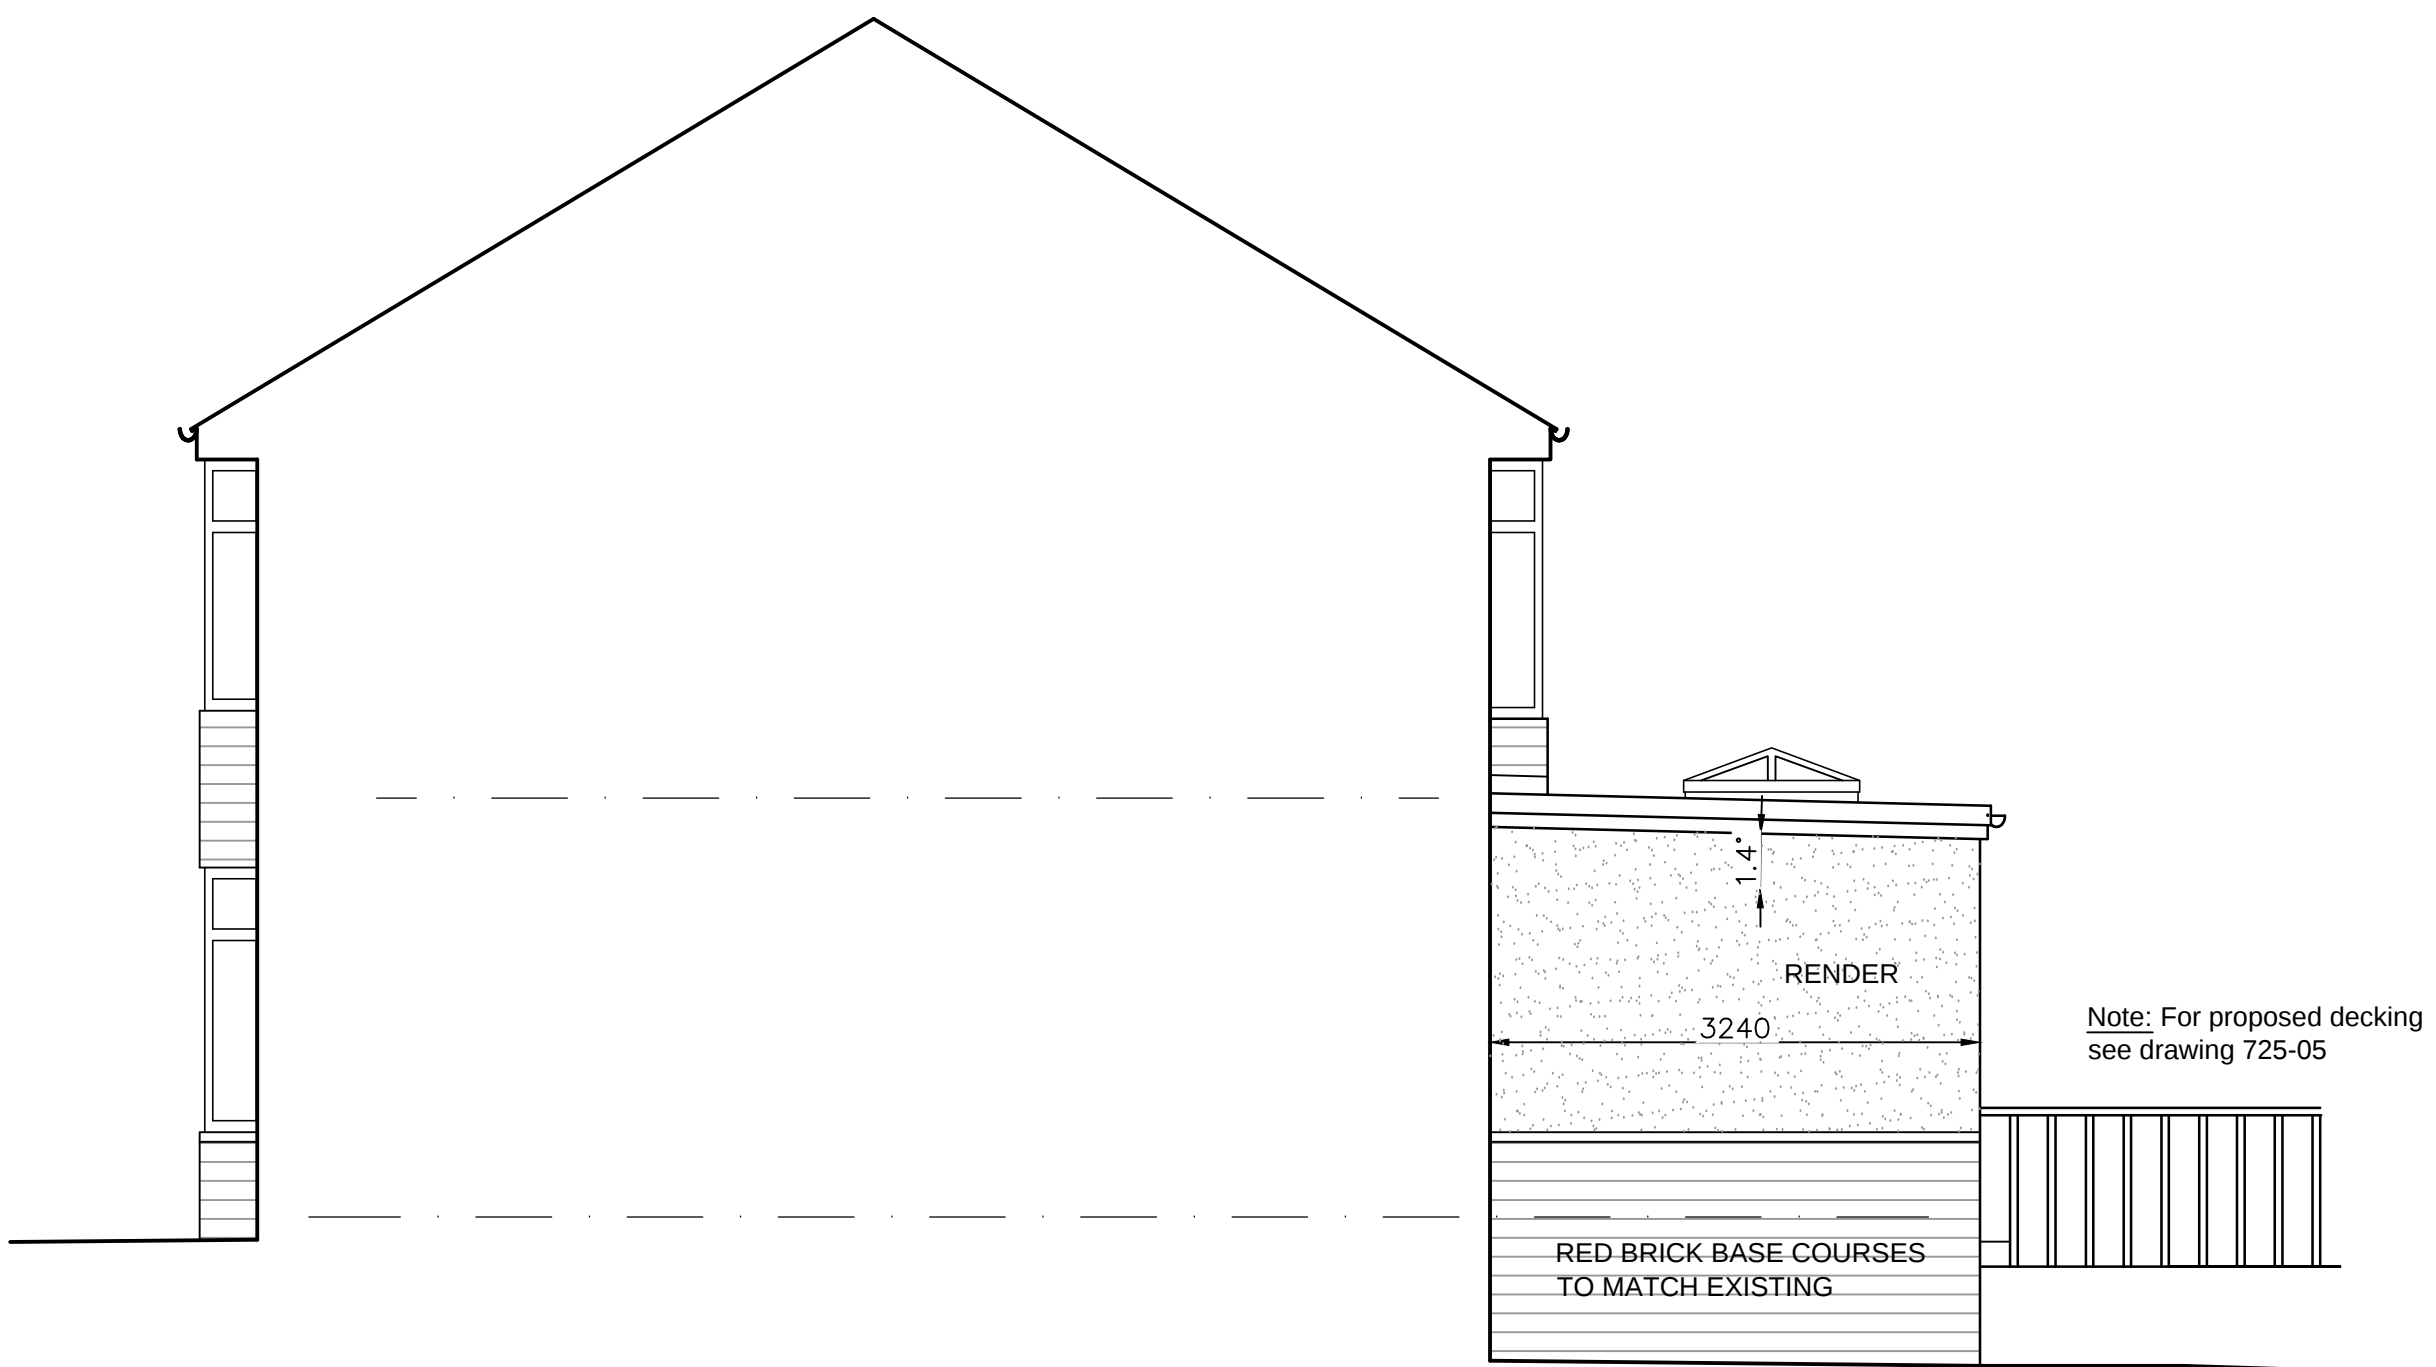

SECTIONAL NORTH (SIDE) ELEVATION

AS BUILT & PROPOSED

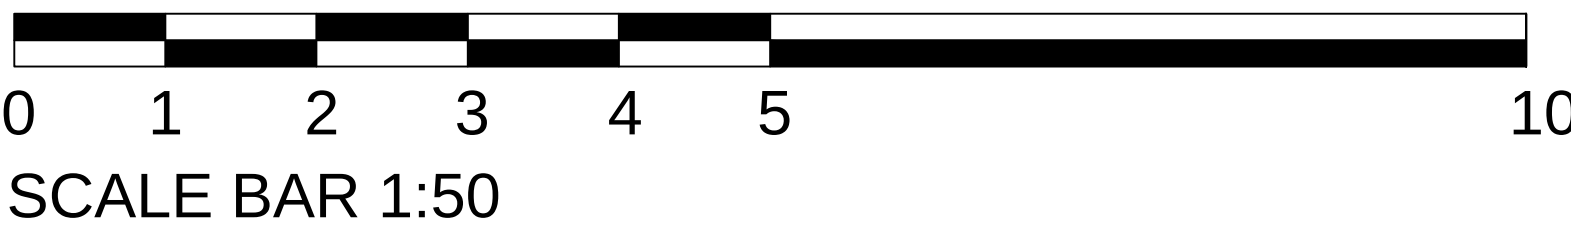

Rev A Roof line amended

29-07-24



BRT Services
52 ASHENHURST AVENUE,
ASHENHURST,
HUDDERSFIELD, HD4 6PX
TEL: 07855 945690

LANDSCAPING & ARCHITECTURAL SERVICES

Client MR M KARIM

Job title PROPOSED EXTENSION:
1 CENTRAL CLOSE
FARTOWN
HUDDERSFIELD

Drawing 725-04
ELEVATIONS AS BUILT &
PROPOSED

Scale 1:50 @ A1

Date JULY 2024 **Revision** A