



Rev	Date	Chk	Drw	Description
P01	19/01/24	MB	RT	WIP Drawing issued for information and coordination purposes.
P02	16/02/24	MB	RT	Modified WIP issued for information
P03	30/04/24	AB	MB	Drawing issued as Draft Planning Submission for information and review purposes. Includes revision (clouded) to canopy to accommodate highway stand off.
P04	12/06/24	MB	MB	Planning drawing issued for approval purposes. Includes amendments following ECI process.

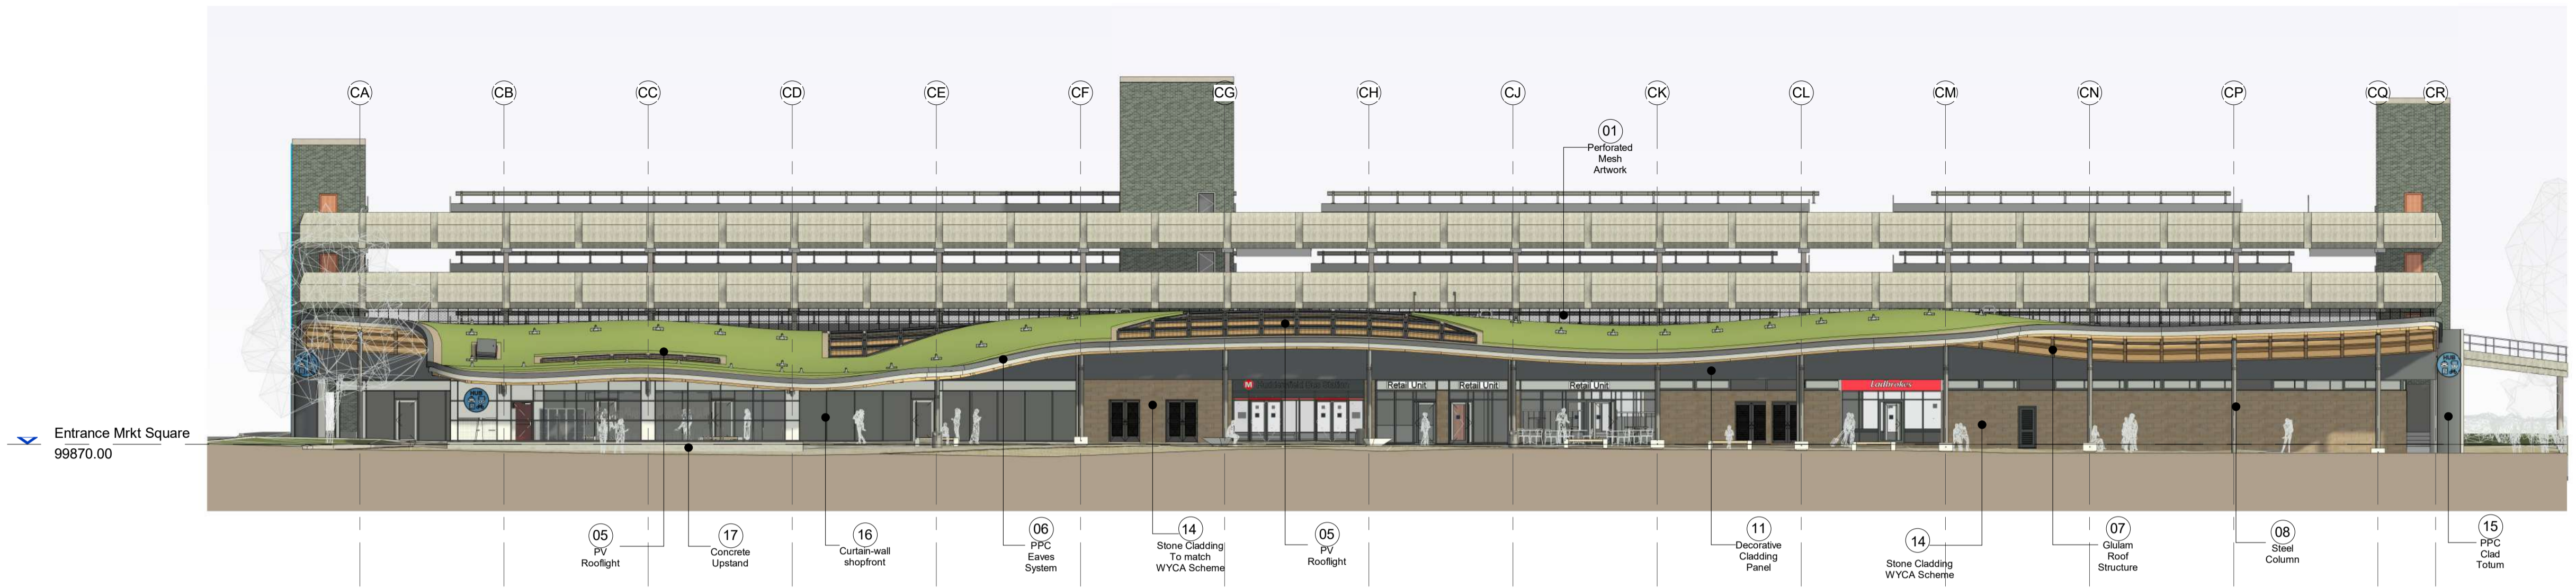

E1 East Elevation
Scale: 1 : 200


- Planning Materials Schedule**
- "Light" Grey RAL 7035 Light Grey / LRV 57 / RGB 197/199/196
 - "Mid" Grey RAL 7004 Signal Grey / LRV 33 / RGB 155/155/155
 - "Dark" Grey RAL 7024 Graphite Grey / LRV 07 / RGB 70/73/79
1. Perforated Mesh Artwork / PPC Light Grey - Panels / PPC Dark Grey - Framing
 2. Gravel Margin - natural finish
 3. Sedum Roof - natural finish
 4. Mansafe System - natural finish
 5. PV Rooflights - PPC Dark grey - Framing & Flashings
 6. PPC Eaves System - Two colour laser line system. Upper - Dark Grey / Lower - Mid Grey
 7. Glulam Roof Structure - Structural Beams - natural finish - Plywood Soffit - natural finish
 8. Steel Columns - PPC Mid Grey
 9. Perforated Metal Panels - PPC Light Grey
 10. Laminated single glazed panel - Clear Glass - Tint TBC
 11. Decorative Cladding Panel - Rockpanel or EQ - Dark Grey
 12. Plank effect soffit - PPC Timber effect planks.
 13. Removable Grillage Walking Gutter Galvanised - natural finish.
 14. Stone Cladding - To match WYCA Scheme.
 15. PPC Clad Totums - PPC Dark Grey & Mid Grey
 16. Curtain Wall Shopfront - PPC Dark Grey - Frames PPC Light Grey - Doors & Spandrel
 17. Exposed Concrete Upstand - natural finish
 18. Utility Doors (Louvered and Solid) PPC Dark Grey

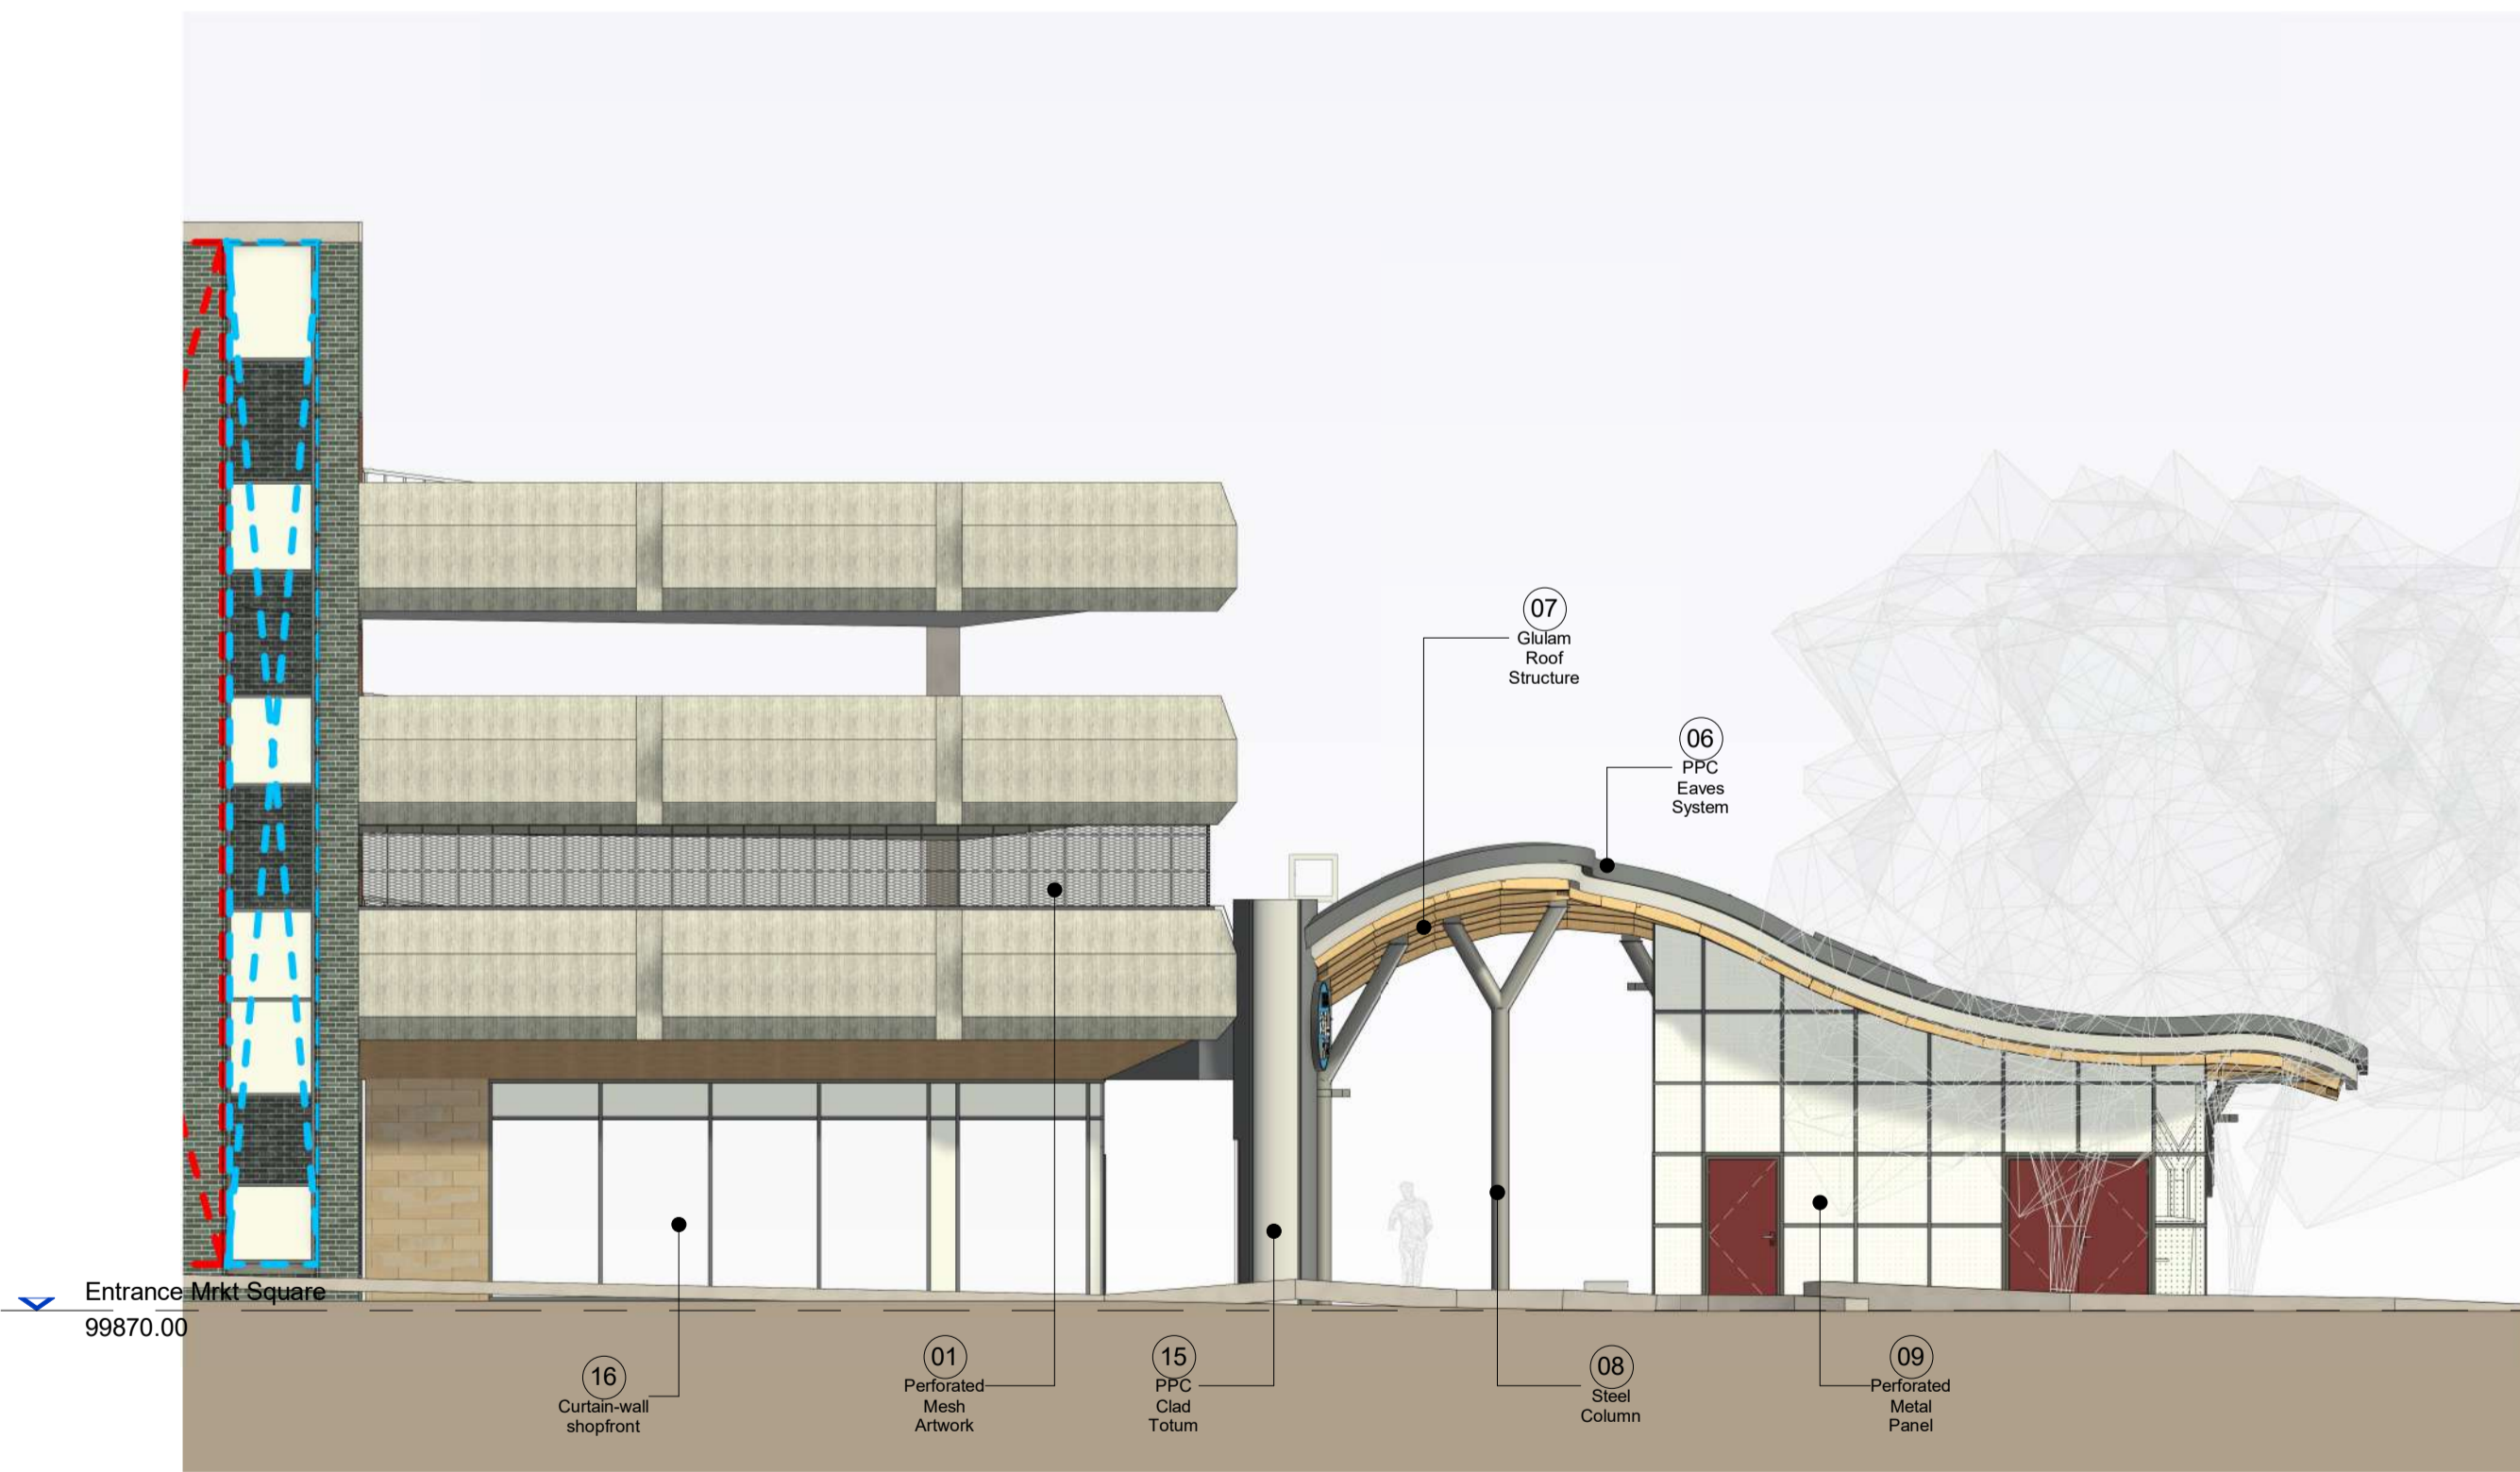

E2 South Elevation
Scale: 1 : 100



E3 North Elevation
Scale: 1 : 100

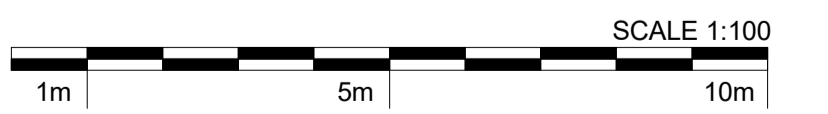

This drawing, the works and concepts depicted are copyright of Stephen George + Partners LLP and may not be reproduced or made use of, either directly or indirectly without express written consent. All heights, levels, sizes and dimensions to be checked on site before any work is put to hand. Information shown on this drawing that is produced by others has not been verified by Stephen George + Partners LLP and no liability is accepted for its accuracy. This document is prepared for the sole use of the documented recipient and Stephen George + Partners LLP accepts no liability for use of this document by parties other than the party for whom it was prepared or for purposes other than those for which it was prepared. Do not scale from this drawing for purposes other than the planning application. Red Line Boundary based on O/S Data and NOT confirmed as the Legal Boundary.