
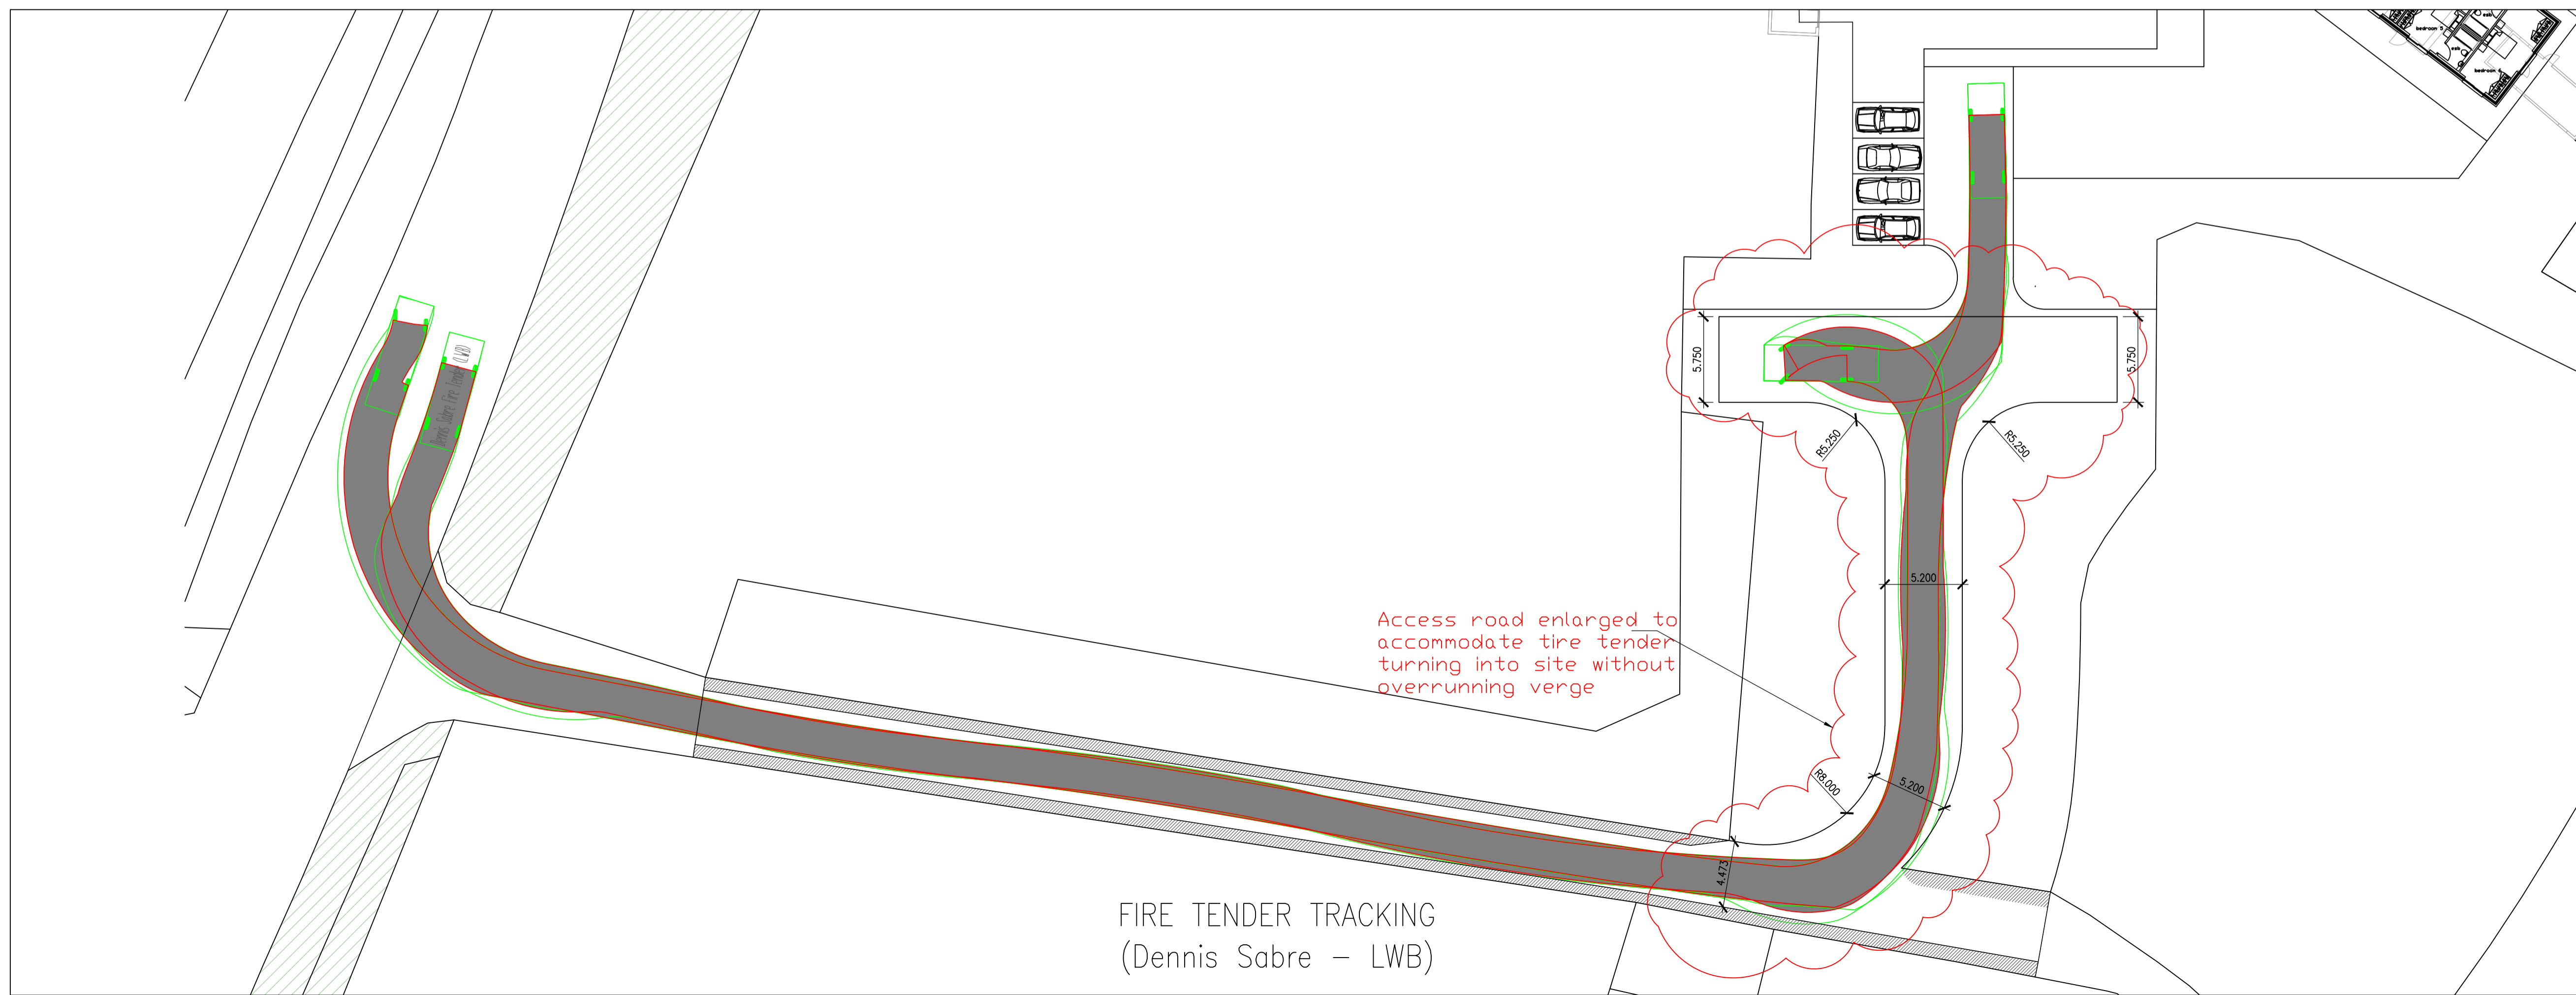


Note: Any work undertaken on site based on either Tender or Preliminary Status drawings is at the Contractors Risk.

General Notes

1. All dimensions are in millimetres and all levels are in metres U.N.O.
2. All materials & workmanship to be in accordance with the project specification and all relevant Warranty provider & British Standards.
3. This Drawing is to be read in conjunction with all relevant Architect's and Structural Engineer's drawings and the specifications.
4. All site particulars, dimensions and levels of existing structures are to be checked on site against the drawings by the Contractor and any discrepancies reported to the engineer prior to commencement of any works.
5. The Contractor shall be responsible for the detailing of any temporary works.
6. All proprietary fixings to be installed in accordance with the manufacturer's recommendations.
7. All work is to be carried out in accordance with current edition of the Building Regulations and to the satisfaction of the Local Authority/Private Building Control. Any work undertaken without Building Control approval is at the Contractors risk.
8. All setting out, services entries, DPM, fire protection, tanking & waterproofing to Architects details.

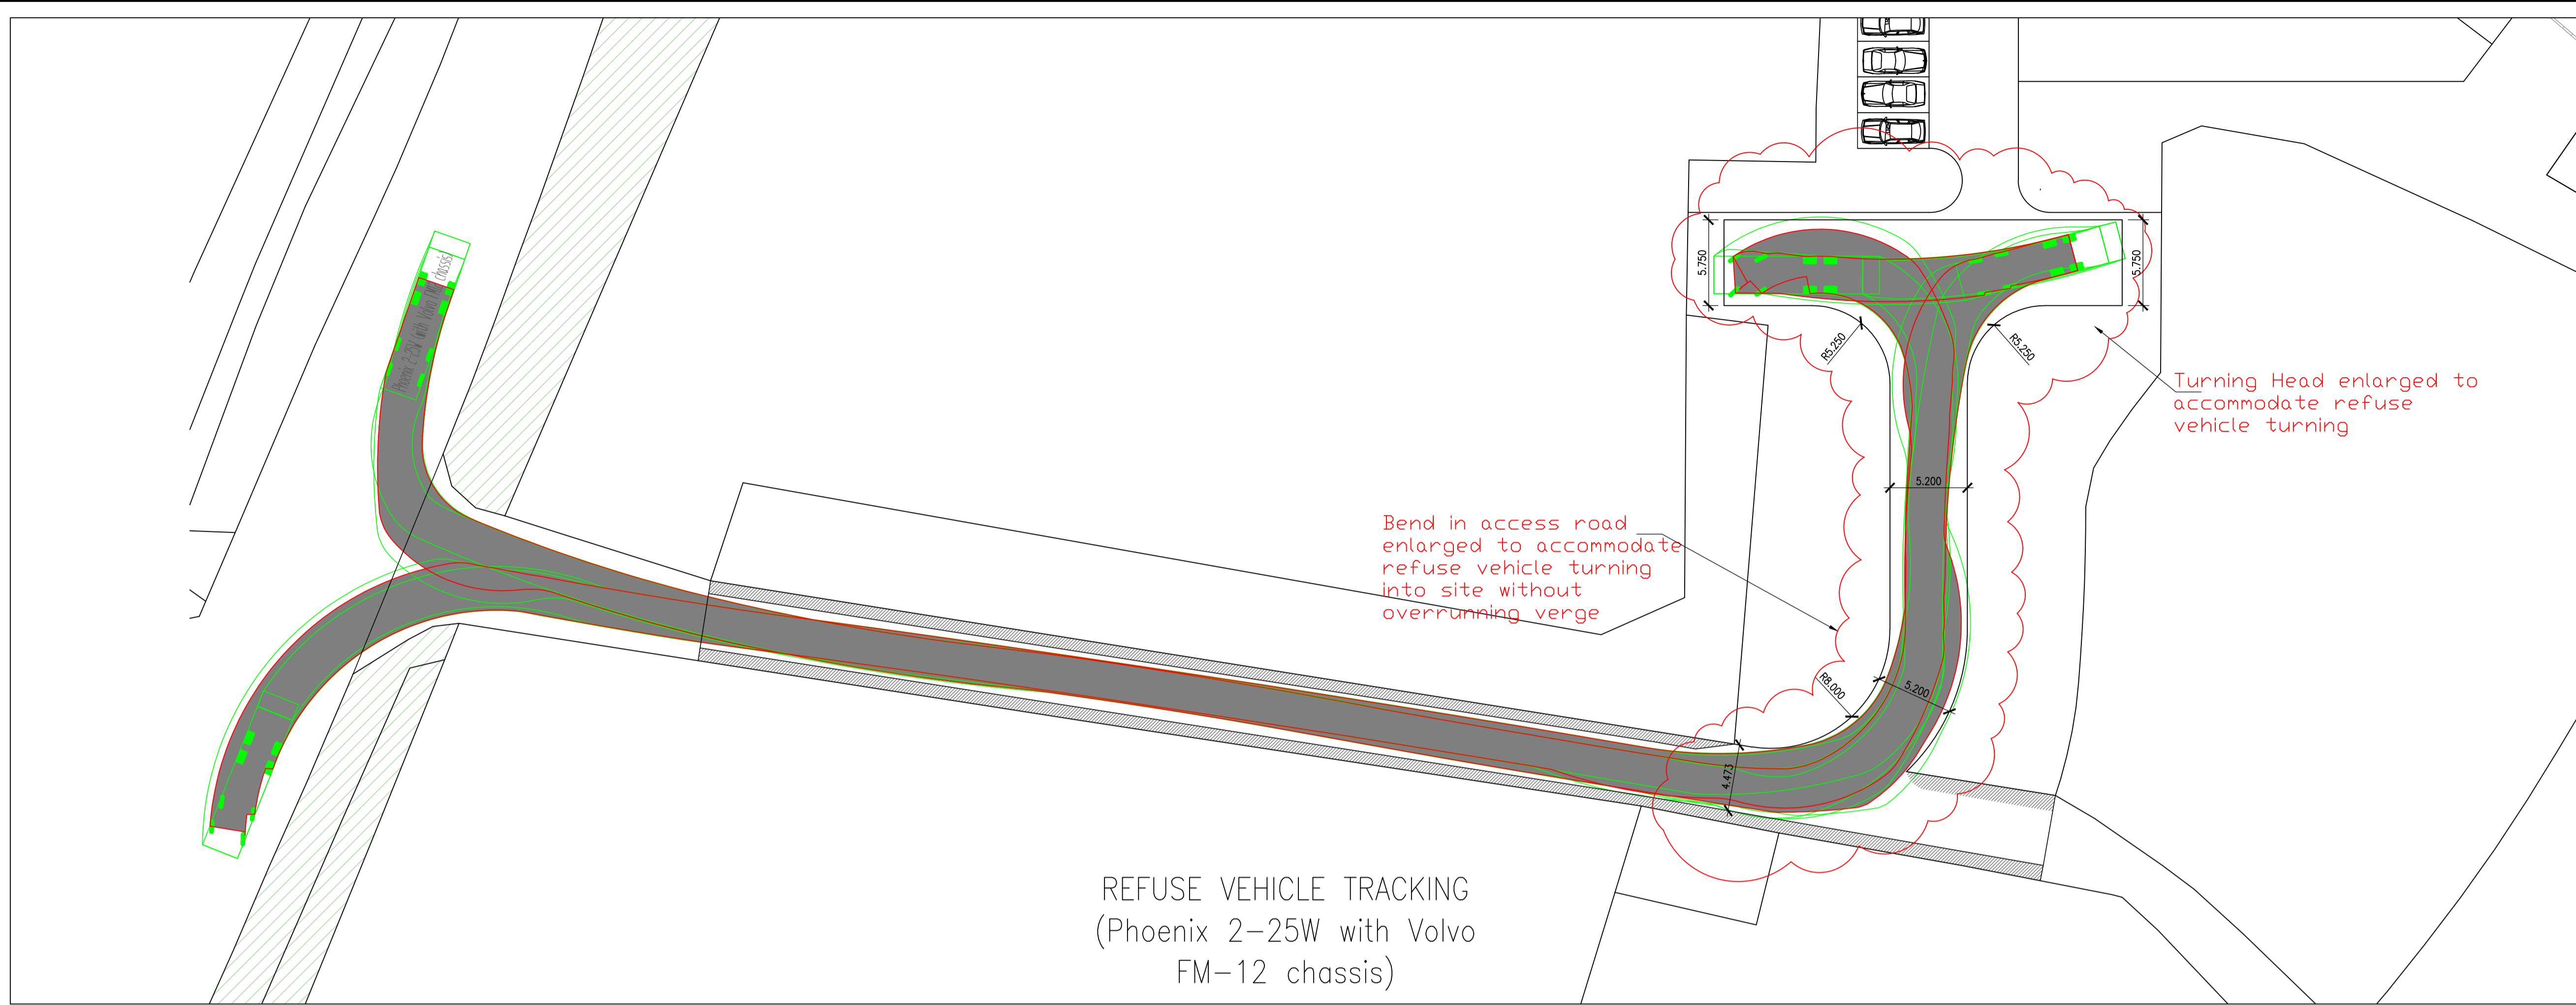

Rev	Description	Date	Dn	Ck
P02	Access Road enlarged to accommodate refuse vehicle & fire tender	28.05.25	MT	JL
P01	Preliminary Issue	14.05.25	MT	JL

CoDa+ Structures
Consulting Civil & Structural Engineers

14 Springfield Court
Guiseley
Leeds LS20 8FD
Tel: 01943 872567

Client: Mr J. Parkinson

Project: 160 Lane Head Road, Shepley, Huddersfield

Title: Refuse Vehicle & Fire Tender Tracking

Scale: 1:250 | Date: May '25 | Drawn: MT | Chkd: JL

Tender: Preliminary Construction As-Built

Dwg No: 8308-CoDA-SW-XX-DR-C-002 | Rev: P02