




- GENERAL NOTES**
- SETTING OUT SHALL BE UNDERTAKEN USING ONLY THE INFORMATION GIVEN. DISTANCES SHOULD NOT BE SCALED FROM THIS DRAWING.
  - ALL RETAINING WALLS AND INSTALLATION WORKS SHALL BE IN ACCORDANCE WITH GEOMAN CONSTRUCTION DETAILS
  - GROUND CONDITIONS TO BE INSPECTED PRIOR TO INSTALLATION OF LEVELING PAD.

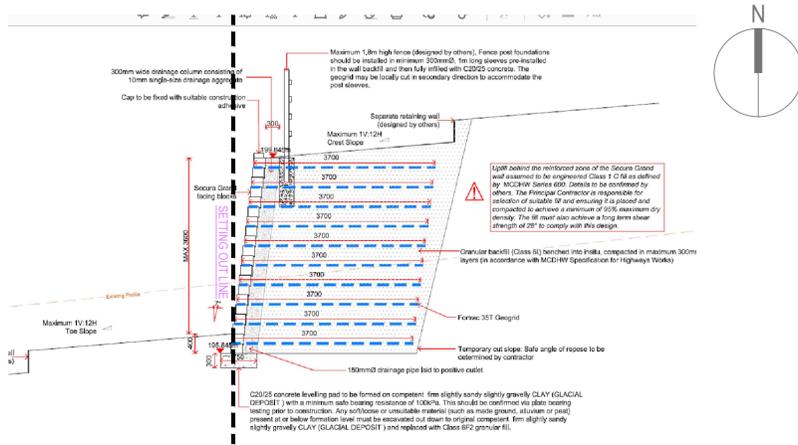

AB1	22.11.2024	AS BUILT ISSUE	JJR	JJR	JCM
C01	15.07.2022	CONSTRUCTION ISSUE	JPR	JCM	JLS
REV	DATE	DESCRIPTION	BY	CHK	APP
<b>DRAWING STATUS:</b>			<b>AS BUILT</b>		
<b>CLIENT:</b>			CASEY		
<b>ARCHITECT:</b>			TADW		
<b>PROJECT:</b>			BROAD OAK, LINTHWAITE		
<b>TITLE:</b>			RETAINING WALL SETTING OUT (2 OF 3)		
<b>STATUS:</b>	<b>PROJECT NUMBER:</b>	<b>DRAWING No:</b>	<b>REV:</b>		
S2	219-174	BRO-AJP-00-ZZ-DR-C-1421	AB1		
<b>SCALE @ A1:</b>	<b>DESIGNED:</b>	<b>DRAWN:</b>	<b>CHECKED:</b>	<b>APPROVED:</b>	<b>DATE:</b>
1:250	JCM	JCM	JLS	JLS	JULY 2022