


TYPICAL SECTION BOUNDARY RETAINING WALL - 1:20 @ A1

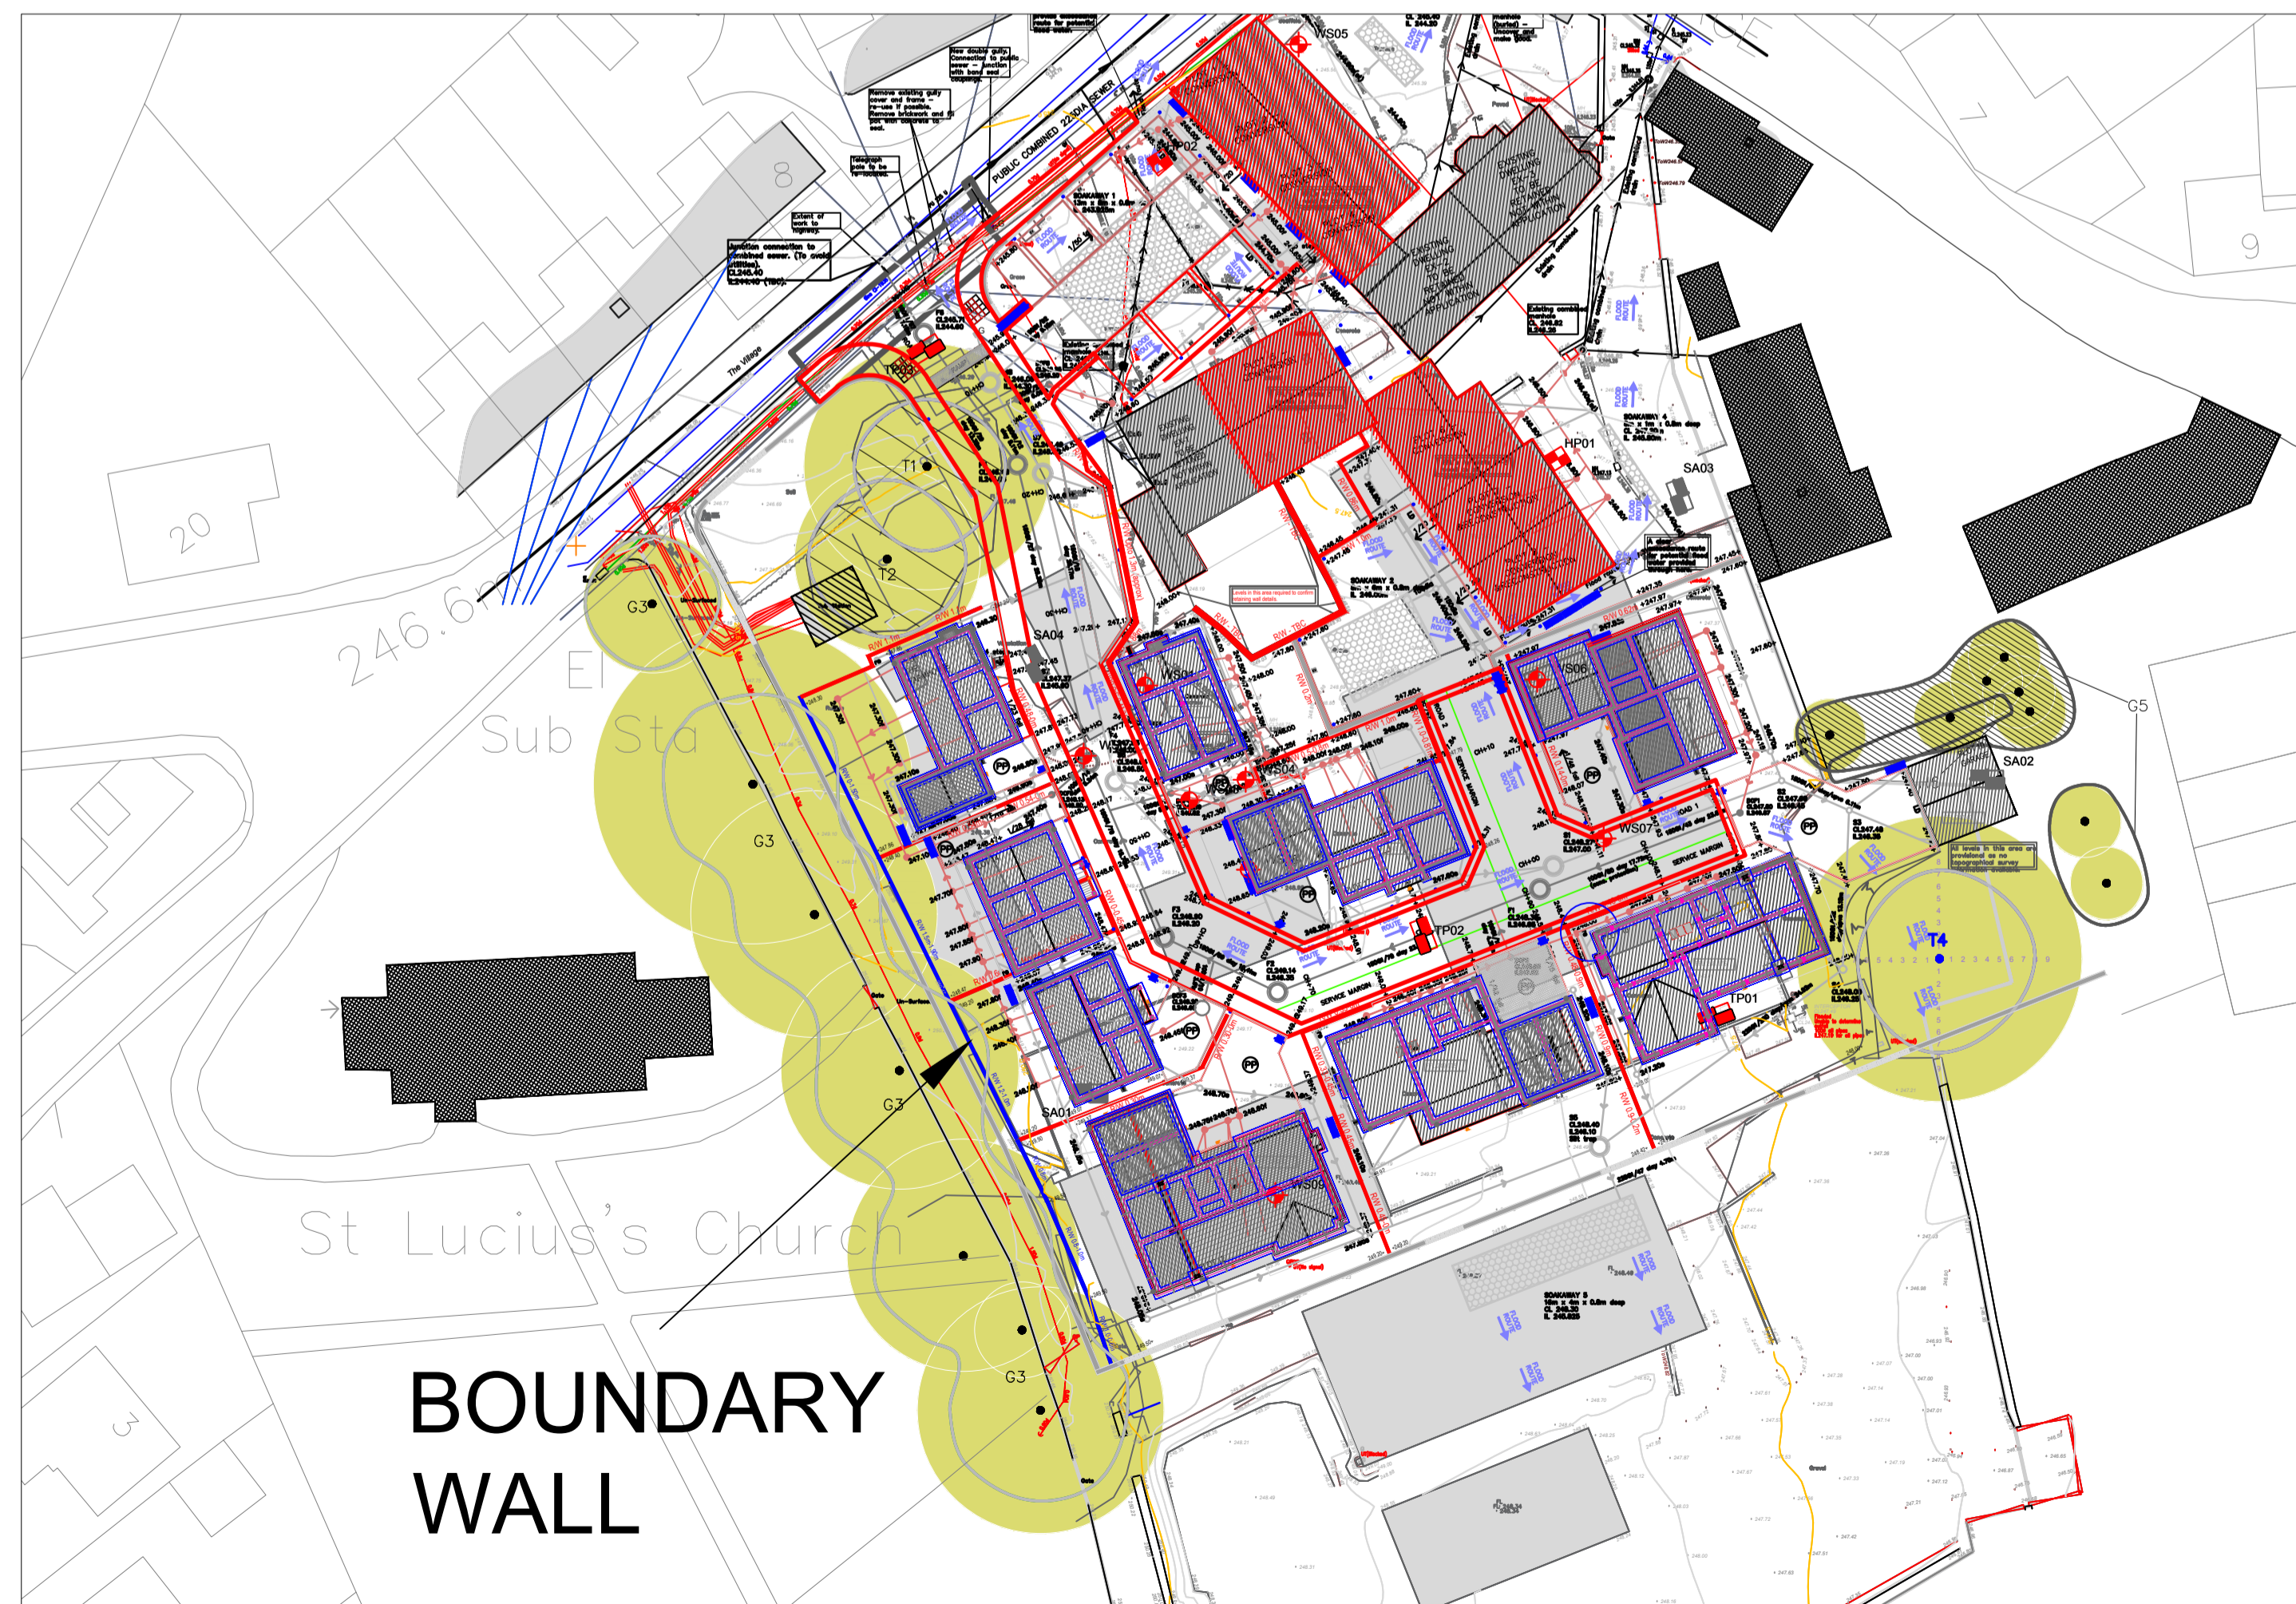

LOCATION OF BOUNDARY RETAINING WALL - 1:500 @ A1

NOTES:

1 Associated Information
This drawing should be read in conjunction with the following drawings and specifications:

- Bright Young Consulting Ltd Foundation Drawings.
- Architectural layouts for wall setting out, dpc's and damp proofing, standard details and insulation requirements.
- Site Investigation for ground conditions.

2 Existing Drains and Services

2.1 Obtain details of existing drains and services beneath or in the vicinity of the foundation works and take appropriate steps to protect the same during the construction of the works.

3 Bearing strata

3.1 Bearing Strata

- Natural clay or weathered sandstone anticipated as bearing strata as indicated in Phase 2 investigation report

NOTE

AS BUILT - FINAL ISSUE DRAWING IN ABSENCE OF SITE RECORDS CONFIRMING SITE MODIFICATIONS

Checked	Revisions	Description
	AB	AS BUILT
		22/09/25

Client
RADCLIFFE DEVELOPMENTS (FARNLEY) LTD

Job Title
PARK FARM FARNLEY TYAS

	The Media Centre 7 Northumberland Street Huddersfield HD1 1RL
	Web: www.brightyoung.co.uk Tel: 01484 487950 Fax: 01484 603519

Drawing Title
BOUNDARY RETAINING WALL

Scale	Date	Drawn	Checked
AS SHOWN	DEC 24		

Drg No.	1430/060	Rev	AB
---------	----------	-----	----