


The drawing is copyright © Eight One Two Architects Ltd. If in doubt... ASK. Drawing measurements shall not be obtained from scaling from the drawing. All dimensions are to be site verified prior to construction. Any discrepancies are to be reported to Eight One Two Architects Ltd immediately. This drawing is to be read in conjunction with all associated drawings and specifications including all relevant sub-consultants information.

Notes\_



PLANNING

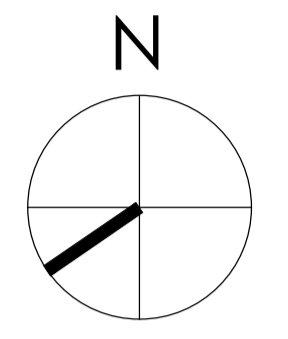


0 1000 2000 3000 4000 5000mm  
 SCALE 1:100

**Note:**  
 Surrounding contextual buildings and information are based on received ordinance survey drawings and are shown for illustrative purposes only. assumed site boundary is subject to confirmation to legal confirmation.

**Note:**  
 Information is based on OS map and received information and is subject to full topographical survey. Assumed site boundary and site constraints subject to legal confirmation. All Legal easements and extent of existing underground services locations are subject to confirmation.

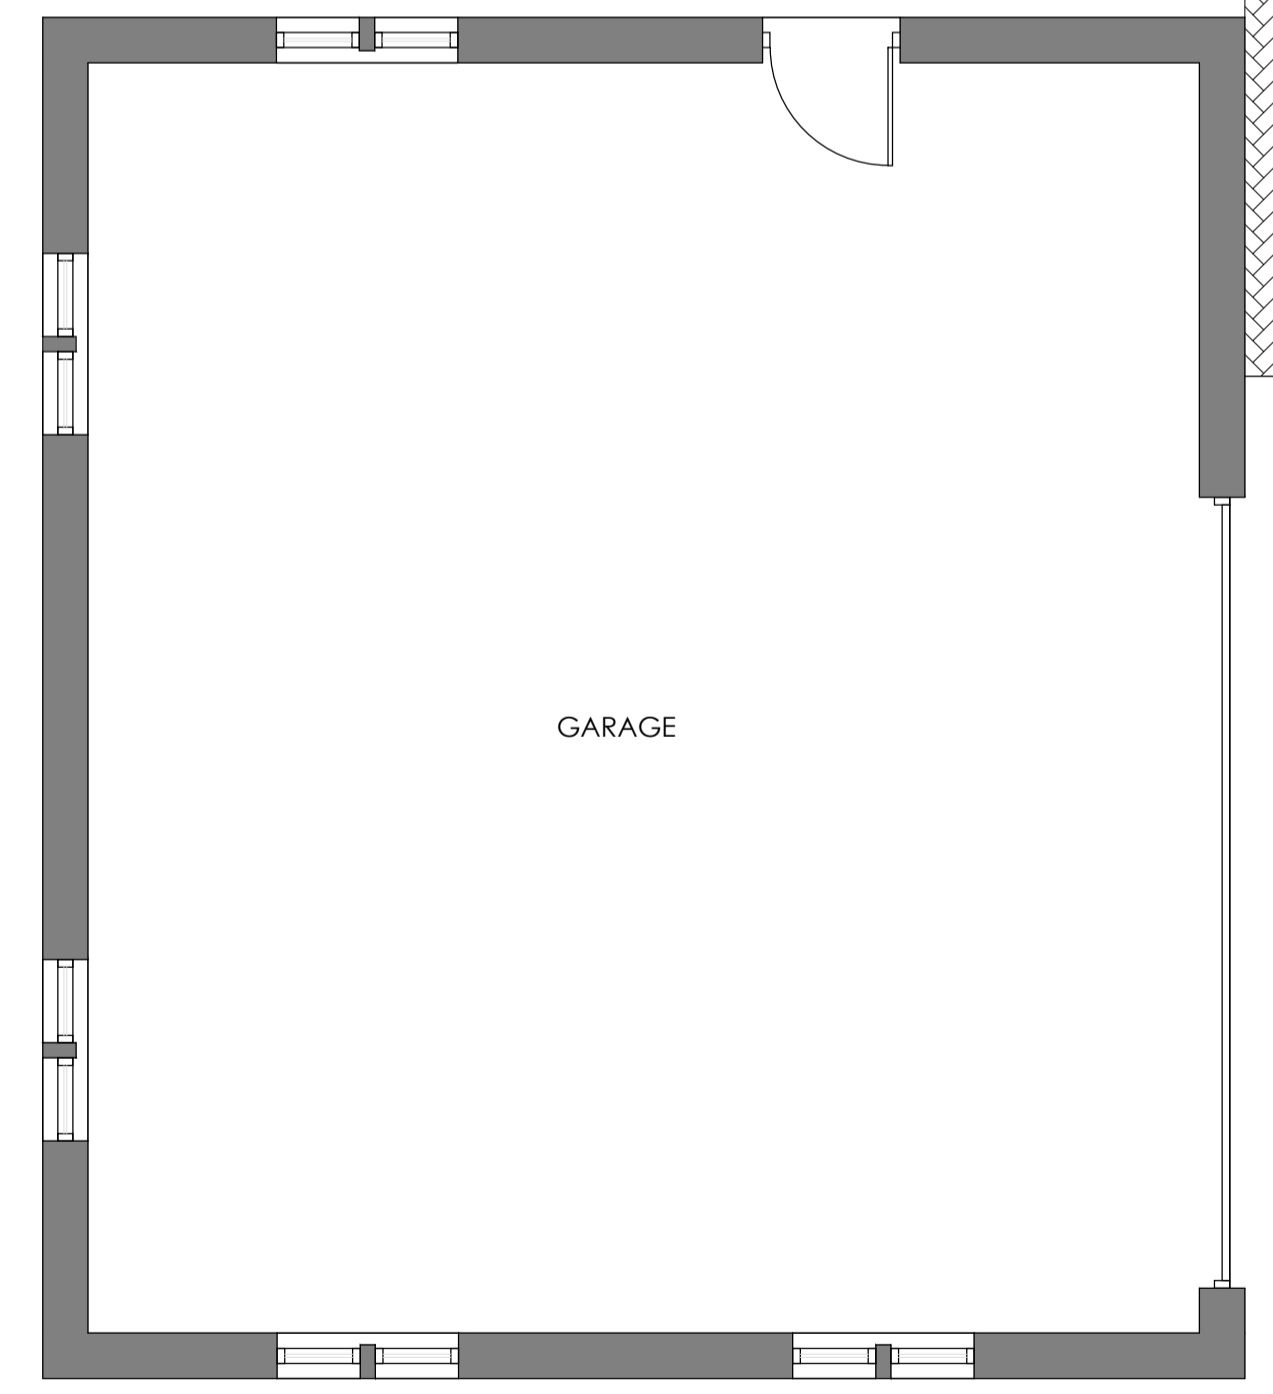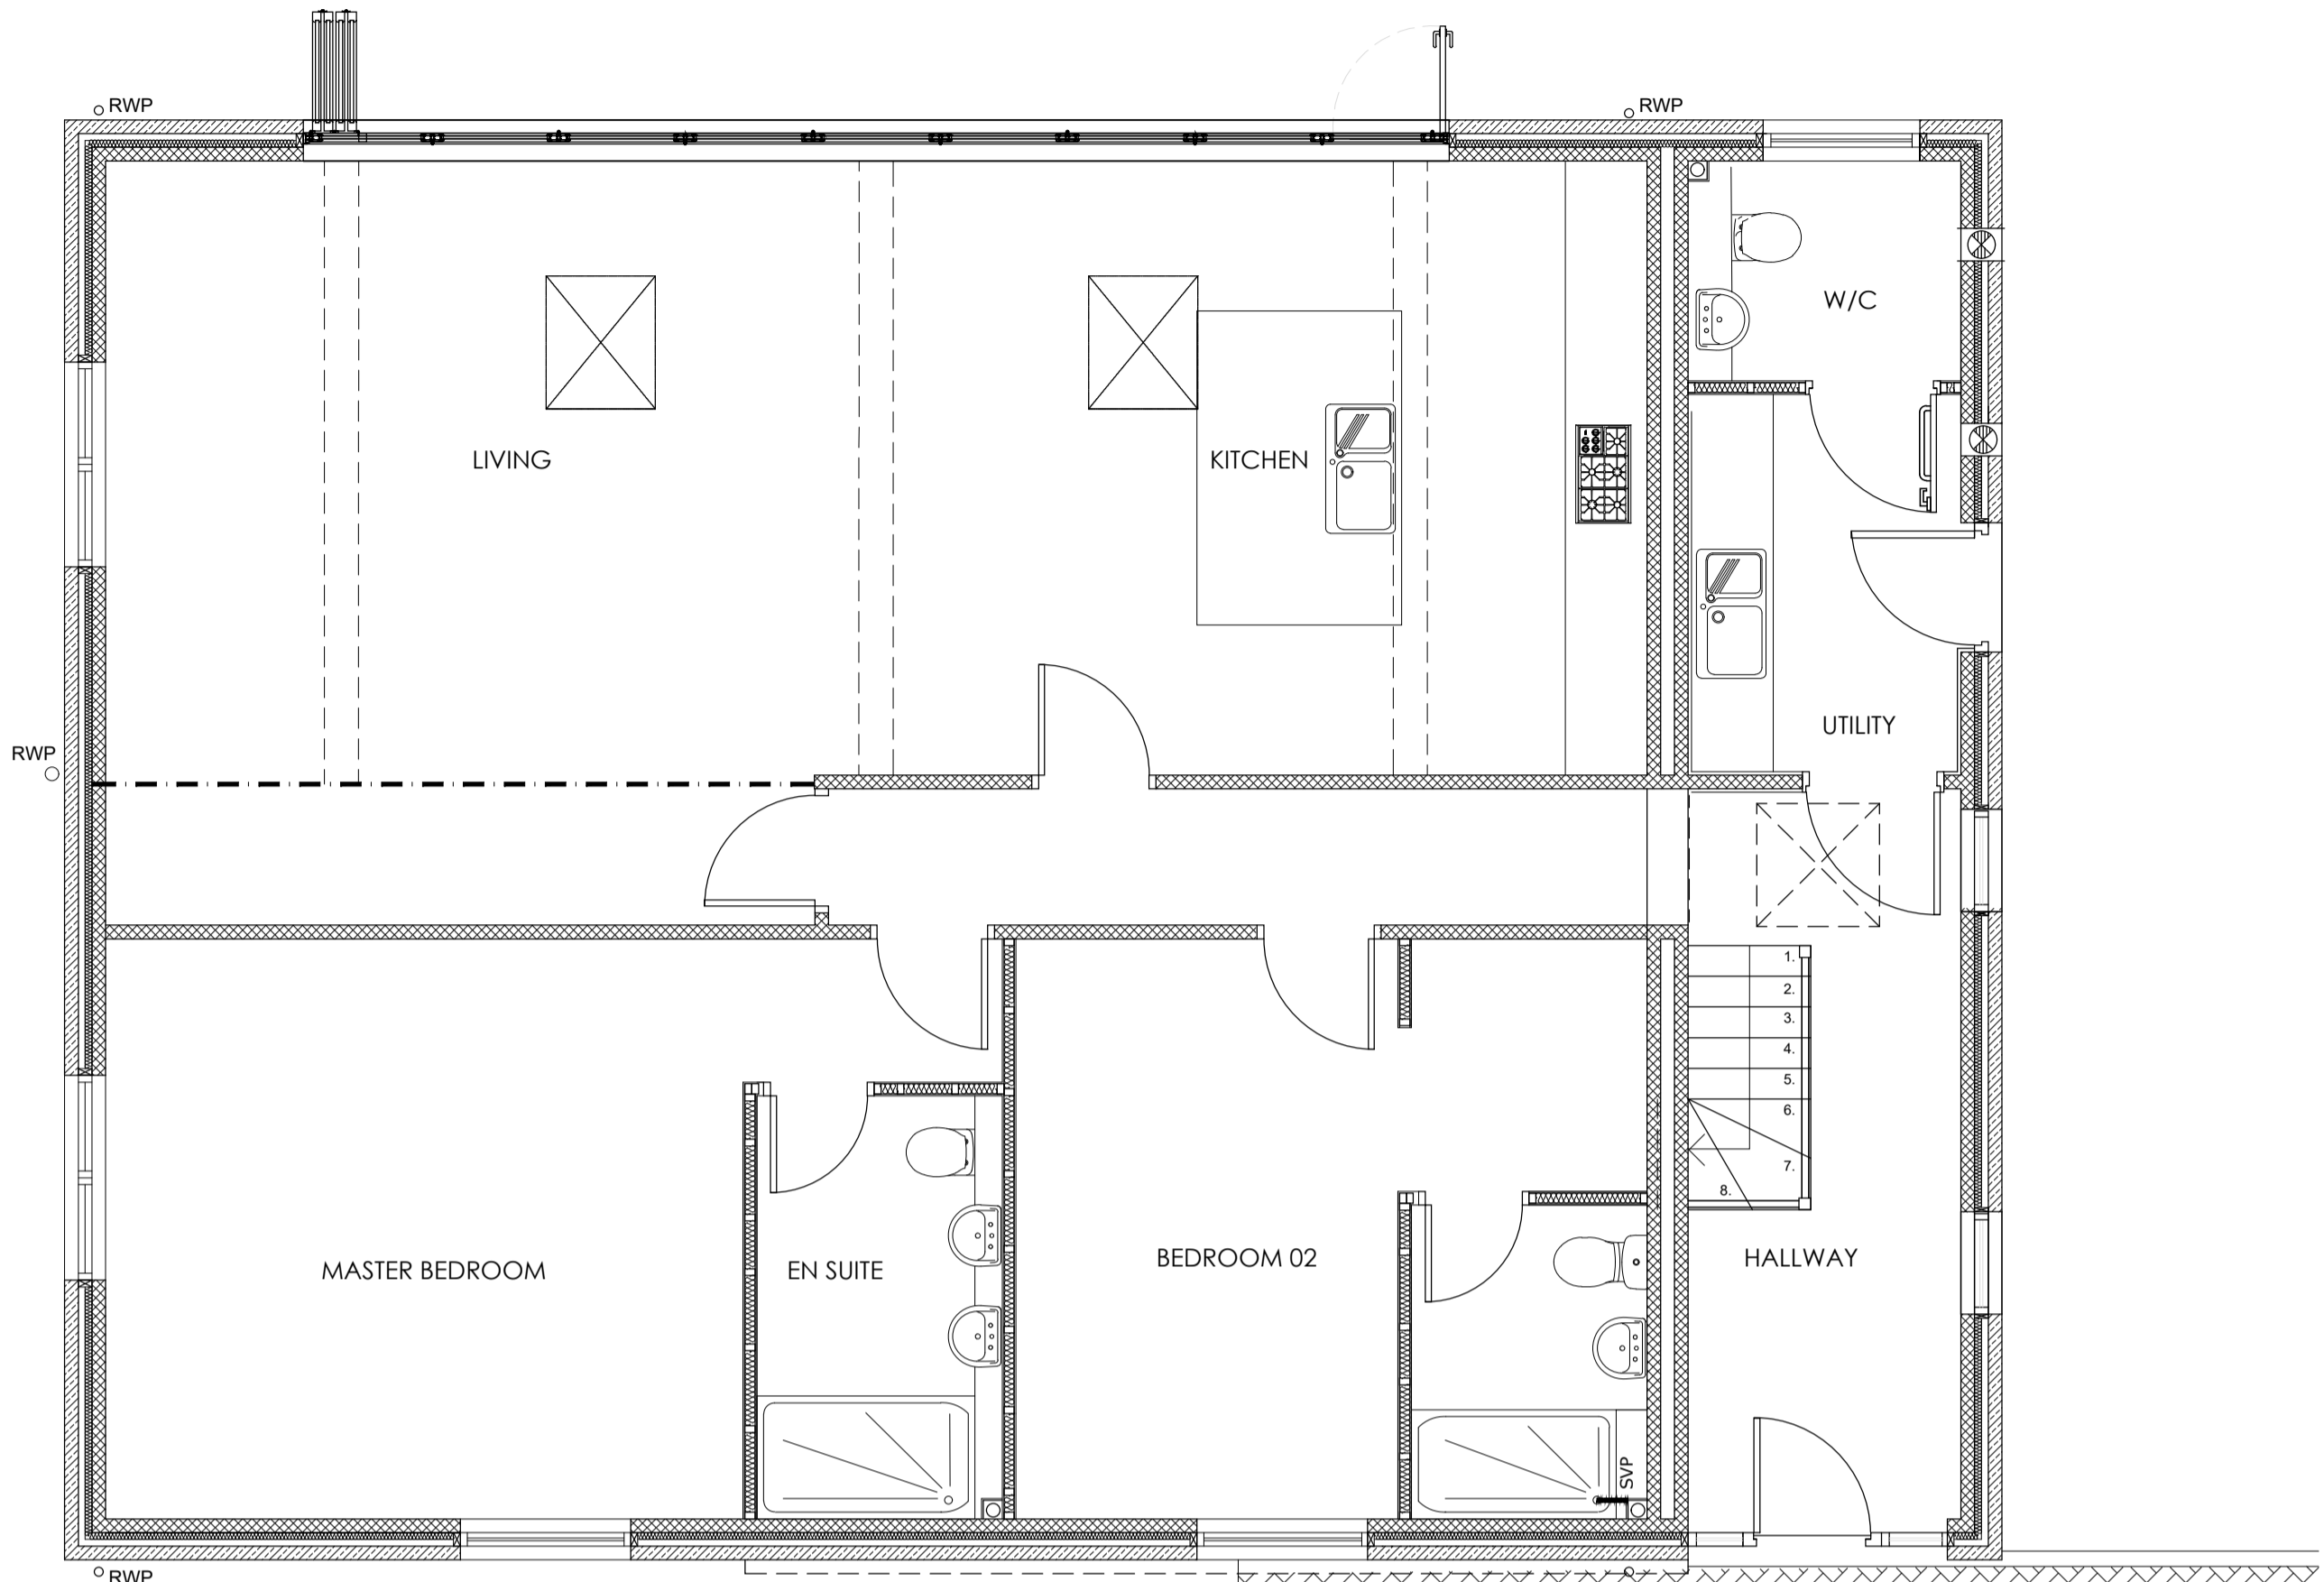

GROUND FLOOR PLANS\_ AS BUILT  
 Scale 1.50

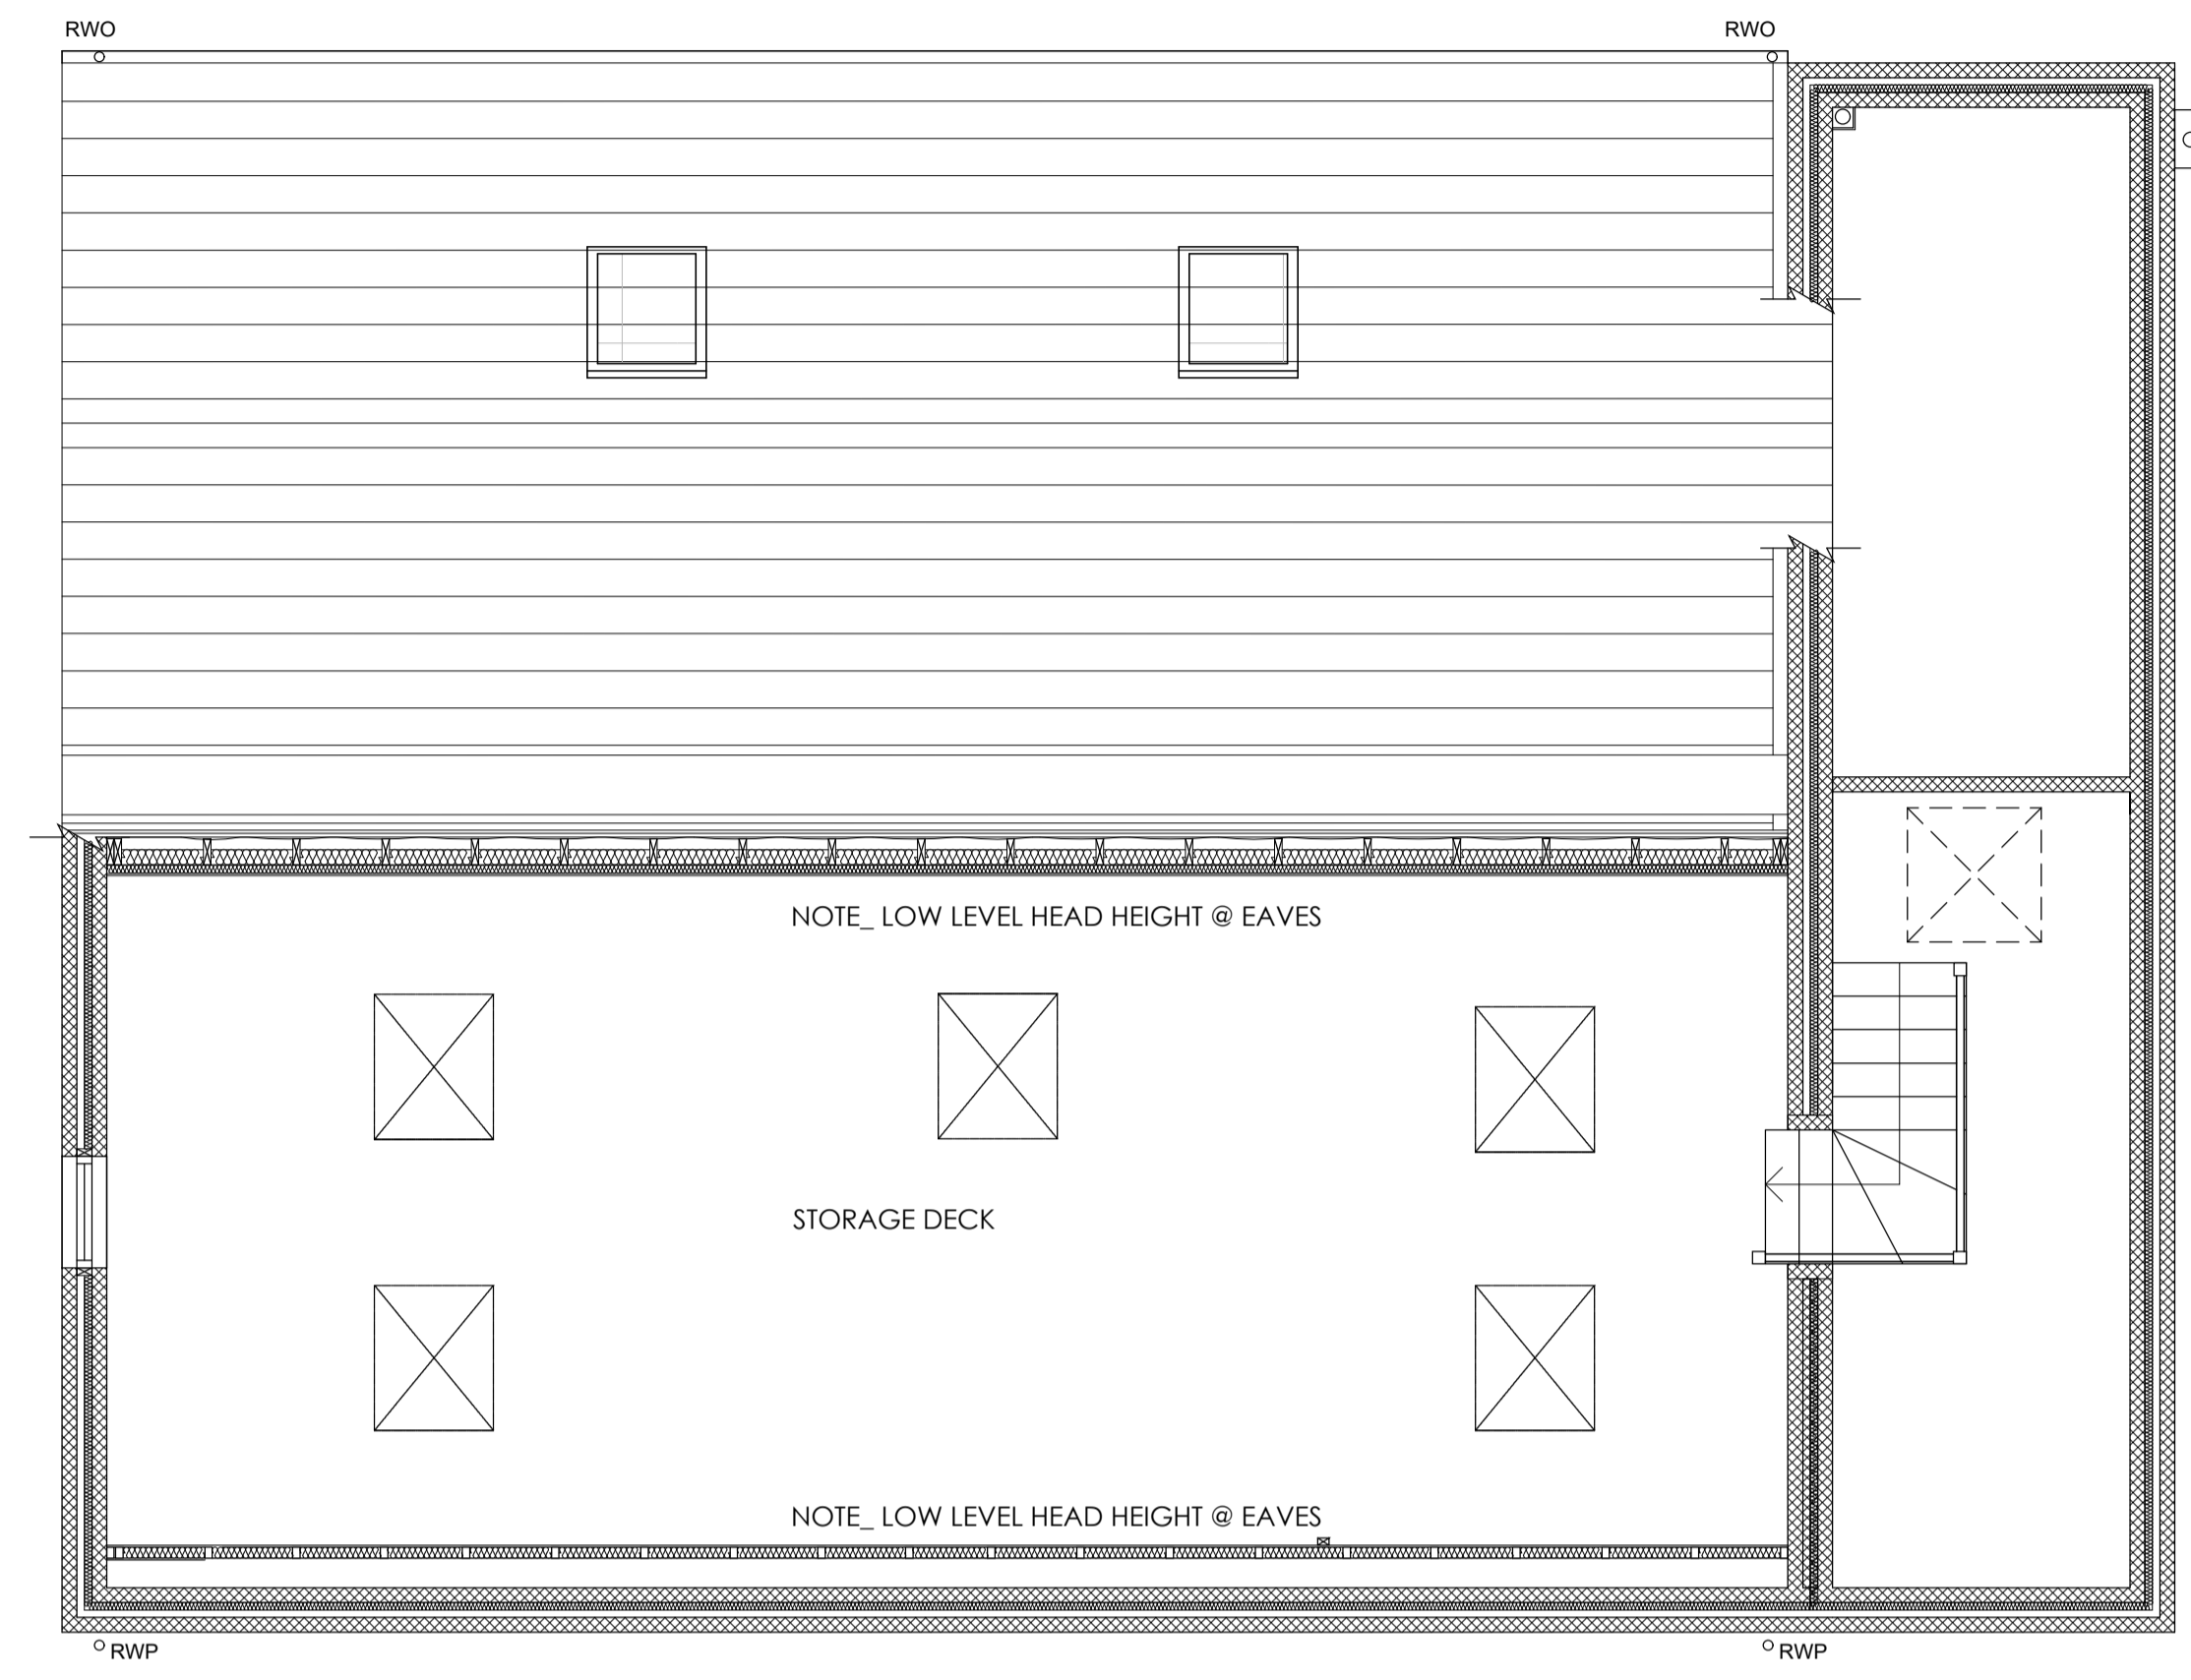

FIRST FLOOR PLAN\_ AS BUILT  
 Scale 1.50

Rev. Date. Amendment. By. April.

# Eight\_ OneTwo Architects

Tel. +44 (0)7761 570735  
 Email. mail@eightonetwo.co.uk  
 www.eightonetwo.co.uk  
 Studio A5, Brooke's Mill, Armitage Bridge, Huddersfield, HD4 7NR

Drawing Status\_ PLANNING

Client\_ MRS PAULINE HOUGH

Project\_ SPRING VILLA FARM, LONG LANE, HONLEY, HOLMFIRTH

Drawing Title\_ AS BUILT\_ FIRST FLOOR PLAN\_ PLOT 01

Drawing Scale\_ 1:50 Drawn By\_ JAL Checked By\_ JAL

Paper Size\_ A1 Drawn Date\_ MAY 2025 Checked Date\_ MAY 2025

Drawing Number\_ 25\_805 117