

NOTES

All efforts have been made in measuring existing site. However the contractor / builder is responsible, for checking & confirming all given dimensions on site prior to pricing & works.

Extent of boundary ownership confirmed by applicant.

Proposal -


Retrospective Planning Application for -
As-Built Detached Agricultural Building constructed with blockwork and faced with timber boarding & natural stonework.

Engineering Operations and the erection of a Retaining Wall.


External Materials of Construction (As-Built) -

Coursed natural stonework to lower parts of the walls with blockwork faced with timber Yorkshire Boarding with a minimum 10mm gap between the boards to remainder walls.

The roller shutter, loading dock doors and roof to be black metal colour finish.

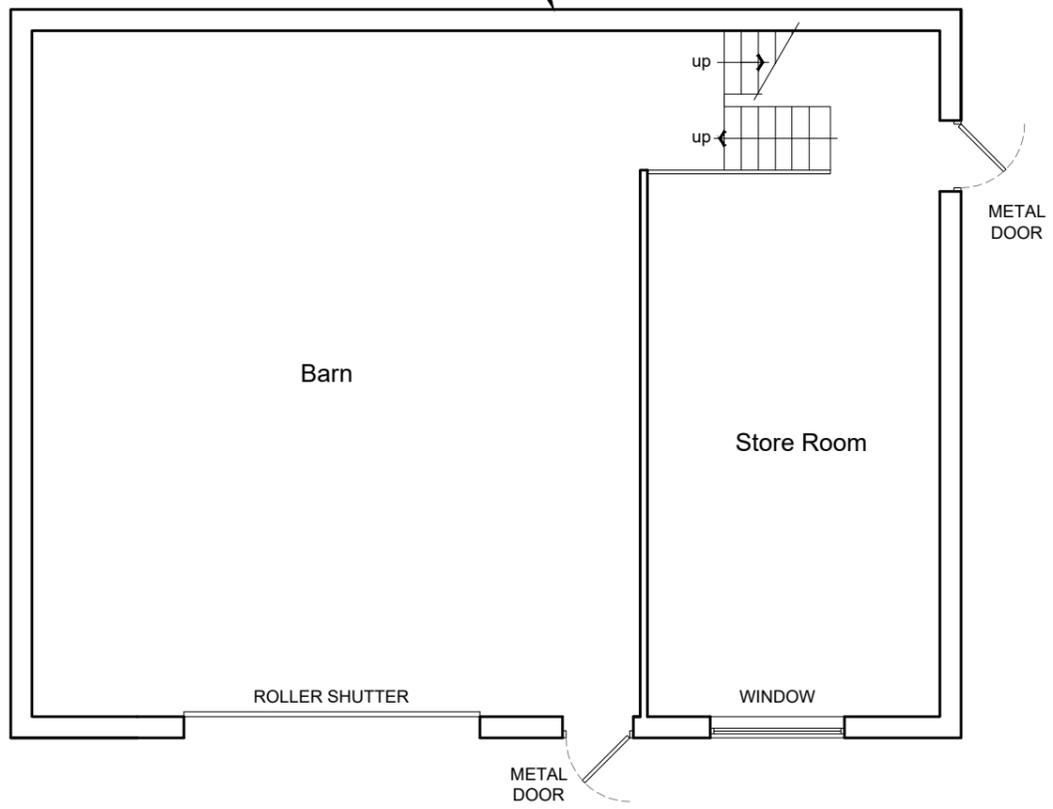

AS-BUILT
GROUND & LOWER GROUND FLOOR PLAN
SCALE - 1:100

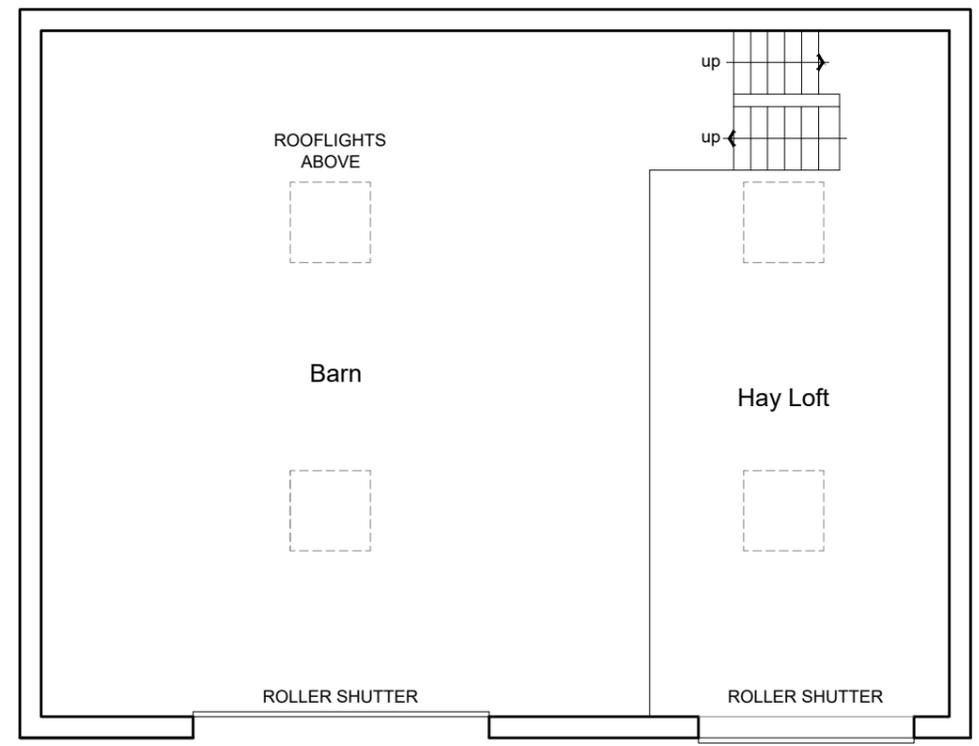

AS-BUILT
GROUND & LOFT PLAN
SCALE - 1:100

Retrospective Planning

Rev	Description	Date	By	App'd
-----	-------------	------	----	-------

tractus:dma
architectural design

Stross House, Scout Hill Mills, Broad Street
Dewsbury, West Yorkshire, WF13 3SA
t: 01924 462 550 m: 07791 717 404
e: asif@tractusad.co.uk

Client
Mr. N. Smith

Project
Town End Farm
Holmbridge, HD9 2QY

Drawing title
As-Built Floor Plans

Drawn by AM	Date 06/25	App'd -
Drawing no PL-02	Project no 25-973	Scale @ A3 1:100
		Rev -