


Do not scale from this drawing. **tractus:dma** must be notified immediately should any discrepancies be found. The contractor must check all dimensions on site before construction or manufacture of materials. This drawing or any portion of it may not be reproduced without the consent of **tractus:dma**.

NOTES


All efforts have been made in measuring existing site. However the contractor / builder is responsible, for checking & confirming all given dimensions on site prior to pricing & works.

Extent of boundary ownership confirmed by applicant.


Proposal -
Retrospective Planning Application for -
As-Built Detached Agricultural Building constructed with blockwork and faced with timber boarding & natural stonework.
Engineering Operations and the erection of a Retaining Wall.

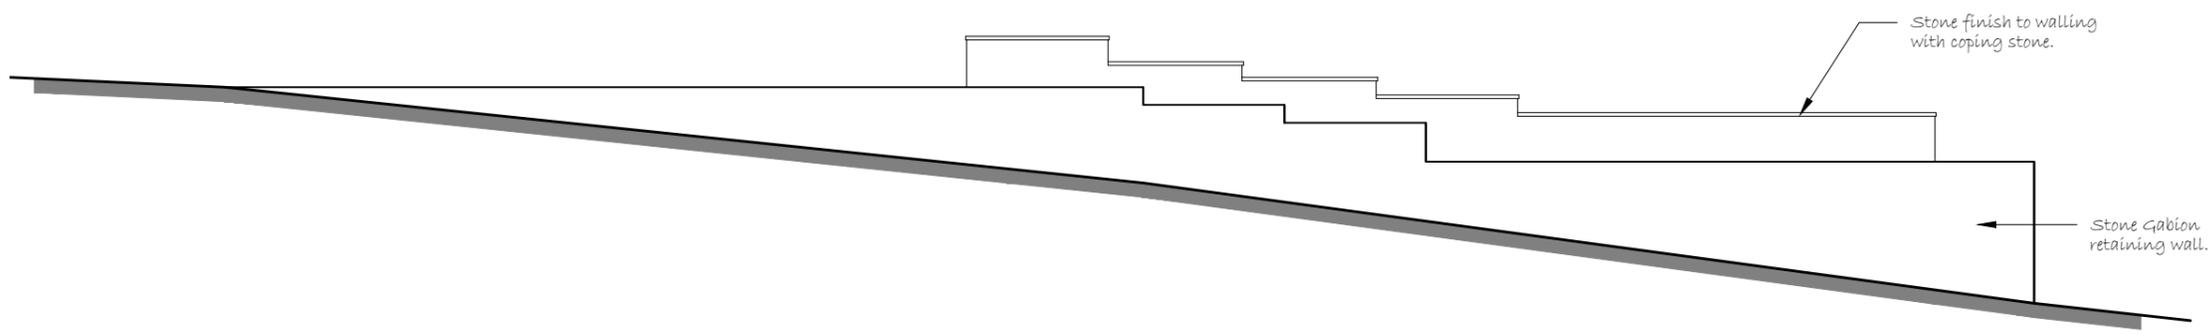


RETAINING WALL
ELEVATION A-A
SCALE - 1:100

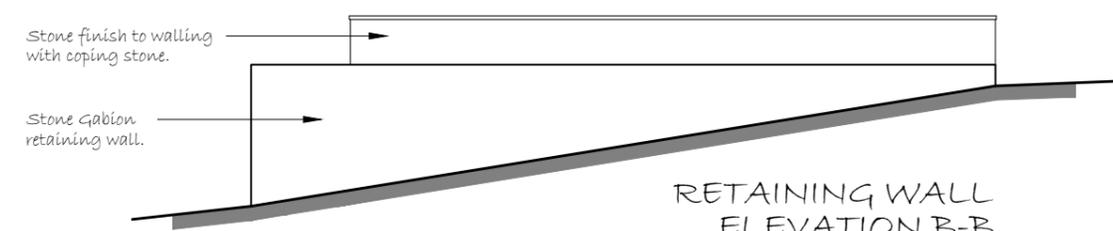


RETAINING WALL
ELEVATION B-B
SCALE - 1:100

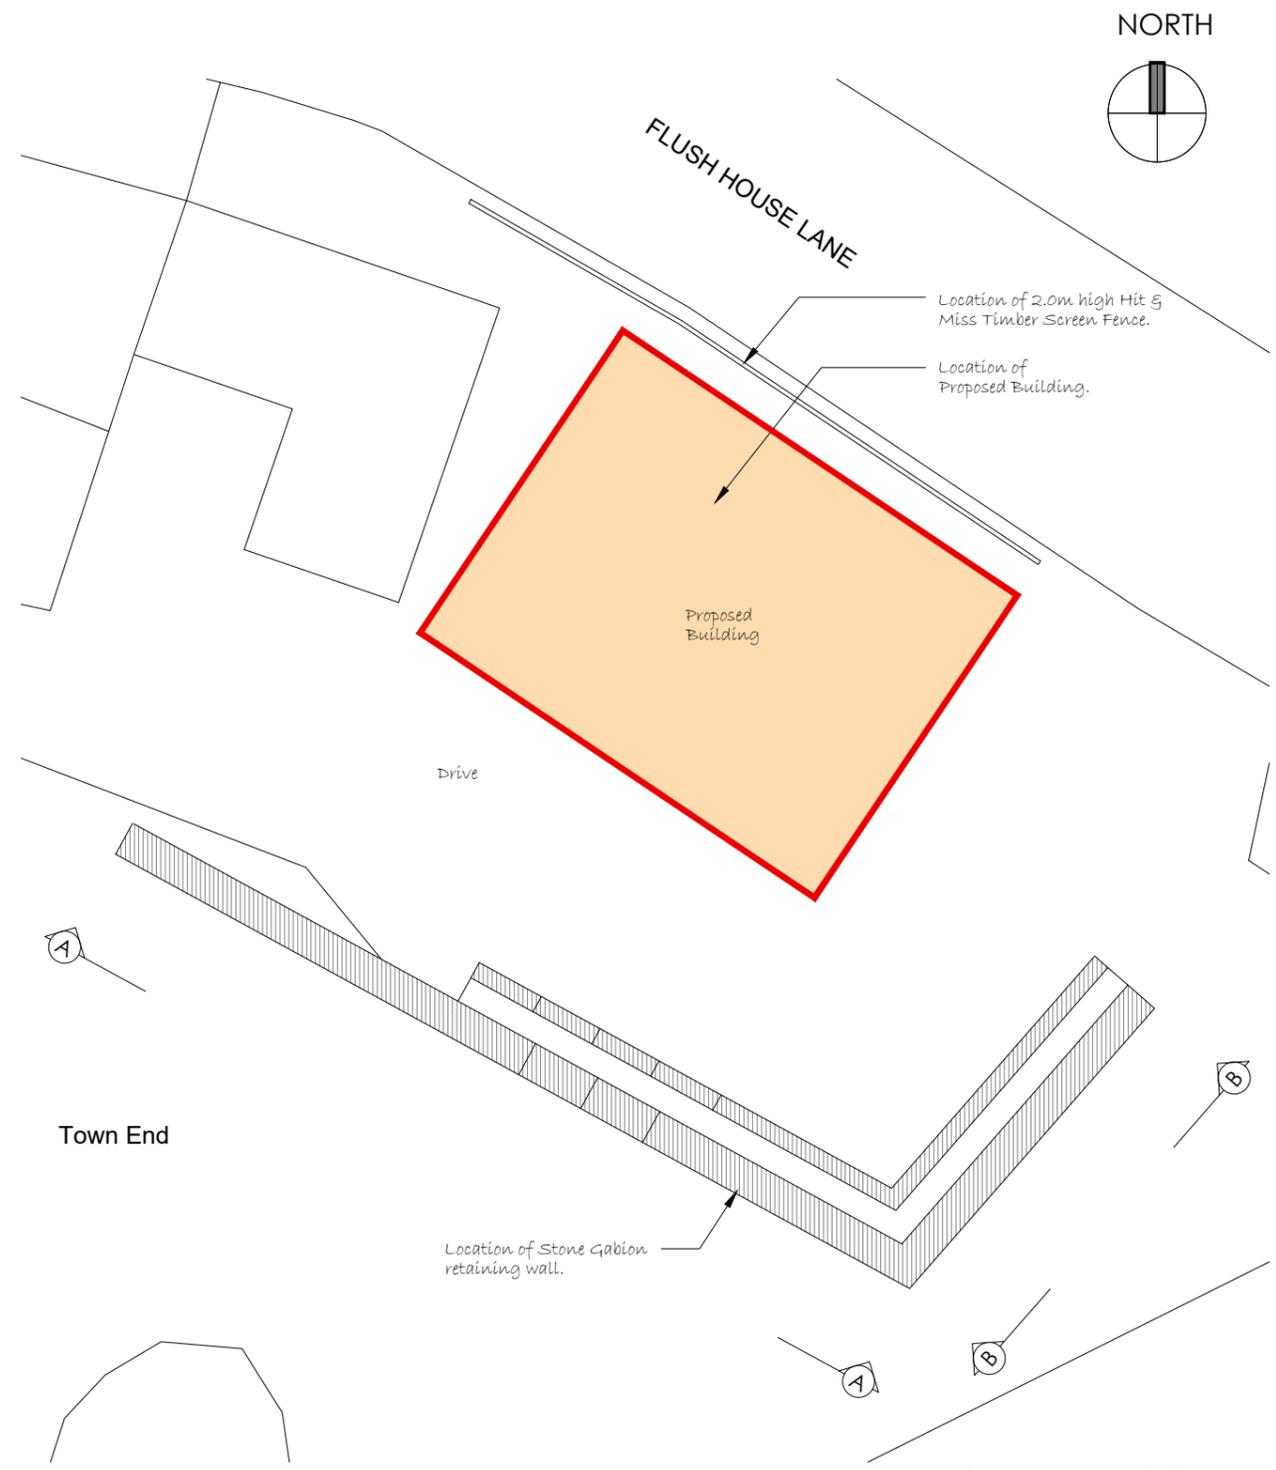

AS-BUILT SITE PLAN
SCALE - 1:200

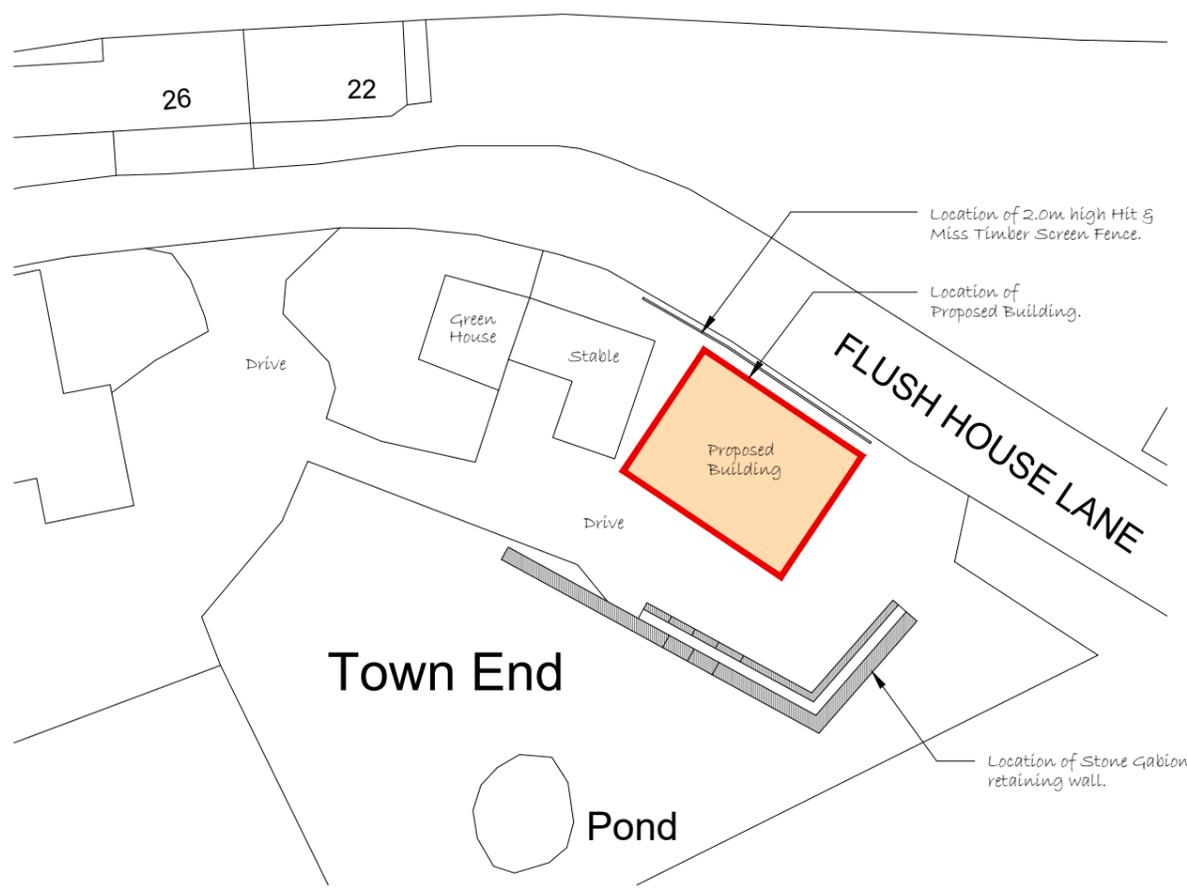

AS-BUILT SITE PLAN
SCALE - 1:500

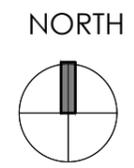

Retrospective Planning

Rev	Description	Date	By	App'd
A	Site plan updated, elevations added.	11/07/25	AM	-

tractus:dma
architectural design

Stross House, Scout Hill Mills, Broad Street
Dewsbury, West Yorkshire, WF13 3SA
t: 01924 462 550 m: 07791 717 404
e: asif@tractusad.co.uk

Client
Mr. N. Smith

Project
Town End Farm
Holmbridge, HD9 2QY

Drawing title
As-Built Site Plan and
Retaining Wall Elevations

Drawn by AM	Date 06/25	App'd -
----------------	---------------	------------

Drawing no PL-01	Project no 25-973	Scale @ A3 A.S.	Rev A
---------------------	----------------------	--------------------	----------