

NOTES

All efforts have been made in measuring existing site. However the contractor / builder is responsible, for checking & confirming all given dimensions on site prior to pricing & works.


Extent of boundary ownership confirmed by applicant.

Proposal -


Retrospective Planning Application for -

As-Built Detached Agricultural Building constructed with blockwork and faced with timber boarding & natural stonework.


Engineering Operations and the erection of a Retaining Wall.

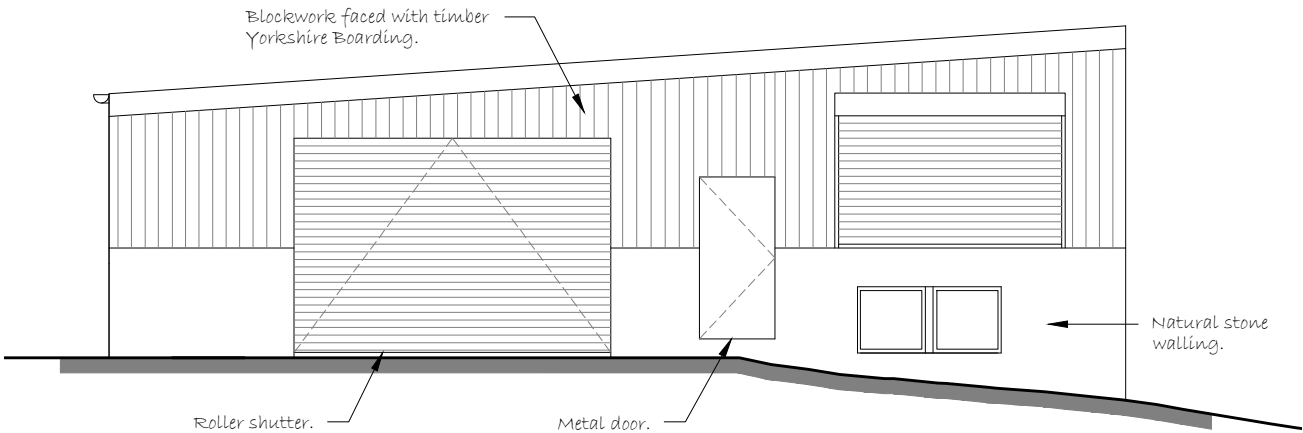


AS-BUILT
FRONT (SW) ELEVATION
SCALE - 1:100

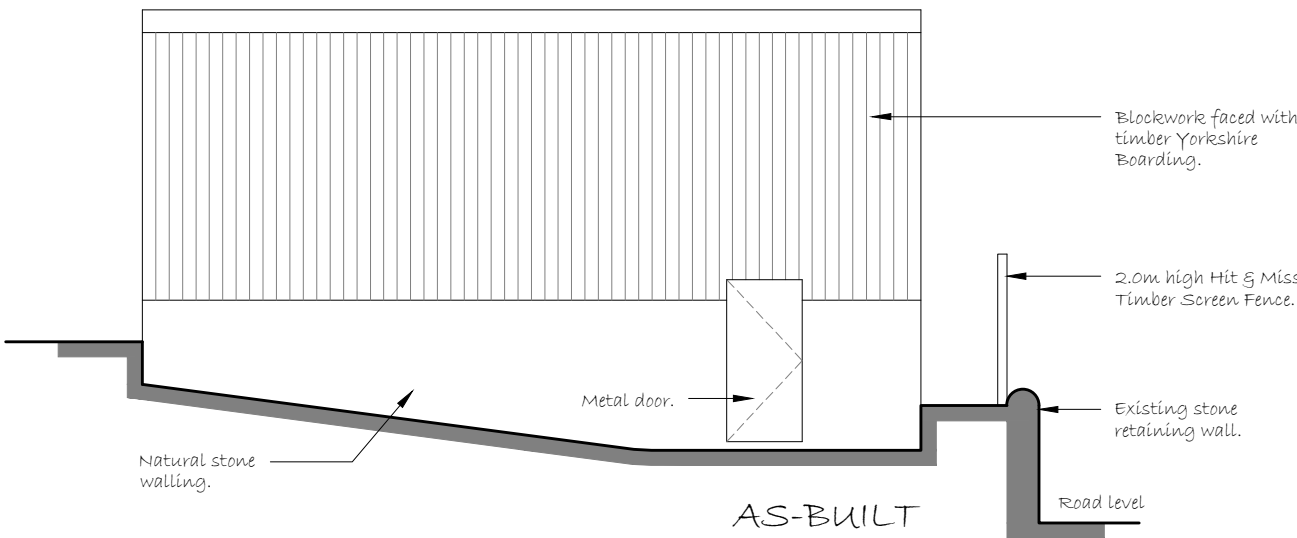

AS-BUILT
SIDE (SE) ELEVATION
SCALE - 1:100

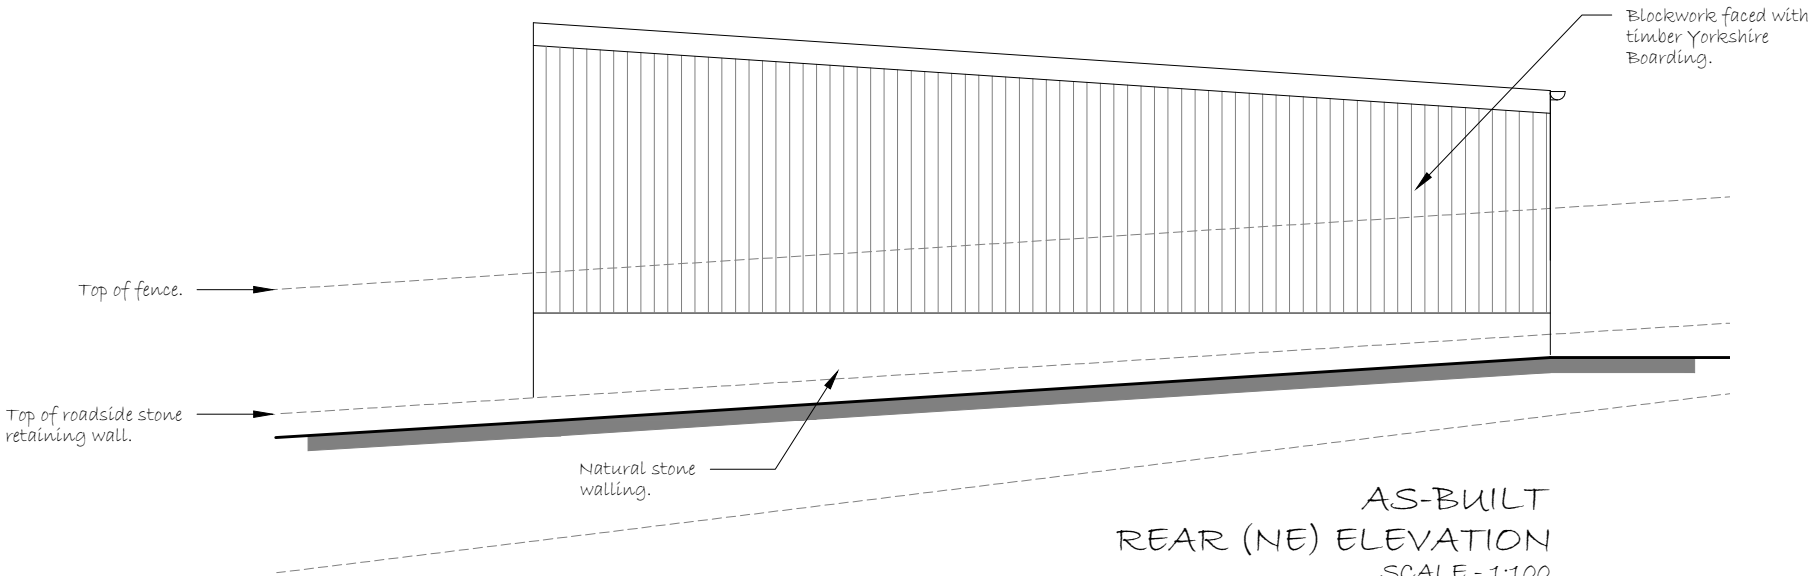

AS-BUILT
REAR (NE) ELEVATION
SCALE - 1:100

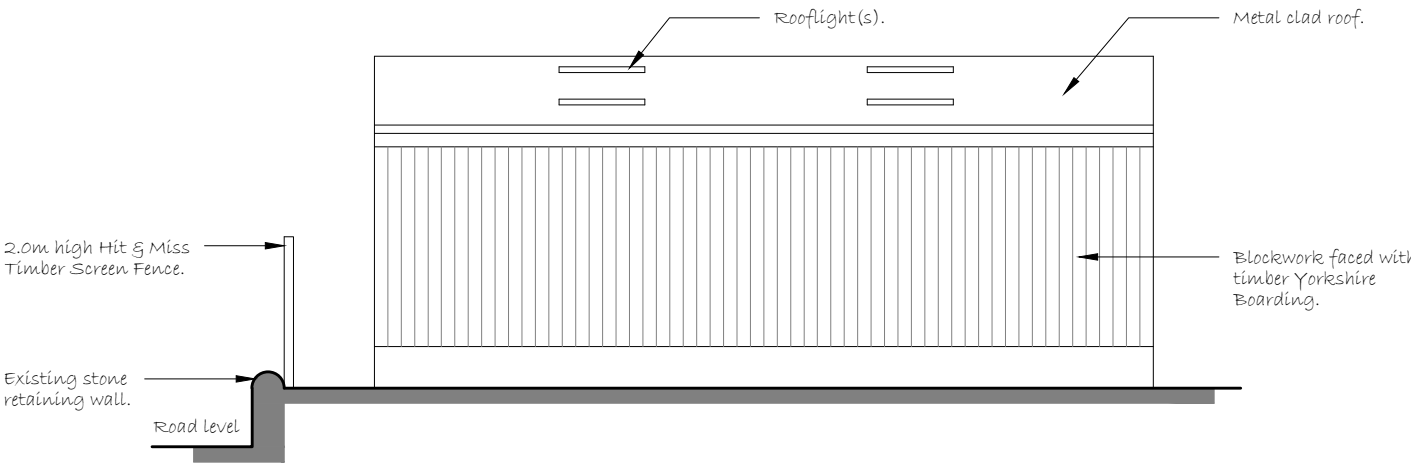

AS-BUILT
SIDE (NW) ELEVATION
SCALE - 1:100

Retrospective Planning

A	Timber fence description amended.	11/07/25	AM	-
Rev	Description	Date	By	App'd

tractus:dma
architectural design

Stross House, Scout Hill Mills, Broad Street
Dewsbury, West Yorkshire, WF13 3SA
t: 01924 462 550 m: 07791 717 404
e: asif@tractusad.co.uk

Client
Mr. N. Smith

Project
Town End Farm
Holmbridge, HD9 2QY
Drawing title
As-Built Elevations

Drawn by AM	Date 06/25	App'd -
Drawing no PL-03	Project no 25-973	Scale @ A3 1:100
		Rev A