

A1

WOODHEAD ROAD


BAN.

S13 INSTALLED BY HIGHWAYS CONTRACTOR AND NOT SUBJECT OF THESE WORKS

LEGEND - PROPOSED SITE DRAINAGE	
ELEMENT	SHOWN AS
PROPOSED FOUL DRAINAGE EXTERNAL 150mm Ø	
PROPOSED SW & FW PC RING MANHOLE	
PROPOSED SW DRAIN	
PROPOSED GULLY CONNECTION 150mm DIAMETER	
PROPOSED ACO CHANNEL	
PROPOSED 60mm Ø RISING MAIN	
RAIN WATER PIPE	RWP
EXISTING MANHOLES (FOUL & SURFACE)	
EXISTING FOUL WATER	Ex.Foul
EXISTING SURFACE WATER	Ex.Storm
PROPOSED GULLY	
ATTENUATION TANK	

NOTE:  
LEGEND WORKS IN GREY NOT PART OF ENABLING WORK CONTRACT

AS BUILT DRAWING

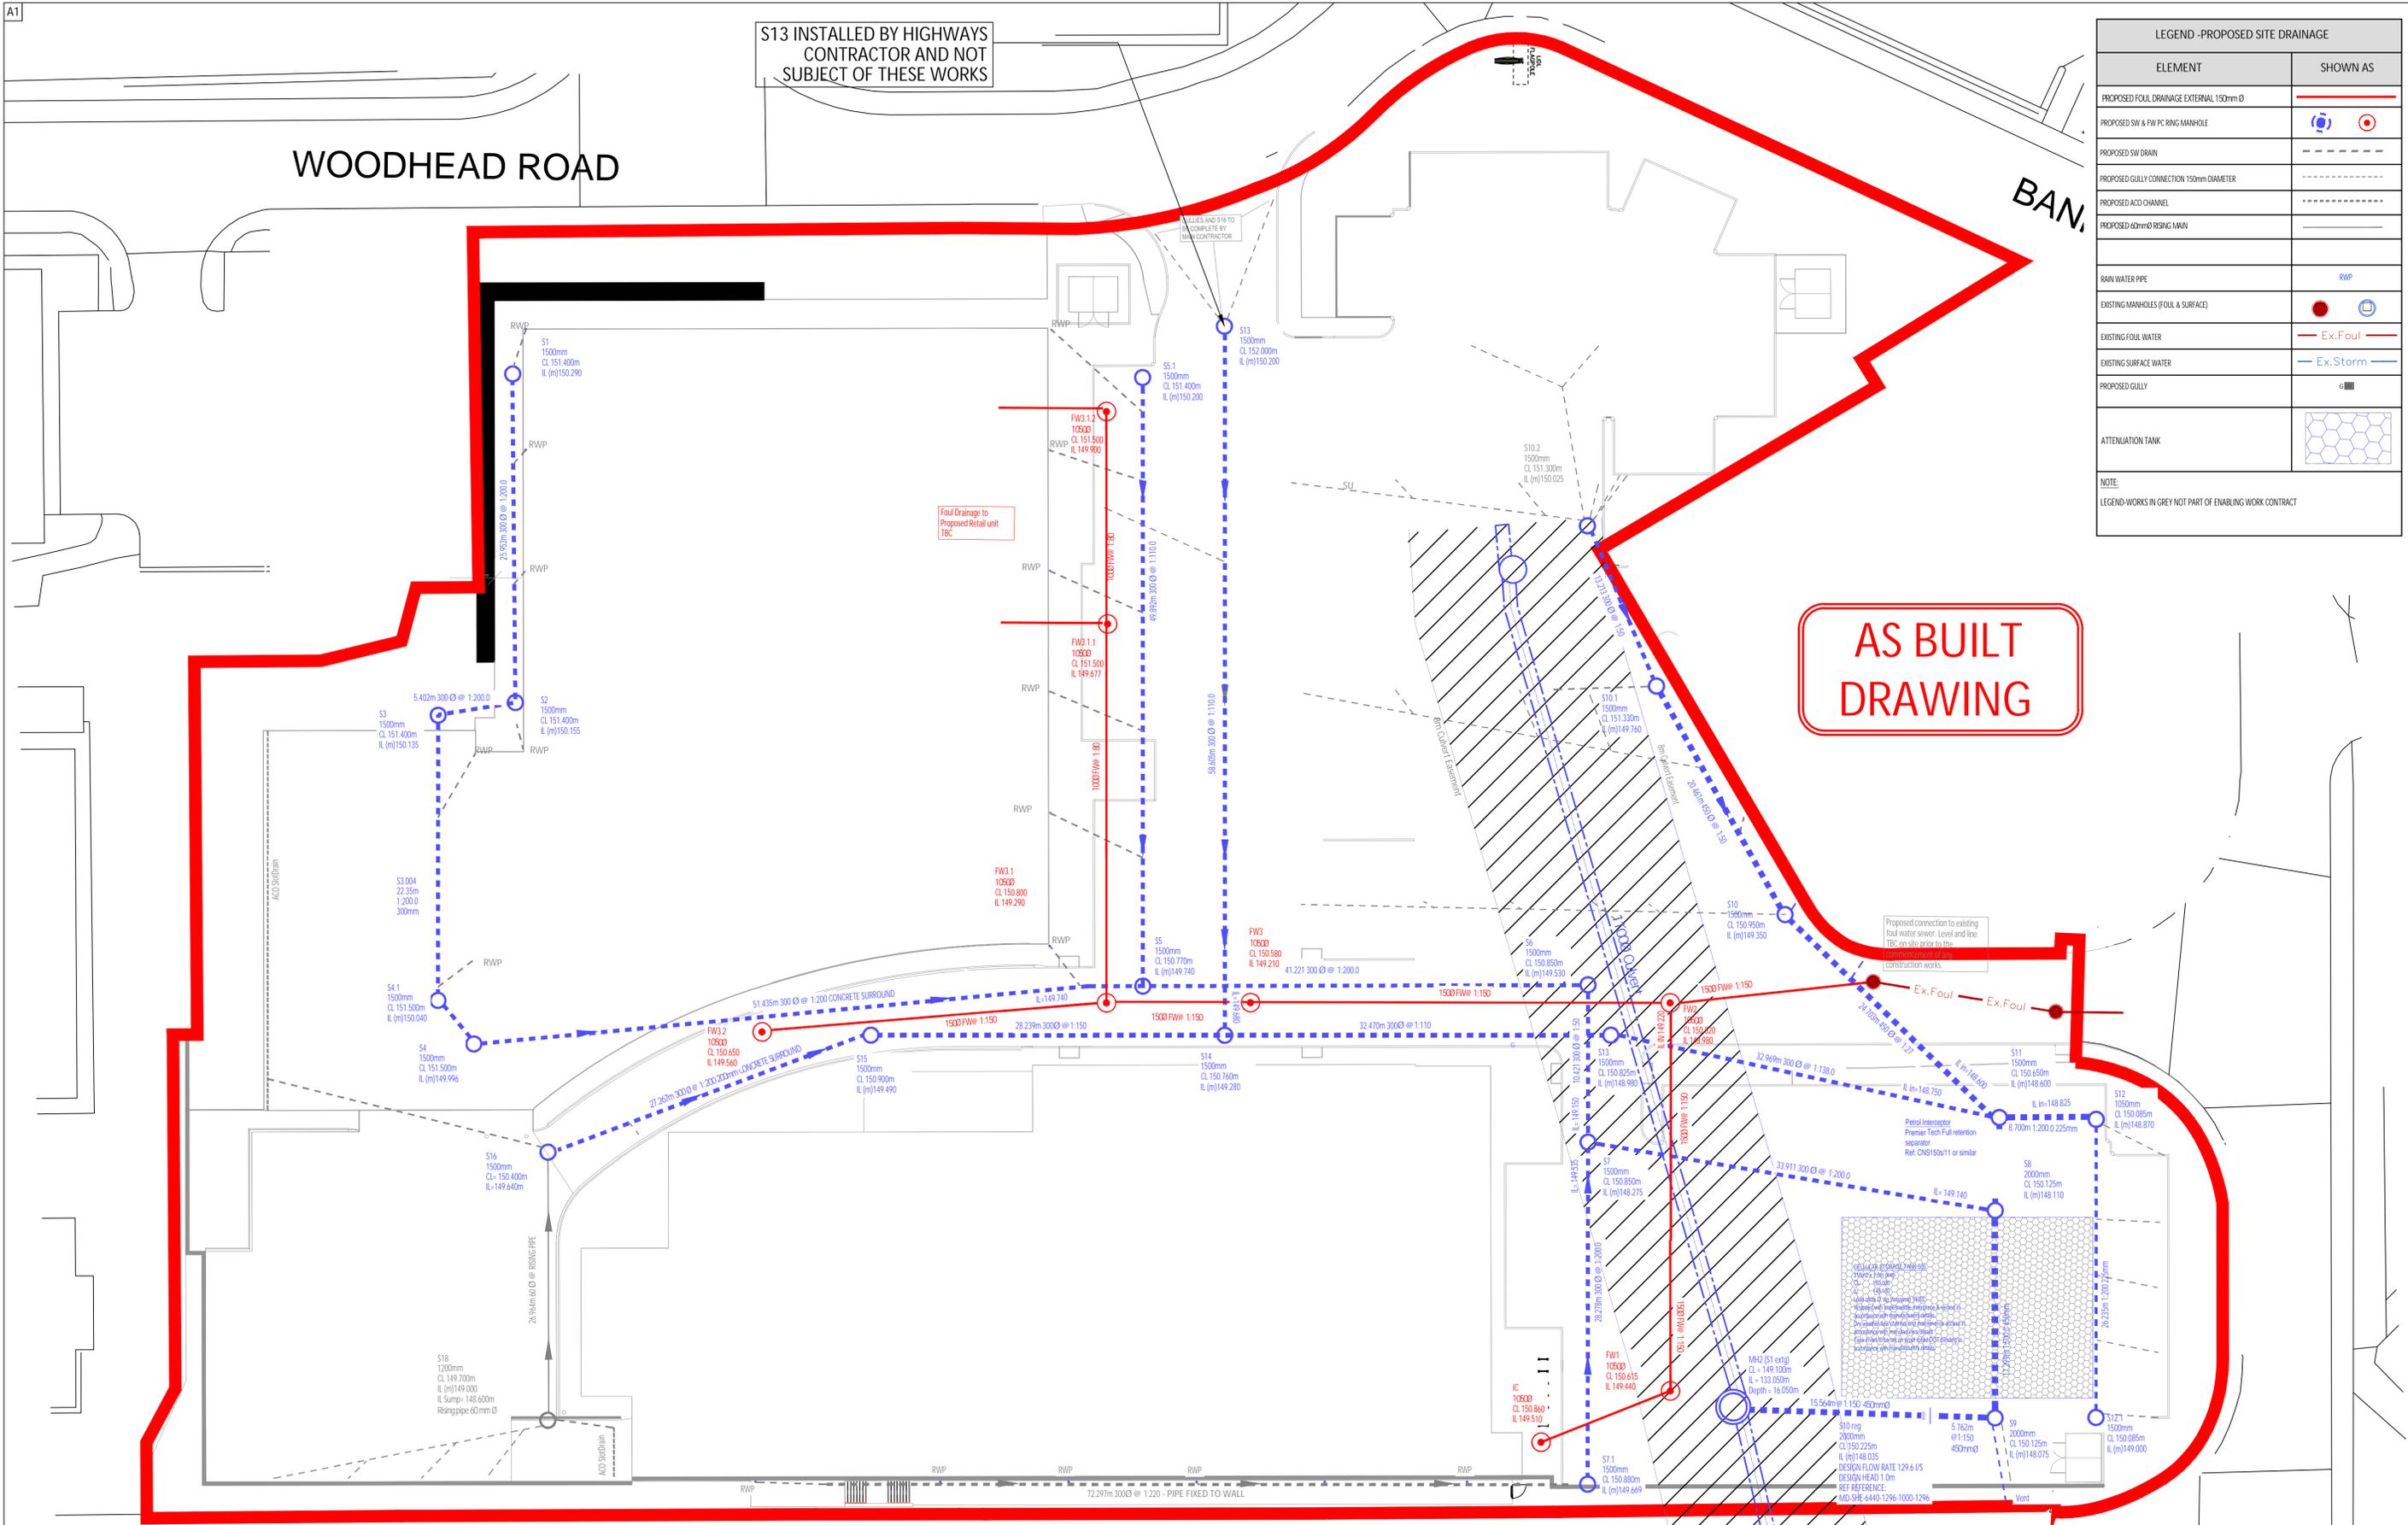

© THIS DRAWING IS PROTECTED BY COPYRIGHT AND IS THE PROPERTY OF SDS (Structural Design Solutions) Ltd. IT MAY NOT BE USED, REPRODUCED OR DISCLOSED TO ANYONE WITHOUT THE PRIOR WRITTEN APPROVAL OF THE AUTHORS.

**CIVIL, STRUCTURAL & BUILDING ENGINEERS**  
DUBLIN LONDON CASTLEBAR SPAIN

Head Office: Unit 9, NS Business Park, Castlebar, Co. Mayo F23 E383. Tel: +353 (0)94 9034914  
Dublin: Silverdale, Old Swards Road, Dublin 9, D09 CA24. Tel: +353 (0)1 6877480  
London: Bridge House, 25-27 The Bridge, Wealdstone, Harrow, HA3 5AB. Tel: +44 (0)20 30266724  
Spain: Calle Virgen de Guadalupe, 44, Ubeda, 23400, Jaen.

**SDS**  
design engineers

Info@structuraldesign.ie Web: www.structuraldesign.ie

**DRAWING NOTES:**

- This Drawing is to be read in conjunction with the relevant Specifications & other Architectural & Engineering Drawings. Engineers to be informed immediately of any discrepancies before work proceeds.
- Do Not Scale from this Drawing - Metric Figured Dimension only are to be used.
- It is the Contractors' responsibility to ensure that all works are carried out in accordance with the requirements of the current Building Regulations and all other statutory documents relevant to this project including the grant of planning permission, Fire Safety Certificate and Disability Access Certificate.
- SDS (Structural Design Solutions) Ltd / SDS-UK (Structural Design Solutions) Ltd. bear no liability for unilateral changes/modifications made during the course of construction based on the drawing prepared, without prior consultation and confirmation of acceptance of the revision by SDS (Structural Design Solutions) Ltd / SDS-UK (Structural Design Solutions) Ltd.

REV.	DATE:	BY:	DESCRIPTION:
AB1	15.01.2026	PM	ISSUED FOR AS BUILT

**STONEDALE CONSTRUCTION**

Project No: **PROPOSED NEW LIDL BIRSTALL, BANKWOOD WAY BIRSTALL, UK**

Drawing No: **SITE LAYOUT FOUL SEWER & SURFACE WATER LAYOUT**

Scale: **1:250**

Drawn by: **PM**

Project No: **25289-SDS-00-SL-DR-C-3021**

Sheet No: **AB1**

Scale:	Project No:	Sheet:
1:250	A1	CONSTRUCTION
Drawn by:	Date:	Checked:
PM	JAN 2026	MM
Drawing No:	Revision:	
25289-SDS-00-SL-DR-C-3021	AB1	