


# WOODHEAD ROAD



LEGEND - SITE LAYOUT	
ELEMENT	SHOWN AS
HIGHWAY BOUNDARY	[Red line]
ARBUS VEHICLE RESTRAINT BARRIER	[Blue line]
PROPOSED PEDESTRIAN PARAPET 1.15m	[Green line]

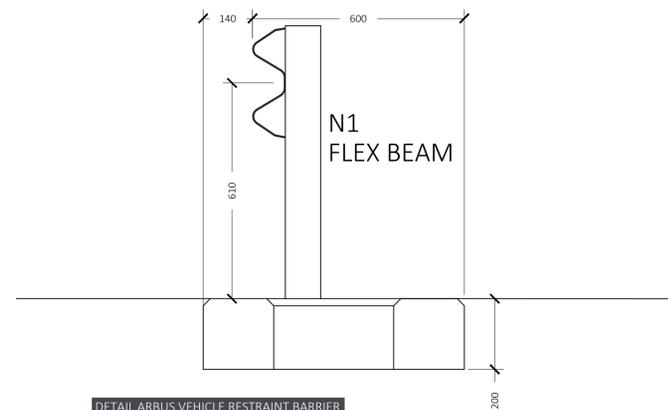


DESIGN SULPHATE CLASS AND ACEC (AGGRESSIVE CHEMICAL ENVIRONMENT FOR CONCRETE) CLASS OF FOUNDATION CONCRETE


1. APPLICABLE TO ALL CONCRETE TO BE IN CONTACT WITH GROUND.
2. SEE GROUND INVESTIGATION REPORT FOR RECOMMENDED DESIGN SULPHATE CLASS AND ACEC CLASS.
3. CONCRETE MIXES TO BE DETERMINED BASED ON DESIGN SULPHATE CLASS AND ACEC CLASS.
4. STRENGTH OF CONCRETE TO BE AS PER GENERAL CONCRETE NOTES.

IMPORTANT NOTES:

1. THE PRINCIPLE CONTRACTOR IS RESPONSIBLE FOR ALL TEMPORARY WORKS DESIGN, INSTALLATION, MAINTENANCE AND REMOVAL. TEMPORARY WORKS DESIGN SHOULD BE SUBSTANTIATED WITH ENGINEERING CALCULATIONS AND DRAWINGS THAT FULLY DESCRIBE THE PHILOSOPHY OF THE PROPOSAL. SDS RECOMMENDS THAT THE DESIGNS ARE PREPARED BY A REGISTERED DESIGN CERTIFIER WITH ADEQUATE INSURANCE TO DESIGN SUCH WORKS.
2. TEMPORARY WORKS DESIGNS, CALCULATIONS AND METHOD STATEMENTS MUST BE SUBMITTED BY THE MAIN CONTRACTOR TO THE APPOINTED HEALTH AND SAFETY CONSULTANT. A SUBMISSION TO THE DESIGN ENGINEERS FOR TECHNICAL EXAMINATION AND APPROVAL IS A REQUIREMENT PRIOR TO COMMENCEMENT OF ANY WORKS.
3. IT IS THE MAIN CONTRACTORS RESPONSIBILITY TO ENSURE ANY SUPPORTING STRUCTURES FROM WHICH TEMPORARY WORKS ARE SUPPORTED FROM BE INCLUDED IN THE DESIGN AND CALCULATIONS PROVIDED AND ARE ALSO THE RESPONSIBILITY OF THE MAIN CONTRACTOR.
4. ALL STEEL MANUFACTURE MUST BE CE CERTIFIED IN ACCORDANCE WITH BS EN 1090-1. IT IS THE PRINCIPLE CONTRACTORS RESPONSIBILITY TO ENSURE THAT THEIR SELECTED STEEL FABRICATION SPECIALIST CAN PRODUCE STEELWORK IN COMPLIANCE, (INCLUDING SUBMISSION OF ALL RELEVANT SUPPORTING DOCUMENTATION) WITH THIS STANDARD.
5. CLIENTS OR MAIN CONTRACTORS WHO ENGAGE A STEELWORK CONTRACTOR SHOULD CARRY OUT DUE DILIGENCE AND SHOULD ONLY APPOINT A STEELWORK CONTRACTOR CERTIFIED WITH AN EXCELLENCE CLASS EQUAL TO THAT FOR THE PROJECT AS DETERMINED BY THE DESIGNER THROUGH IS EN 1090-2.

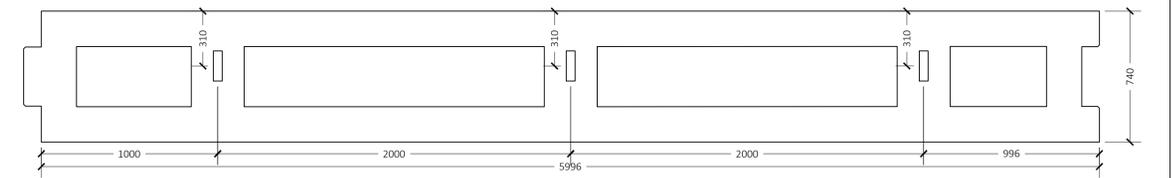

**AS BUILT DRAWING**

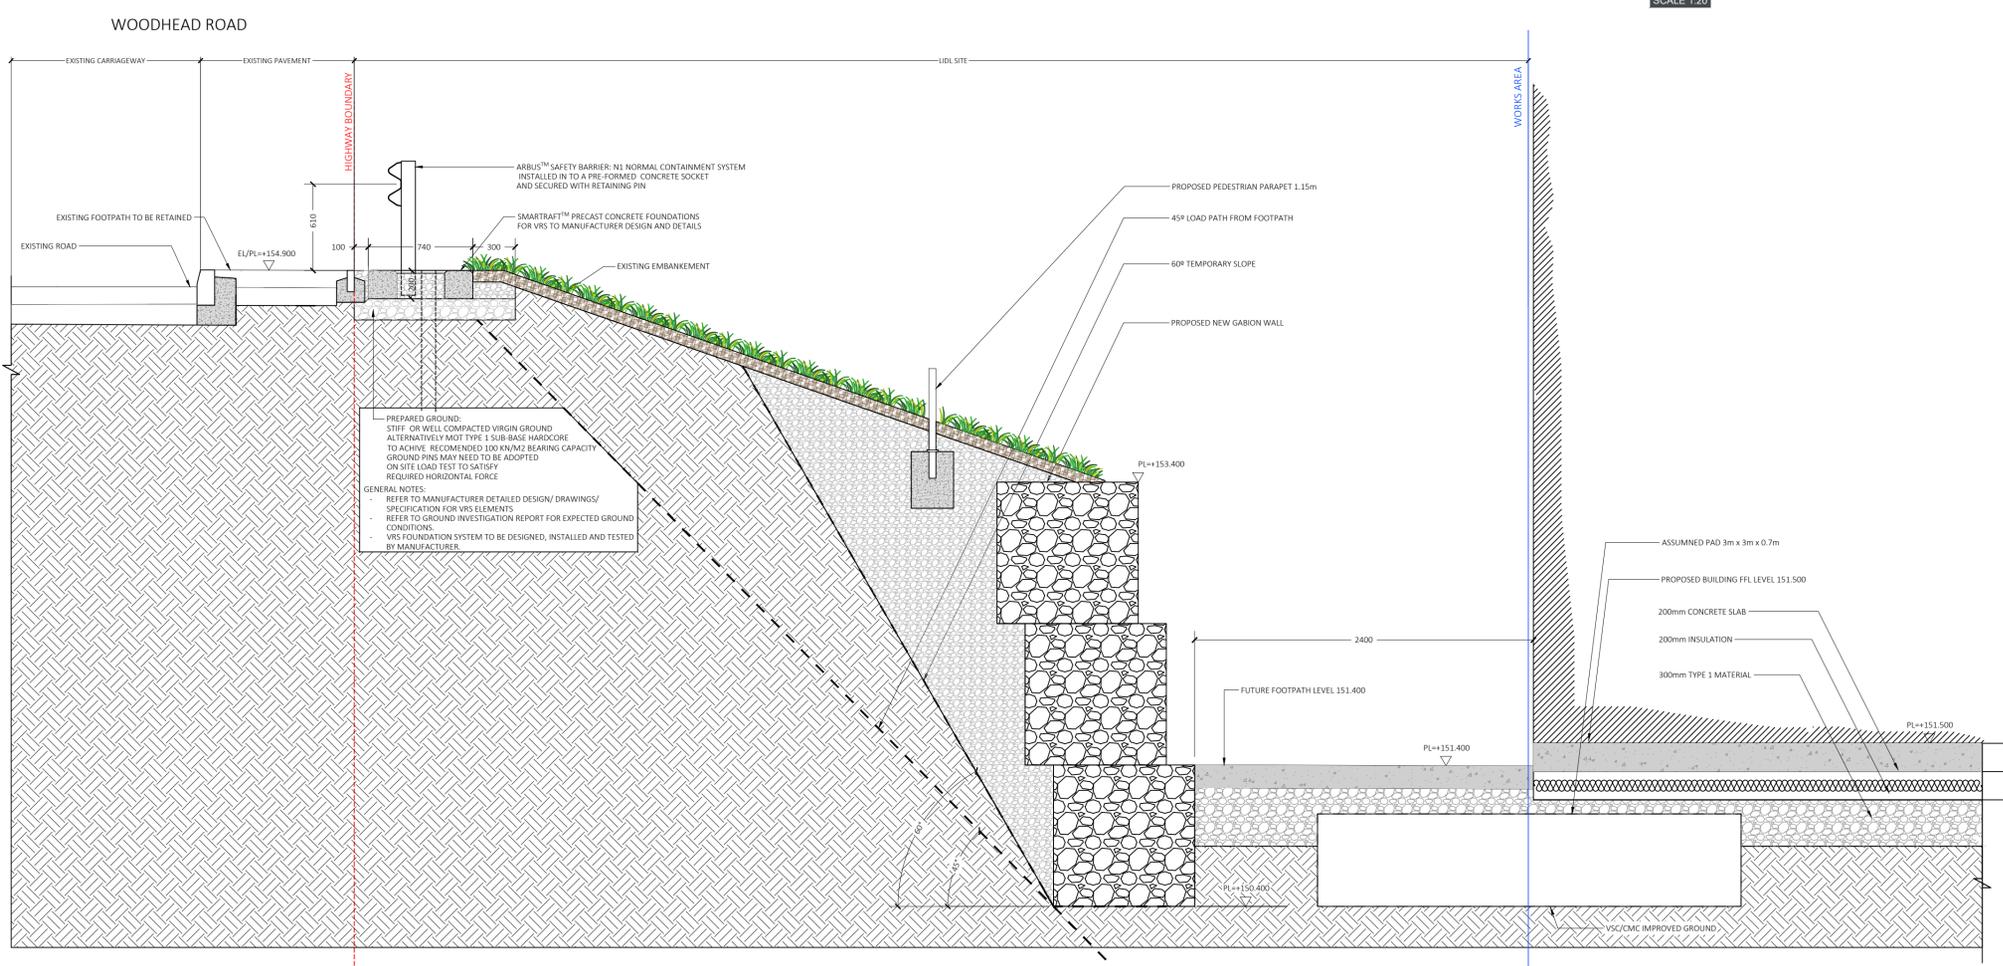

THIS DRAWING IS PROTECTED BY COPYRIGHT AND IS THE PROPERTY OF SDS (Structural Design Solutions) Ltd / SDS-UK Ltd. IT MAY NOT BE USED, REPRODUCED OR DISCLOSED TO ANYONE WITHOUT THE PRIOR WRITTEN APPROVAL OF THE AUTHORS.

**CIVIL, STRUCTURAL & BUILDING ENGINEERS**  
DUBLIN • LONDON • CASTLEBAR • SPAIN

Head Office: Unit 9, NS Business Park, Castlebar, Co. Mayo F23 E283. Tel: +353 (0)94 9034914  
Dublin: Silverdale, Old Swords Road, Dublin 9, D09 CA24. Tel: +353 (0)1 6877480  
London: Congress House, 14 Lyon Road, Harrow, HA1 2EN. Tel: +44 (0)20 3026724  
Spain: Calle Virgen de Guadalupe, 44 Urbda. 23400, Jaen. Tel: +34662556212  
Email: info@structuraldesign.ie Web: www.structuraldesign.ie

**SDS**  
design engineers

DRAWING NOTES:

1. This Drawing is to be read in conjunction with the relevant Specifications & other Architectural & Engineering Drawings. Engineers to be informed immediately of any discrepancies before work proceeds.
2. Do Not Scale from this Drawing. Metric Figured Dimension only are to be used.
3. It is "The Contractors" responsibility to ensure that all works are carried out in accordance with the requirements of the current Building Regulations and all other statutory documents relevant to this project including the grant of planning permission, Fire Safety Certificate and Disability Access Certificate.
4. SDS (Structural Design Solutions) Ltd / SDS-UK (Structural Design Solutions) Ltd. bear no liability for unilateral changes/modifications made during the course of construction based on the drawing prepared, without prior consultation and confirmation of acceptance of the revision by SDS (Structural Design Solutions) Ltd / SDS-UK (Structural Design Solutions) Ltd.

REV	DATE	BY	DESCRIPTION
AB1	15/01/2025	PM	ISSUED FOR AS BUILT

Client	Project Title
STONEDALE CONSTRUCTION	PROPOSED NEW LIDL BIRSTALL, BANKWOOD WAY BIRSTALL, UK

Drawn by	Date	Status
AC	JAN 2026	AS BUILT

Project No	Revision
25289-SDS-00-SL-DR-C-3030	AB1

Project No	Revision
25289-SDS-00-SL-DR-C-3030	AB1