


SITE PLAN - HOME BARGAINS STORE
SCALE 1:500

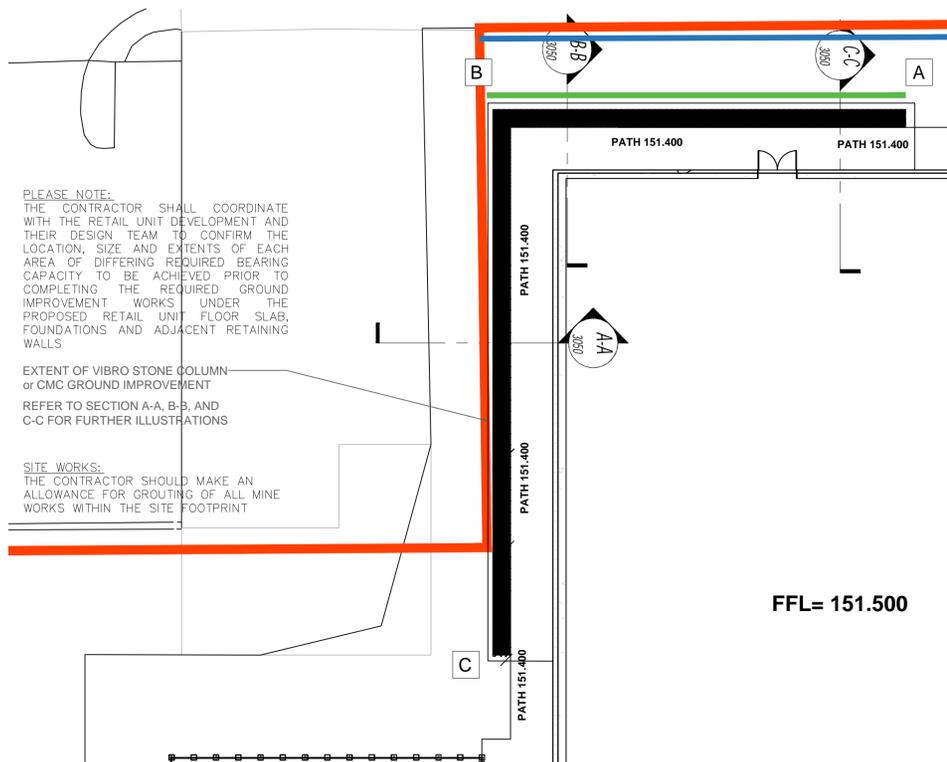

SITE PLAN - HOME BARGAINS STORE
SCALE 1:200

PLEASE NOTE:
THE CONTRACTOR SHALL COORDINATE WITH THE RETAIL UNIT DEVELOPMENT AND THEIR DESIGN TEAM TO CONFIRM THE LOCATION, SIZE AND EXTENTS OF EACH AREA OF DIFFERING REQUIRED BEARING CAPACITY TO BE ACHIEVED PRIOR TO COMPLETING THE REQUIRED GROUND IMPROVEMENT WORKS UNDER THE PROPOSED RETAIL UNIT FLOOR SLAB, FOUNDATIONS AND ADJACENT RETAINING WALLS

EXTENT OF VIBRO STONE COLUMN or CMC GROUND IMPROVEMENT REFER TO SECTION A-A, B-B, AND C-C FOR FURTHER ILLUSTRATIONS

SITE WORKS:
THE CONTRACTOR SHOULD MAKE AN ALLOWANCE FOR GROUTING OF ALL MINE WORKS WITHIN THE SITE FOOTPRINT

NOTE:

- GRID SETTING OUT AS PER ARCHITECTS DETAIL & DESIGN.
- DIMENSIONS AS PER ARCHITECTS LAYOUT PLAN - PLEASE REFER TO ARCHITECTS DRAWINGS FOR ALL DIMENSIONS & LEVELS.
- REFER TO ARCHITECTS DRAWINGS FOR ALL SERVICES, SIZES, SETTING OUT AND ARRANGEMENT.
- ARCHITECTS DRAWINGS TO TAKE PRECEDENCE.

IMPORTANT NOTES:


PLEASE READ THESE DRAWINGS IN CONJUNCTION WITH CURRENT LIDL CORPORATE SPECIFICATION, CORPORATE SPECIFICATION TO TAKE PRECEDENCE AT ALL TIMES. ANOMALIES TO BE NOTED IN WRITING IMMEDIATELY TO THE ENGINEER.

FOUNDATION STANDARD BUILD UP UNLESS OTHERWISE SPECIFIED:


- 1.50mm BLINDING
- 300mm (MIN.) SUB BASE TYPE 1 GRANULAR MATERIAL ROLLED IN LAYERS NOT EXCEEDING 200mm AND FULLY COMPACTED WITH A SUITABLE MECHANICAL ROLLER
3. COMPACTION & SUBGRADE MODULUS TO BE ESTABLISHED BY APPROPRIATE INSITU TESTING. (PLATE BEARING TESTS WITH A PLATE DIA 600MM, MINIMUM 6 No. TESTS TO BE CARRIED OUT AT EXCAVATION LEVEL PRIOR TO INSTALLATION OF CAPPING LAYER. LOCATIONS OF TEST TO BE AGREED WITH ENGINEER PRIOR TO TESTING. RESULTS TO BE FORWARDED TO ENGINEER FOR REVIEW PRIOR TO CAPPING LAYER CONSTRUCTION.

IMPORTANT NOTE:

1. THE PRINCIPLE CONTRACTOR IS RESPONSIBLE FOR ALL TEMPORARY WORKS DESIGN, INSTALLATION, MAINTENANCE AND REMOVAL. TEMPORARY WORKS DESIGN SHOULD BE SUBSTANTIATED WITH ENGINEERING CALCULATIONS AND DRAWINGS THAT FULLY DESCRIBE THE PHILOSOPHY OF THE PROPOSAL. SDS RECOMMEND THAT THE DESIGNS ARE PREPARED BY A REGISTERED DESIGN CERTIFIER WITH ADEQUATE INSURANCE TO DESIGN SUCH WORKS.
2. TEMPORARY WORKS DESIGNS, CALCULATIONS AND METHOD STATEMENTS MUST BE SUBMITTED BY THE MAIN CONTRACTOR TO THE APPOINTED HEALTH AND SAFETY CONSULTANT. A SUBMISSION TO THE DESIGN ENGINEERS FOR TECHNICAL EXAMINATION AND APPROVAL IS A REQUIREMENT PRIOR TO COMMENCEMENT OF ANY WORKS.
3. IT IS THE MAIN CONTRACTORS RESPONSIBILITY TO ENSURE ANY SUPPORTING STRUCTURES FROM WHICH TEMPORARY WORKS ARE SUPPORTED FROM BE INCLUDED IN THE DESIGN AND CALCULATIONS PROVIDED AND ARE ALSO THE RESPONSIBILITY OF THE MAIN CONTRACTOR.
4. ALL STEEL MANUFACTURE MUST BE CE CERTIFIED IN ACCORDANCE WITH BS EN 1090-1. IT IS THE PRINCIPLE CONTRACTORS RESPONSIBILITY TO ENSURE THAT THEIR SELECTED STEEL FABRICATION SPECIALIST CAN PRODUCE STEELWORK IN COMPLIANCE, (INCLUDING SUBMISSION OF ALL RELEVANT SUPPORTING DOCUMENTATION) WITH THIS STANDARD.
5. CLIENTS OR MAIN CONTRACTORS WHO ENGAGE A STEELWORK CONTRACTOR SHOULD CARRY OUT DUE DILIGENCE AND SHOULD ONLY APPOINT A STEELWORK CONTRACTOR CERTIFIED WITH AN EXECUTION CLASS EQUAL TO THAT FOR THE PROJECT AS DETERMINED BY THE DESIGNER THROUGH IS EN 1090-2.

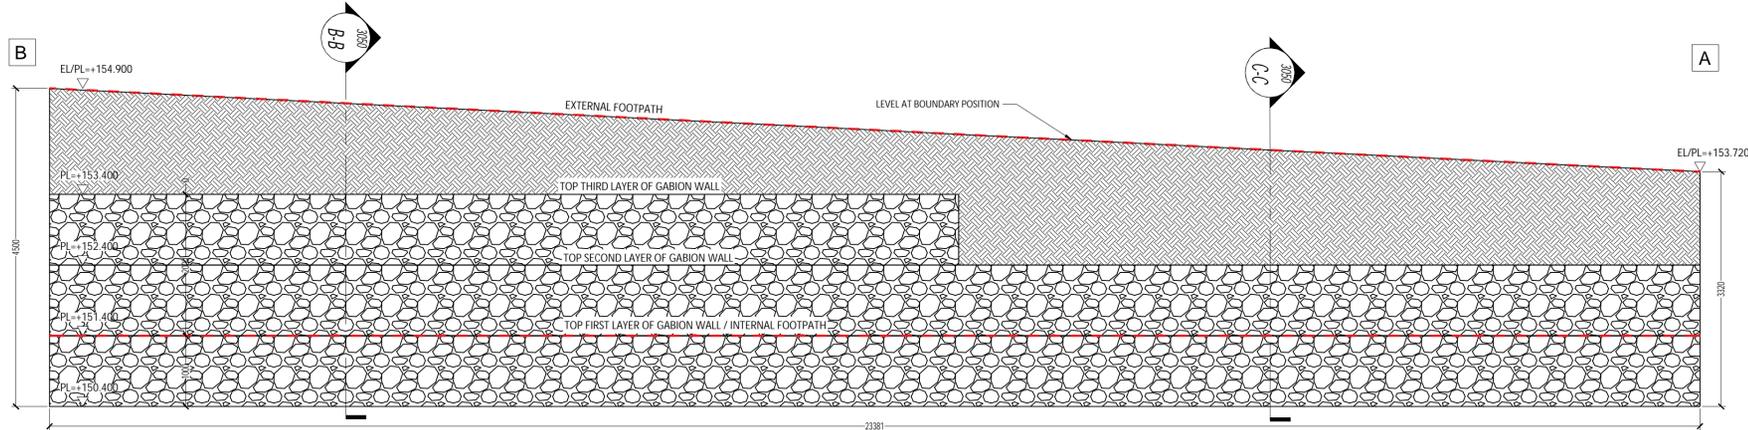

ELEVATION GABION WALL A-B
SCALE 1:50

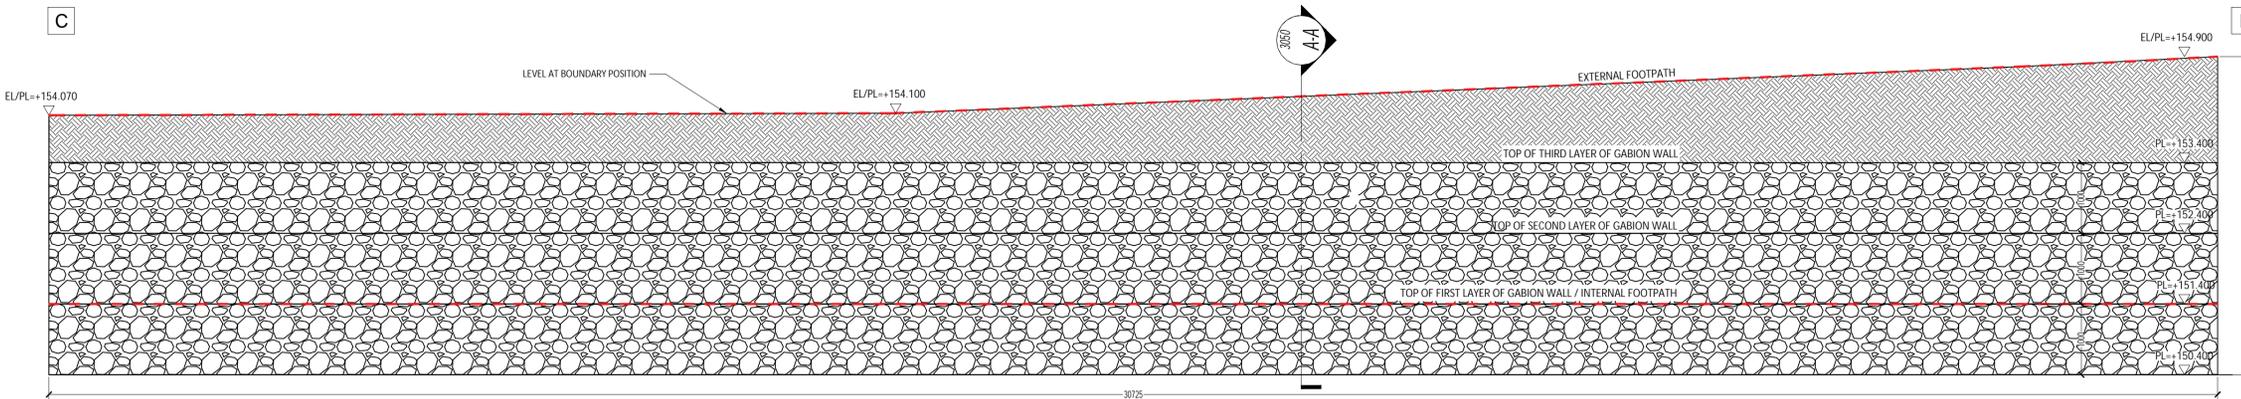

ELEVATION GABION WALL B-C
SCALE 1:50

LEGEND	
	PROPOSED GABION WALL
	LAND TO BE RETAINED
	FOOTPATH LEVEL

**AS BUILT
DRAWING**

© THIS DRAWING IS PROTECTED BY COPYRIGHT AND IS THE PROPERTY OF SDS (Structural Design Solutions) Ltd. / SDS-UK Ltd. IT MAY NOT BE USED, REPRODUCED OR DISCLOSED TO ANYONE WITHOUT THE PRIOR WRITTEN APPROVAL OF THE AUTHORS.

CIVIL, STRUCTURAL & BUILDING ENGINEERS
DUBLIN LONDON CASTLEBAR SPAIN

Head Office: Unit 9, N5 Business Park, Castlebar, Co. Mayo T23 E283. Tel: +353 (0)94 9034914
Dublin: Silverdale, Old Swords Road, Dublin 9, D19 CA24. Tel: +353 (0)1 6877480
London: Bridge House, 25-27 The Bridge/Woolstone, Harrow, HA3 5AB. Tel: +44 (0)20-30266724
Spain: Calle Virgen de Guadalupe, 44, Libreda, 23400, Jaen.

SDS
design engineers

info@structuraldesign.ie Web: www.structuraldesign.ie

DRAWING NOTES:

1. This Drawing is to be read in conjunction with the relevant Specifications & other Architectural & Engineering Drawings. Engineers to be informed immediately of any discrepancies before work proceeds.
2. Do Not Scale from this Drawing. -Metric Figured Dimension only are to be used.
3. It is "The Contractors" responsibility to ensure that all works are carried out in accordance with the requirements of the current Building Regulations and all other statutory documents relevant to this project including the grant of planning permission, Fire Safety Certificate and Disability Access Certificate.
4. SDS (Structural Design Solutions) Ltd./ SDS-UK (Structural Design Solutions) Ltd. bear no liability for unilateral changes/modifications made during the course of construction based on the drawing prepared, without prior consultation and confirmation of acceptance of the revision by SDS (Structural Design Solutions) Ltd./ SDS-UK (Structural Design Solutions) Ltd.

REV.	DATE	BY	DESCRIPTION
AB1	15.01.2026	PM	ISSUED FOR AS BUILT

STONEDALE CONSTRUCTION

Project Title:
LIDL BIRSTALL, BANKWOOD WAY
BIRSTALL, UK

Drawing Title:
HOME BARGAINS SITE
PROPOSED GABION WALL ELEVATIONS

Scale	Page Size	Status
AS SHOWN	A1	AS BUILT
Drawn by JPM	Date JAN 2026	Checked AM
Project No. 25289-SDS-00-XX-DR-C-3051	Revision AB1	