





00\_Ground\_Floor\_Plan  
1 : 100

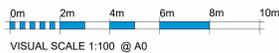

VISUAL SCALE 1:100 @ A0

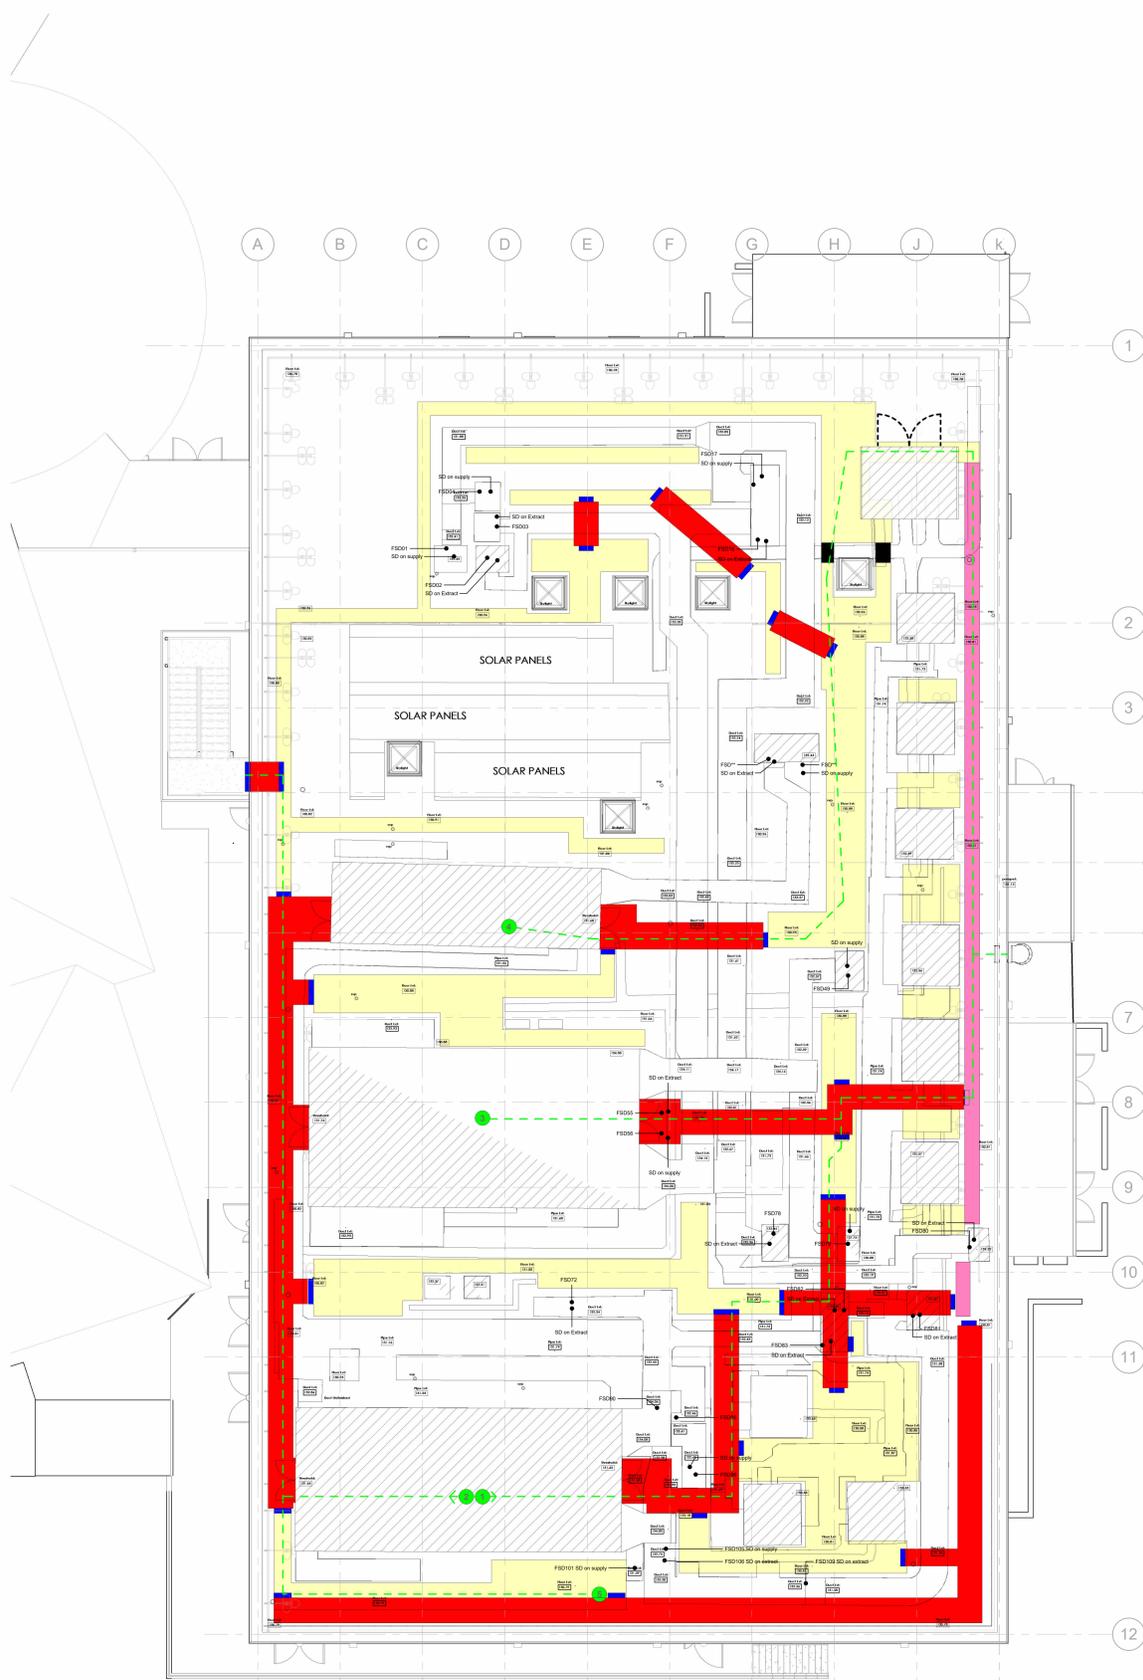

Roof Plan  
1 : 100

Module Schedule		
W X L X H(m)	Level	Quantity
2.8 x 9.9 x 4.6	GF	6
3.4 x 9.9 x 4.6	GF	21
3.3 x 11.1 x 4.6	GF	18
Total		45

**Legend**  
Ground Floor GFA: 1503m<sup>2</sup>  
Linkway GFA: 17m<sup>2</sup>

- GA developed in consultation with client team during meetings 19th Oct '22 - 2nd Nov '22, updated following IPC comments.
- Derogations from initial SoA are noted in the Derogation Schedule (180598-DGL-01-SH-A)

**Roof Plan Key**

Anti-slip painted walkway - To be done by Darwin roofing production team - approx 250m <sup>2</sup>	
Step over	
Access to the step over either slipaladder or up and over steps	
Cross grip matt or duckboard safety walkway - approx 330m	
Duct access positions	
Volume control damper positions	

**Please Note:**  
Survey heights and dimensions are indicative only. Several valves and other mechanical elements may extend above the recorded TOPO points. It is the recipient's responsibility to conduct their own survey and due diligence to verify all critical levels and obstructions before proceeding with design and installation.

Fire exit route	Length
1	42.8m
2	38.1m
3	25.9m
4	60m
5	46.9m

**Department Key:**

	Admission Suite Facilities
	Circulation
	Operating Theatre Suite
	Outpatients
	Plant & Services
	Public Facilities
	Recovery Unit
	Staff Facilities
	Storage - Overall for Building
	Toilet Facilities

Rev	Description	By	Chk	Date
P17	Changed name to store	RW	DT	13/03/25
CR1	As Constructed Record	RW / AR	DT	16/04/25
CR2	As constructed record updates for clarification	AR	DT	17/07/25

**DarwinGroup**  
Construction Has Evolved

PROJECT TITLE: Dewsbury and District Hospital  
ADDRESS: Holton Rd, Dewsbury, Wt3 4RS

DRAWING TITLE: General Arrangements

DRAWING REFERENCE: 180598\_DGL\_01\_ZZ\_DR\_A\_2000

INITIAL ISSUE DATE: 25/05/22  
INITIAL ISSUE BY: LS  
INITIAL CHECKED BY: GFA

SUITABILITY: CR As Constructed  
SCALE: As Indicated  
SHEET: A0  
REV: CR2

23/07/2025 09:45:35