




Proposed_North_Facing_Elevation
1 : 200

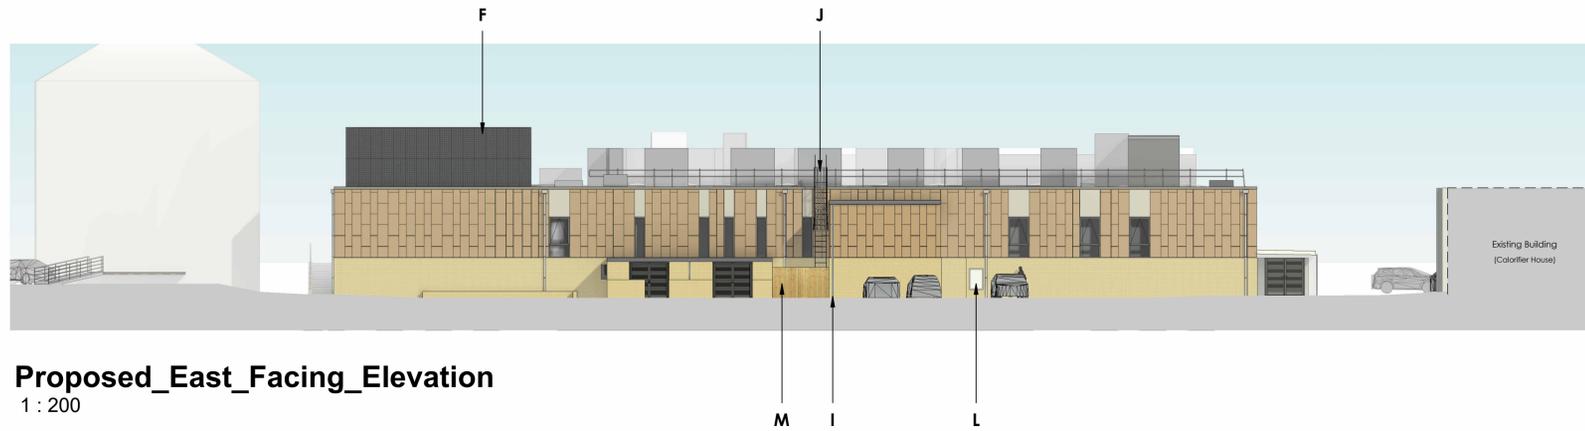


Proposed_East_Facing_Elevation
1 : 200

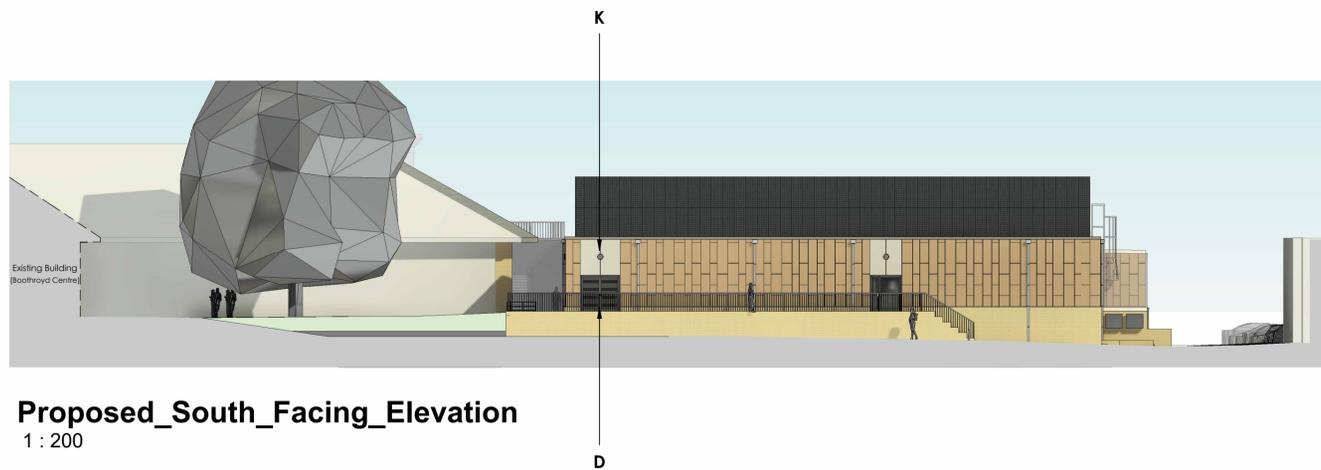

Proposed_South_Facing_Elevation
1 : 200

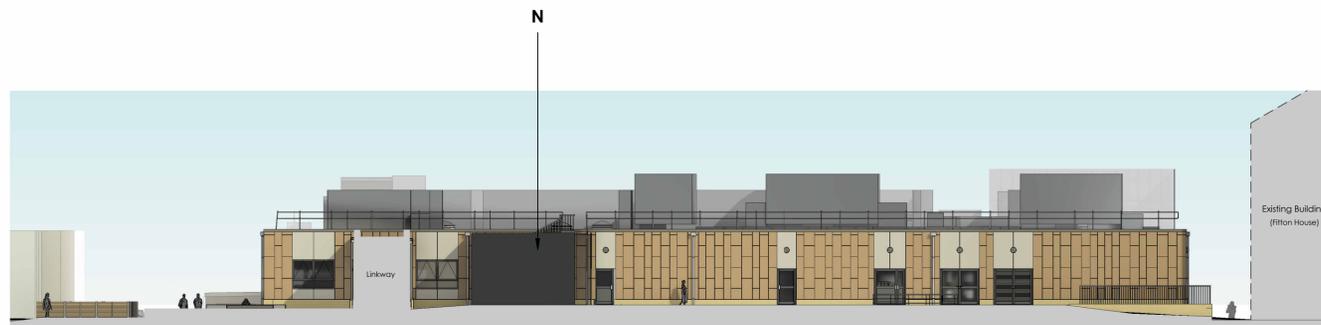

Proposed_West_Facing_Elevation
1 : 200

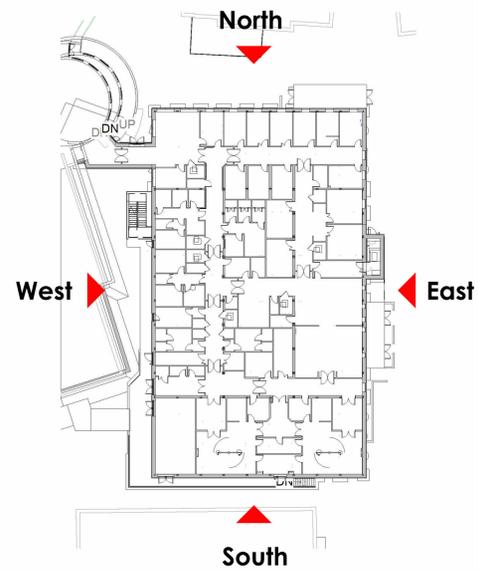

Elevation Plan
1 : 500

Cladding	
A	Brickwork Plinth - Buff Brick Village Golden Thatch  Product photo
B1	Architectural Cladding - Equitone TE 30 (Sandstorm)  Colour match from product photo  Product photo
B2	Architectural Cladding - Equitone TE 00 (Calico)  Colour match from product photo  Product photo
External Windows/Doors	
C	Aluminium Windows - Anthracite Grey RAL 7016
D	PPC Aluminium Frame External Louvred Door - Anthracite Grey RAL 7016
E	PPC Aluminium Frame External Glazed Door - Anthracite Grey RAL 7016
External Components	
F	Ballasted Louvre Screen RAL 7016
G	Ballasted Handrail
H	GRP Enclosure - Grey
I	82mm uPVC Round Downpipes, Black
J	CAT Ladder
K	External Bulkhead Light
L	White Access Panel
M	Vertical Closeboard Fencing
N	Sheet metal cladding - RAL 7016

Rev	Description	By	Chk	Date
P1	Updated for S2 Issue	HB	MYH NHST	20/12/22
P2	IPC comments added: external platform lift, and lead lining to MTR2	LS	MYH NHST	08/02/23
P3	External Stair Added	EB	LS	13/02/23
P4	RIBA Stage 3 Submission	EB/ CA	LS	31/03/23
P5	Updated materials	ET	CR	14/08/23
CR1	As Constructed Record	FH / AR	AR / DT	16/04/25
CR2	As constructed record updates for clarification	AR	DT	17/07/25

ALL DIMENSIONS ARE IN MILLIMETRES UNLESS OTHERWISE NOTED. DO NOT SCALE OFF DRAWINGS. ALL DIMENSIONS ARE NOMINAL AND MUST BE CHECKED ON SITE. ALL DRAWINGS ARE COPYRIGHT OF DARWIN GROUP LTD AND CANNOT BE REPRODUCED WITHOUT WRITTEN CONSENT OF DARWIN GROUP LTD. IF THERE ARE ANY DISCREPANCIES WITH ANY INFORMATION PROVIDED, IT IS THE CONTRACTORS RESPONSIBILITY TO NOTIFY DARWIN GROUP LTD IMMEDIATELY.



PROJECT TITLE: Dewsbury and District Hospital
ADDRESS: Halifax Rd, Dewsbury WF13 4HS

DRAWING TITLE: Elevations

DRAWING REFERENCE					
PROJECT	ORIGINATOR	VOLUME	LEVEL	TYPE	ROLE
180598	DGL	01	XX	DR	A
INITIAL ISSUE DATE					2100
INITIAL ISSUE BY					NUMBER
INITIAL CHECKED BY					
GIFA					
14/12/22					1503 m²
SUITABILITY					SHEET
SCALE					REV
CR As Constructed Record					A1
STATUS CODE					CR2
STATUS DESCRIPTION					

