



Dewsbury and District Hospital

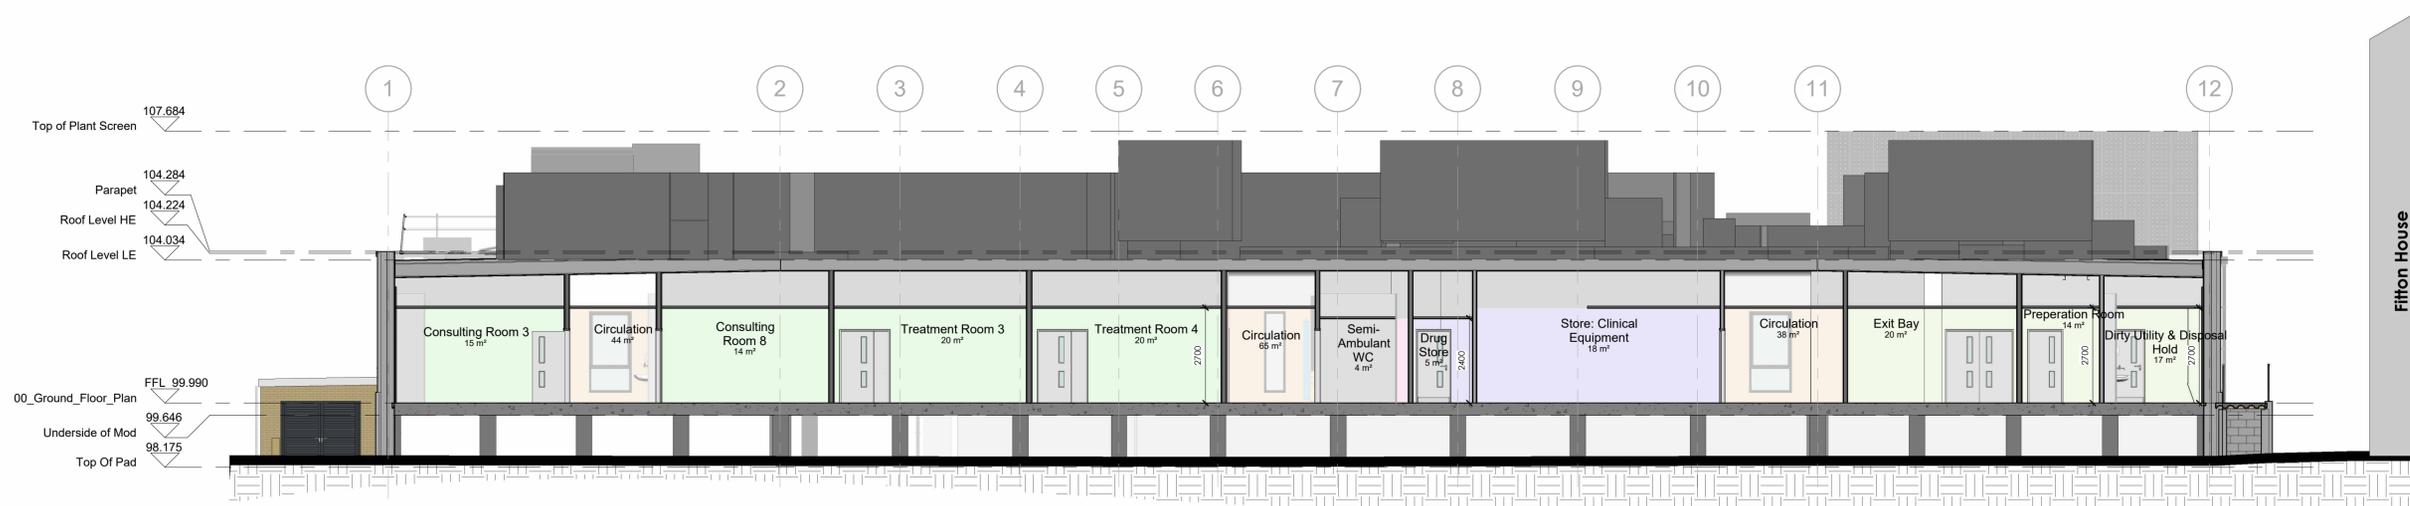

Proposed Section AA
1 : 100

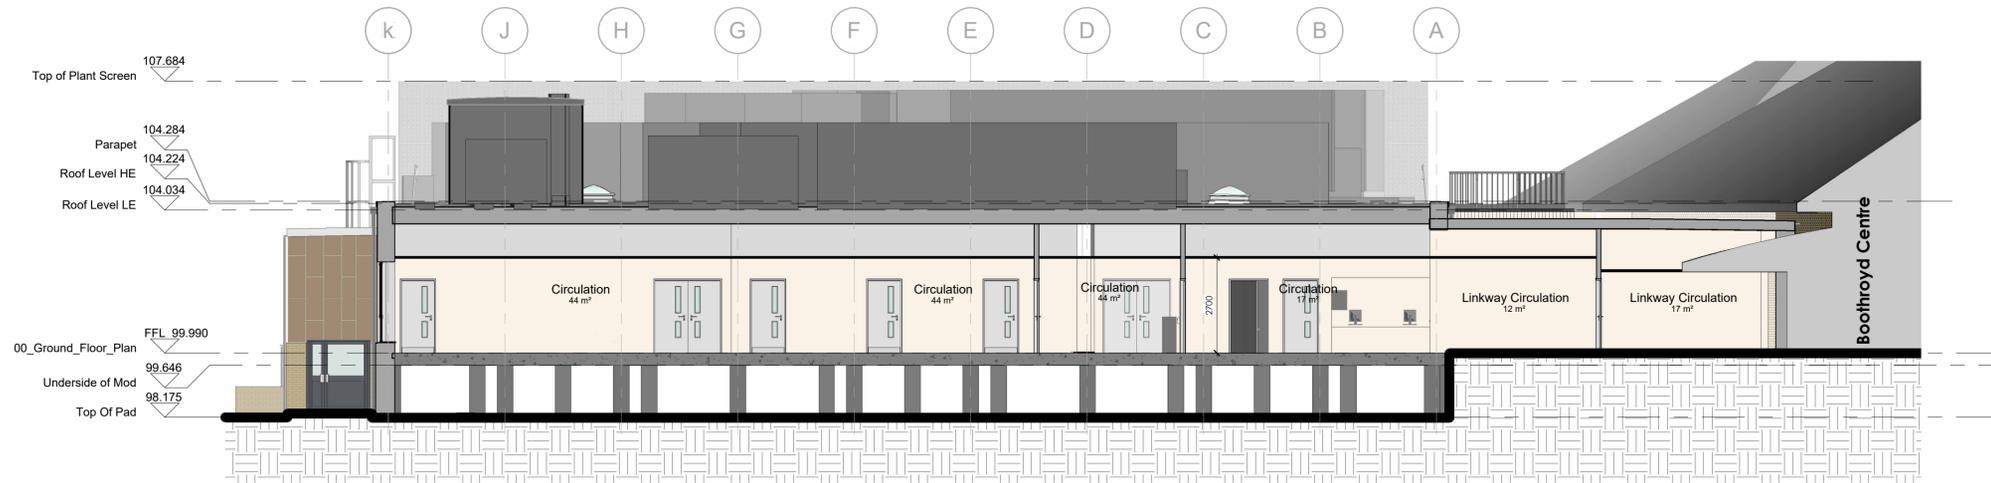

Proposed Section BB
1 : 100



Proposed Section CC
1 : 100



| Rev | Description | By | Chk | Date |
|-----|---|-------|-------|----------|
| P1 | RIBA Stage 3 Submission | EB/CA | LS | 31/03/23 |
| CR1 | As Constructed Record | FH/AR | AR/DT | 16/04/25 |
| CR2 | As constructed record updates for clarification | AR | DT | 17/07/25 |

ALL DIMENSIONS ARE IN MILLIMETRES UNLESS OTHERWISE NOTED. DO NOT SCALE OFF DRAWINGS. ALL DIMENSIONS ARE NOMINAL AND MUST BE CHECKED ON SITE. ALL DRAWINGS ARE COPYRIGHT OF DARWIN GROUP LTD AND CANNOT BE REPRODUCED WITHOUT WRITTEN CONSENT OF DARWIN GROUP LTD. IF THERE ARE ANY DISCREPANCIES WITH ANY INFORMATION PROVIDED, IT IS THE CONTRACTORS RESPONSIBILITY TO NOTIFY DARWIN GROUP LTD IMMEDIATELY.

DarwinGroup
Construction Has Evolved
Design — Engineering — Contracting — Offsite
London House, Showbury Business Park, Showbury, Stroud, G5 4EA
TEL: 01993 252909
www.darwingroup.co.uk

PROJECT TITLE: Dewsbury and District Hospital
ADDRESS: Halifax Rd, Dewsbury WF13 4HS

DRAWING TITLE: Proposed Building Sections

| DRAWING REFERENCE | | | | | | |
|--------------------------|------------|--------------------|-------|--------------------|------|--------|
| PROJECT | ORIGINATOR | VOLUME | LEVEL | TYPE | ROLE | NUMBER |
| 180598 | DGL | 01 | XX | DR | A | 2300 |
| INITIAL ISSUE DATE | | INITIAL ISSUE BY | | INITIAL CHECKED BY | | |
| 12/12/2022 | | CH | | LS | | |
| SUITABILITY | | SCALE | | SHEET | | REV |
| CR As Constructed Record | | As indicated | | A1 | | CR2 |
| STATUS CODE | | STATUS DESCRIPTION | | | | |



VISUAL SCALE 1:100 @ A1