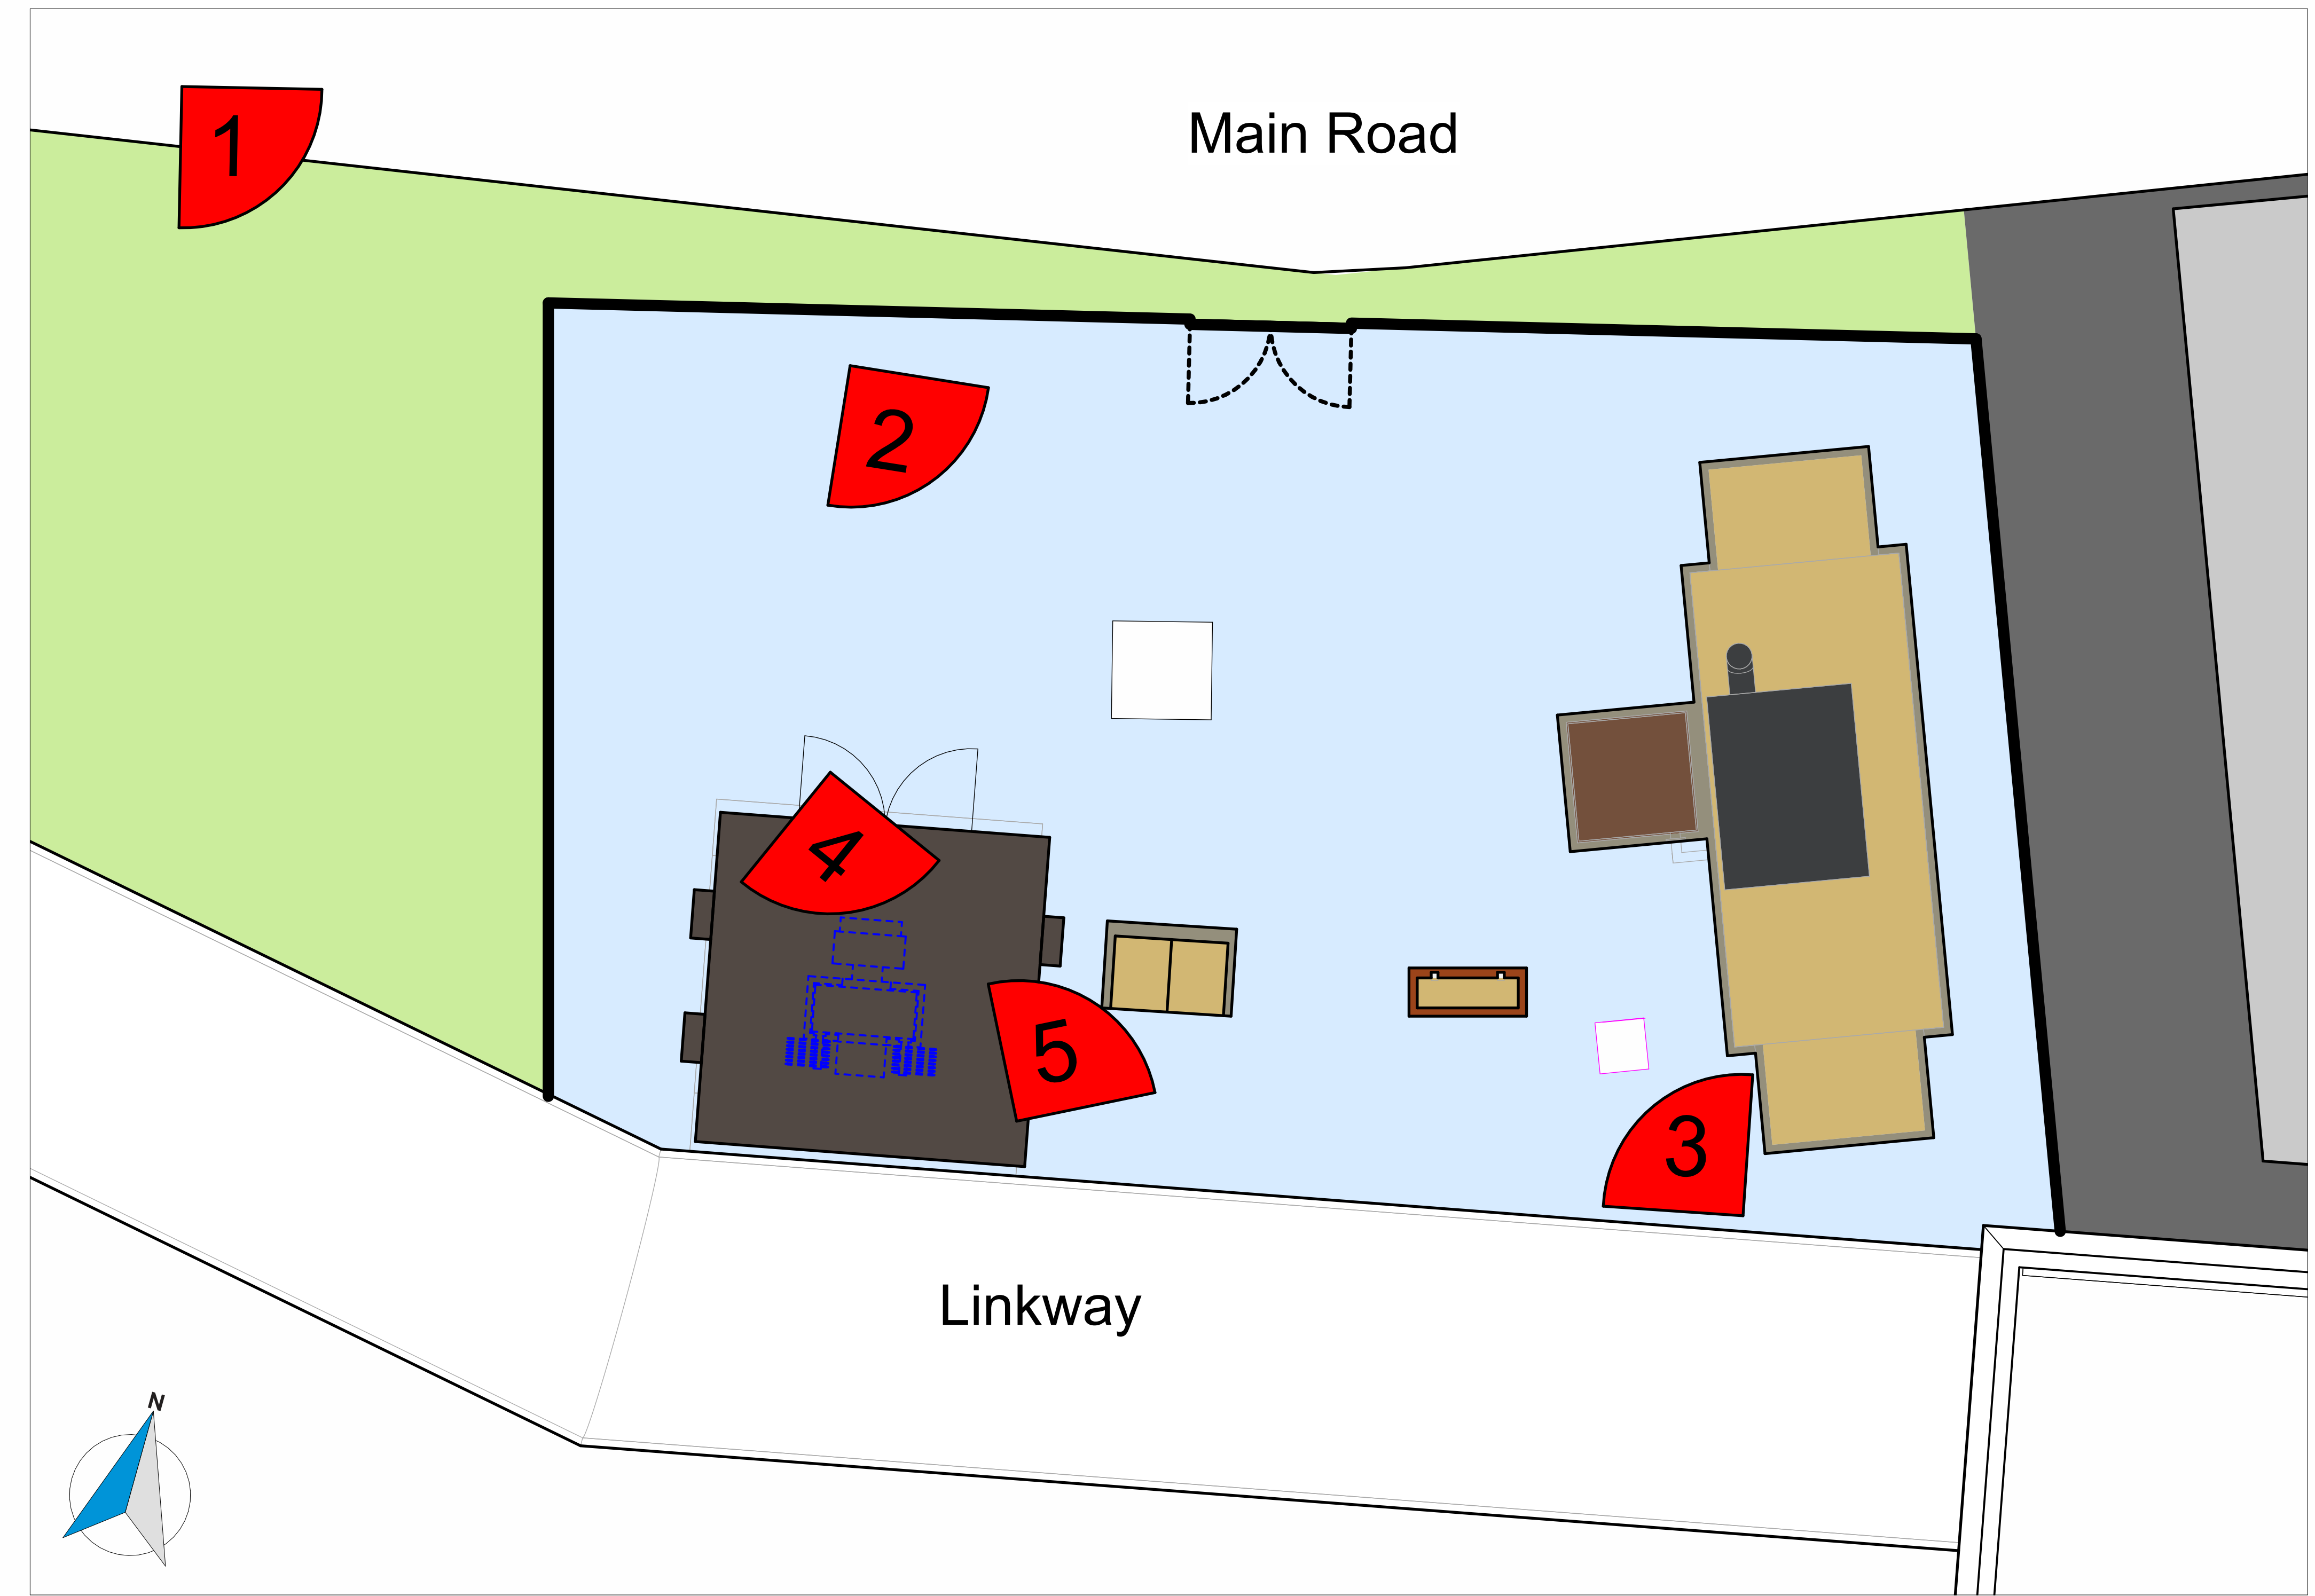
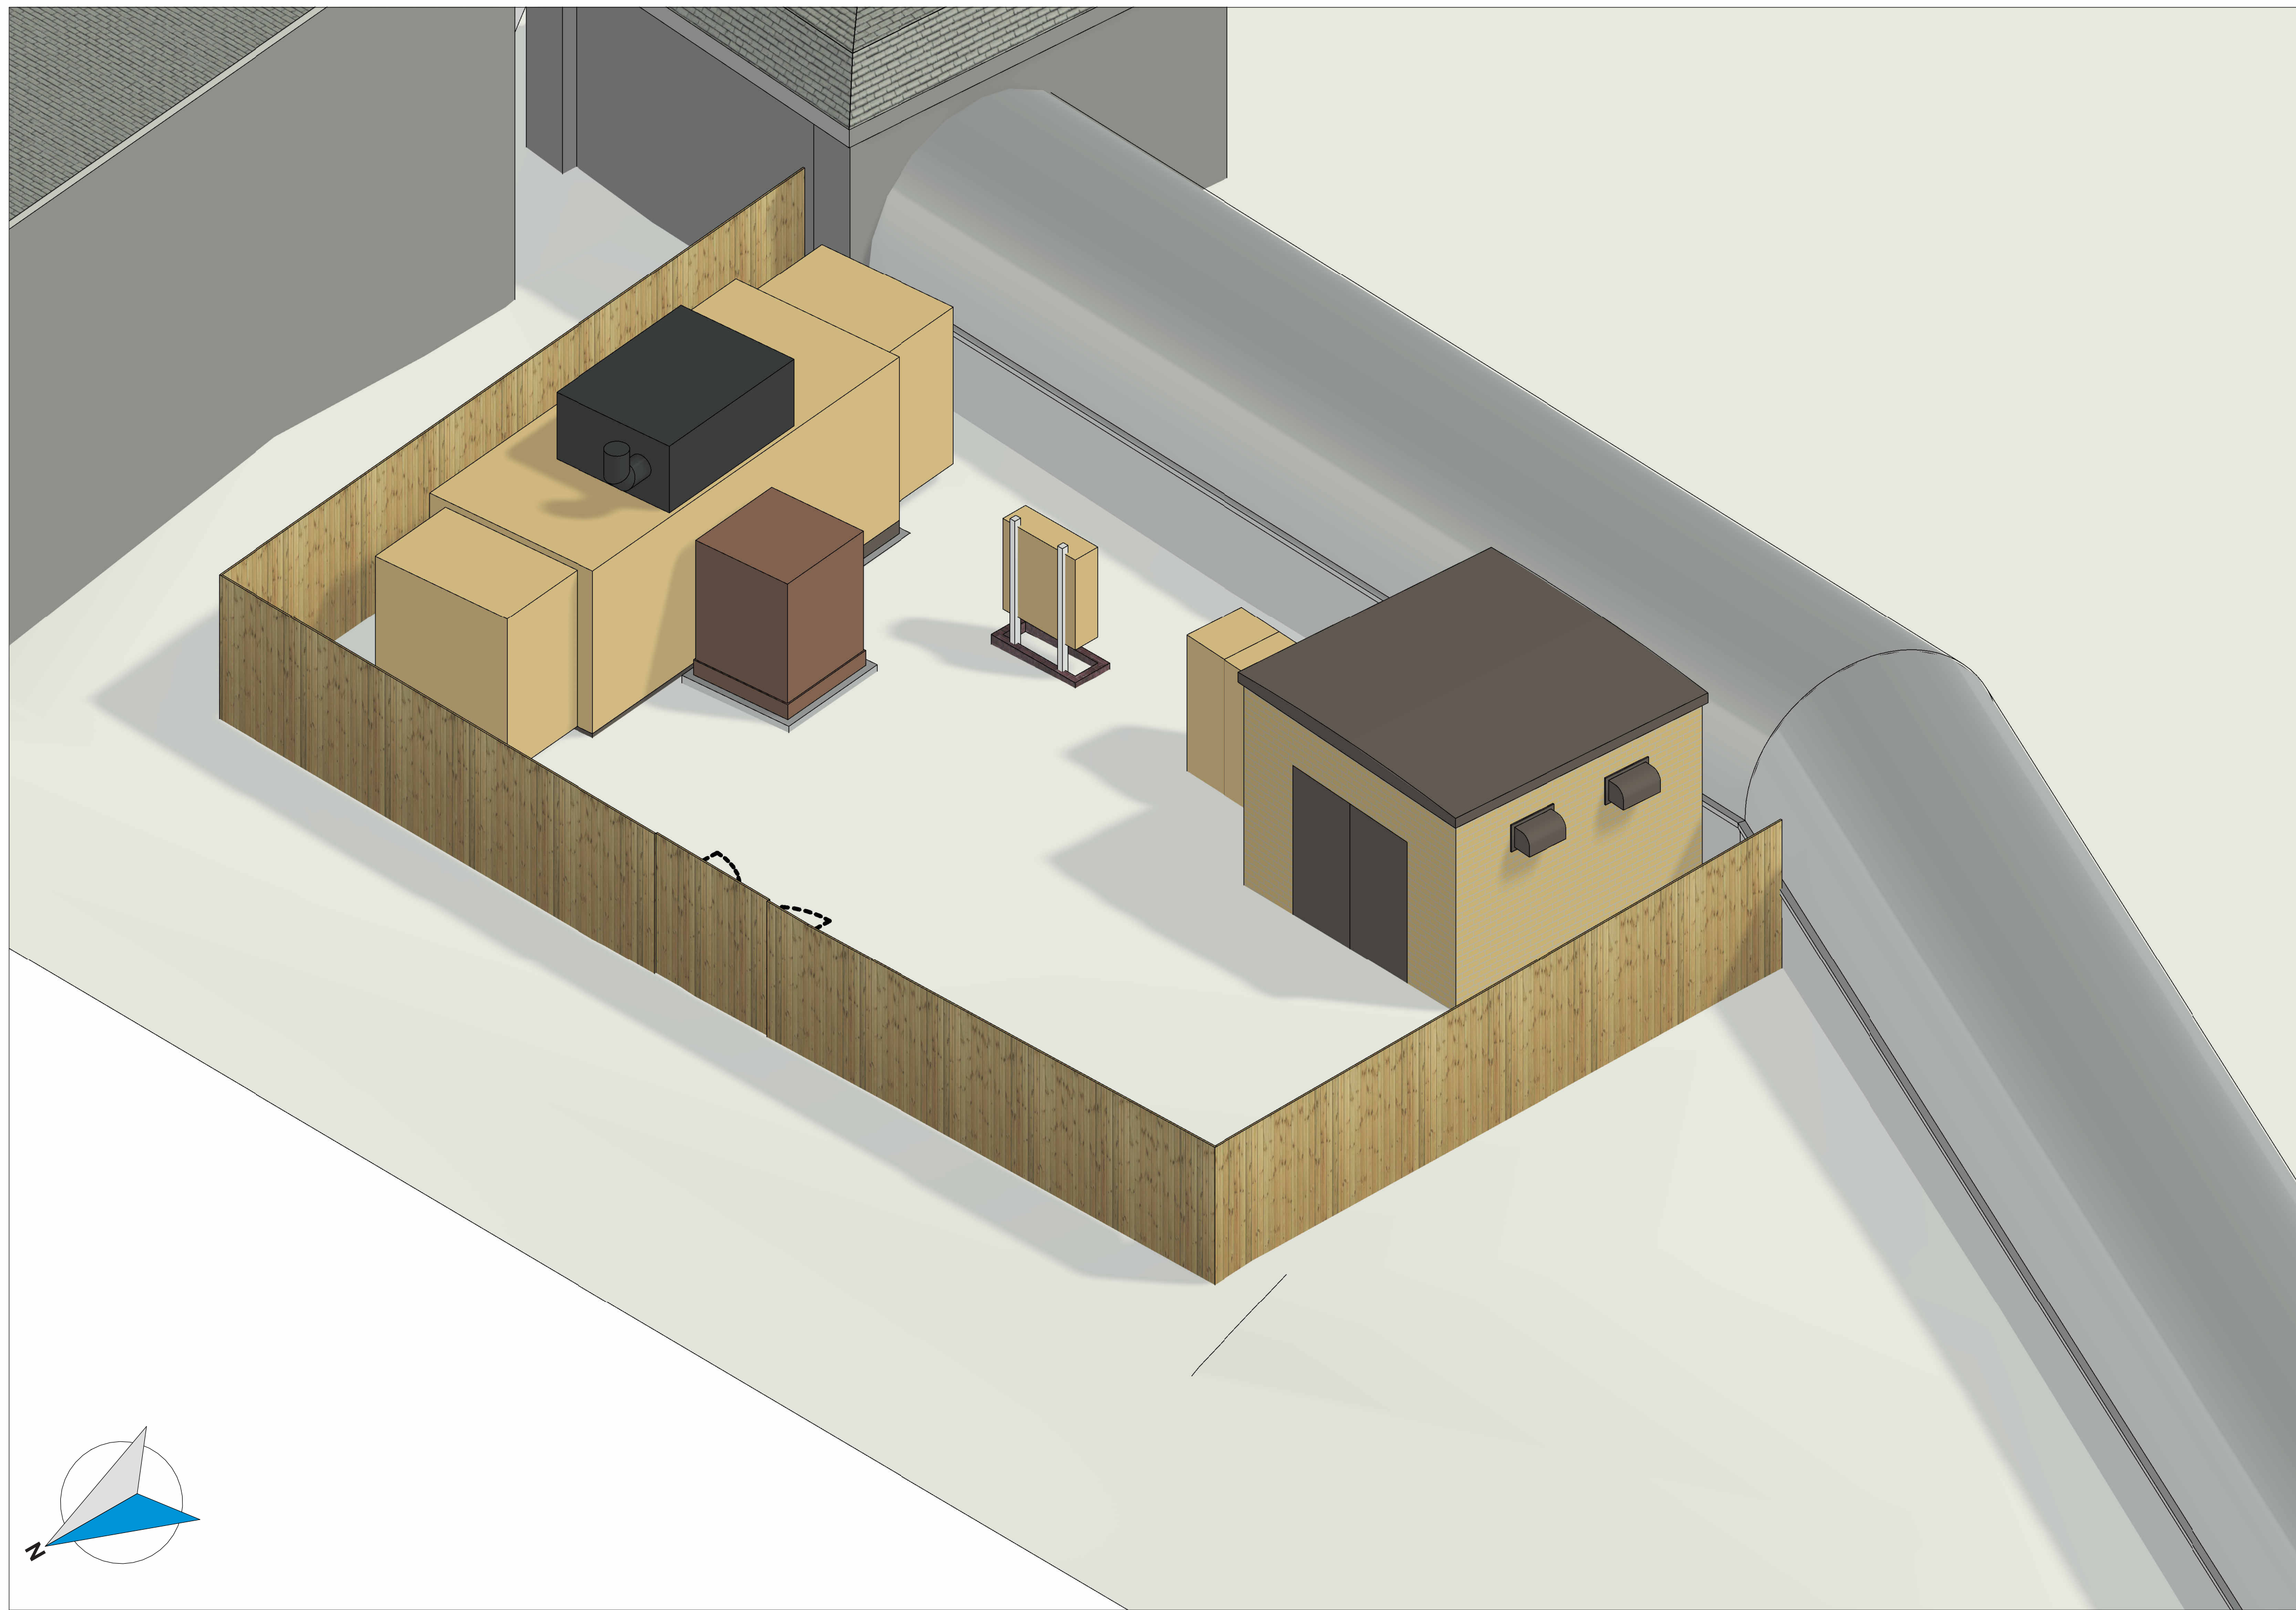


[illegible]

ALL DIMENSIONS ARE IN MILLIMETRES UNLESS OTHERWISE NOTED. DO NOT SCALE OFF DRAWINGS. ALL DIMENSIONS ARE NOMINAL AND MUST BE CHECKED ON SITE. ALL DRAWINGS ARE COPYRIGHT OF DARWIN GROUP LTD AND CANNOT BE REPRODUCED WITHOUT WRITTEN CONSENT OF DARWIN GROUP LTD.

IF THERE ARE ANY DISCREPANCIES WITH ANY INFORMATION PROVIDED, IT IS THE CONTRACTORS RESPONSIBILITY TO


 DESIGN BY DARWIN GROUP LTD. IMMEDIATELY.
DarwinGroup
 Construction Has Evolved
 Design — Engineering — Contracting — Office
 London House, Shorebury Business Park, Shorebury, Shorebury, ST4 6JA
 Tel: 01939 250969
 www.darwingroup.co.uk

PROJECT TITLE	ADDRESS
Dewsbury and District Hospital	Hallifax Rd. Dewsbury WF13 4HS

DRAWING TITLE

Photos - Enclosure

DRAWING REFERENCE						
180598	DGL	01	ZZ	DR	A	2014
PROJECT	ORGANOGRAPH	VOLUME	LEVEL	TYPE	ROLE	NUMBER
INITIAL ISSUE DATE		INITIAL ISSUE BY		INITIAL CHECKED BY		GIFA
13/10/2025		FH		AR		1503 m ²
SUITABILITY				SCALE	SHEET	REV
CR	As Constructed			1 : 50	A0	
STATUS CODE	30			Second		

13/10/2025 14:31:19