



As Built Elevation - 1
Scale 1:100 @ A1



As Built Elevation - 2
Scale 1:100 @ A1



As Built Elevation - 3
Scale 1:100 @ A1




As Built Elevation - 4
Scale 1:100 @ A1



As Built Elevation - 5
Scale 1:100 @ A1



As Built Elevation - 2A
Scale 1:100 @ A1

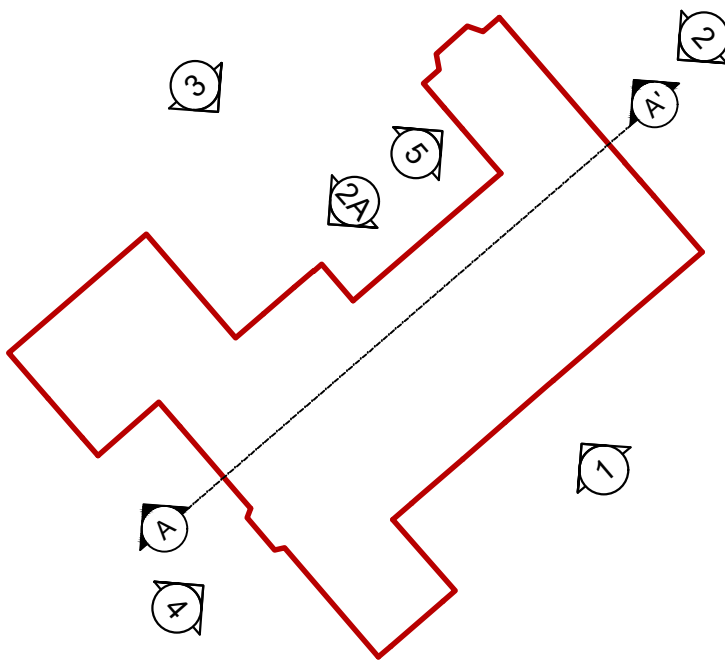

DRAWING TITLE:	PROPOSED ELEVATIONS
JOB DWG NO:	25-P-149
CLIENT:	
REVISION:	
REV / DATE	DESCRIPTION

NOTES

1. This drawing and the copyright and patent herein are the designer's property and may be used or reproduced only under contract.
2. Contractor and sub-contractor must check and agree all dimensions before preparing shop drawings or commencing work on site.
3. Contractor are responsible for informing the Designer of any discrepancy discovered on this drawing or between this drawing and any other related documents issued in respect of the work.
4. Written dimensions only are to be used from this drawing. If any doubt exist the contractor must ask for clarification. On no account must the contractor scale off this drawing.
5. If no site investigation has been carried out prior to commencement of work, Contractor to make test holes to test suitability of ground for proposed foundations.
6. All work must be carried out in accordance with the current Building Regulations, Codes of Practice and British Standards. If any doubt exists the contractor must ask for clarification.
7. All references refer to accompanying specification.
8. Information is based on OS map and received information and is subject to full topographical and building survey. Assumed site boundary and site constraints subject to confirmation.