


ACUMEN SPOT LEVELS TAKEN ON SITE 18.11.25

■ RED DENOTES FILL AMOUNT EXCEEDING 200mm

■ BLUE DENOTES FILL AMOUNT NOT EXCEEDING 200mm

○ DENOTES INDICATIVE ZONE OF EXCEEDING FILL

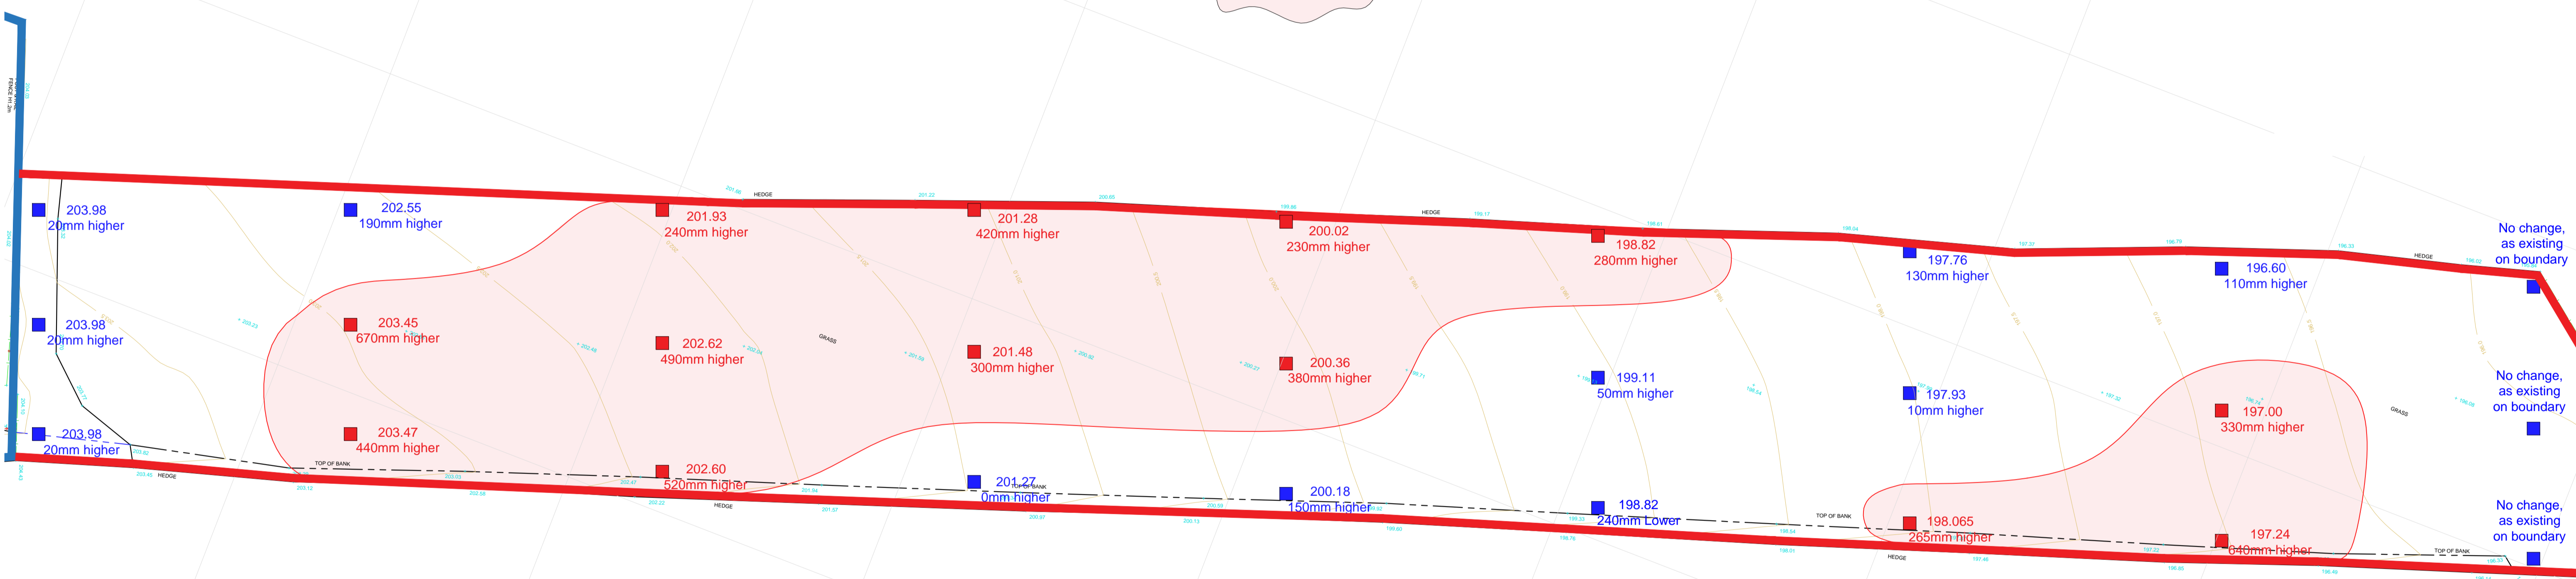

DO NOT SCALE OFF THIS DRAWING

rev	description	drawn	auth	date



acumenarchitects.co.uk 01484 546 000
 Headrow House, Old Leeds Road, Huddersfield, HD1 1SG

Client
MR & MRS FORSTER

Project
**ENGINEERING OPERATIONS @
 22 STRINGER HOUSE LANE**

Project No 2721	Drawing No (100) 13	Rev
---------------------------	-------------------------------	-----

Description
AS BUILT (CURRENT) SPOT LEVELS

Scale 1:200 @ A1	Date Drawn 19.11.25	Drawn By AO	Authorised By JC
----------------------------	-------------------------------	-----------------------	----------------------------

Purpose of Issue
 Planning Building Regs Tender Construction Comment Info