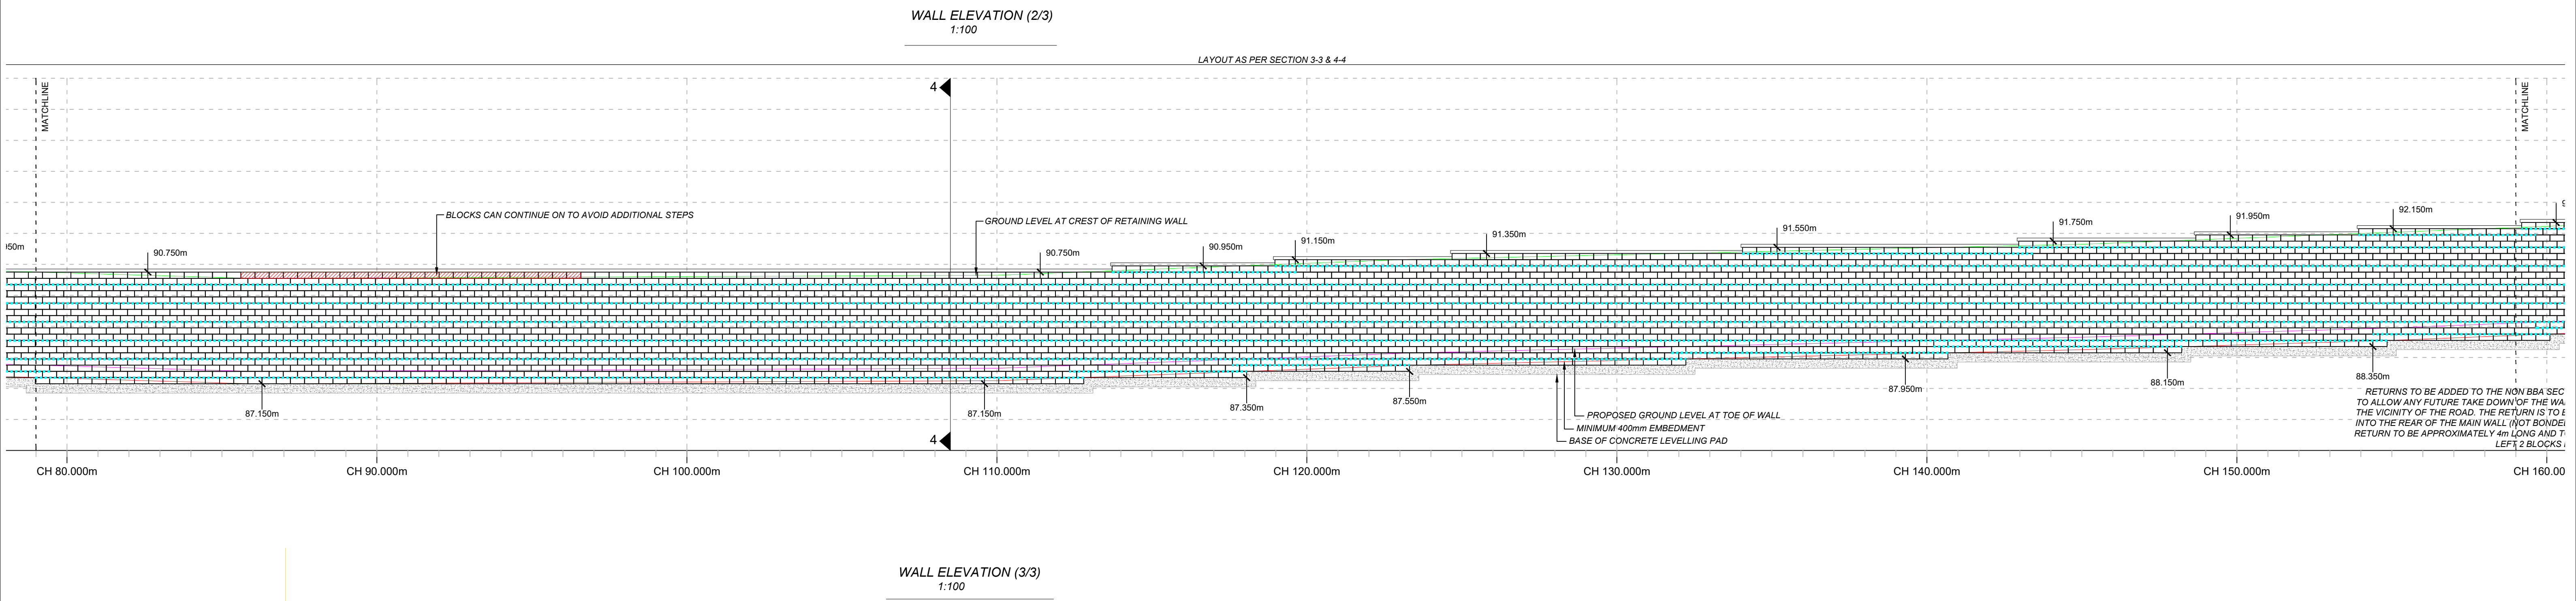
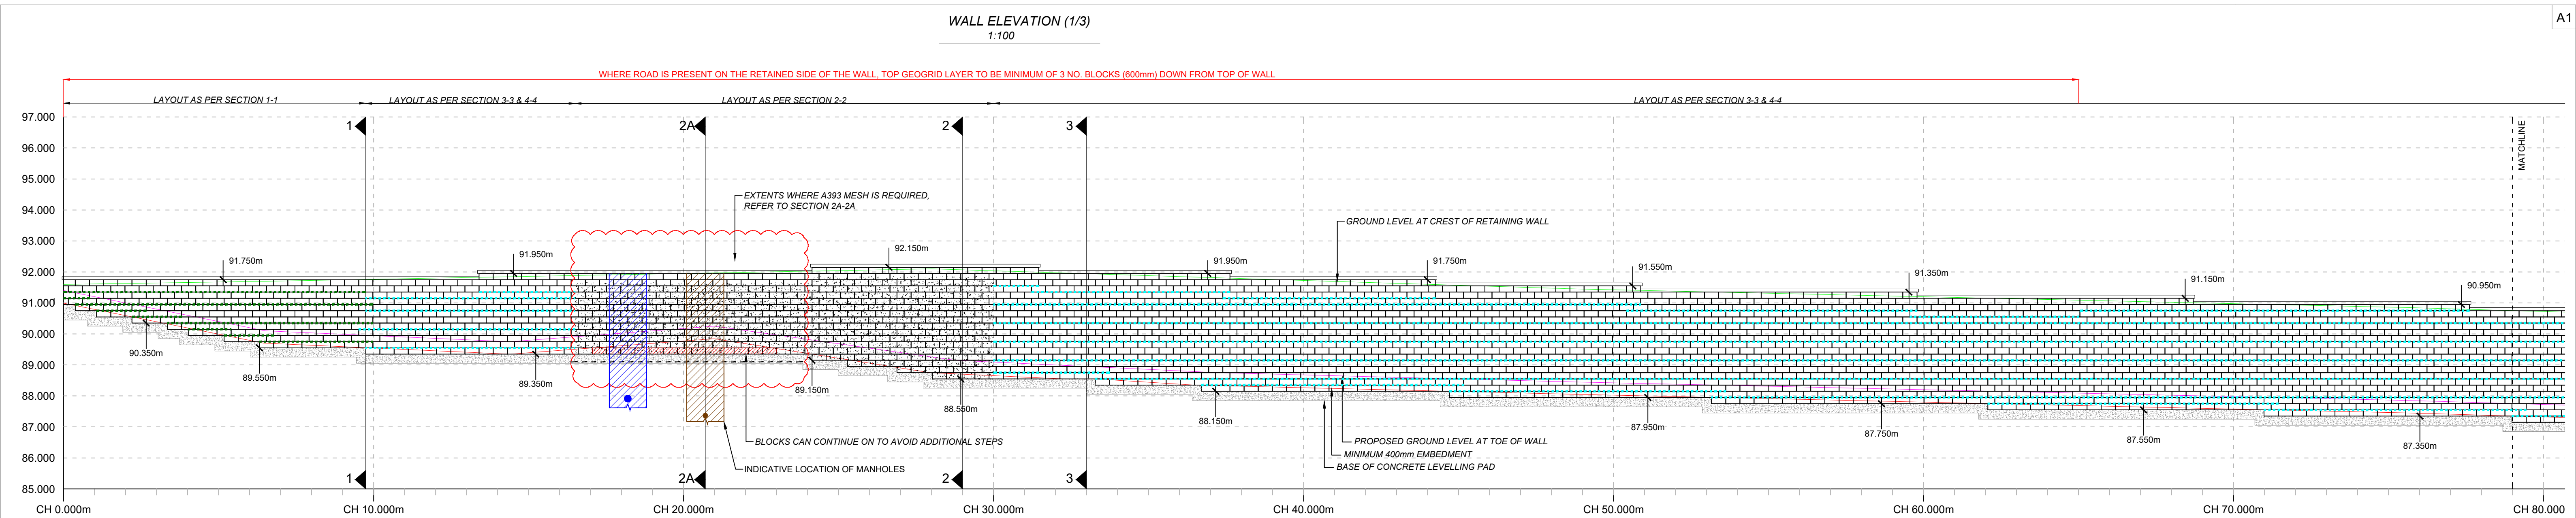


				Drawing Title: VERTICA MACWALL ELEVATION		Designed: DMCG		Date: 07.11.25		Project Title: PENINSTONE LANE, FEANEY BRIDGE		MACCAFERRI T: 01865 770555 E: technical.uk@maccaferri.com E: construction.uk@maccaferri.com	GEOMAN T: +44 (0)2890 664 941 E: geoman@geoman.co.uk				
				Scale @ A1: AS SHOWN		Unit: MM		Project Number: 24-5915-F1		Drawn: DMCG				Date: 07.11.25		Client: K HARAN CIVILS	
				Drawing Number: SK24-5915-F1-02		Revision: B		Checked: GM		Date: 07.11.25				Drawing Status: CONCEPT/PRELIMINARY ONLY ☐ FOR APPROVAL ☒ FOR CONSTRUCTION ☐ AS BUILT ☐			
Status/Rev/Description:				Drawn/ App./ Date:													
B DIMENSIONS INCREASED CLOSE TO ROAD				DMCG 07.11.25													
A HAPAS BBA BLOCKS INCLUDED				DMCG 22.08.25													
0 CONCRETE DETAIL AT MANHOLES				DMCG 30.03.25													
0				DMCG 21.03.25													