




SOUTH (REAR) ELEVATION

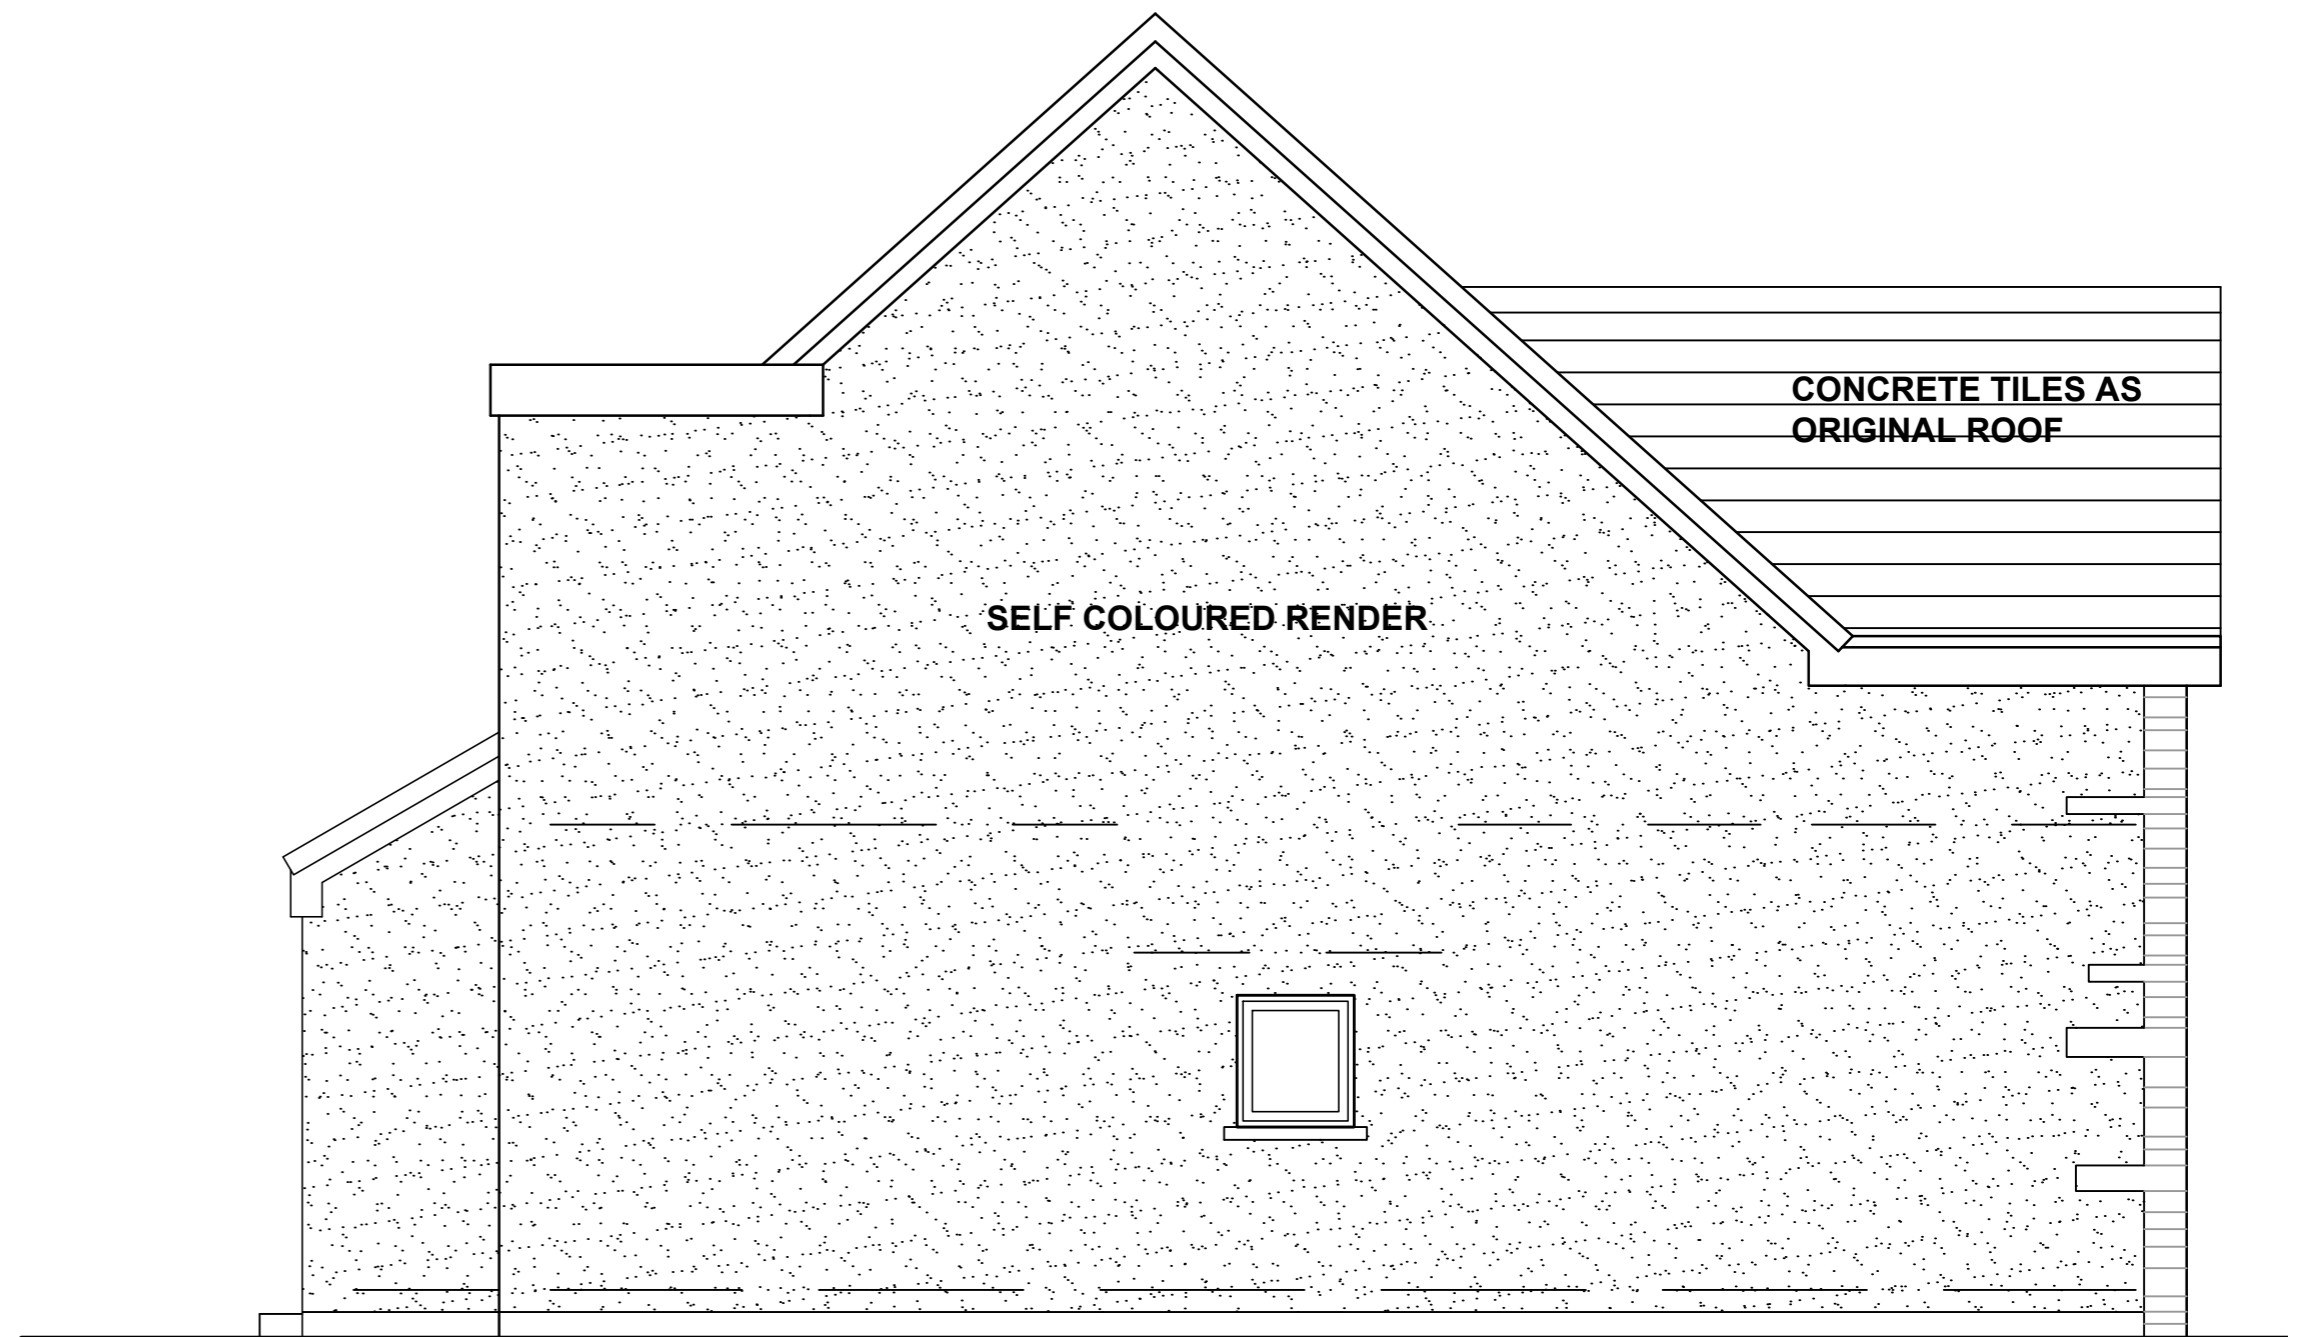

EAST (SIDE) ELEVATION

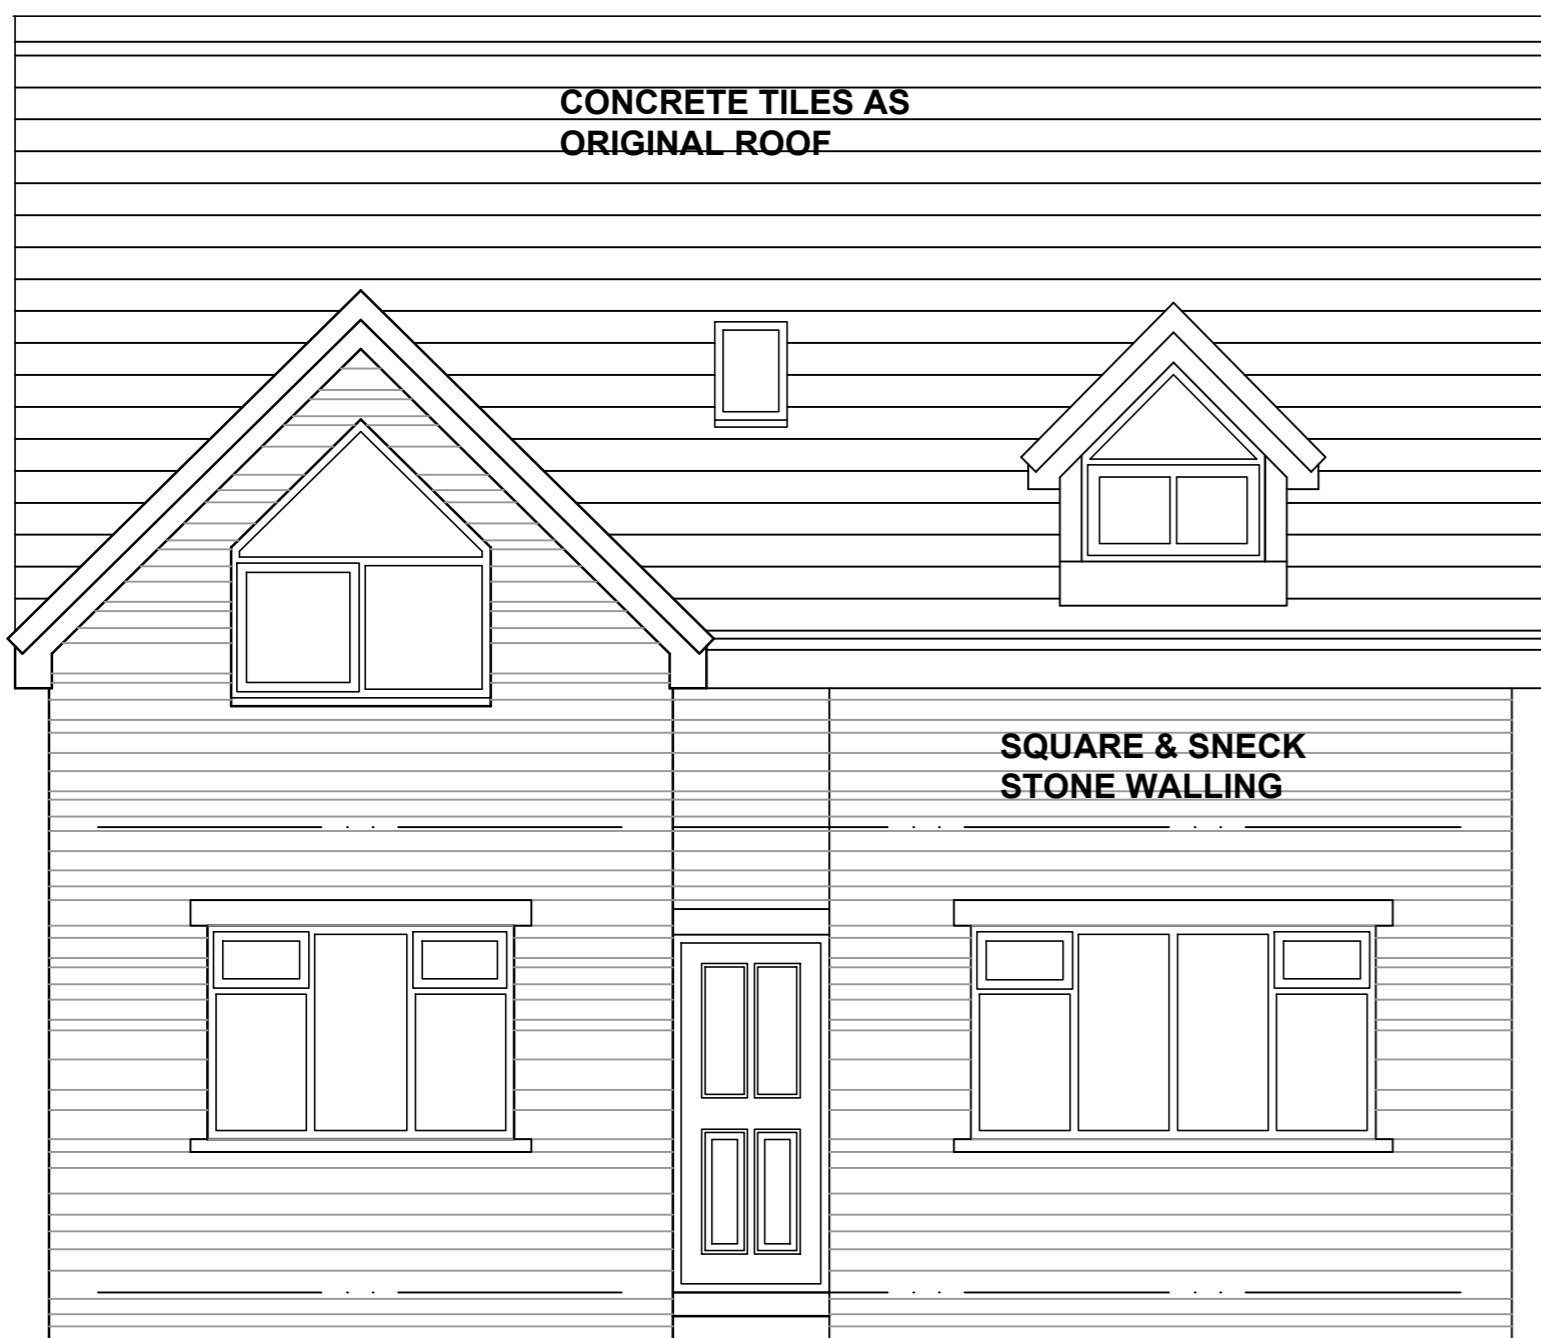

NORTH (ROAD/FRONT) ELEVATION

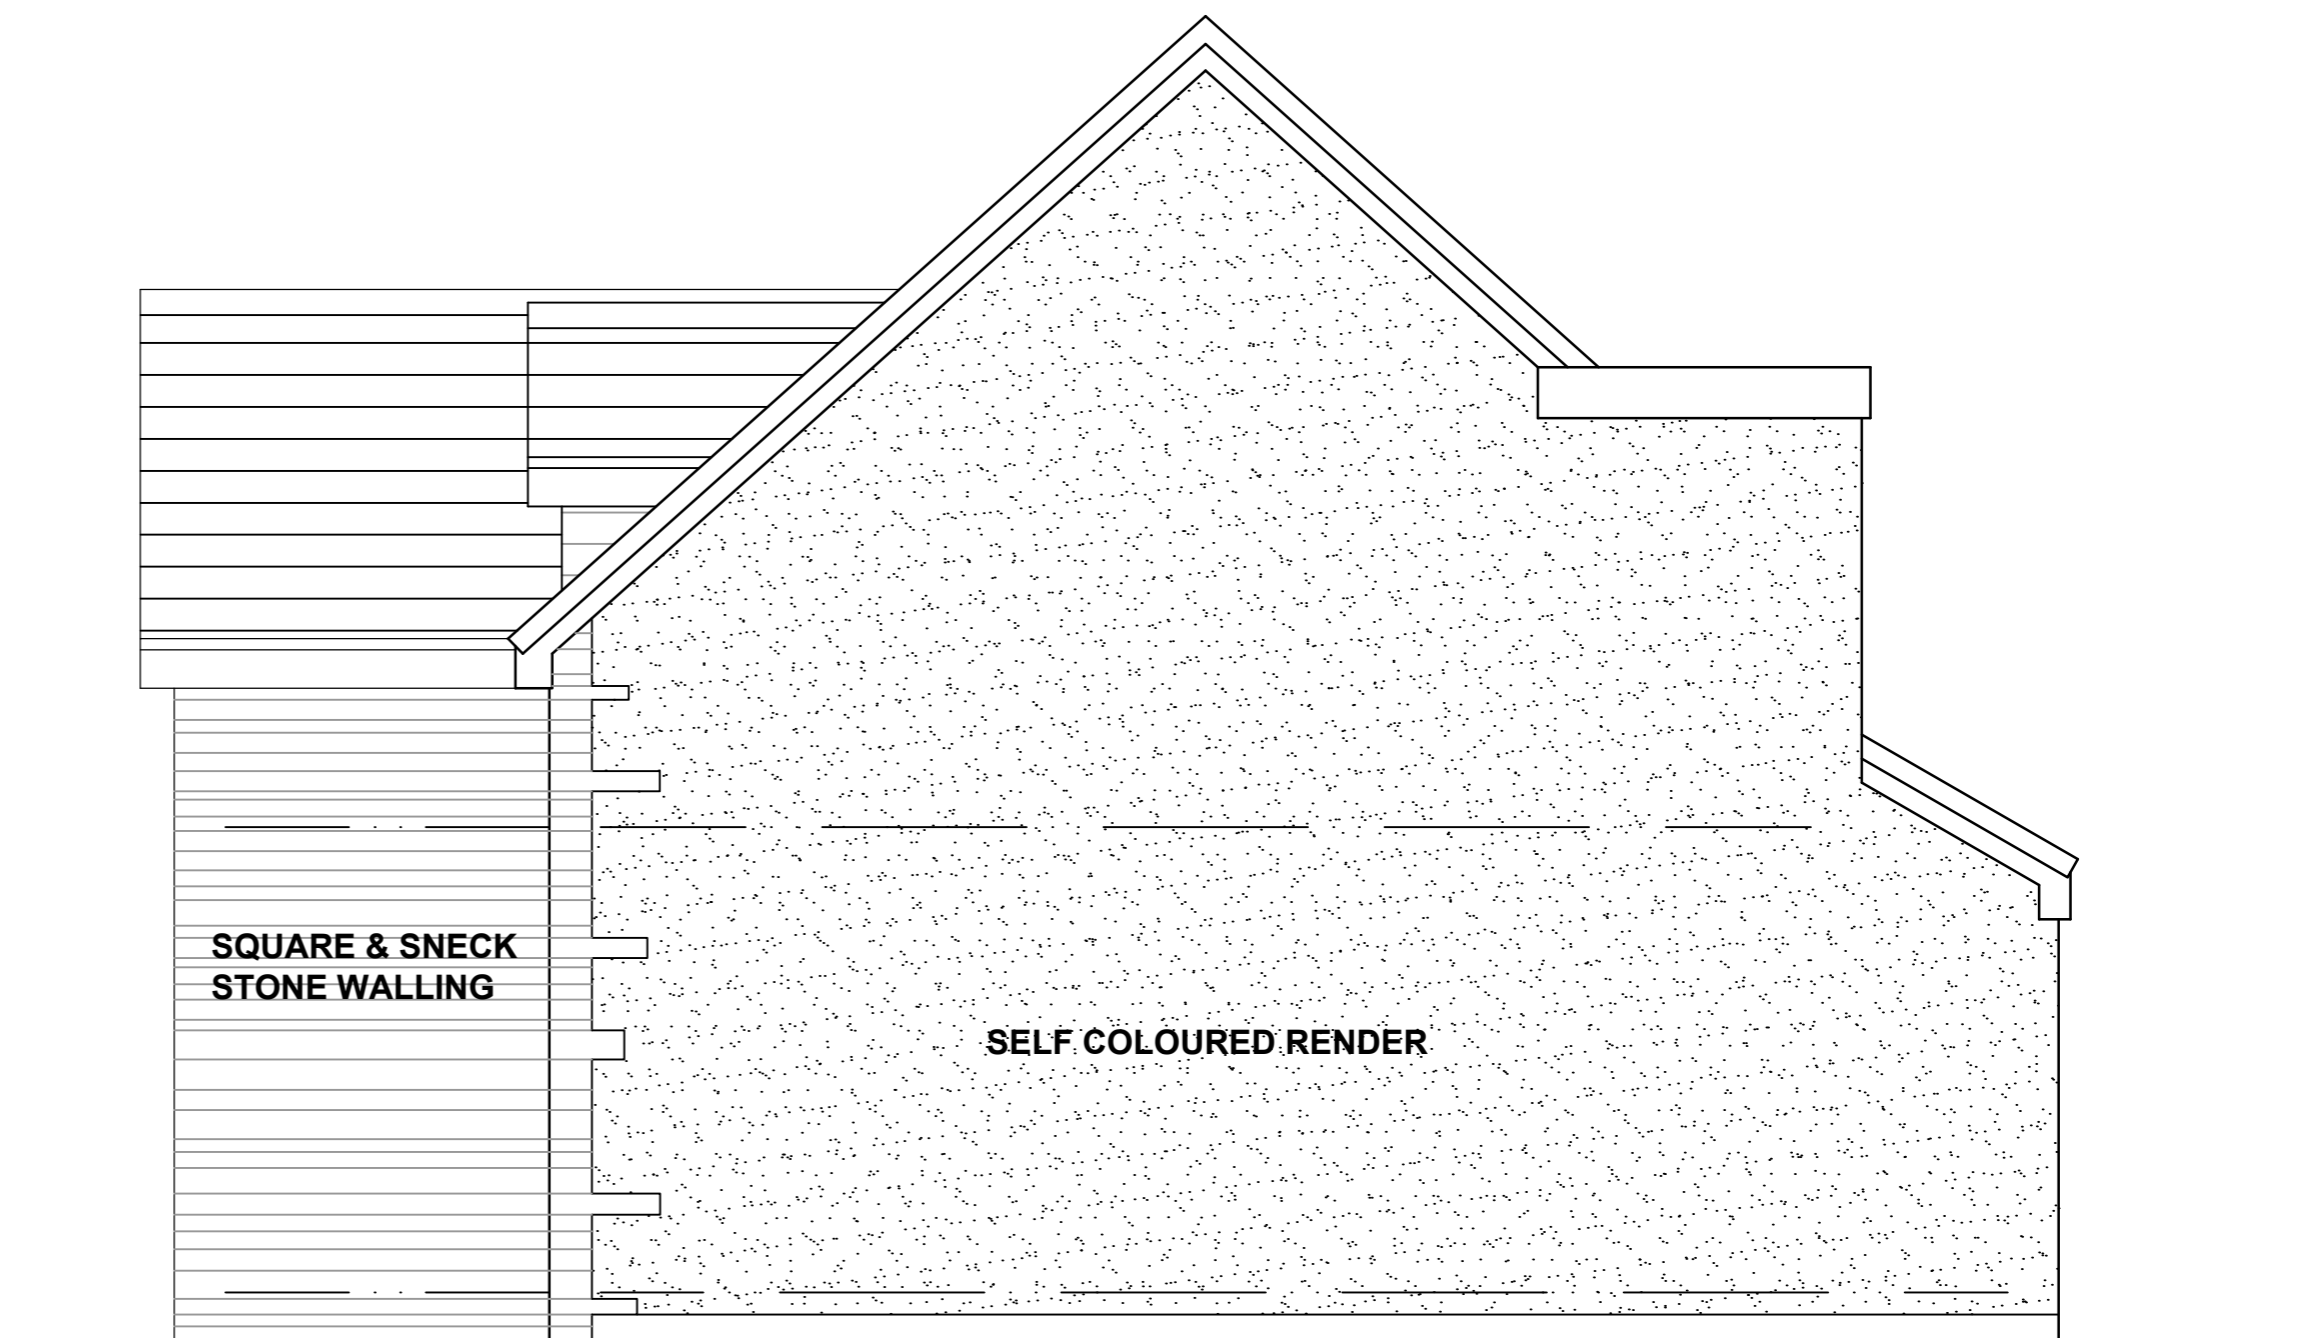

WEST (SIDE) ELEVATION

THIS DRAWING TOGETHER WITH THE DESIGN IS THE PROPERTY AND COPYRIGHT OF BRT SERVICES AND MUST NOT BE REPRODUCED WITHOUT WRITTEN PERMISSION

ONLY FIGURED DIMENSIONS TO BE USED
SCALED DIMENSIONS TO BE CHECKED WITH
BRT SERVICES

EXISTING BUILDING DIMENSIONS ARE FOR INDICATION
ONLY AND SHOULD BE PHYSICALLY CHECKED ON SITE
PRIOR TO WORK COMMENCING

PARTY WALL SURVEYOR..... NOT REQUIRED
PLANNING SUPERVISOR..... NOT REQUIRED
M&E ENGINEER NOT REQUIRED
STRUCTURAL ENGINEER..... NOT REQUIRED

PLANNING APPLICATION



BRT Services
52 ASHENHURST AVENUE,
ASHENHURST,
HUDDERSFIELD, HD4 6PX
TEL: 07855 945690

LANDSCAPING & ARCHITECTURAL SERVICES

Client MR M Mukhtar

Job title PROPOSED EXTENSION:
59 LARCH ROAD,
PADDOCK,
HUDDERSFIELD

Drawing 736-03
DWELLING EXTENSIONS
AS BUILT

Scale 1:50 @ A1

Date OCT 2025

Revision -