




Existing (AS BUILT)

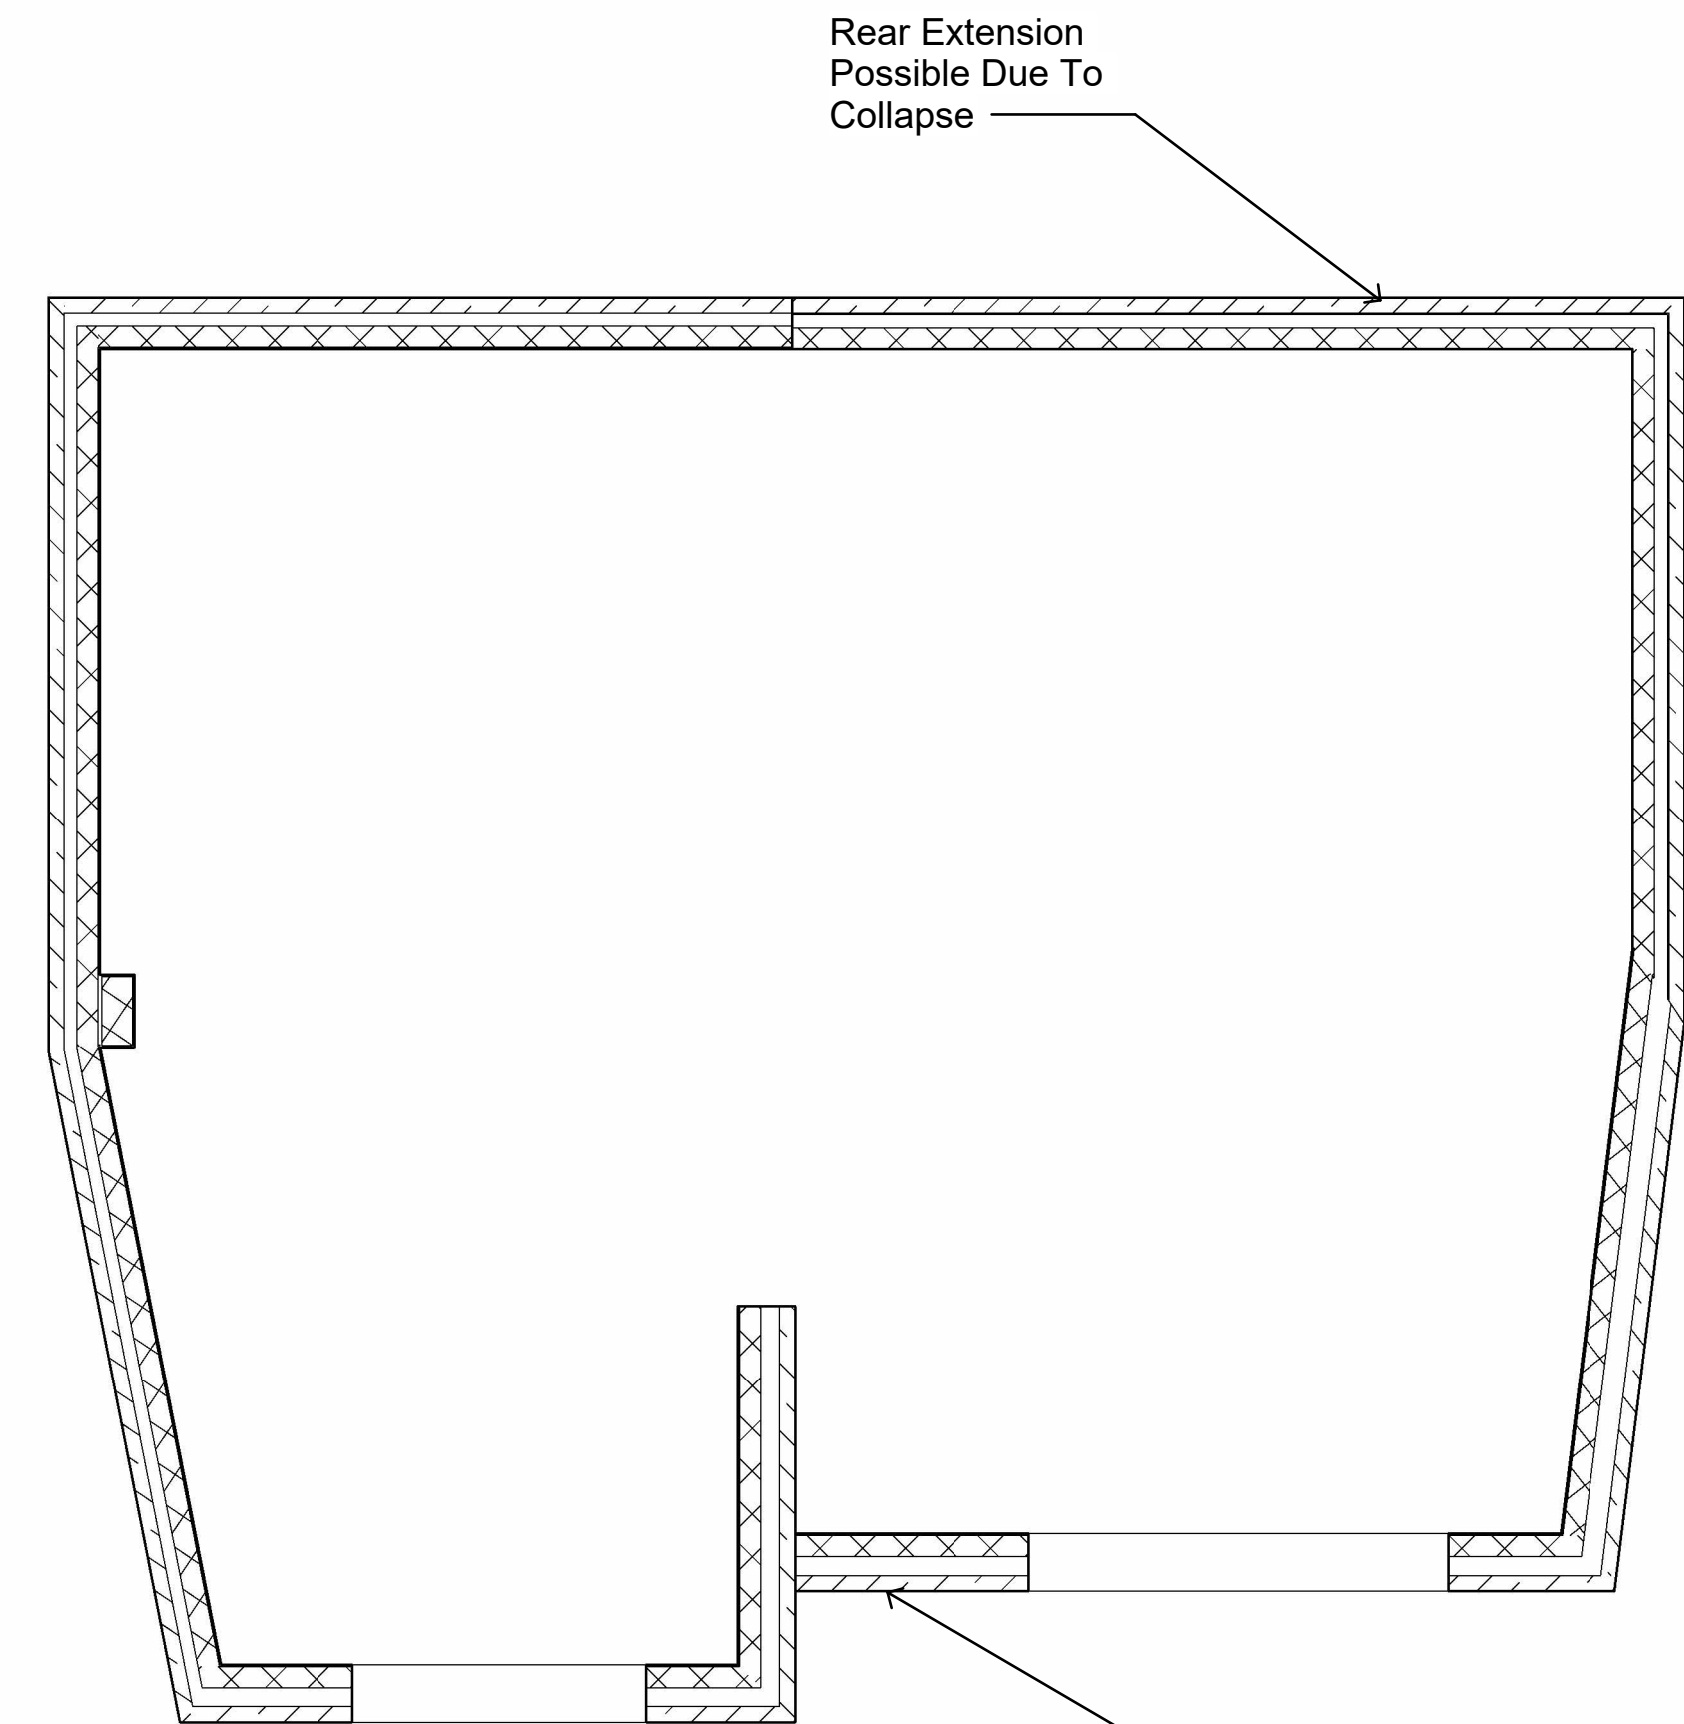


Existing Ground Floor Plan  
1 : 50

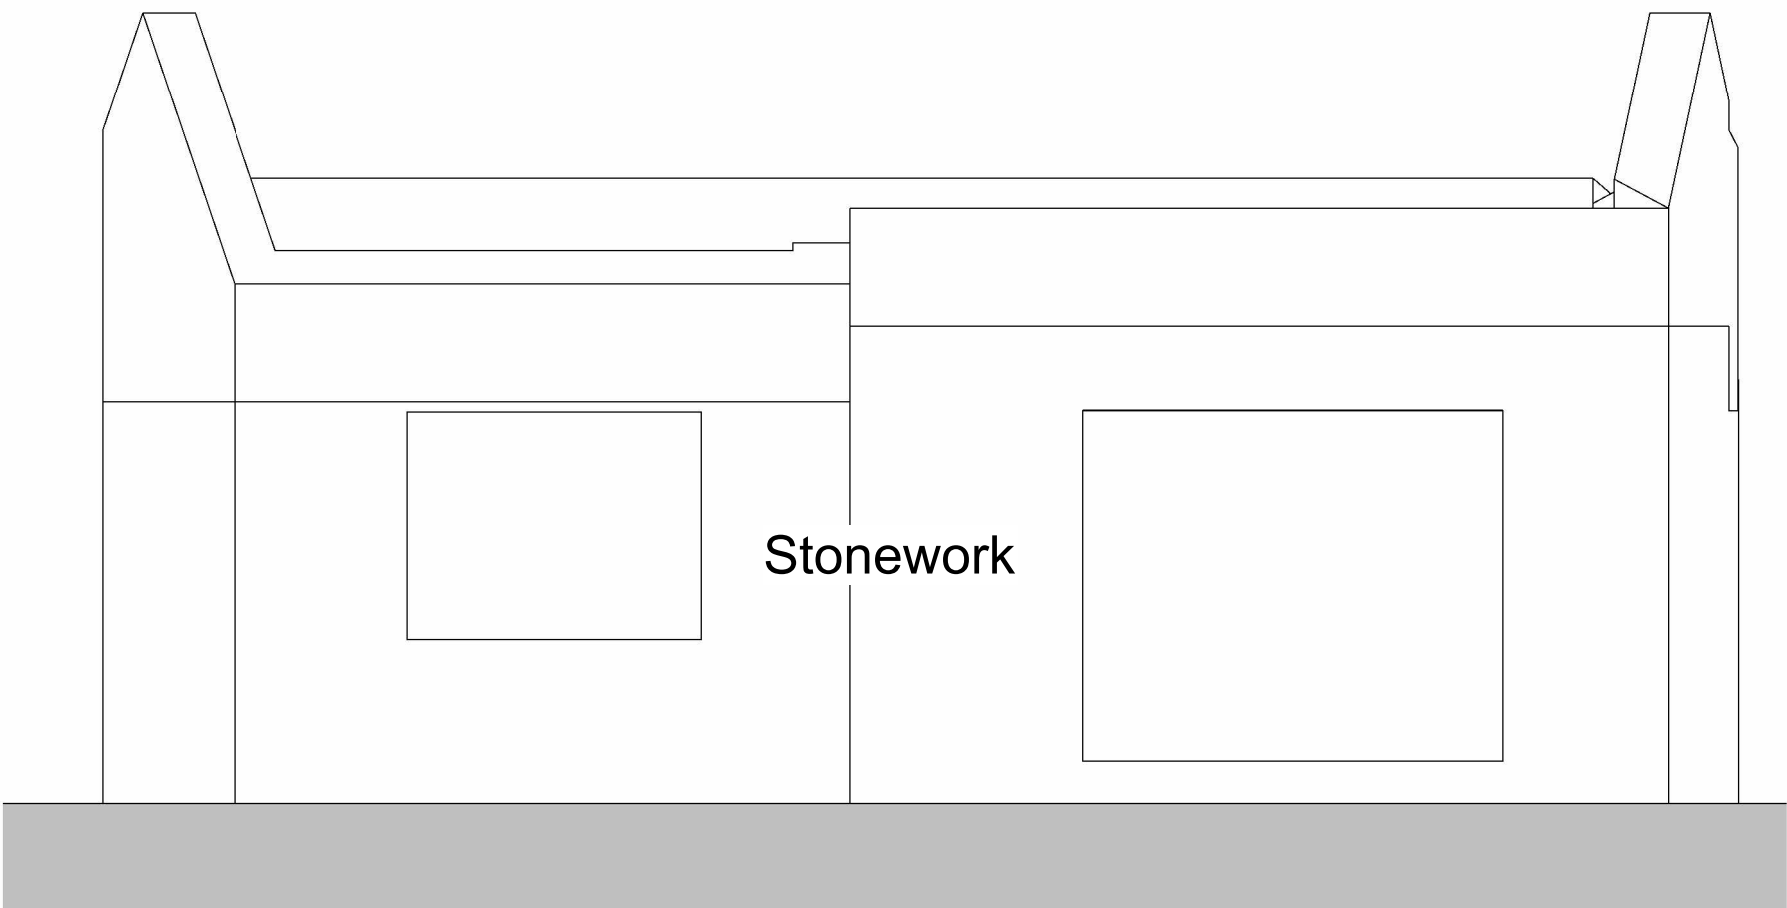


Existing South South West Elevation (Front)  
1 : 50

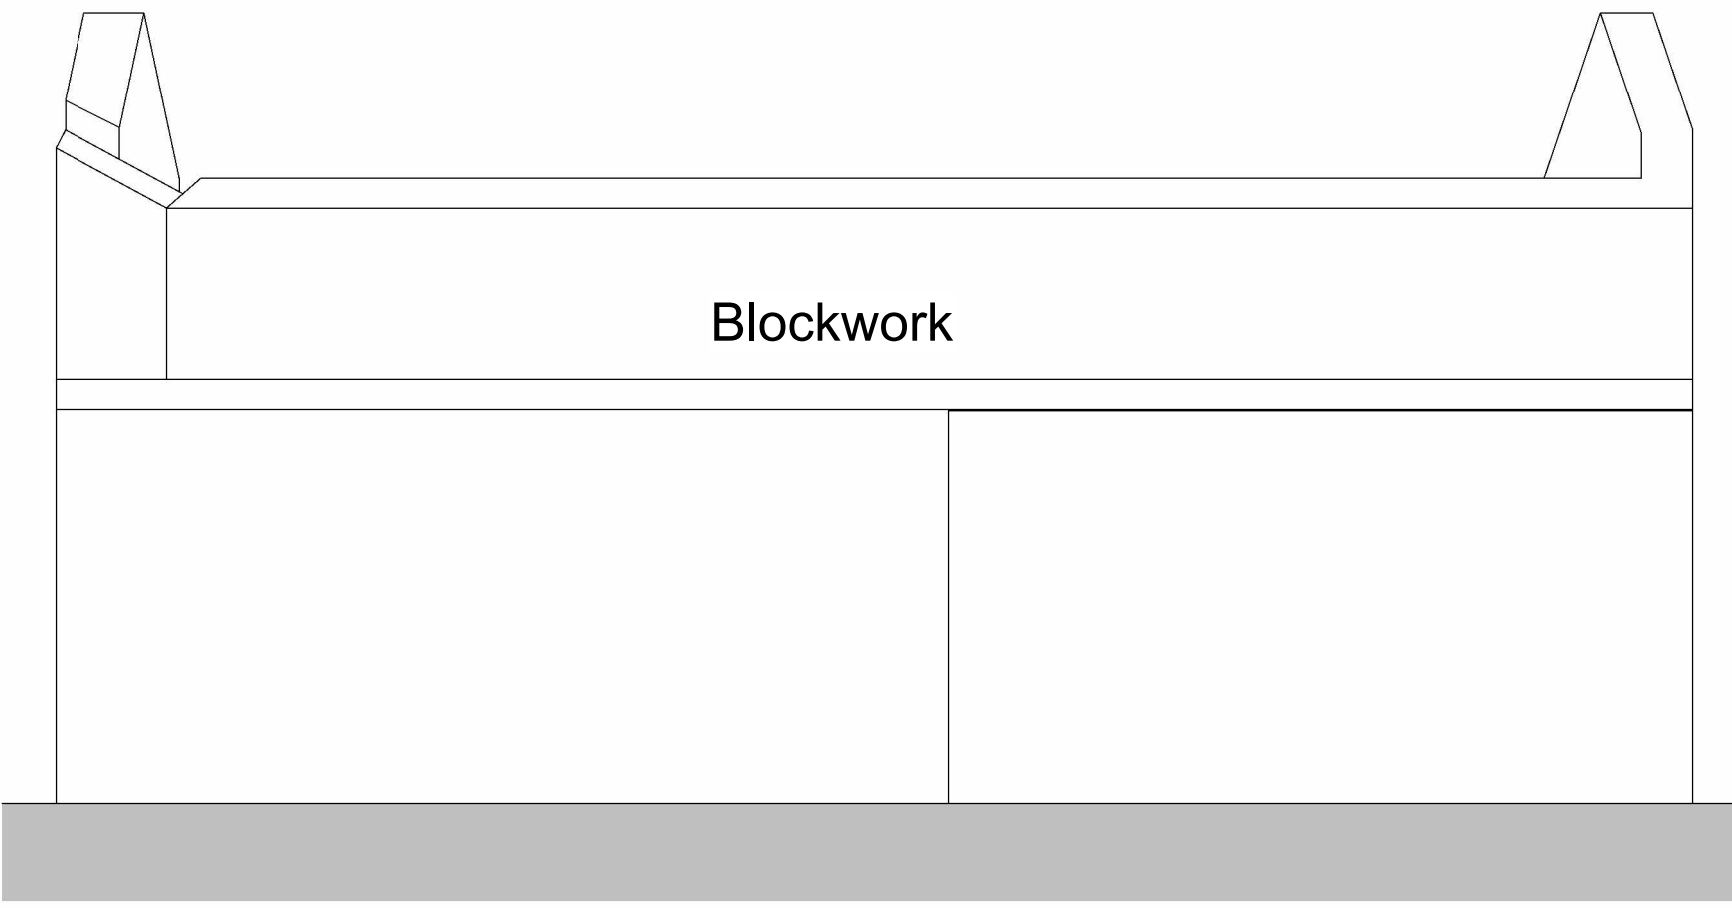


Existing North North East Elevation (Rear)  
1 : 50

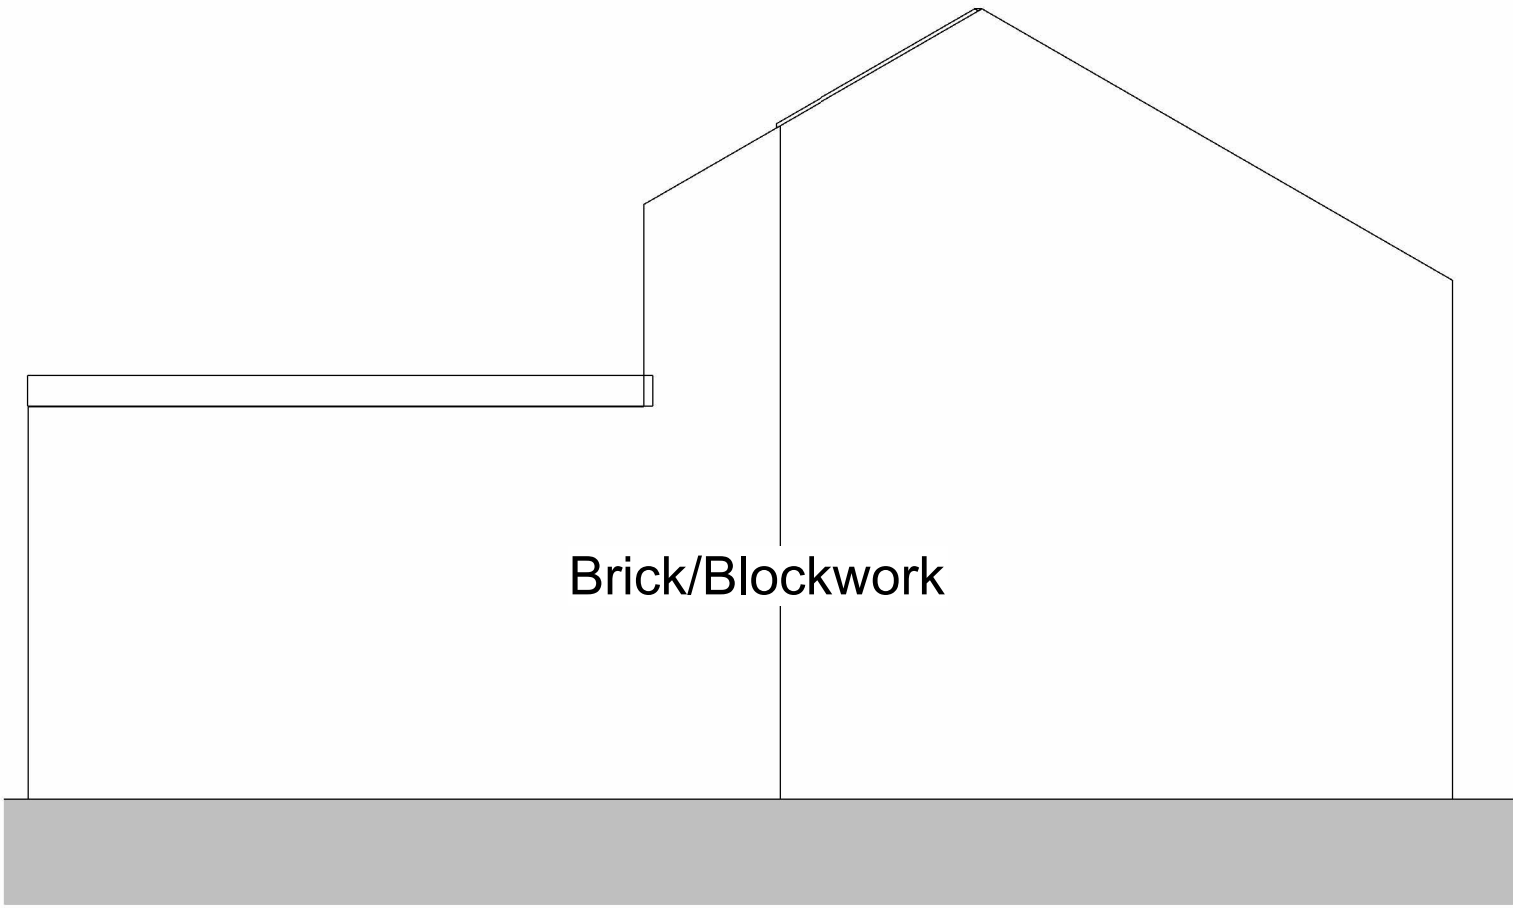

Existing West North West Elevation (Left)  
1 : 50

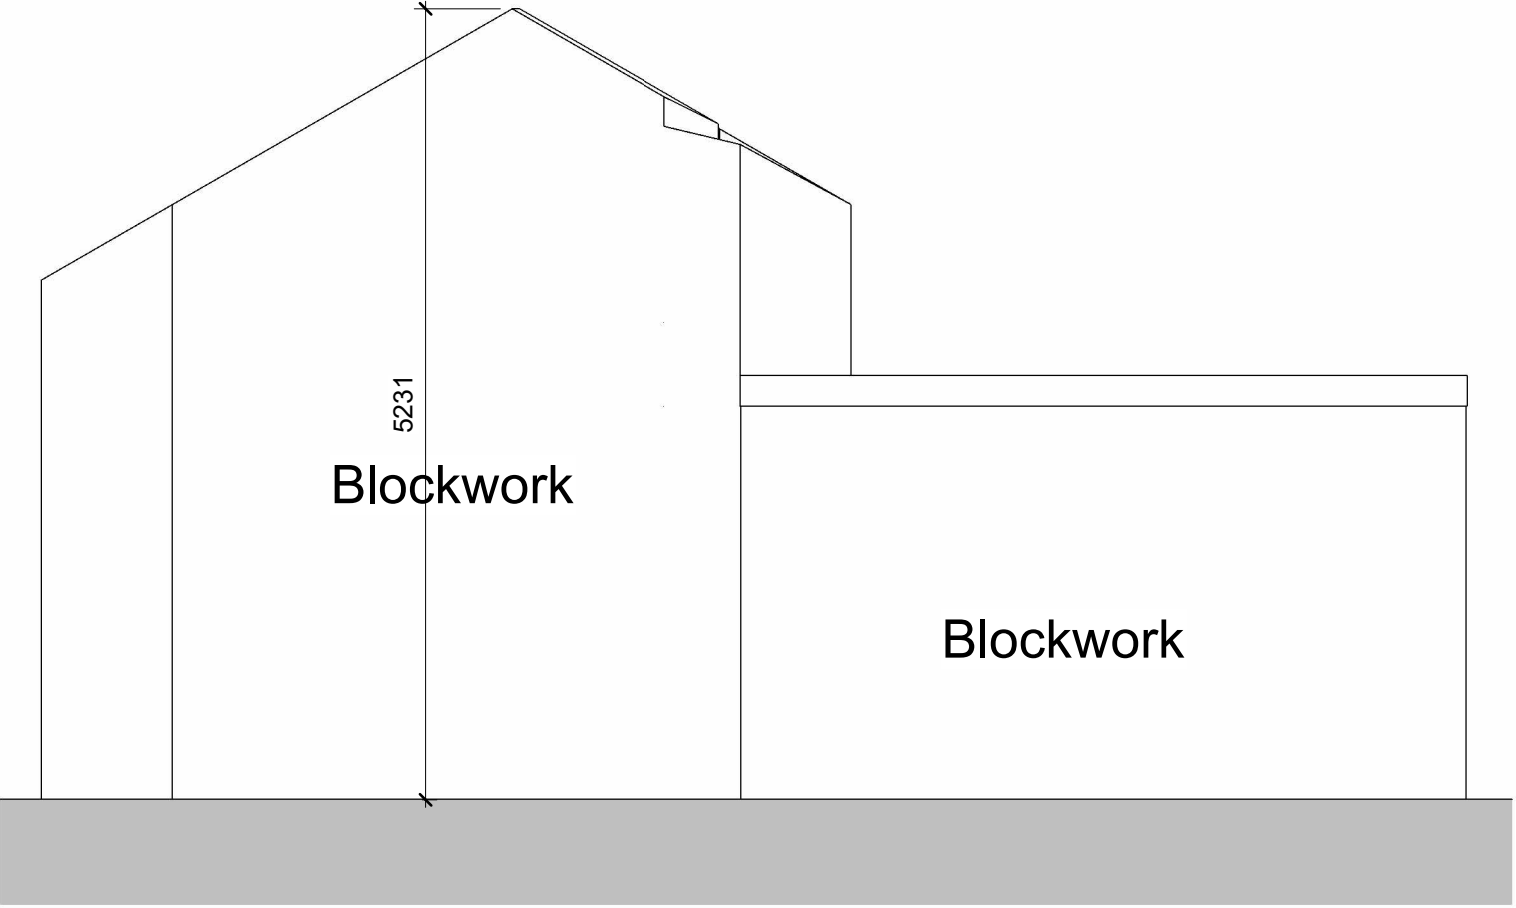

Existing East South East Elevation (Right)  
1 : 50

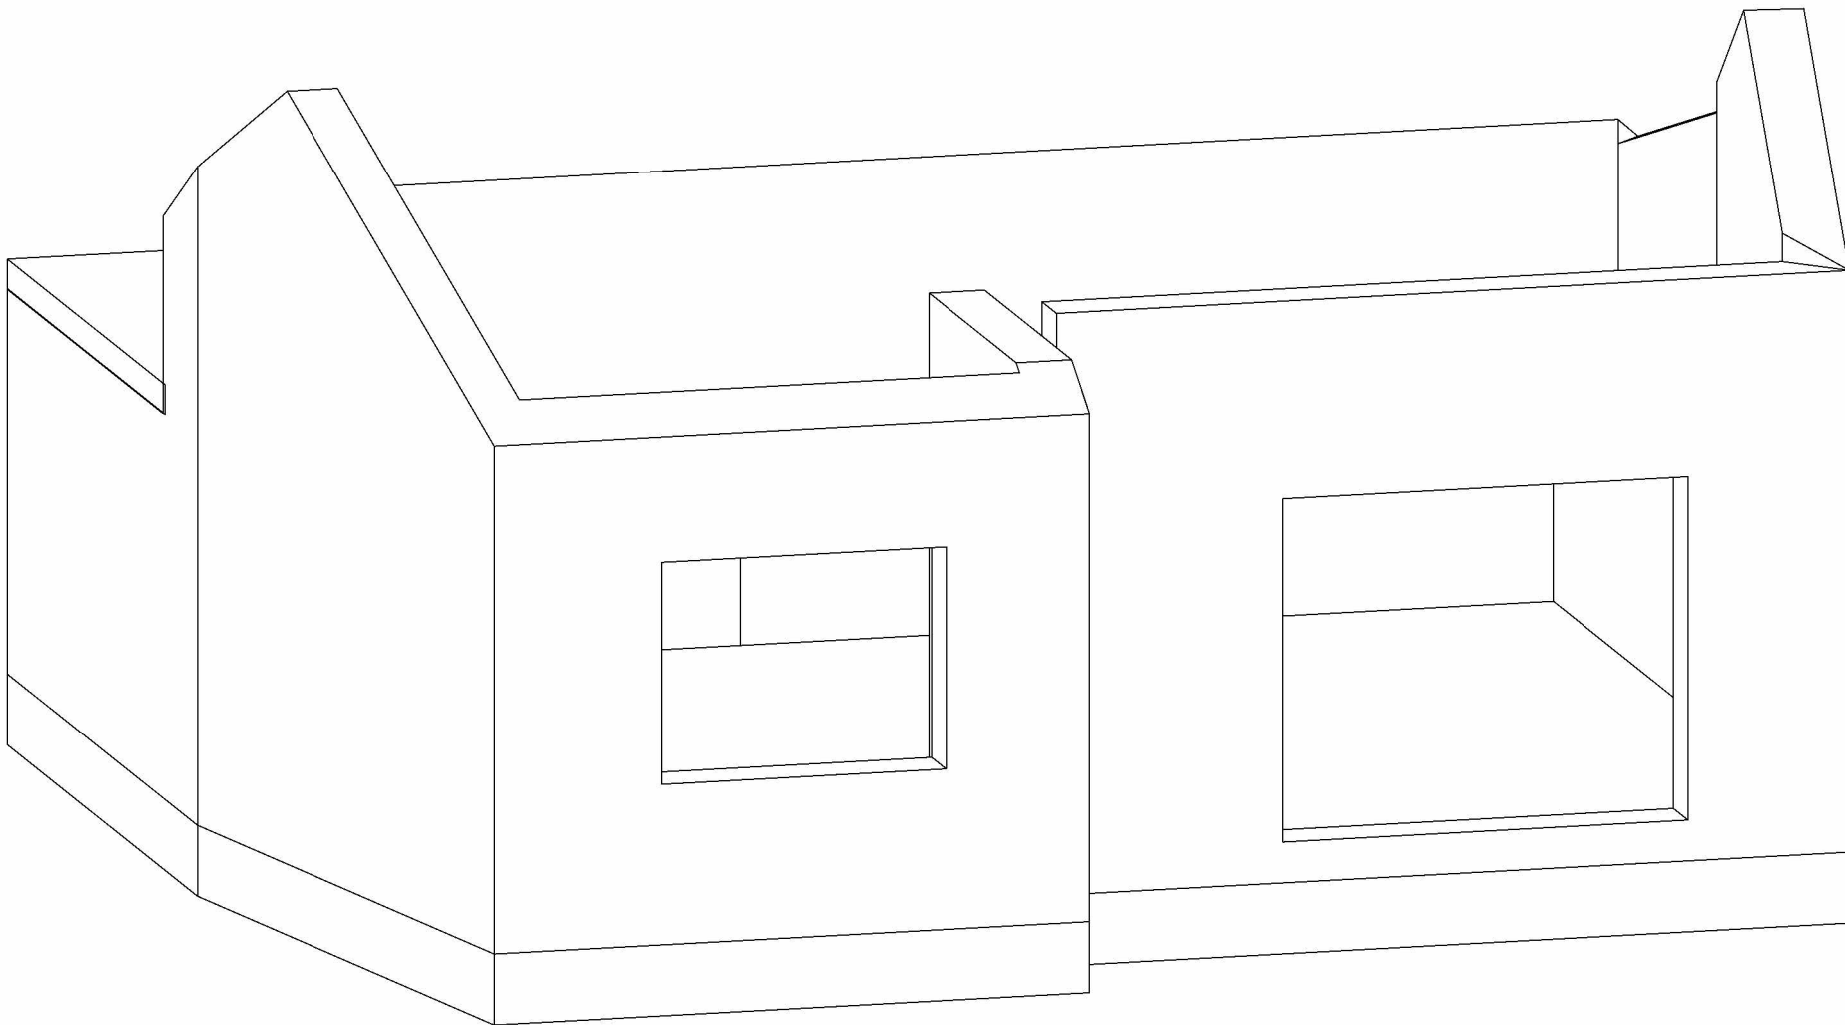

Existing 3D

**Note:**

All Dimensions Are Approximate  
And TBC On Site By Contractor

|                                                                                                                                                                                                                                                                      |                                        |
|----------------------------------------------------------------------------------------------------------------------------------------------------------------------------------------------------------------------------------------------------------------------|----------------------------------------|
| <div><div></div><div><div>TREND</div><div>ARCHITECTURE</div><div>T: 01484 941051</div><div>plan@trendarchitecture.co.uk</div><div>www.trendarchitecture.co.uk</div></div></div> |                                        |
| <div>Mohammed Yaseen</div> <div>382 Huddersfield Rd, Mirfield WF14 9DL</div>                                                                                                                                                                                         |                                        |
| <div>Drawing Title:</div> <div>Existing (As Built) Grouped Plans</div>                                                                                                                                                                                               |                                        |
| <div>Drawing Number:</div> <div>TR-A25-0705-A5</div>                                                                                                                                                                                                                 | <div>Scale:</div> <div>1 : 50@A1</div> |
| <div>Date: 02/07/26</div>                                                                                                                                                                                                                                            | <div>Revision: C</div>                 |
| <div>Drawn By: AM</div>                                                                                                                                                                                                                                              | <div>Checked by: JA</div>              |
| <div>Reason For Issue:</div> <div>Planning</div>                                                                                                                                                                                                                     |                                        |