

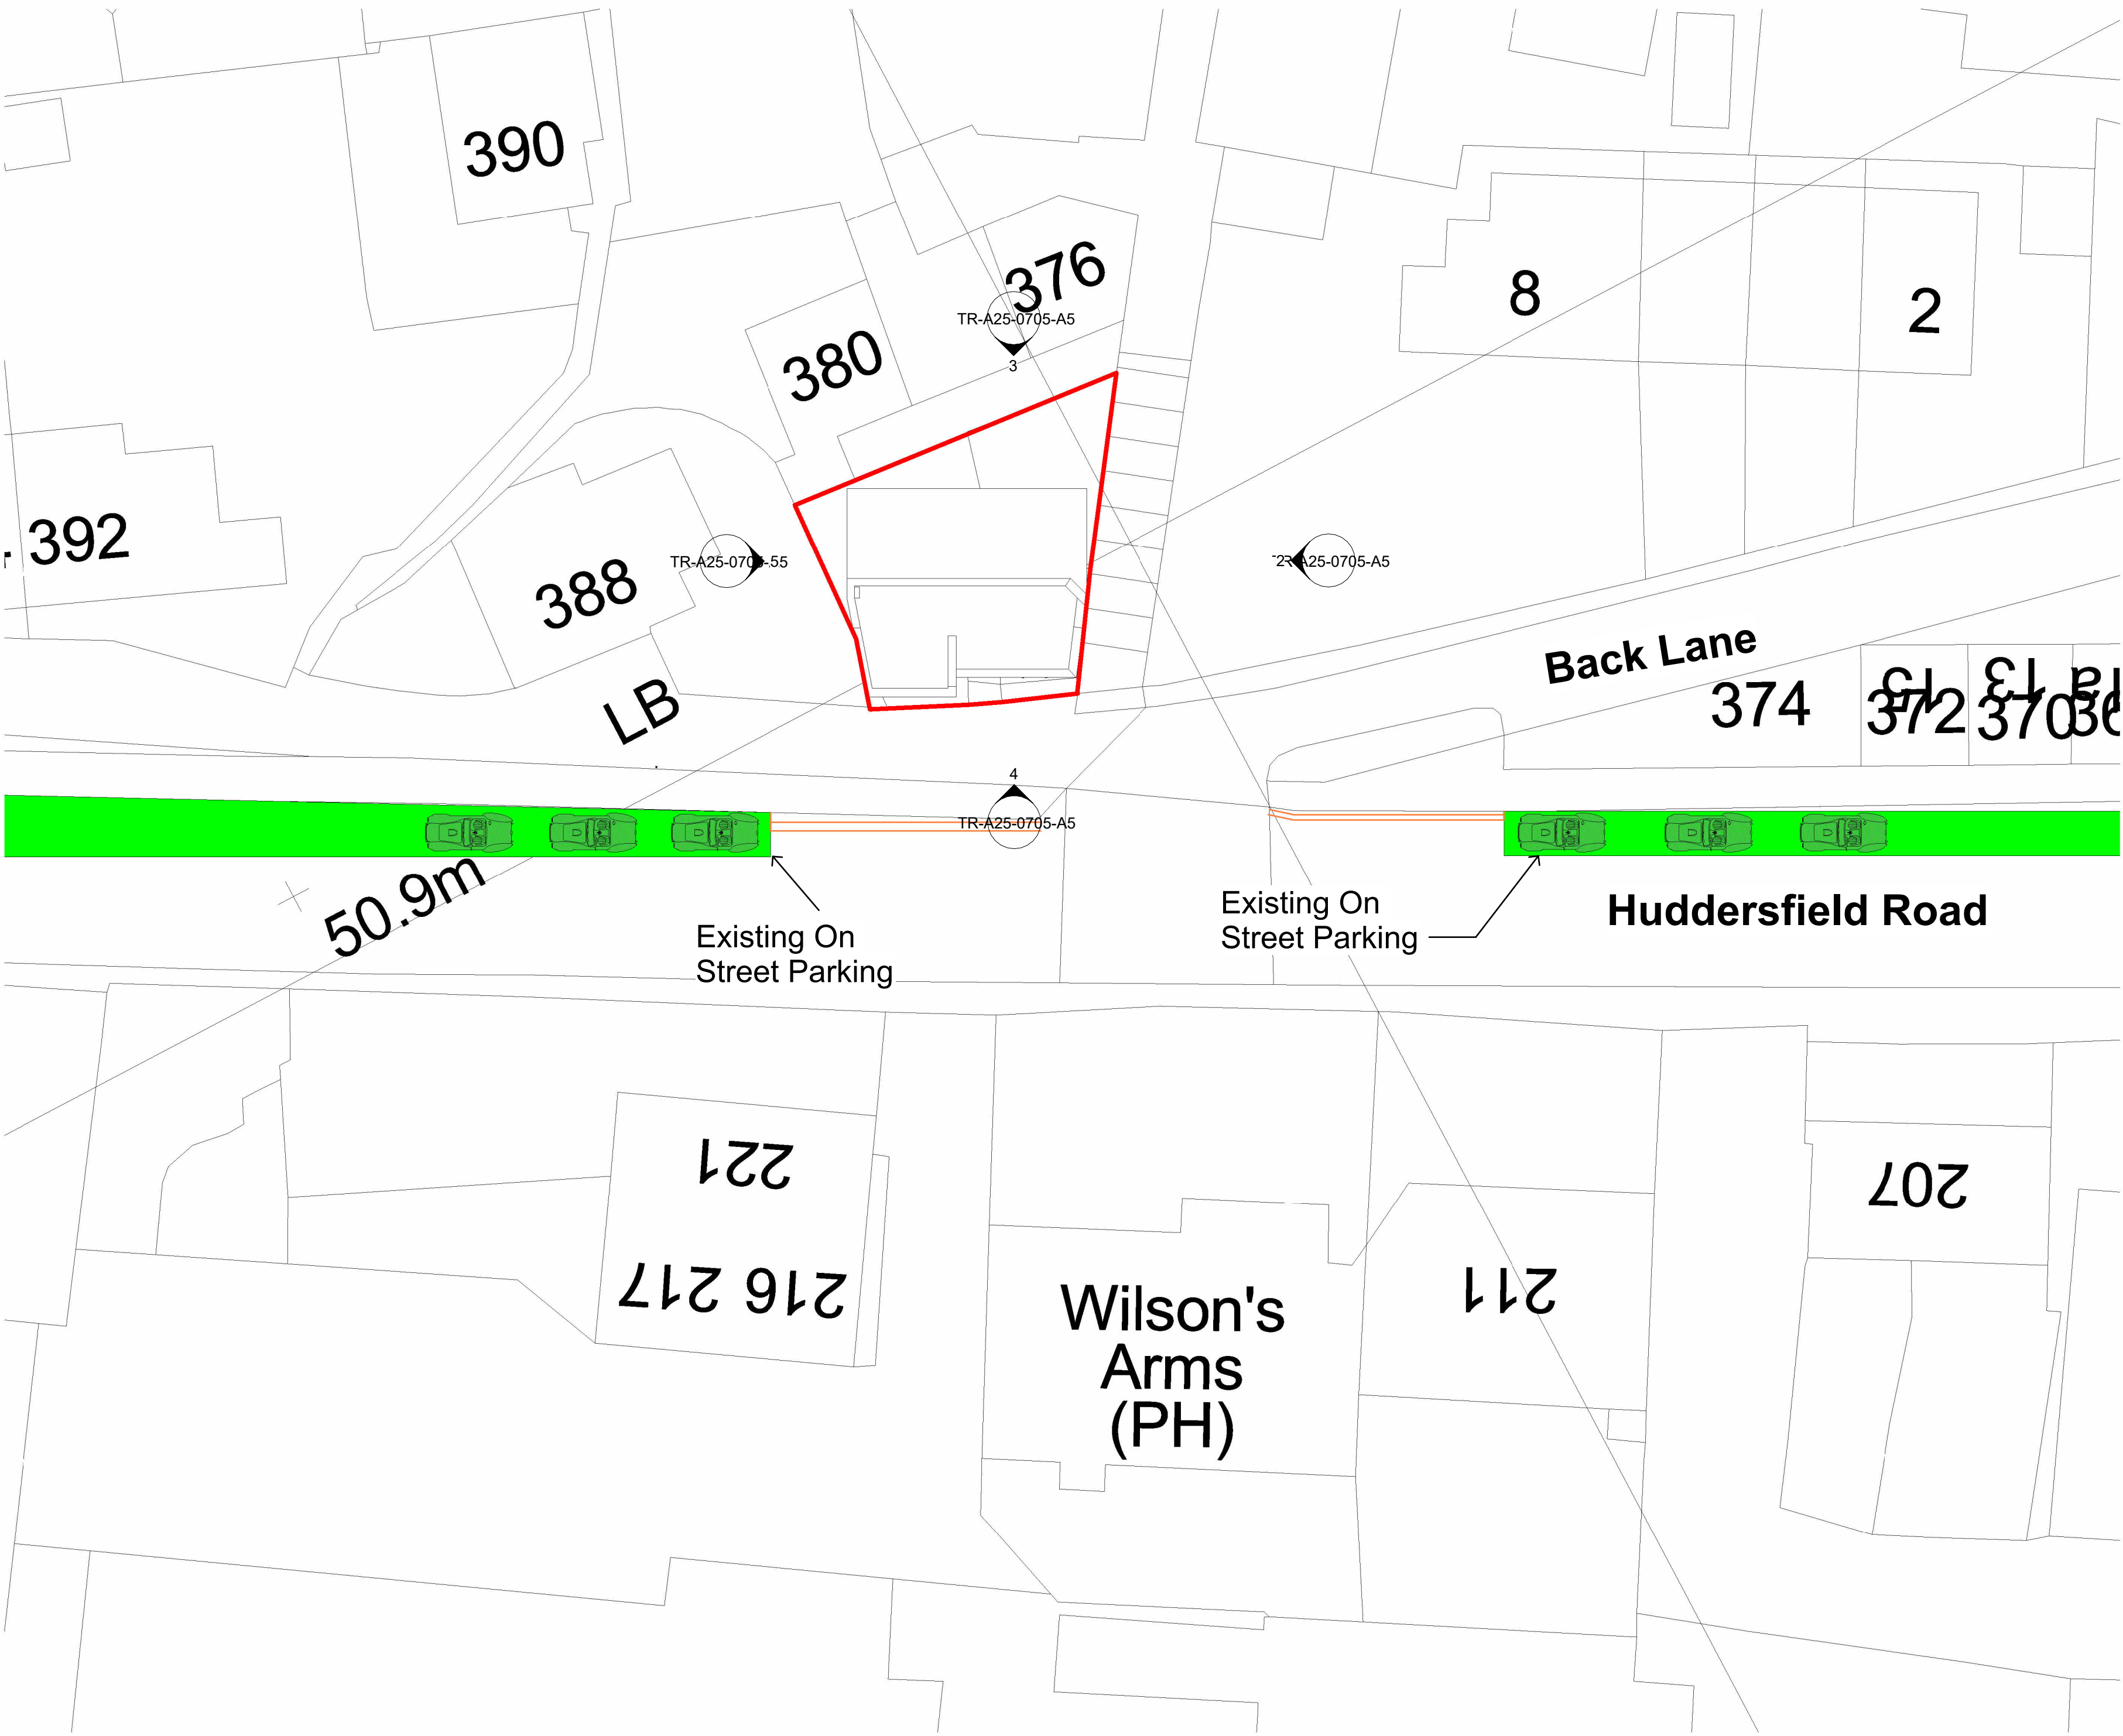
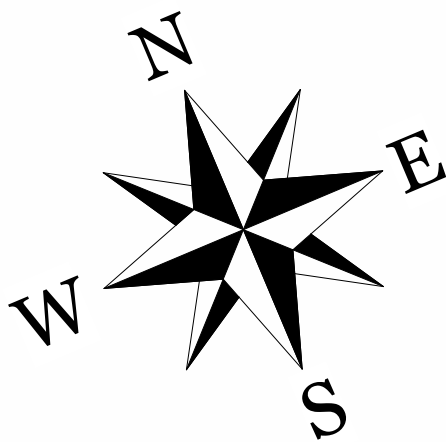


Existing (AS BUILT)

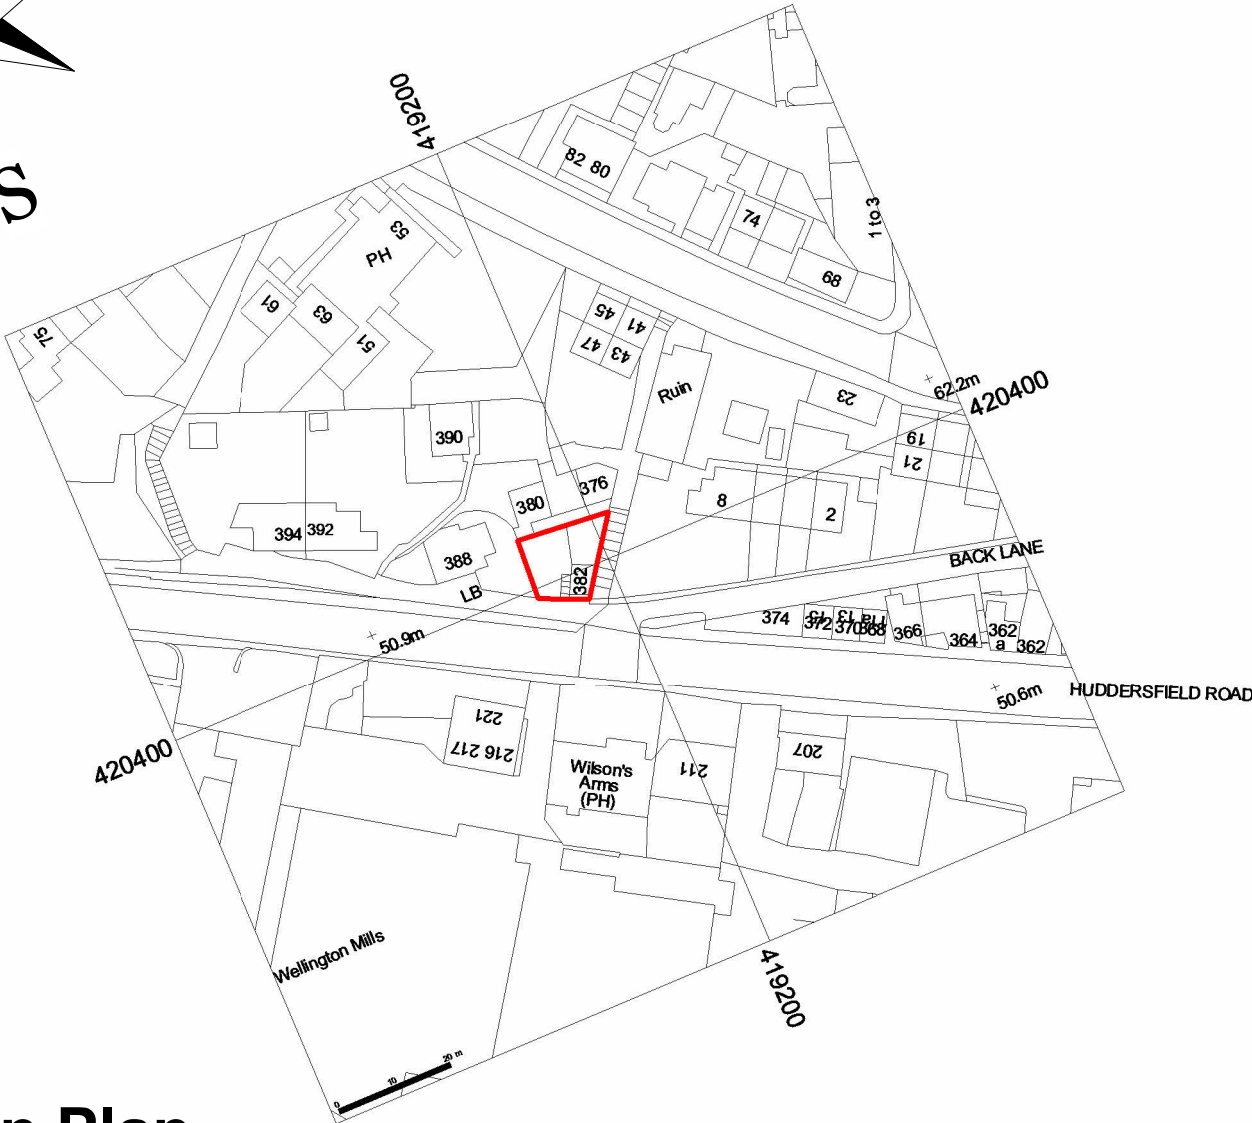

Existing Site Plan
1 : 200

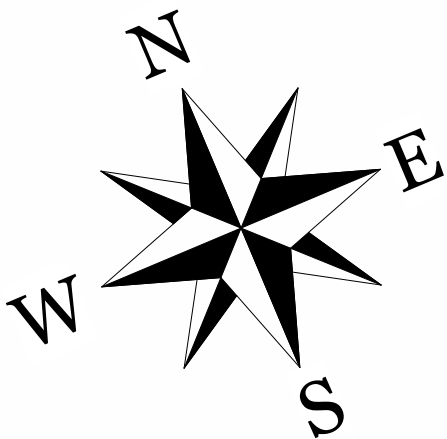

Location Plan
1 : 1250

Note:
All Dimensions Are Approximate
And TBC On Site By Contractor



TREND
ARCHITECTURE
T: 01484 941051
plan@trendarchitecture.co.uk
www.trendarchitecture.co.uk

Mohammed Yaseen
382 Huddersfield Rd, Mirfield WF14 9DL

Drawing Title:
Location & Existing Site Plan

Drawing Number: TR-A25-0705-A4
Scale: As indicated@A1

Date: 02/07/26
Revision: C

Drawn By: AM
Checked by: JA

Reason For Issue:
Planning