




Existing (AS BUILT)

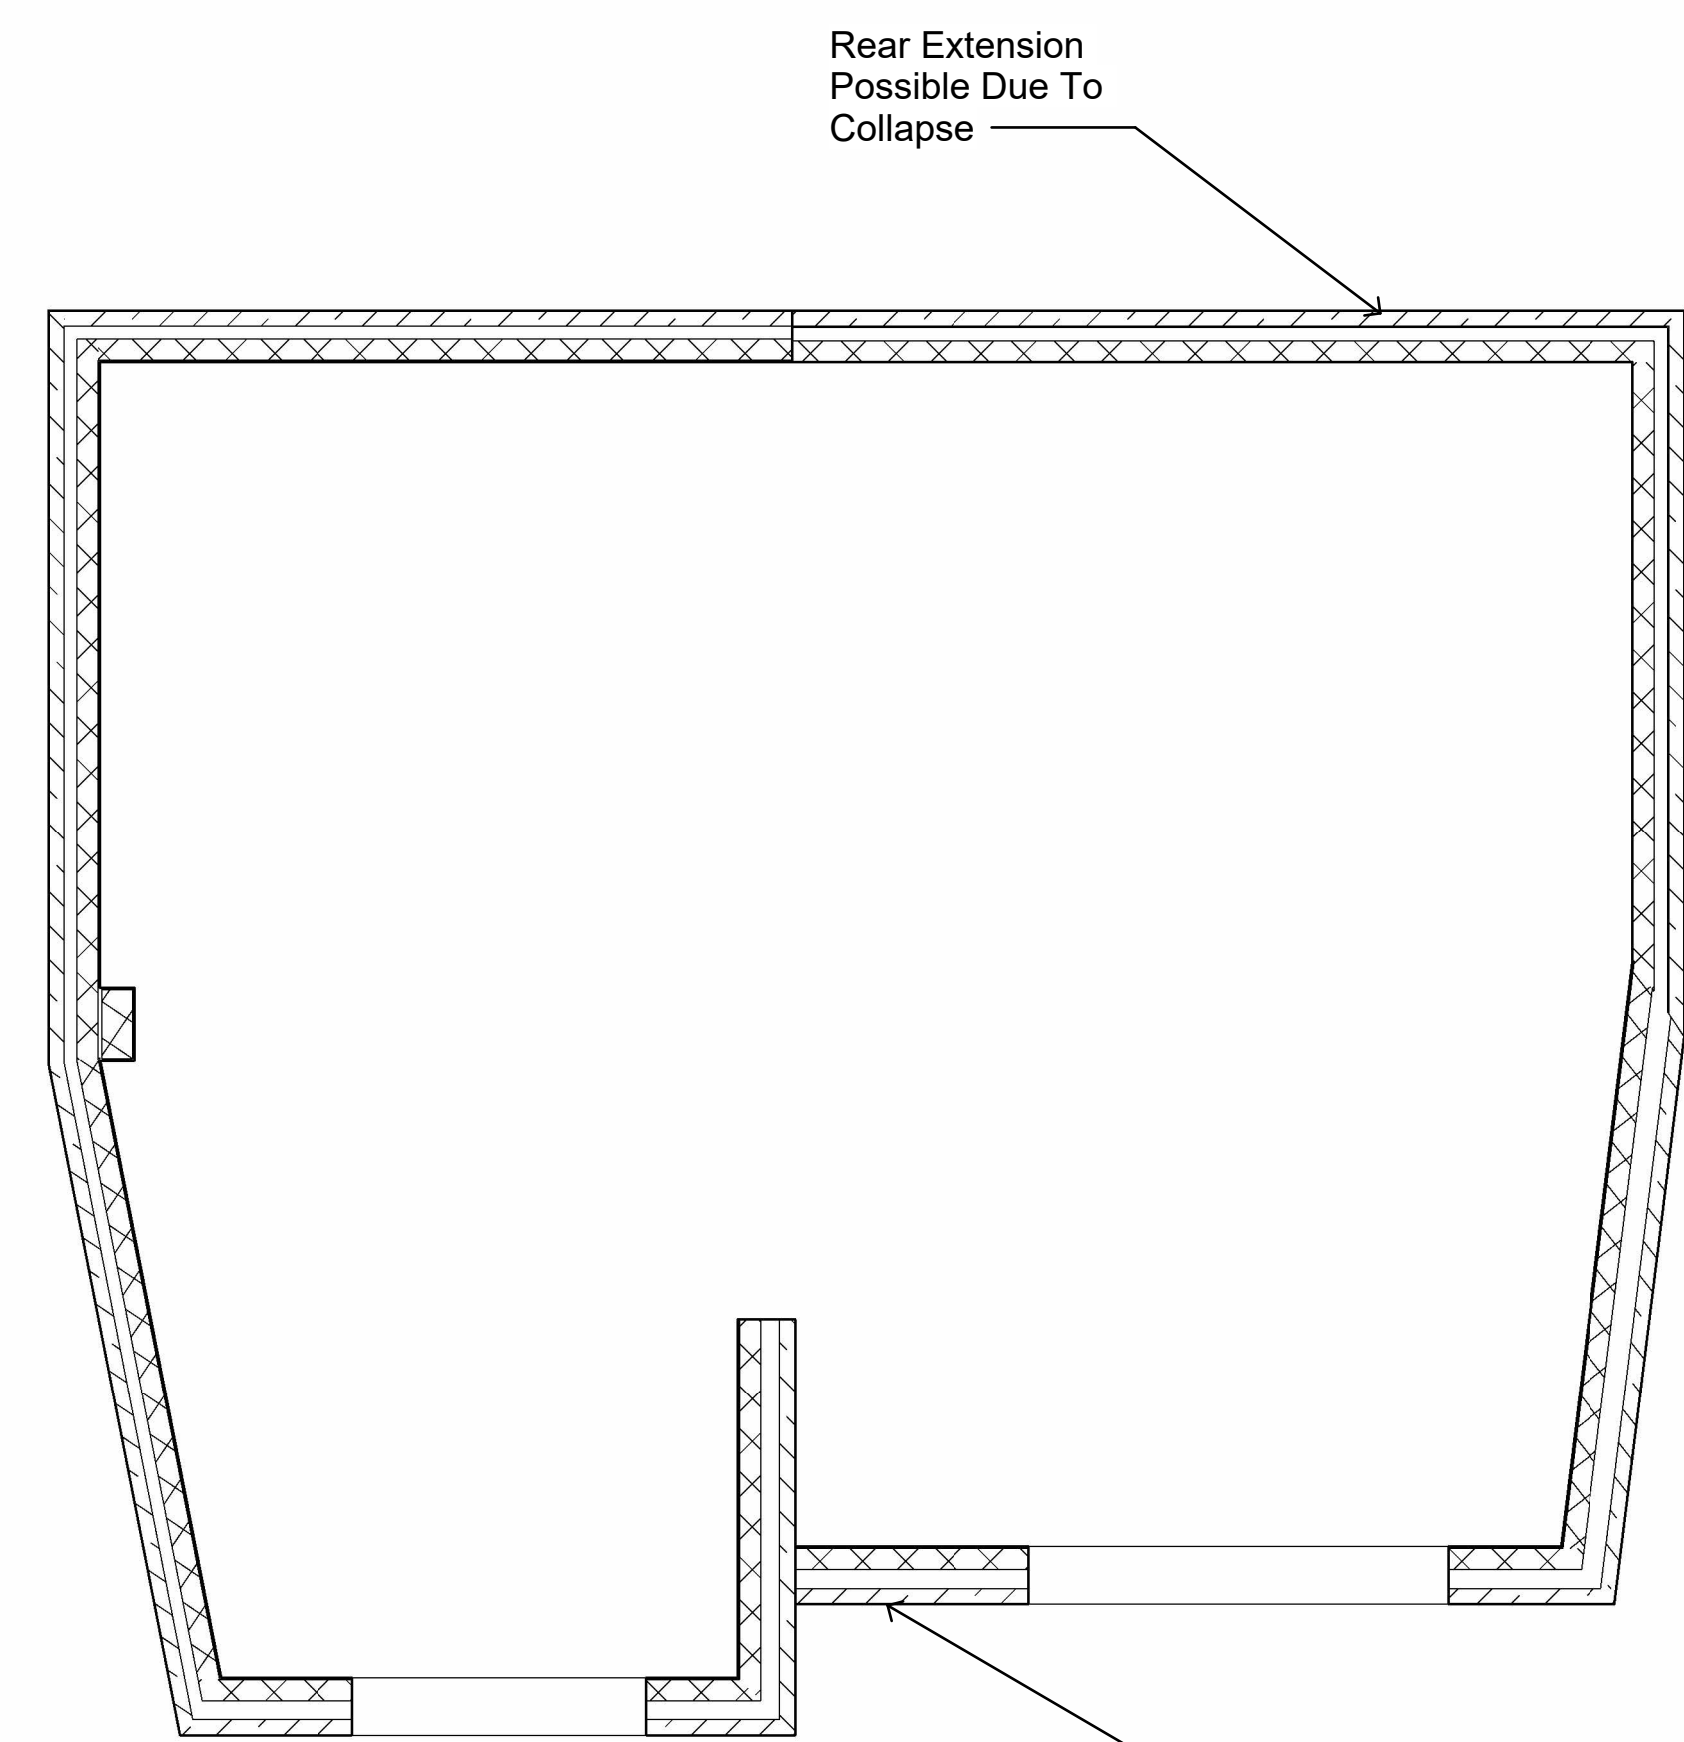


Existing Ground Floor Plan
1 : 50

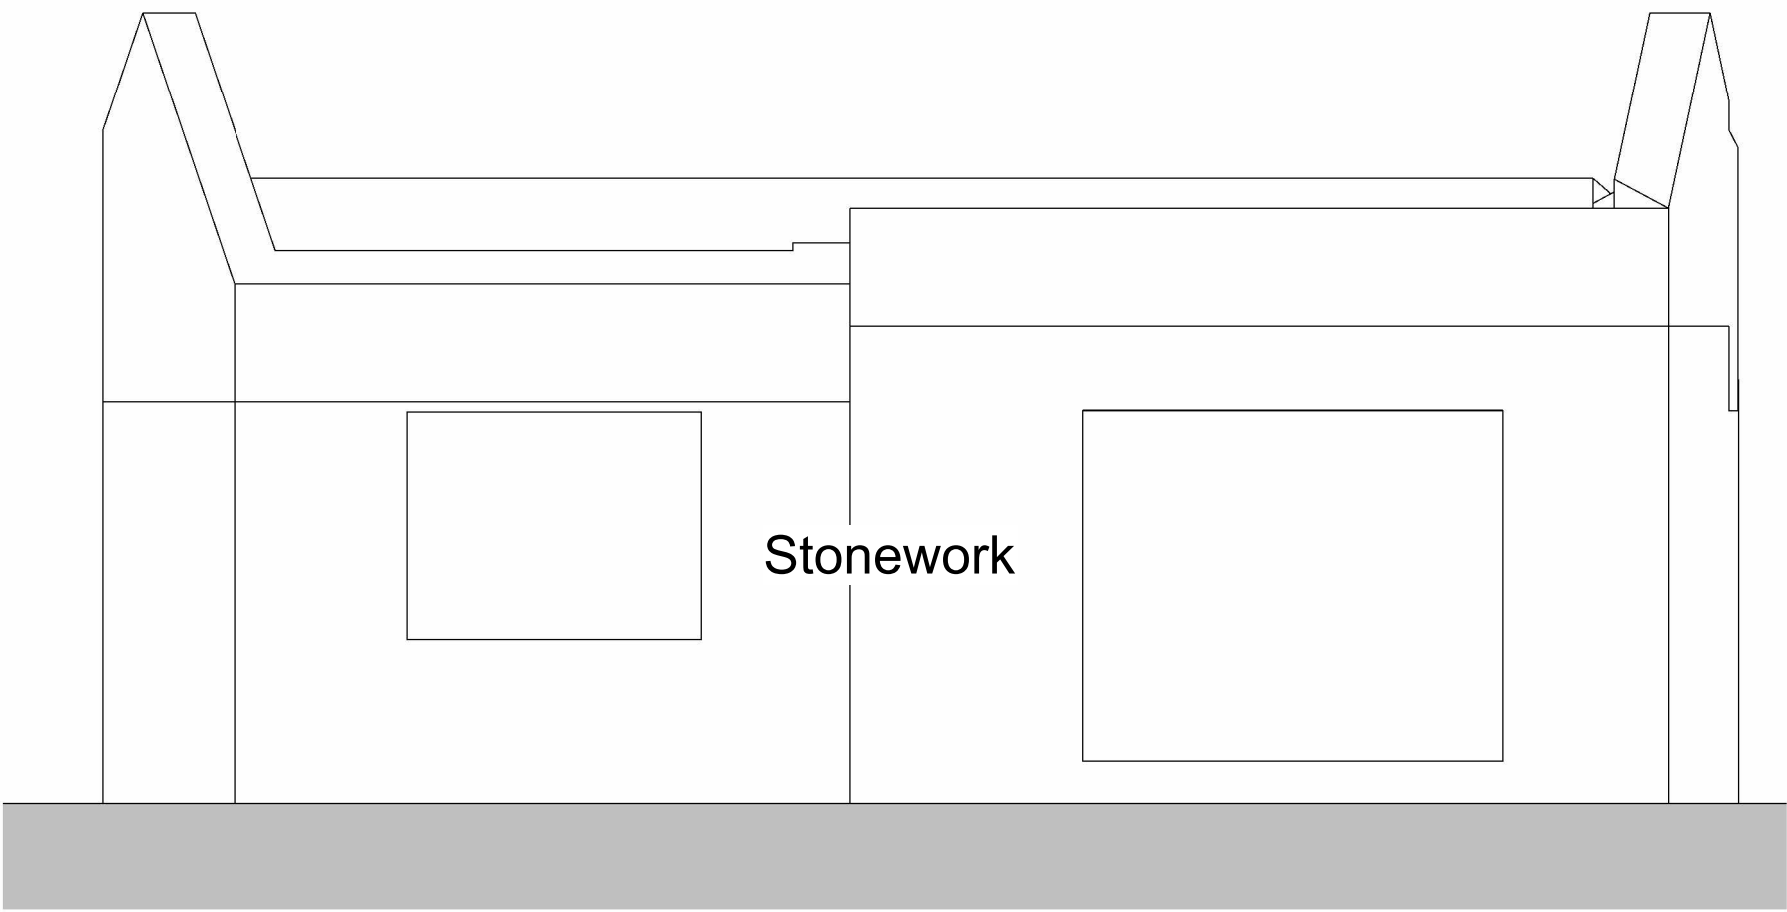


Existing South South West Elevation (Front)
1 : 50

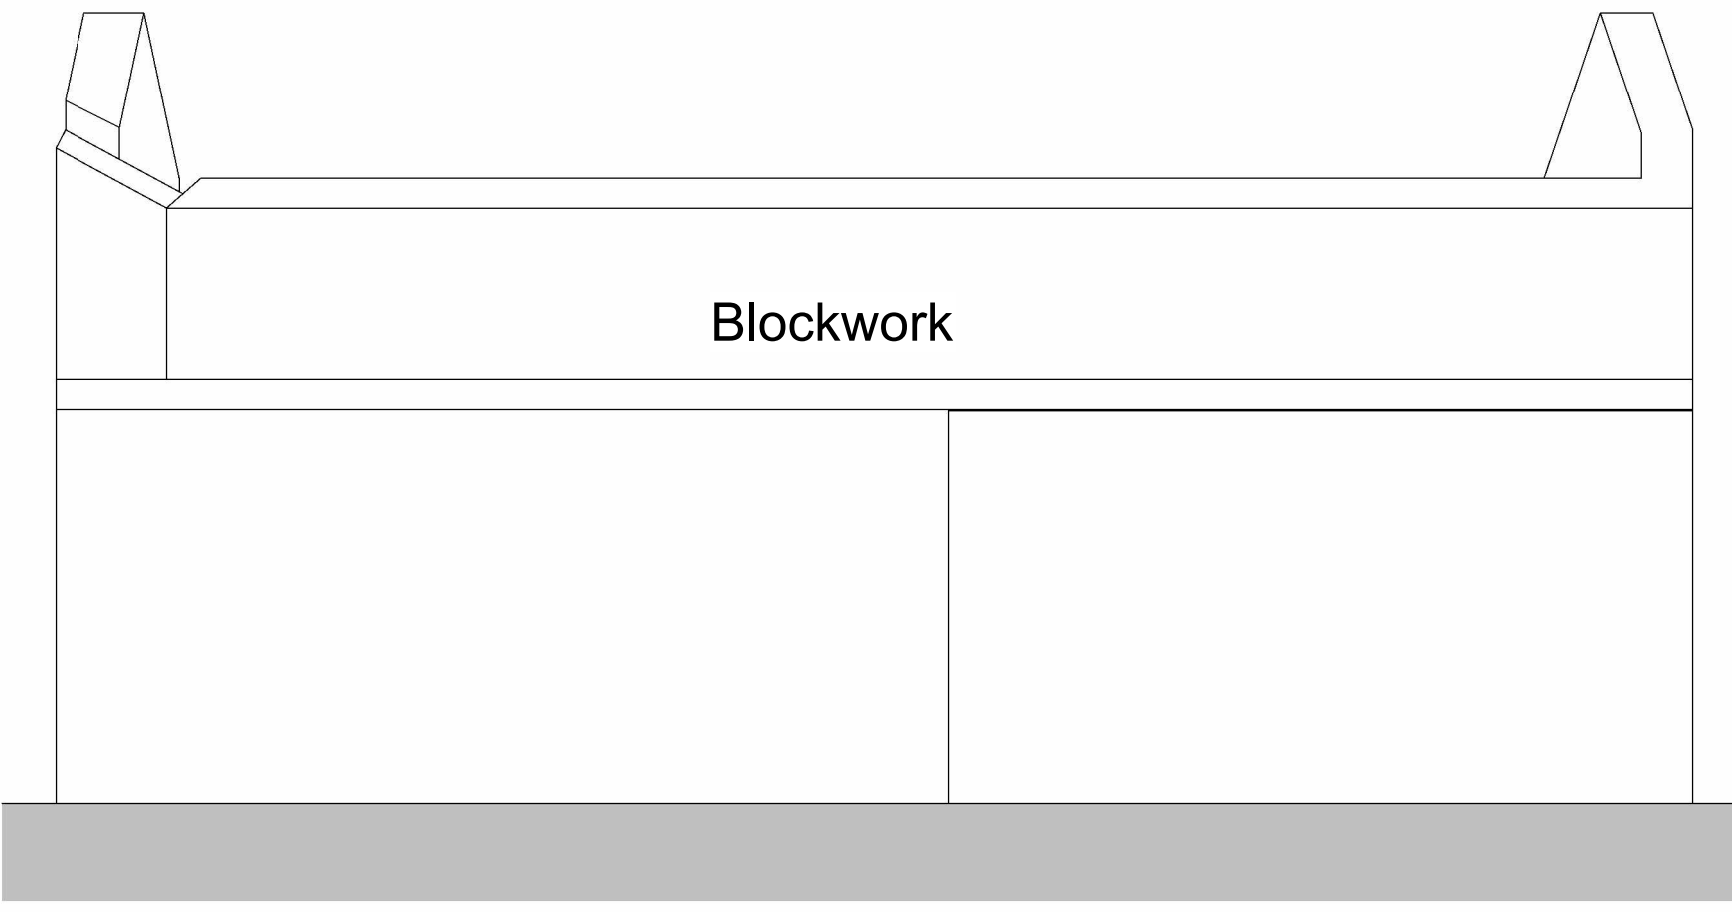


Existing North North East Elevation (Rear)
1 : 50

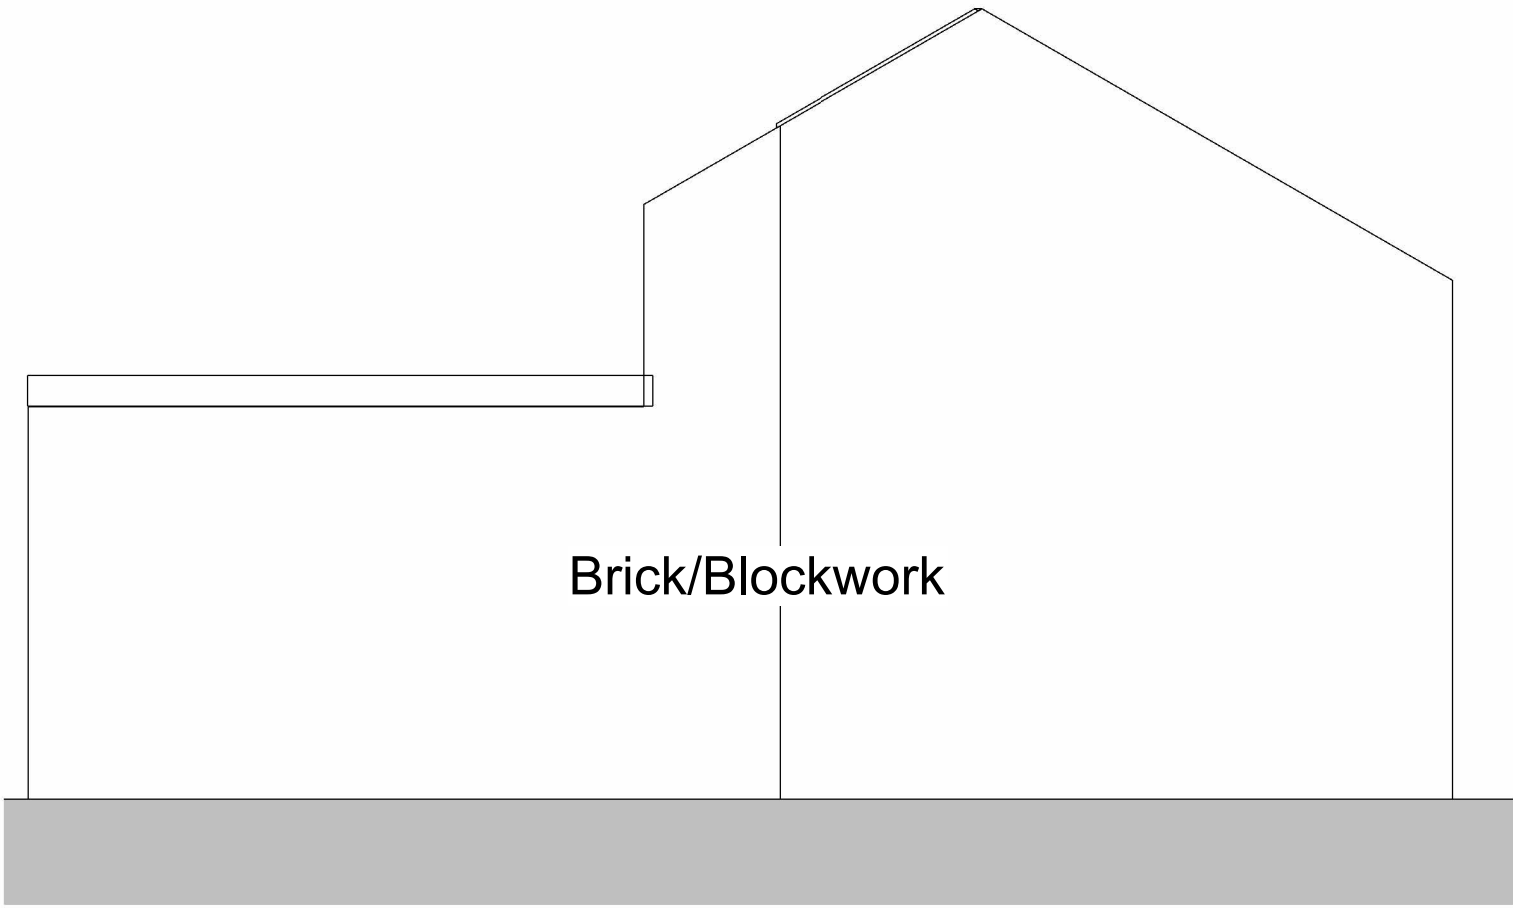

Existing West North West Elevation (Left)
1 : 50

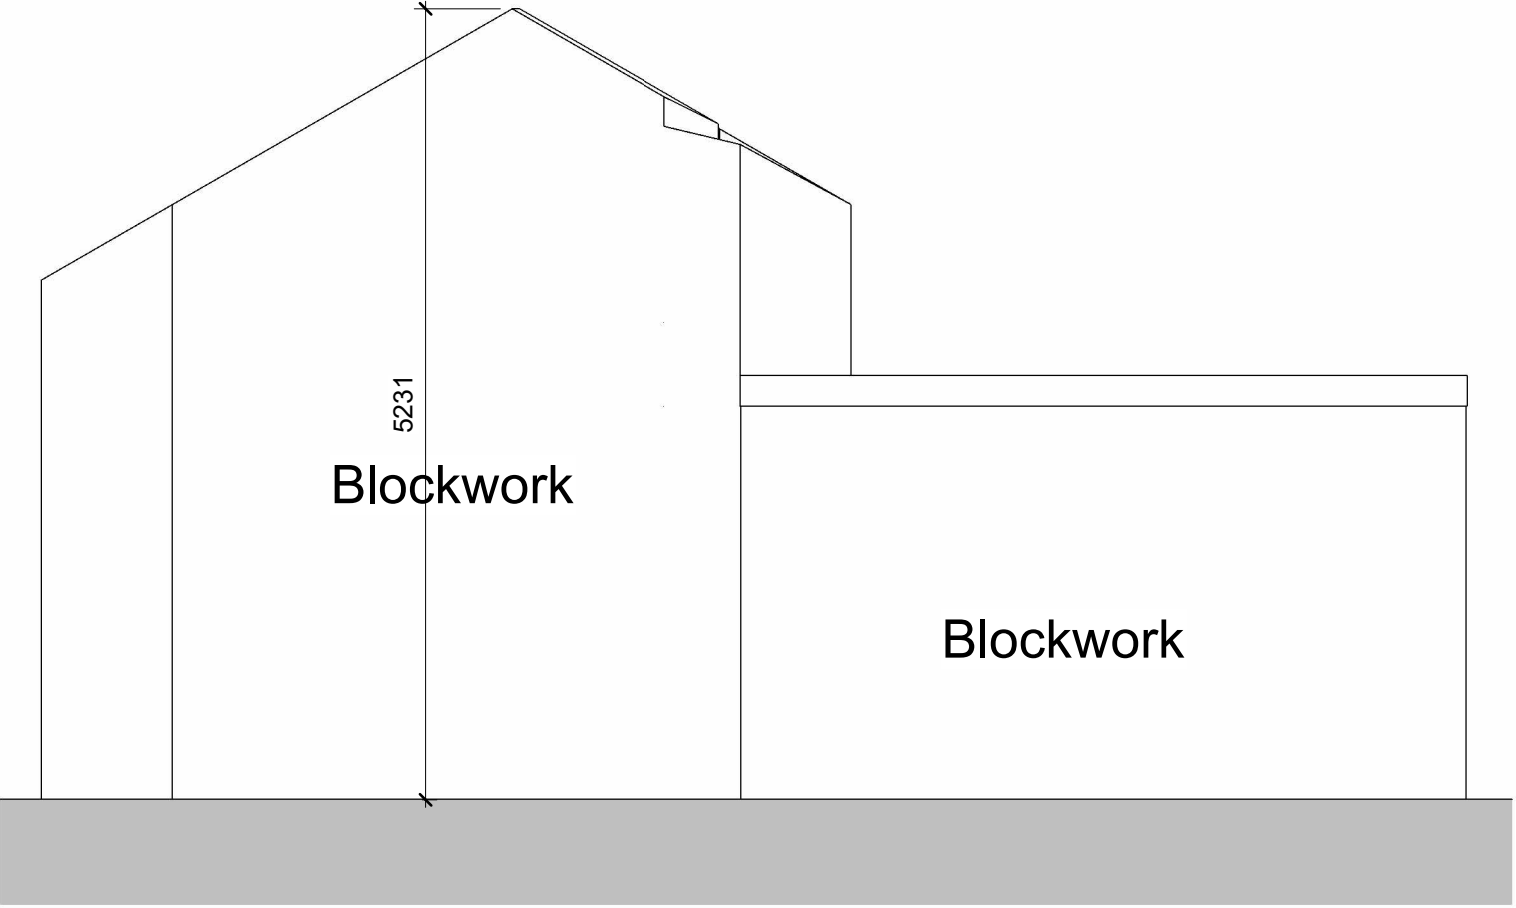

Existing East South East Elevation (Right)
1 : 50

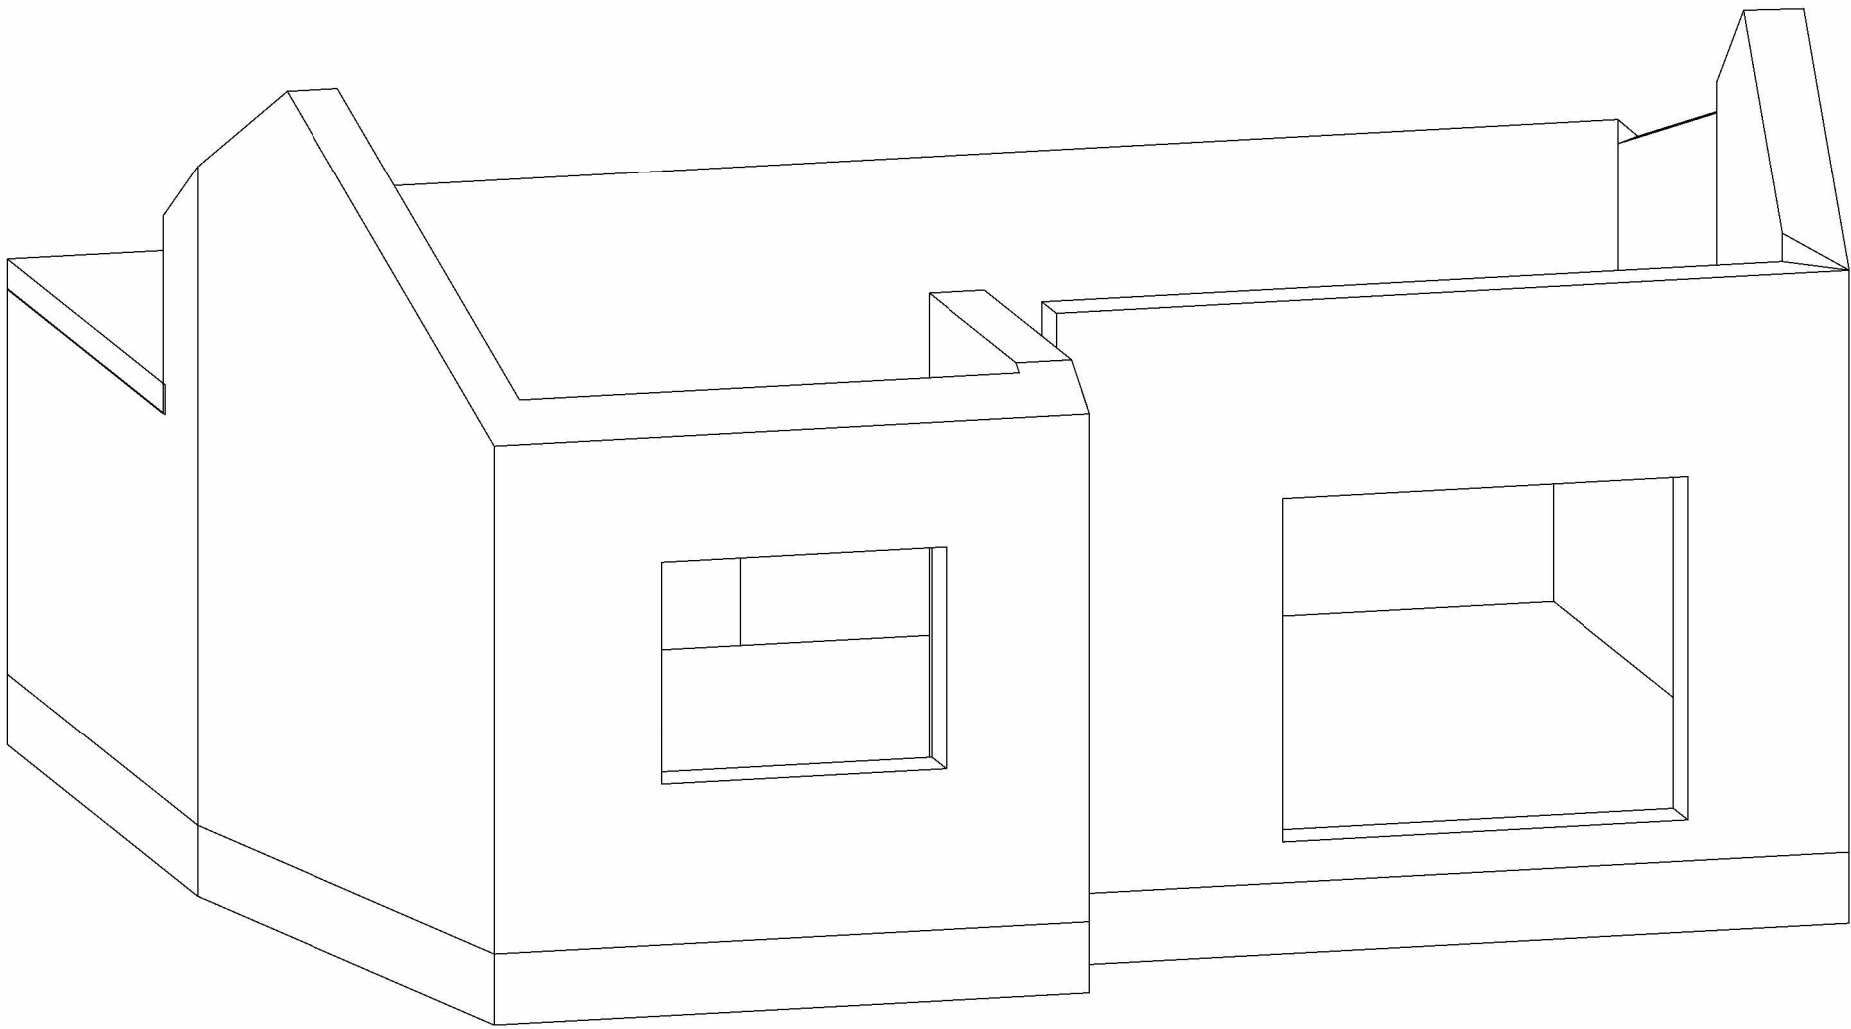

Existing 3D

Note:

All Dimensions Are Approximate
And TBC On Site By Contractor

<div><div></div><div>TREND ARCHITECTURE T: 01484 941051 plan@trendarchitecture.co.uk www.trendarchitecture.co.uk</div></div>	
Mohammed Yaseen 382 Huddersfield Rd, Mirfield WF14 9DL	
Drawing Title: Existing (As Built) Grouped Plans	
Drawing Number: TR-A25-0705-A5	Scale: 1 : 50@A1
Date: 19/10/26	Revision: D
Drawn By: AM	Checked by: JA
Reason For Issue: Planning	