


Percy Shaw House
Basement Plan

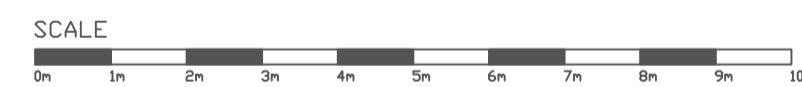

GIA: 686.75m²

GENERAL NOTES:

ALL DIMENSIONS ARE TO BE CHECKED ON SITE WITH ANY DISCREPANCIES REPORTED TO ESTATES AND FACILITIES DEPT PRIOR TO THE WORKS BEING CARRIED OUT.

ALL WORKS ARE TO BE IN ACCORDANCE WITH THE PLANNING APPROVAL AND ANY SUBSEQUENT APPROVED LOCAL AUTHORITY PLANNING CORRESPONDENCE INCLUDING DRAWINGS, DOCUMENTS AND REPORTS.

ALL WORKS ARE TO COMPLY WITH THE BUILDING REGULATIONS, BRITISH STANDARDS, CODE OF PRACTICE, AND ANY LOCAL STATUTORY REQUIREMENTS.

ALL WORKS ARE TO COMPLY WITH CURRENT HEALTH AND SAFETY LEGISLATION, H.S.E. RECOMMENDATIONS/GUIDANCE AND THE CURRENT C.D.M. REGULATIONS.

FOR ALL STRUCTURAL WORKS REFER TO THE STRUCTURAL ENGINEERS INFORMATION.

FOR ALL MECHANICAL AND ELECTRICAL WORKS REFER TO THE MECHANICAL AND ELECTRICAL ENGINEERS INFORMATION.

FOR ALL ABOVE GROUND DRAINAGE WORKS REFER TO THE PUBLIC HEALTH ENGINEERS INFORMATION.

ALL PRODUCTS SPECIFIED ARE TO BE INSTALLED STRICTLY IN ACCORDANCE WITH THE MANUFACTURERS RECOMMENDATIONS, SPECIFICATION AND DETAILS.

AS BUILT

REV	DESCRIPTION	DATE	BY	CHKD
A	REVISION NOTE	13.03.25		

DO NOT SCALE OFF THIS DRAWING

University of
HUDDERSFIELD
Inspiring global professionals

estates@hud.ac.uk | www.hud.ac.uk
Queensgate Huddersfield HD1 3DH
Huddersfield:
01484 472351

client
UNIVERSITY of HUDDERSFIELD

project
MASTER DRAWING

project no	drawing no	rev
	PC-00	A

description
**PERCY SHAW HOUSE
BASEMENT FLOOR**

scale	date drawn	drawn by	authorized by
1:100@ A1	13.03.25	AS	MW

purpose of issue
planning building regs tender comment approval construction