




AS BUILT GROUND FLOOR PLAN, 1:100

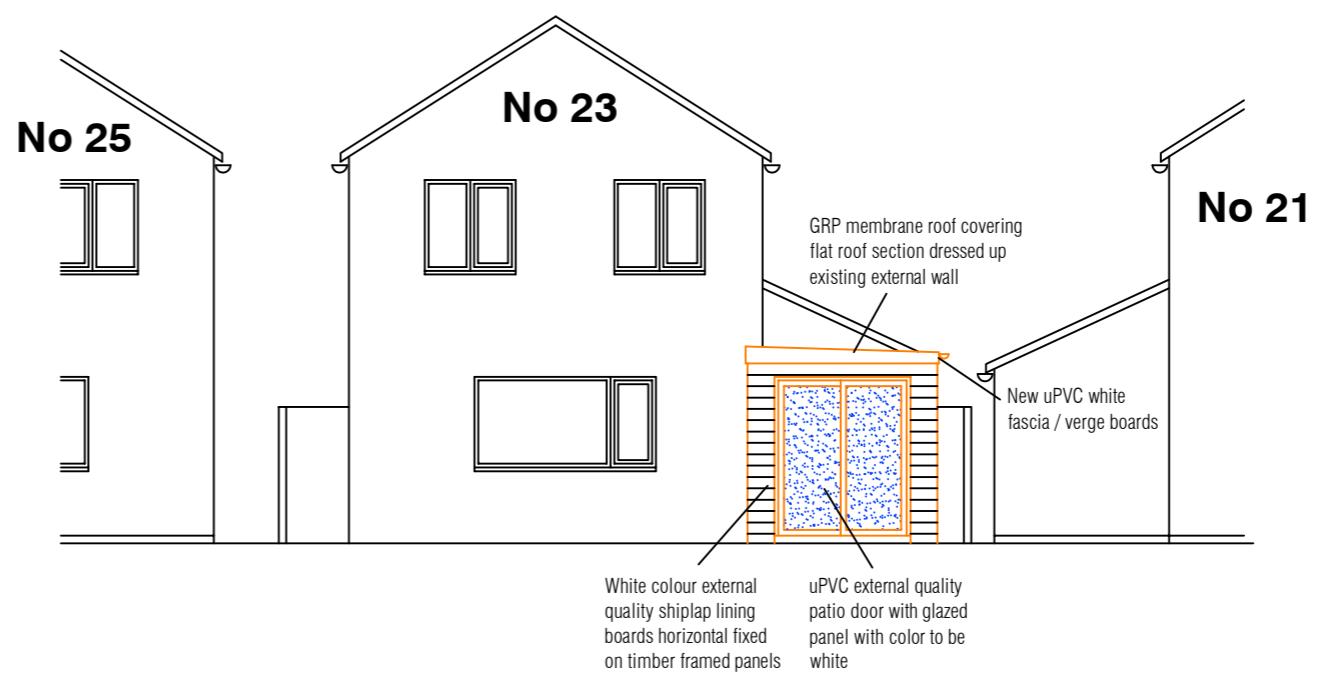

AS BUILT REAR ELEVATION, 1:100

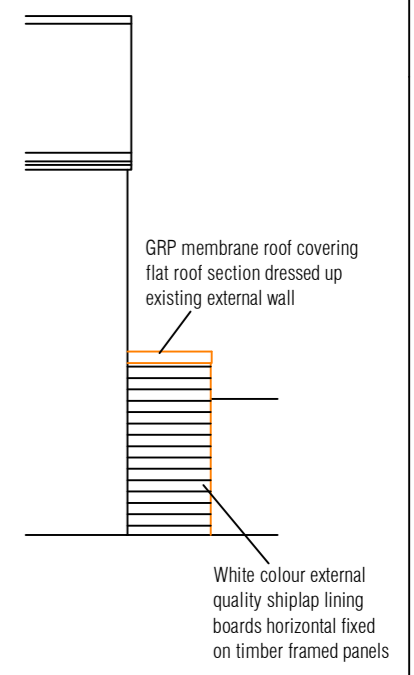

AS BUILT SIDE ELEVATION, 1:100

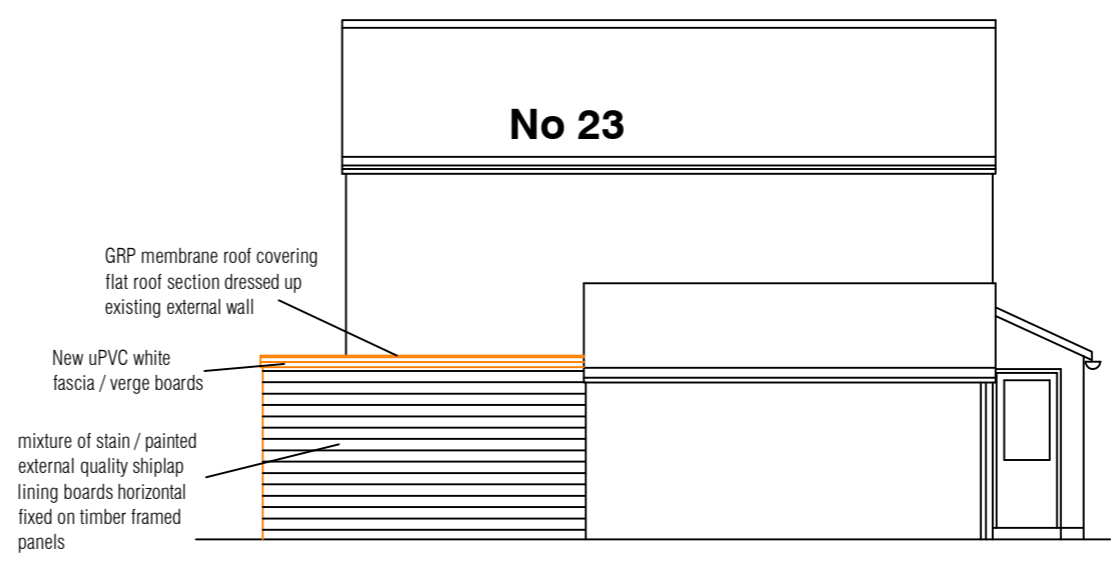

AS BUILT SIDE ELEVATION, 1:100

STUDIO CHARRETTE
 A: The Clubhouse, 50 Grosvenor Hill, London, W1K 3QT
 W: www.studiocharrette.co.uk

Client
 Joseph Bell

Project Title
 23 South Street, Oakenshaw,
 Bradford BD12 7DJ

Drawing Title
 Certificate of Lawfulness for rear / side extension
 As built floor and elevations

Drawing No. SC / 26 / 641 - 201	Rev
Scale 1:100 @ A3	Date May 2026
Created By A Mc	Planning
Check By	Building Control
	Client
	Sketch
	Information

This drawing and the copyright, design rights and all other intellectual property rights in it belong to Studio Charrette Ltd. No licence or assignment of any such rights is granted hereunder. This drawing is not to be copied or divulged to a third party without written permission.