



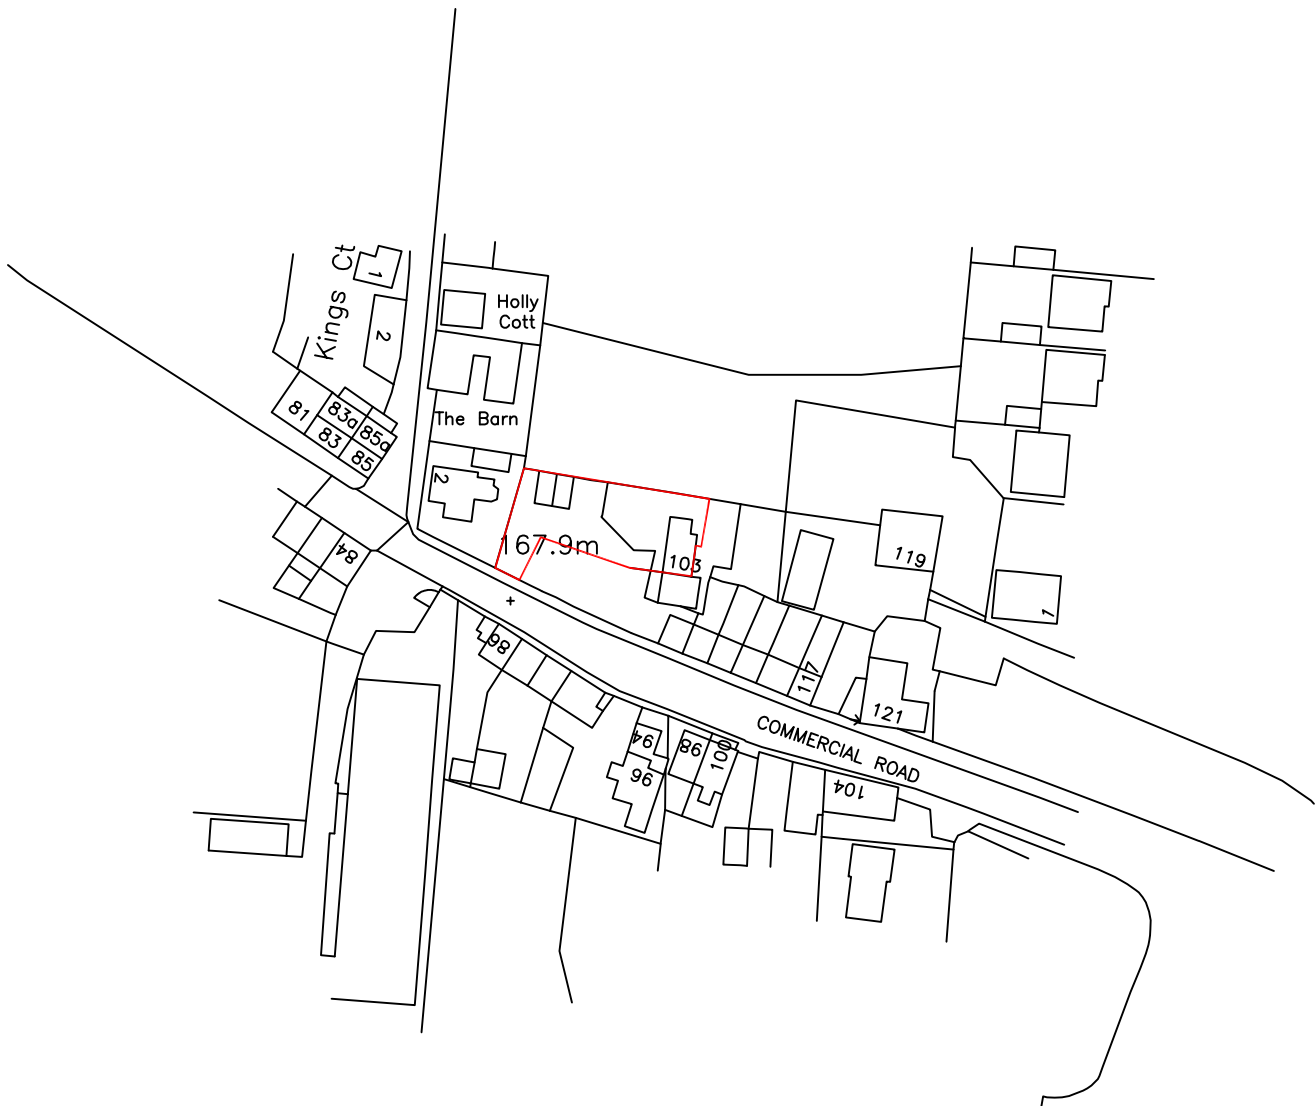

A 19/06/2026 Redline Boundary amended at Planners request

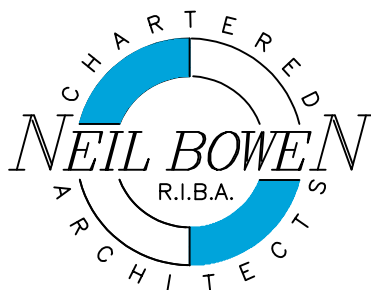

Office F7
Flexspace
Monckton Road
Wakefield, WF2 7AS
Email : neil@neilbowenarchitects.co.uk
Phone : 01924 380873

Date 16/06/2026

A4

Project

103 Commercial Road,, Skelmanthorpe HD8 9DX

Drawing
Ordnance Survey Plan

2615	Scale
R A	1:1250
Drg No 3	

Drg No

