



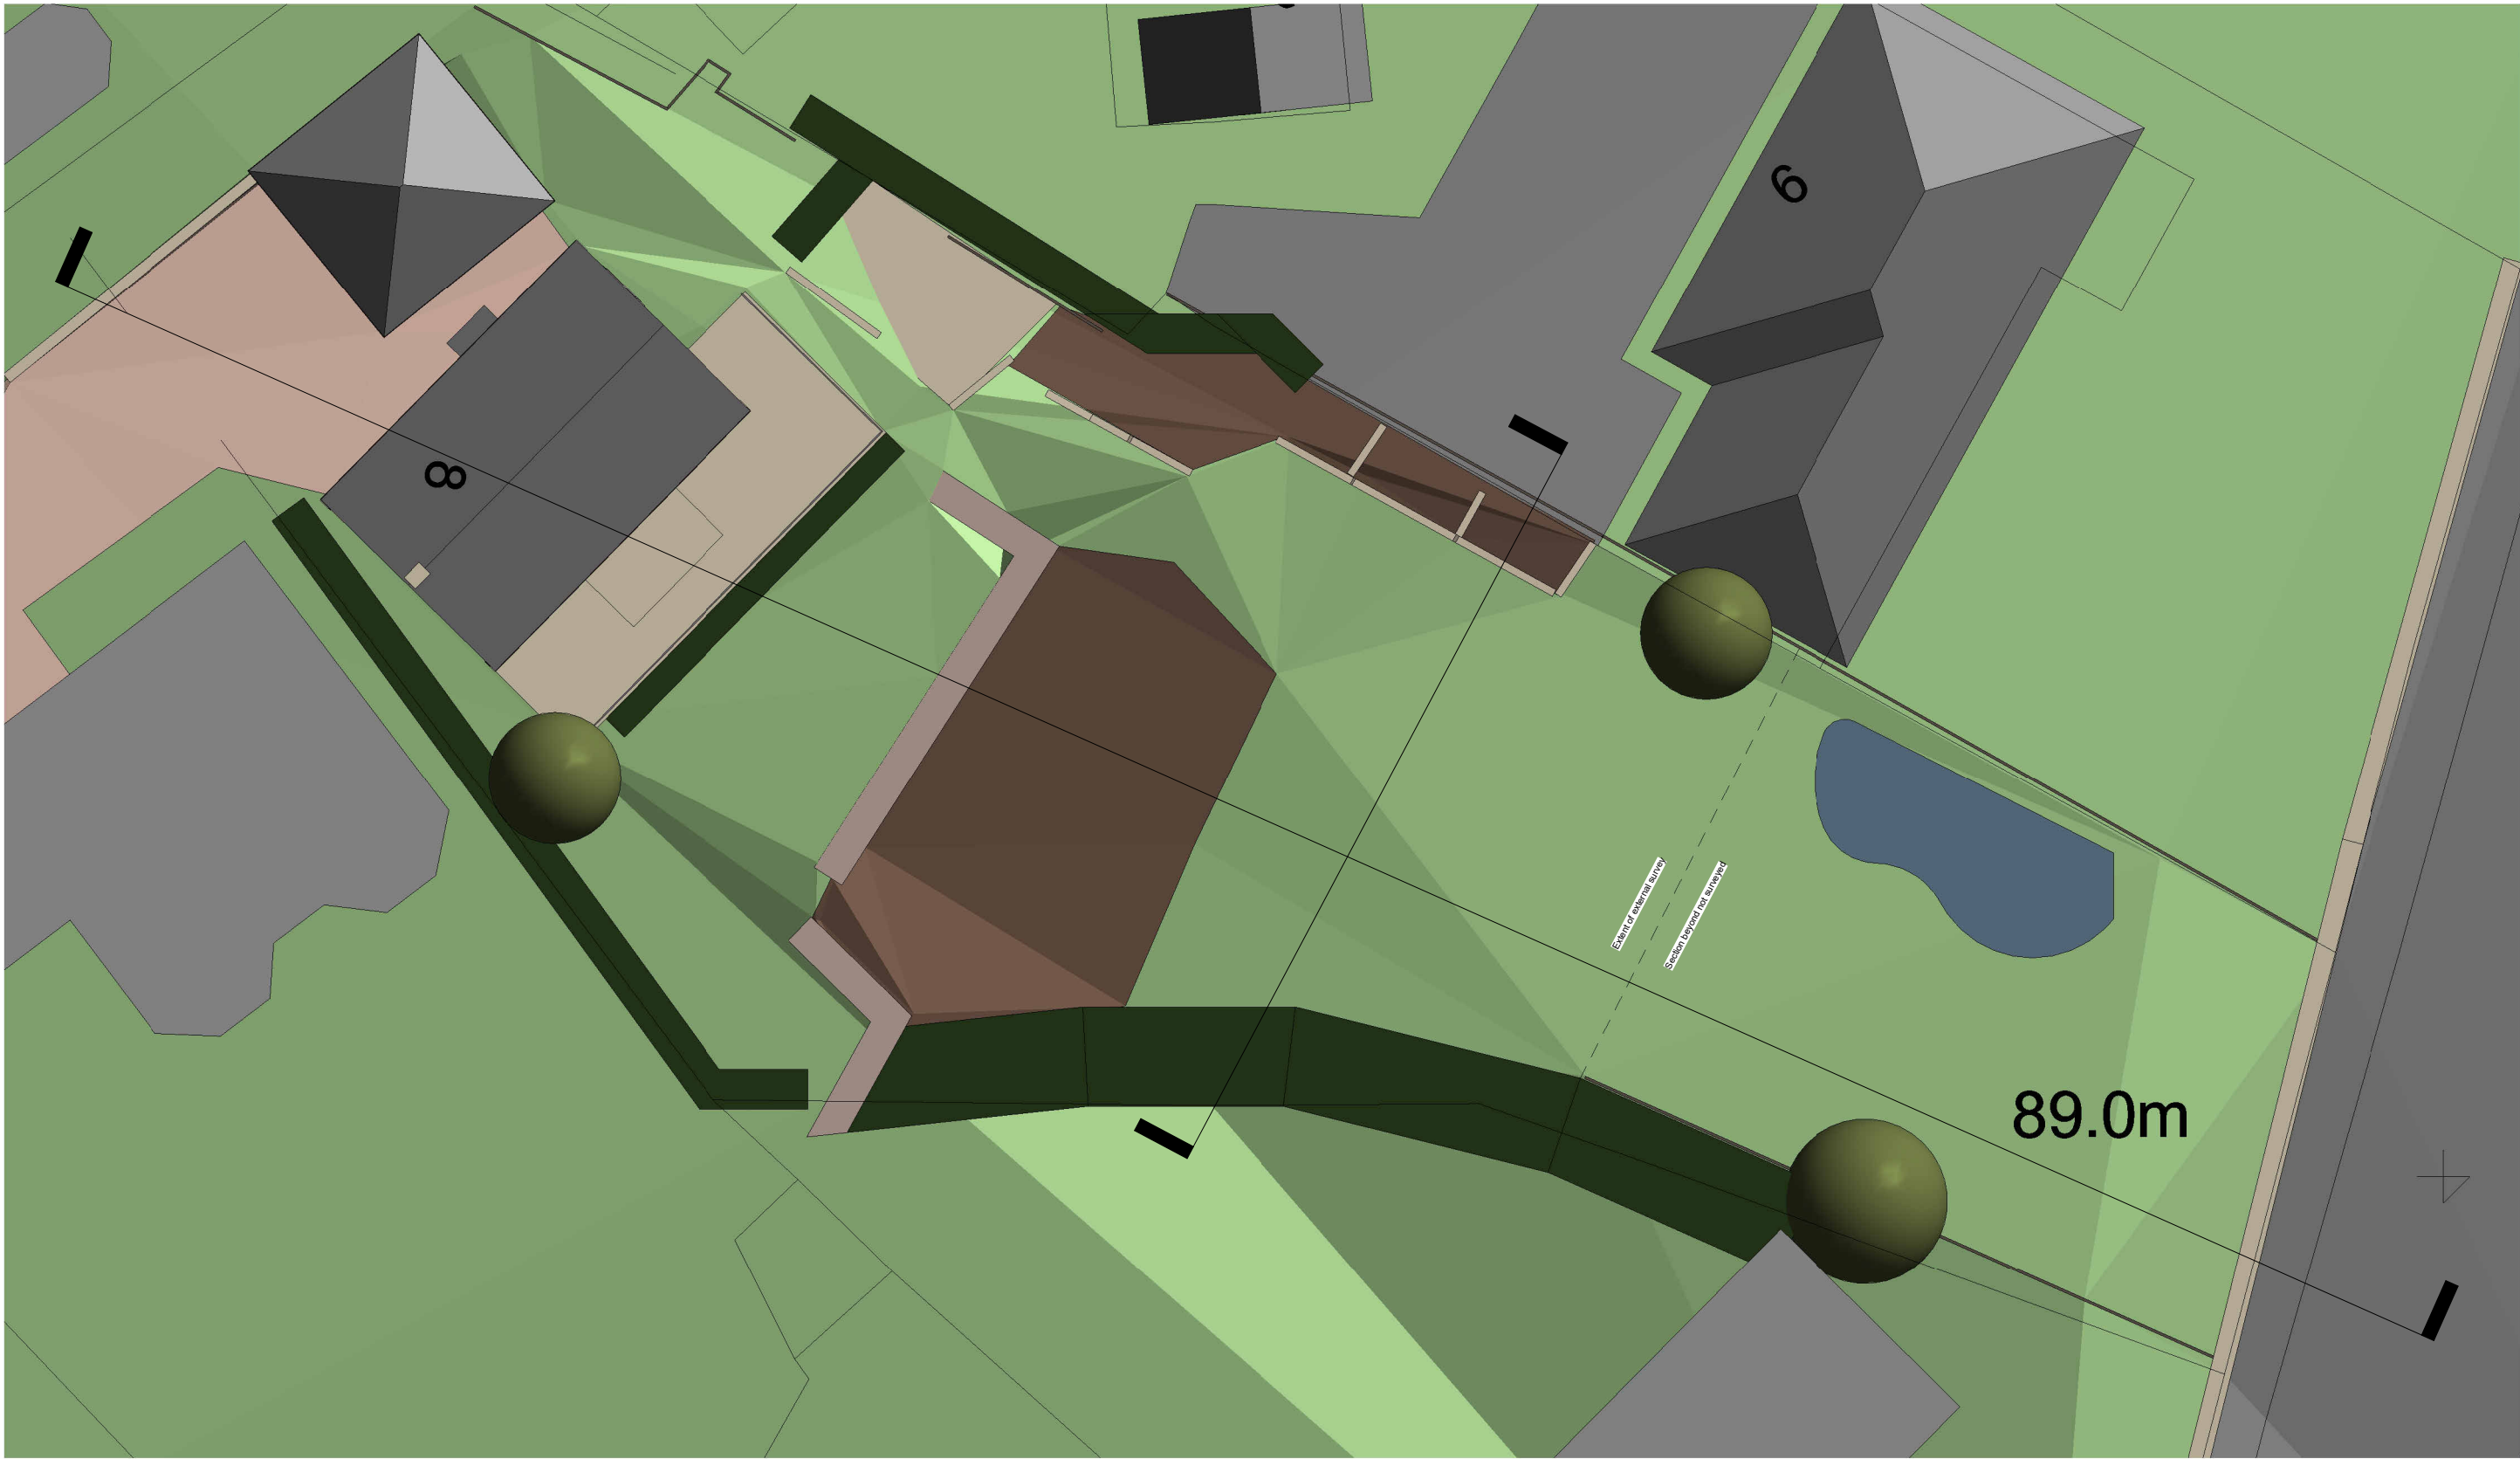

PROPOSED (AS BUILT) SITE PLAN
1:200

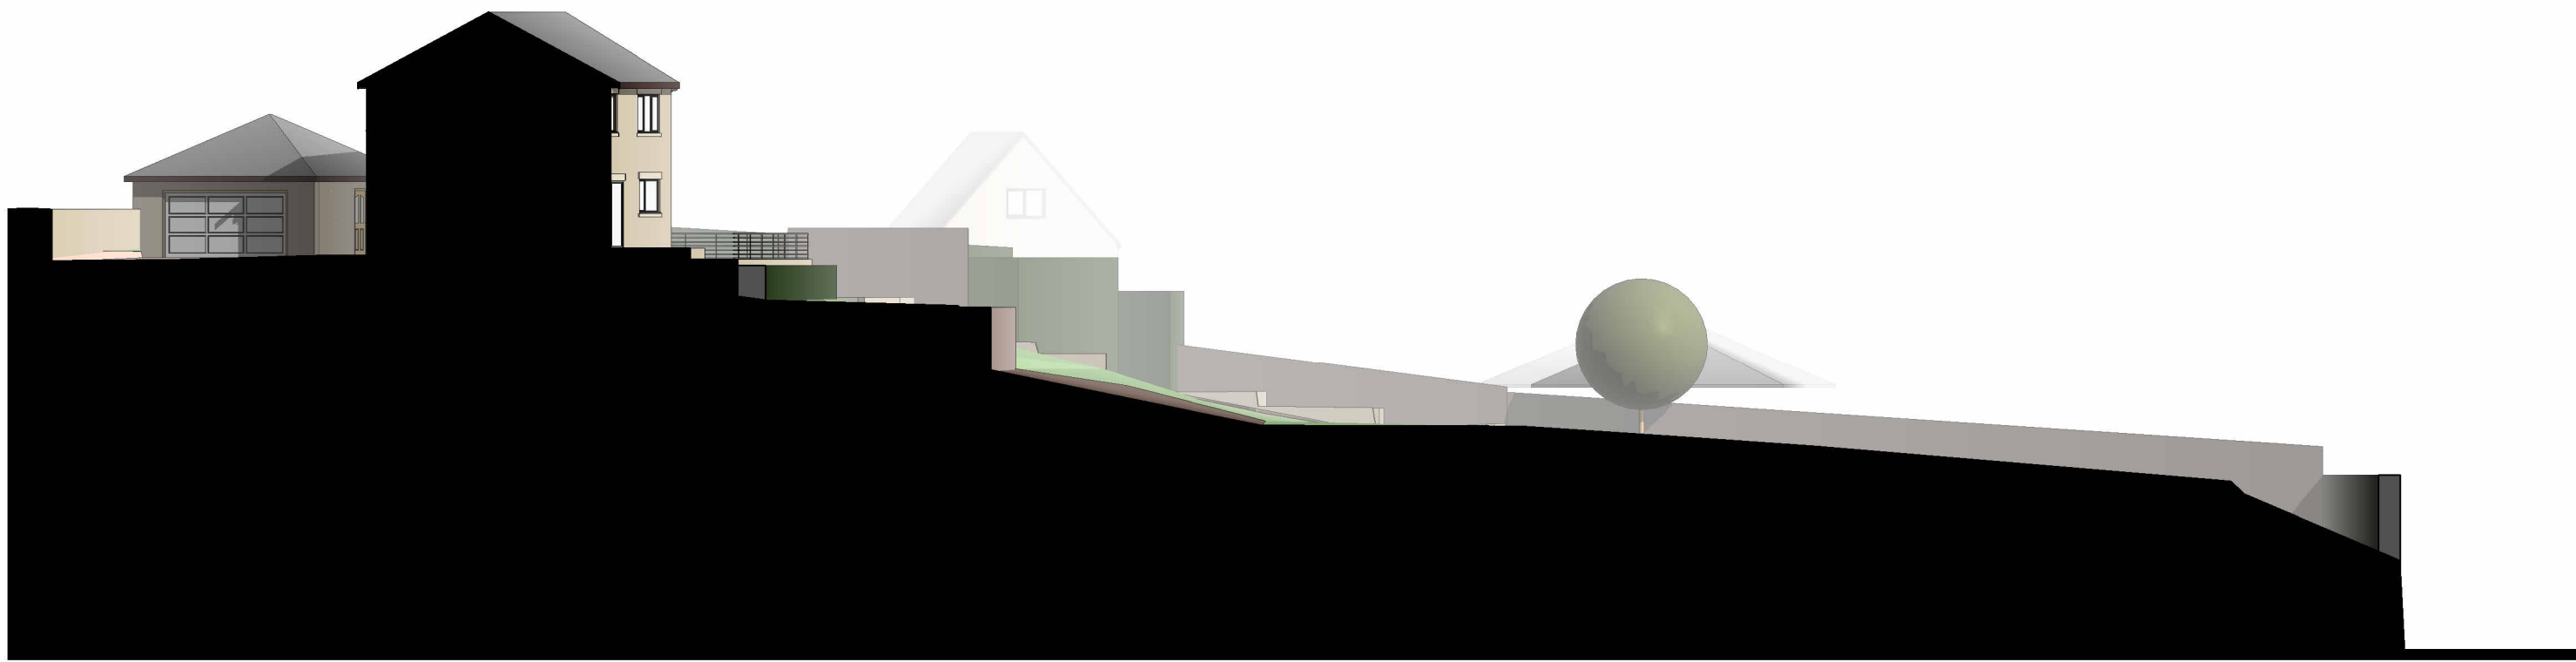

PROPOSED (AS BUILT) LONG SITE SECTION
1:200



PROPOSED (AS BUILT) SHORT SITE SECTION
1:200

PO	Drawing originated for comment	JF	15.06.26
Rev No.	Description	Drawn:	Date



Client
Mr C Smith

Project
8 St Pauls Road, Kirkheaton

Drawing Title
Proposed (As Built) Site Plan & Sections

Drawing No	Rev No
2026141-103	PO
Scale	Date Drawn
1 : 200	@ A1 Jun'26
Purpose of Issue	Drawn By
Planning	JF