

This drawing incorporates the information last issued for construction under the building contract. This drawing has not been verified by dimensional survey and allowable construction tolerances may have resulted in differences between this drawing and the finished building. The composition of materials indicated on this drawing has not been checked. Do not scale from this drawing for construction or acquisition purposes. Responsibility is not accepted for errors made by others in scaling from this drawing. All construction information must be taken from figured dimensions only. All dimensions and levels must be checked on site and discrepancies between drawings and specification must be reported to GSSArchitecture. © Copyright GSSArchitecture. Ordnance Survey © Crown Copyright 2026. All rights reserved. Licence number GSS 100017356. Map Data Copyright 2026 Google. Registered Office: 35 Headlands, Kettering, Northants, NN15 7ES. Tel: 01536 513 165. Email: studio@gssarchitecture.com

Key Plan

Legend

C2	12/02/26	HXM	CJPW	Record Drawing Issue
C1	21/11/25	CJPW	ADP	Construction Issue
P04	19/08/25	HXM	ADP	Stage 04- Issued for Listed building Consent
P03	16/05/25	TP	CJPW	Stage 04 - First Issue
P02	04/10/24	CJPW	ADP	Stage 03 Issue
P01	20/09/24	CJPW	ADP	Issued for Listed Building Consent

Rev	Date	Drn	Chk	Description
-----	------	-----	-----	-------------



GSSarchitecture
KETTERING | GLOUCESTER | HARROGATE | LEEDS | MILTON KEYNES | NEWCASTLE

Project Title:
Ramsden Building

Client:
University of Huddersfield

Drawing Title:
Proposed Site Plan

Drawn By: HXM	Checked By: CJPW	Scale @A1: 1 : 200	Date: 06/03/24
Document Status: Record Drawing			Project No: UNI049D
Drawg No: UHRAM-GSS-XX-00-DR-A-90003			Rev: C2

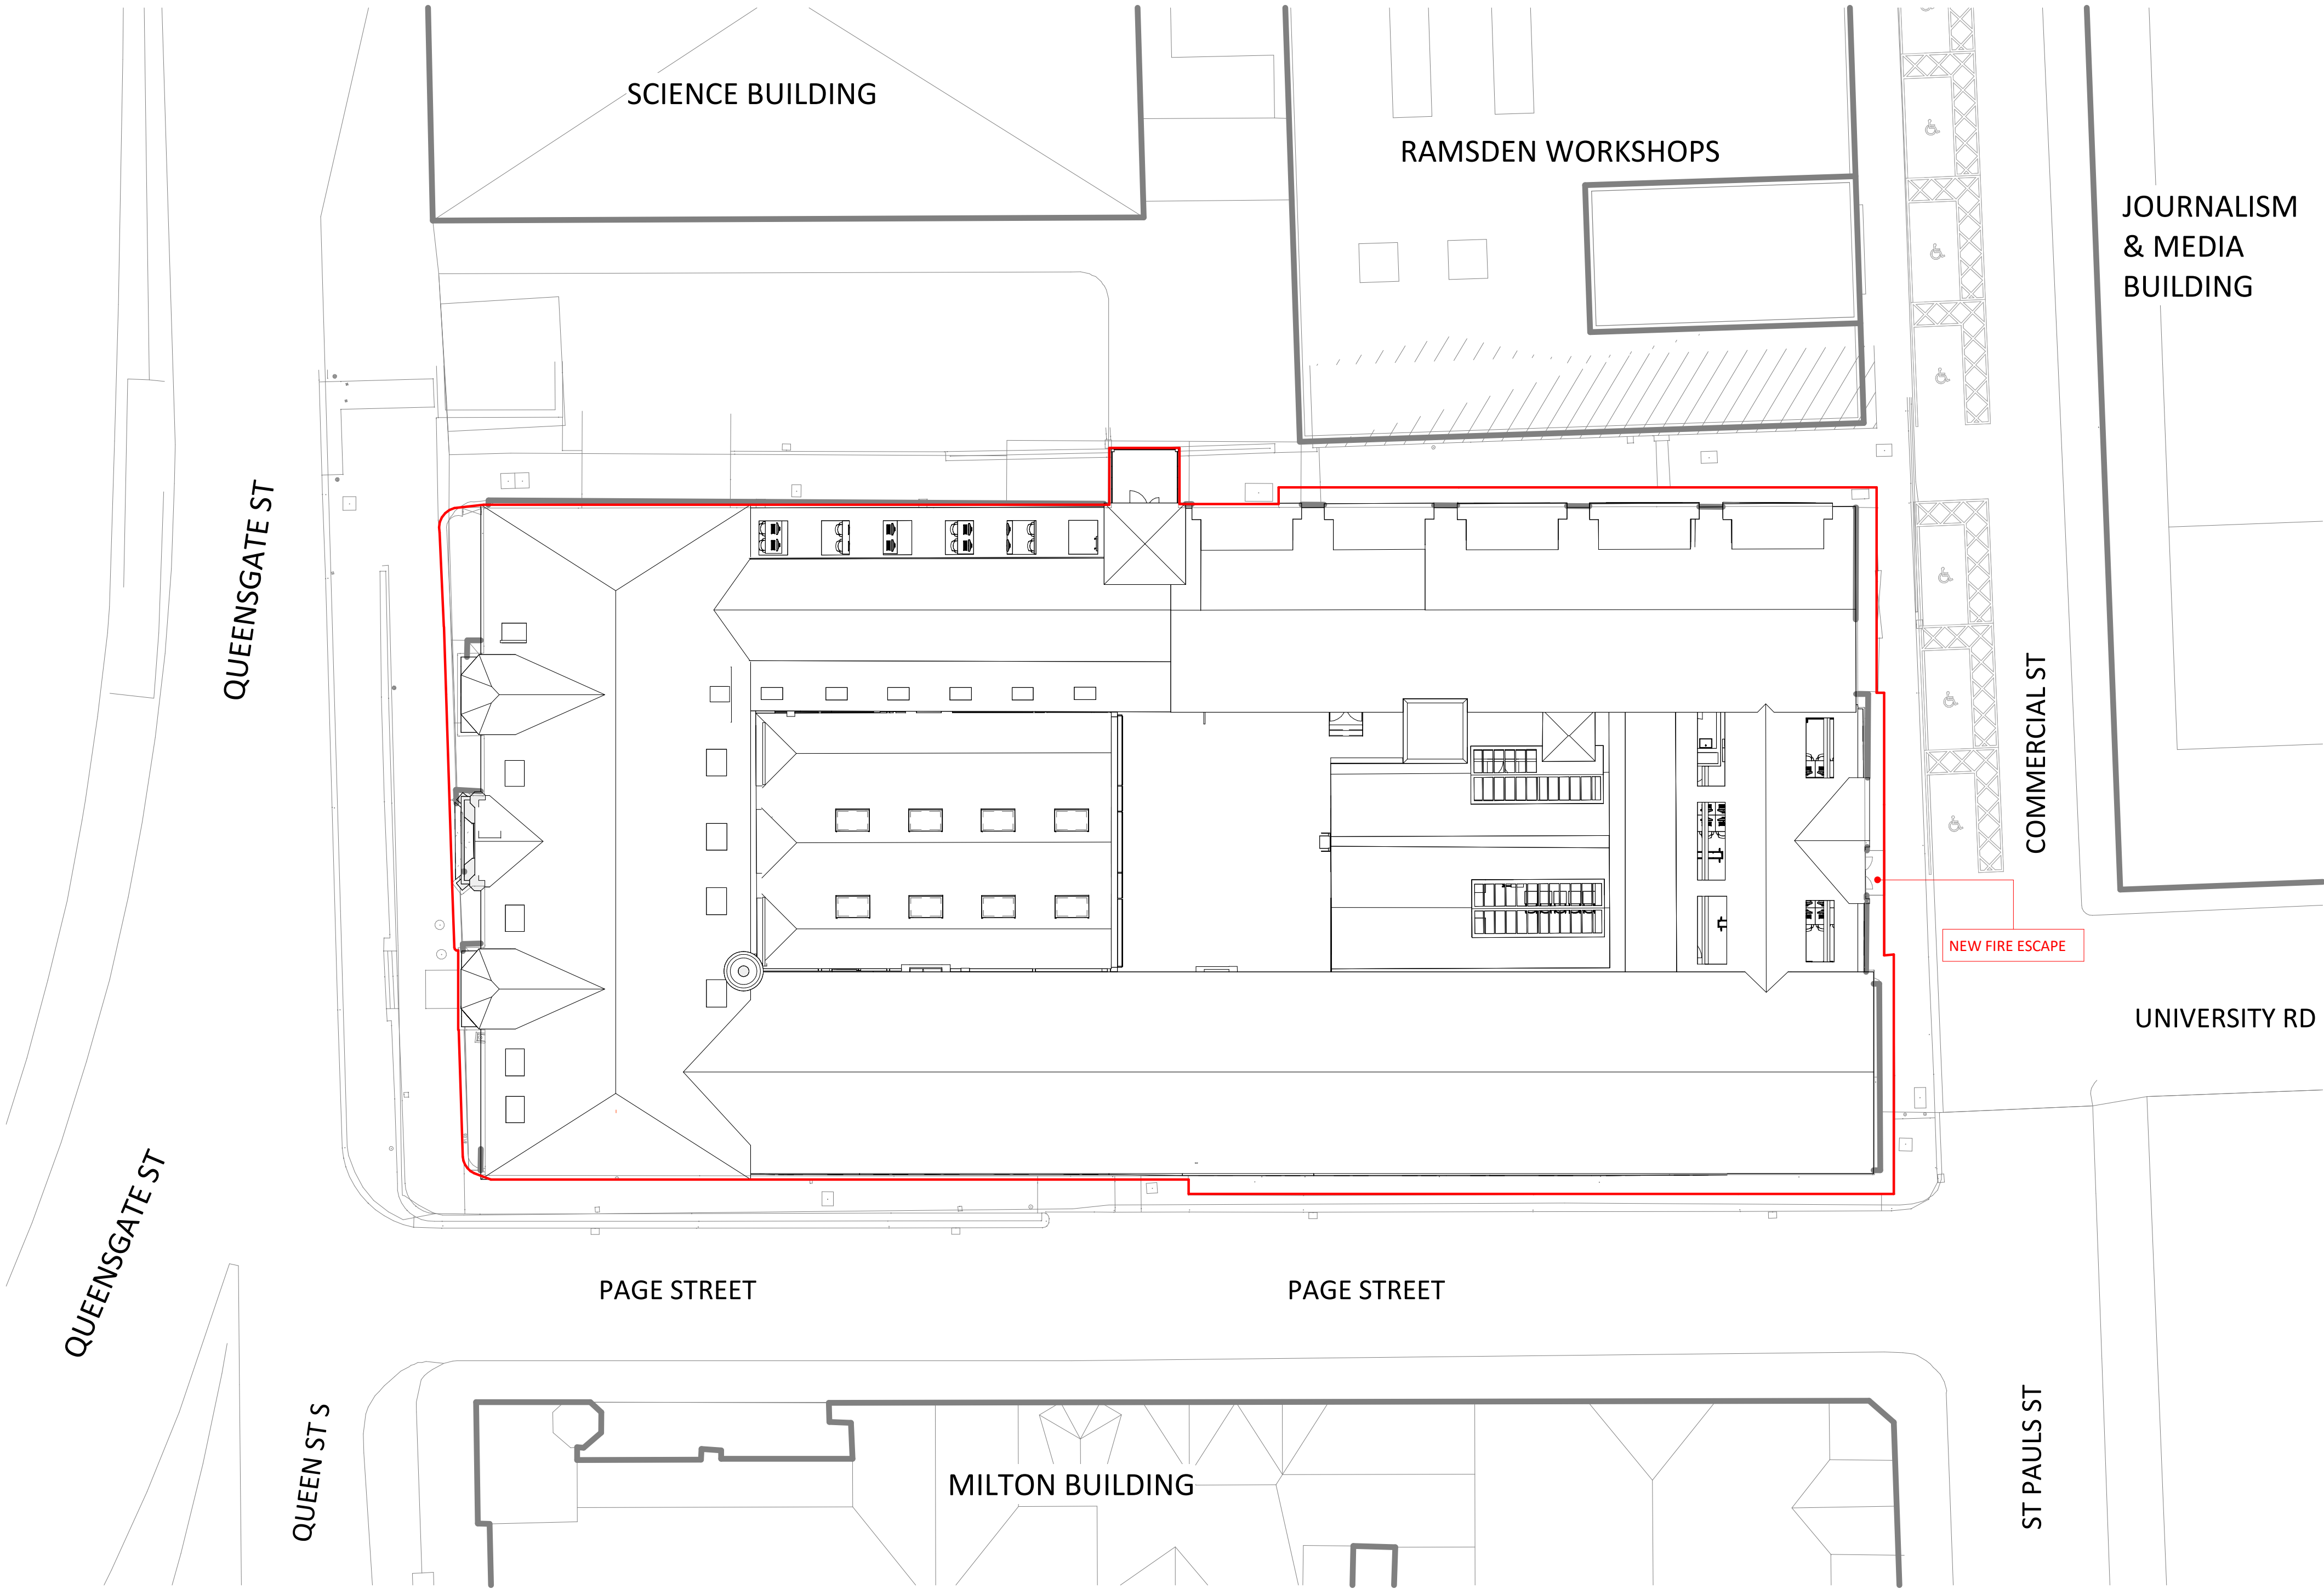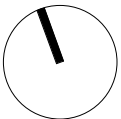

1. Proposed Site Plan
SCALE - 1 : 200@A1