

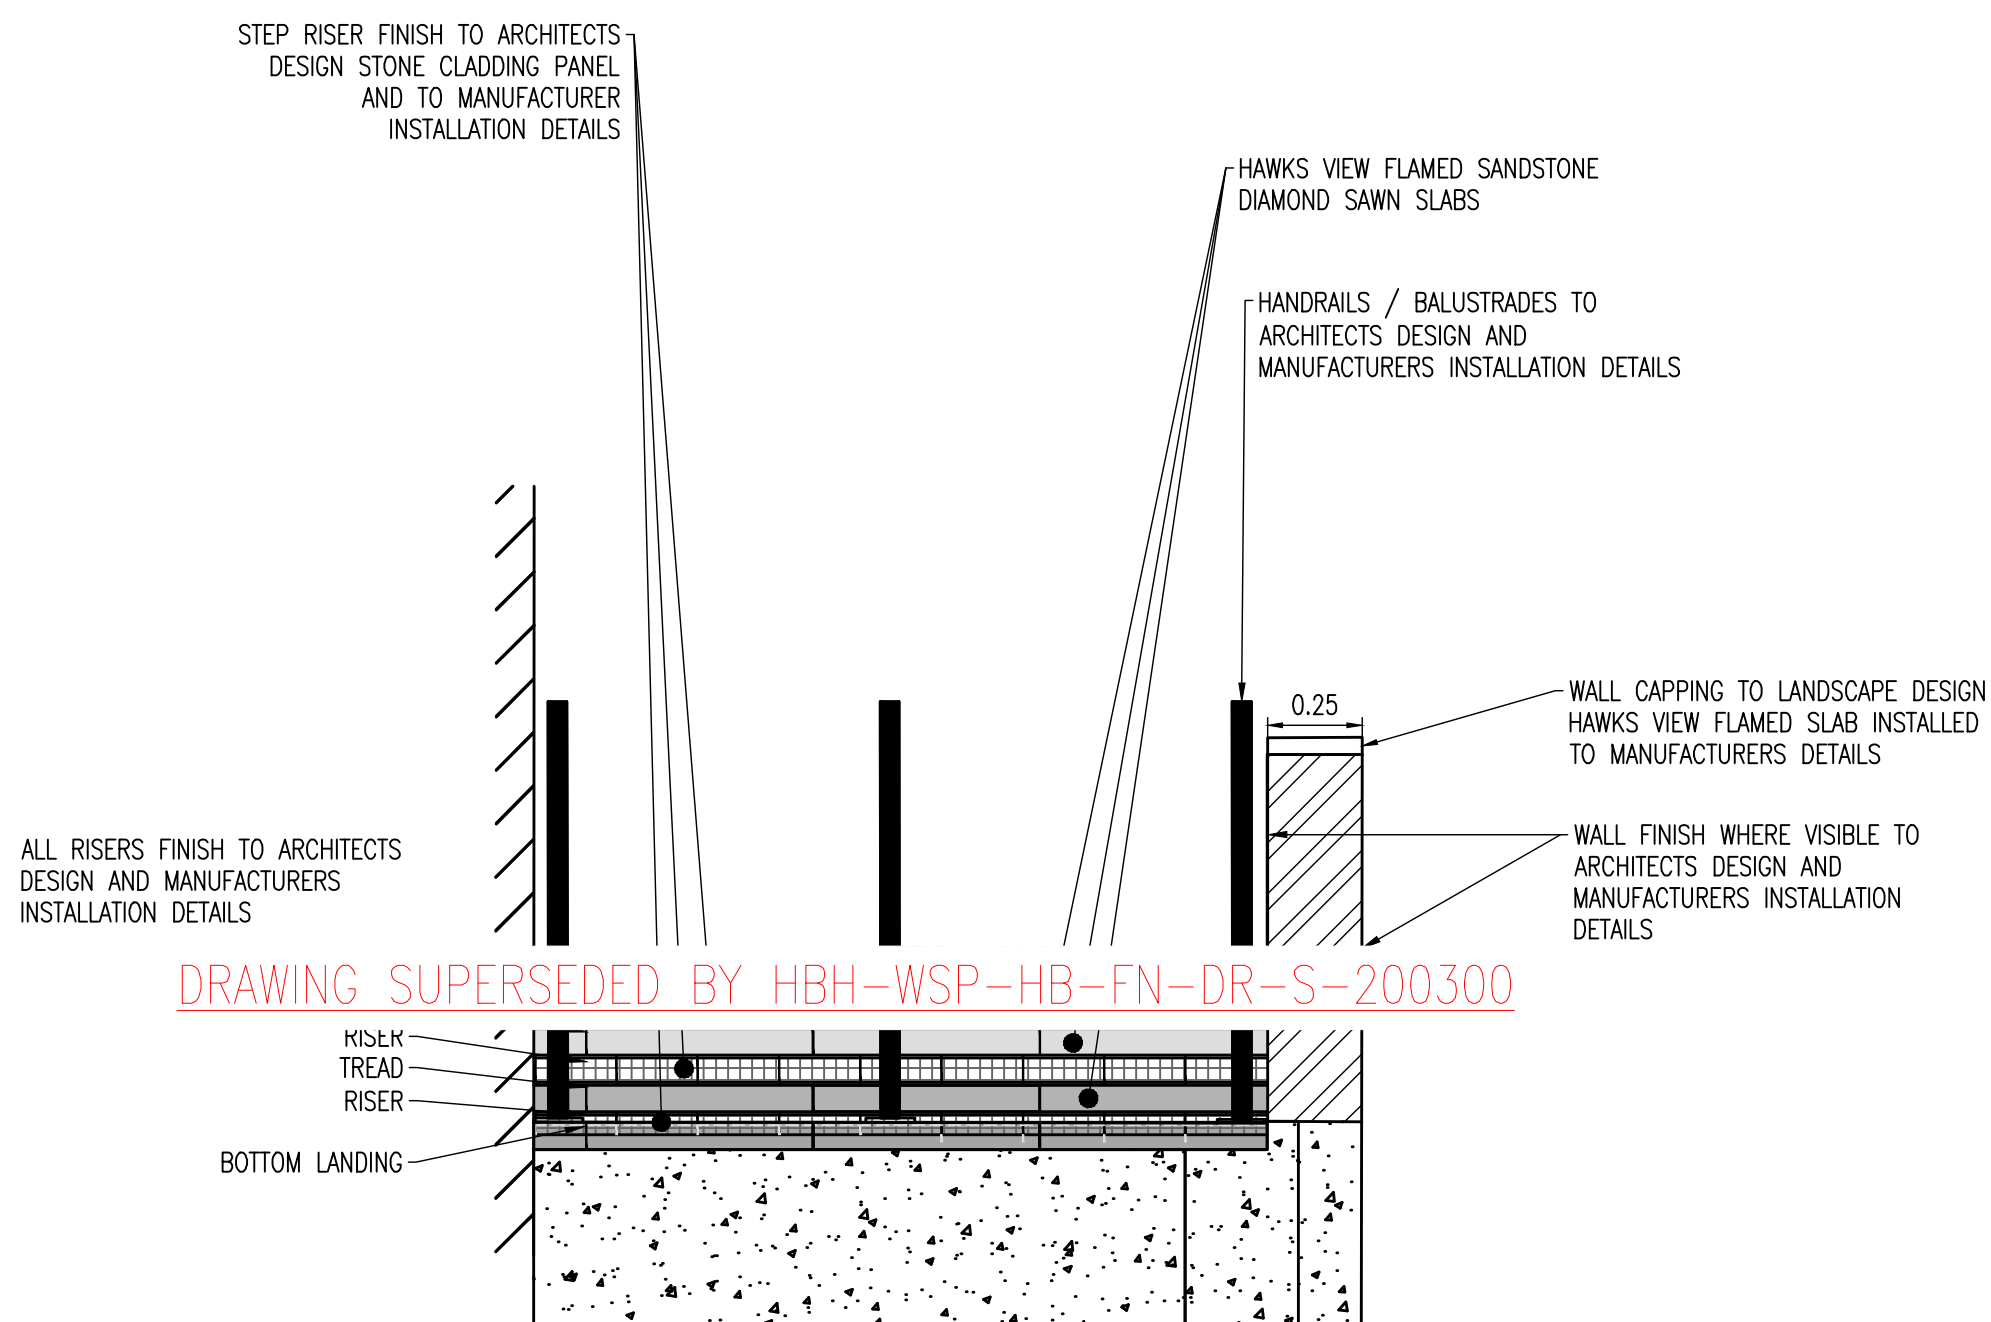



File name: \\UK\WSPGROUP\COMMON\DATA\PROJECTS\0007000700702-HECKMONDWIKE BUS HUB\03-IMP\03-CIVIL\ENGINEERING\03-DRAWINGS\TCF-WSP-KIR-HECK-DR-CH-1102.DWG, printed on 17 June 2026 12:58:18, by Cooper, Chris

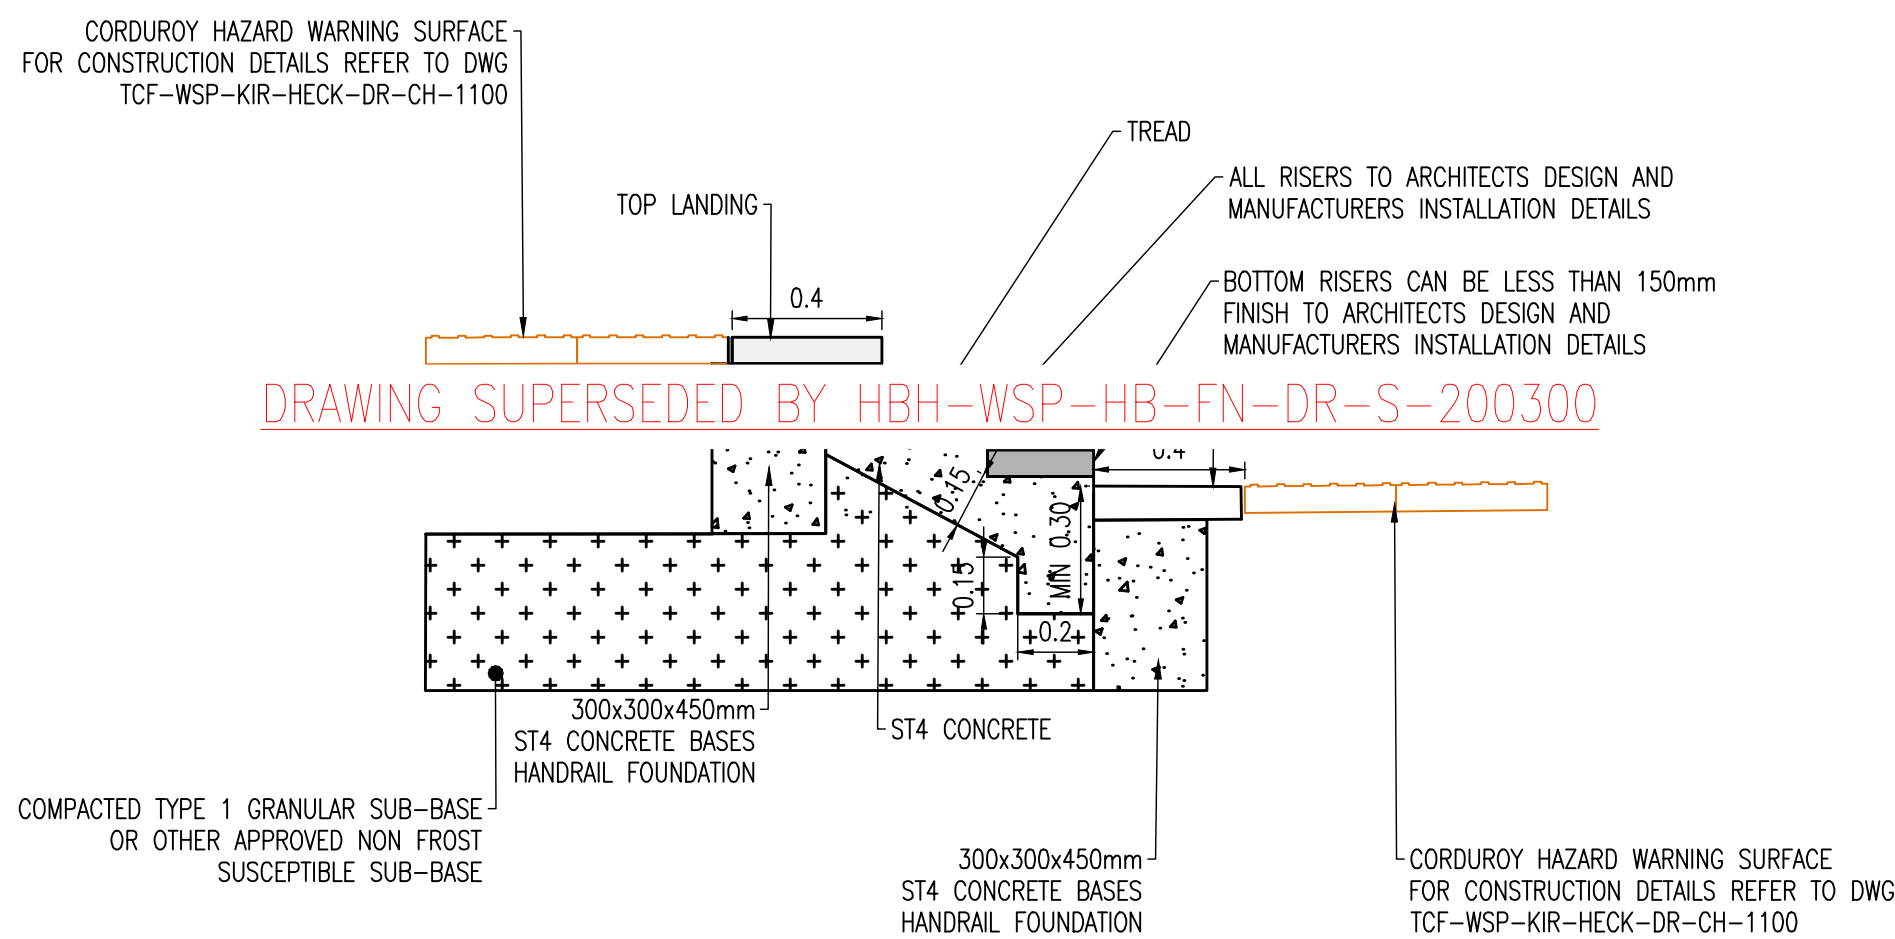

SECTION: BUS HUB STEPS DETAILS
(SCALE 1:20)

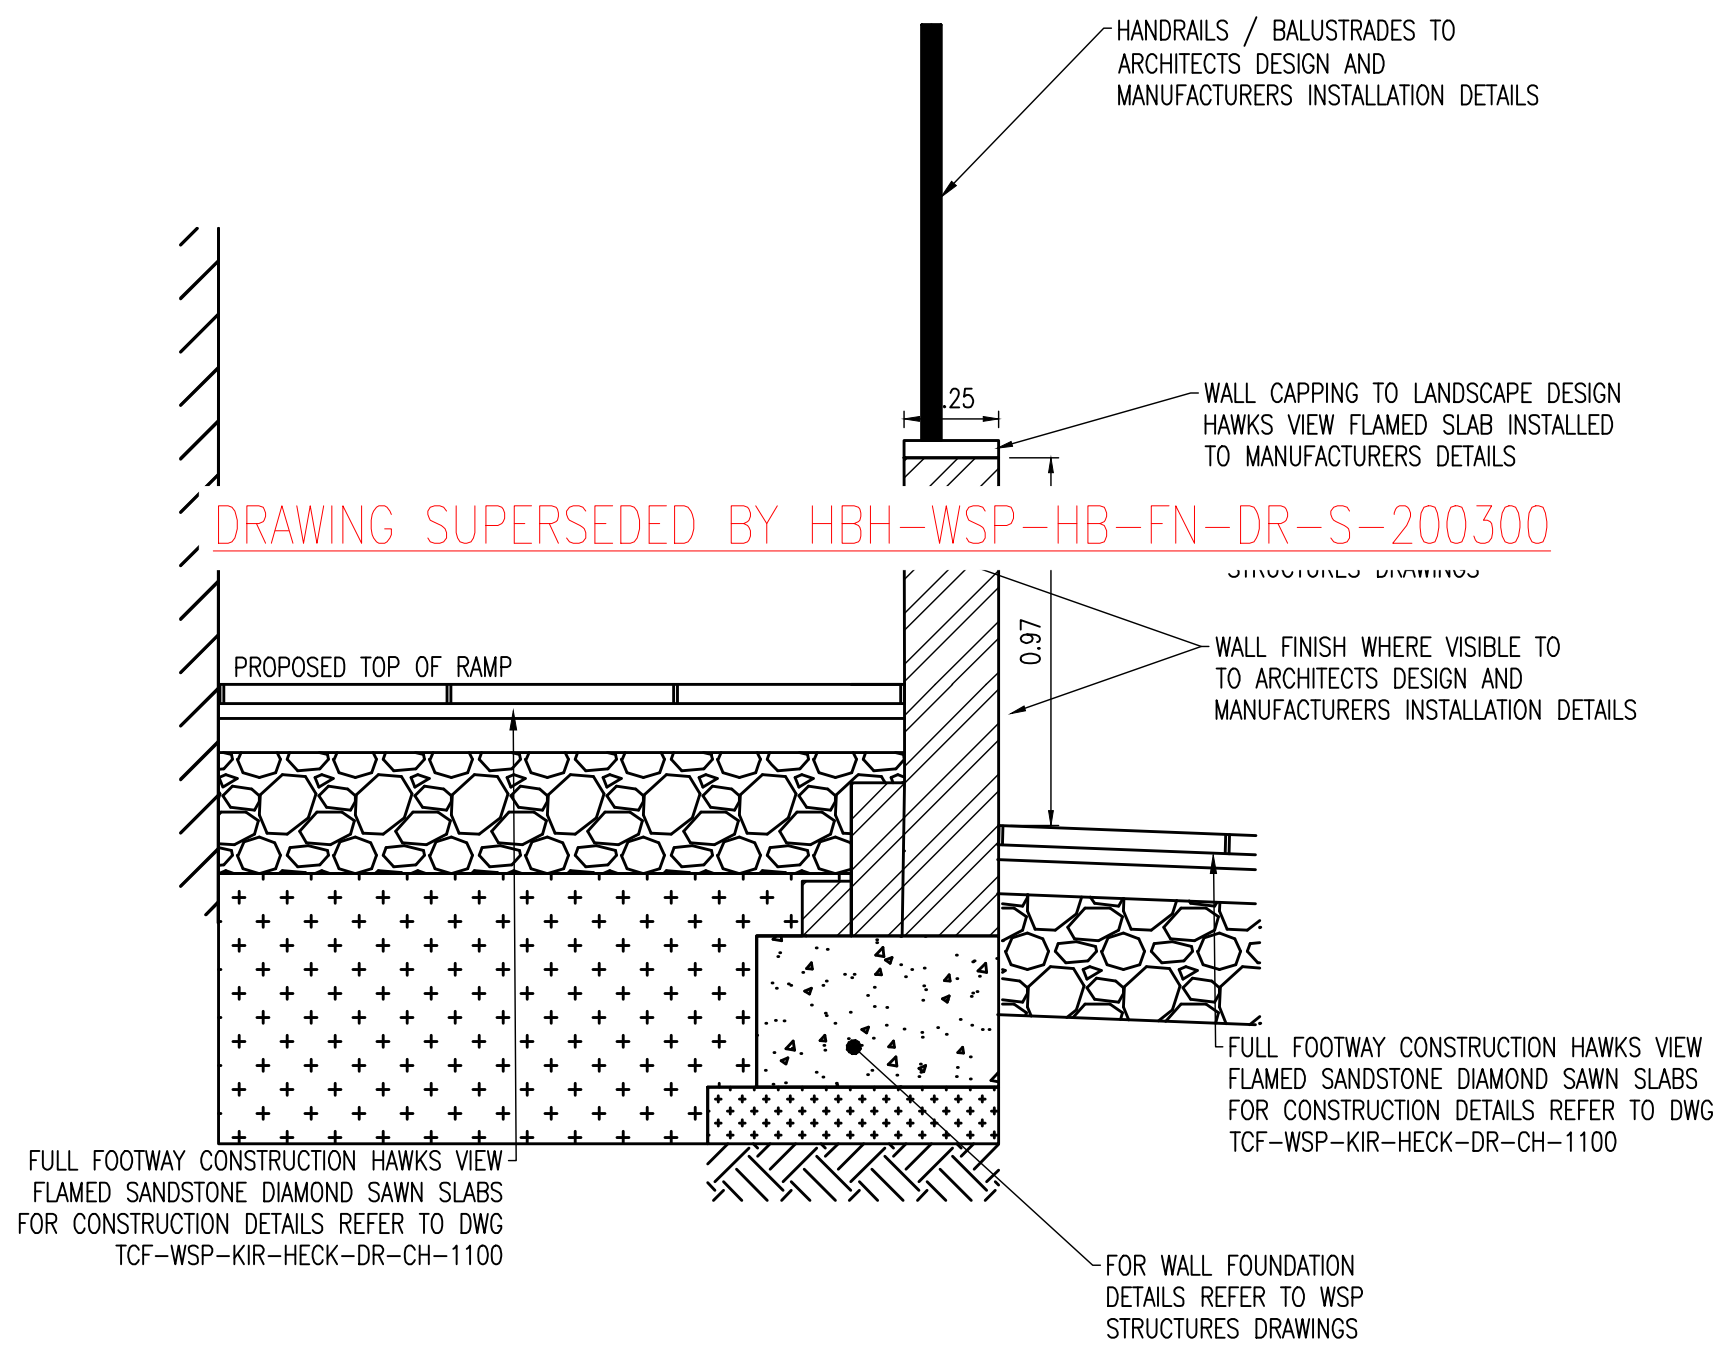

SECTION: BUS HUB RAMP
(SCALE 1:20)
UPSTAND HEIGHT IS SUBJECT TO CHANGE

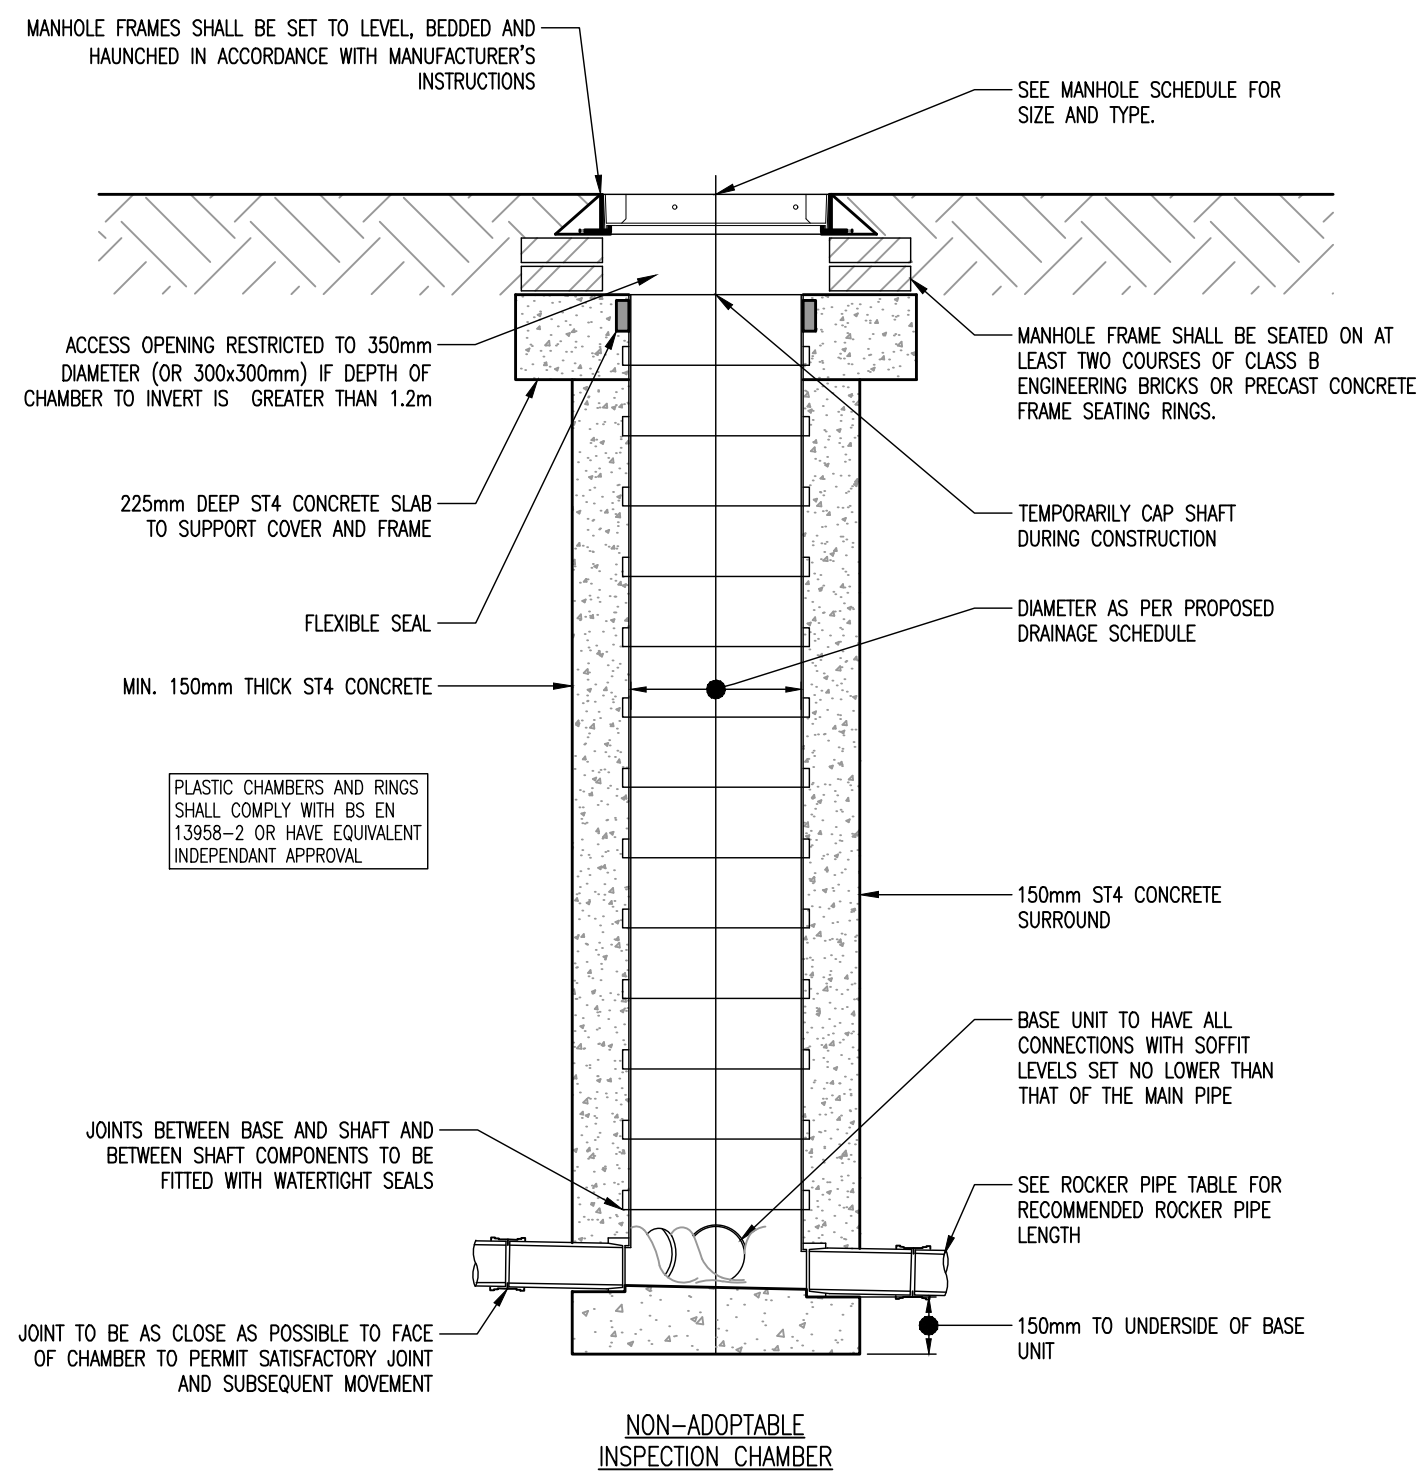

DO NOT SCALE

NOTES

- THIS DRAWING SHALL BE READ IN CONJUNCTION WITH ALL RELATED DOCUMENTATION AND STANDARD DETAILS.
- DIMENSIONS ARE IN METRES UNLESS OTHERWISE STATED.
- FOUNDATIONS TO BE KEPT DRY AT ALL TIMES
- FOR ENTRANCE RAMP AND STAIRS RETAINING WALL DETAILS REFER TO STRUCTURES DRAWING HBH-WSP-HB-FN-DR-S-200300
- FOR CYCLE STORE STAIR RETAINING WALL DETAILS REFER TO STRUCTURES DRAWING HBH-WSP-HB-FN-DR-S-200301

PLEASE NOTE: THIS DRAWING HAS BEEN ISSUED AS A RECORD OF DESIGN INFORMATION PROVIDED FOR CONSTRUCTION. IT SHOULD NOT BE RELIED UPON AS AN ACCURATE AS-BUILT RECORD OF THE COMPLETED WORKS.

CD2	17/06/2026	CC	AS DESIGNED	CS	CC
CD1	06/09/2024	CC	FIRST ISSUE	SG	SG
REV	DATE	BY	DESCRIPTION	CHK	APP

DRAWING STATUS: CR - CONSTRUCTION RECORD



3 Wellington Place, Leeds, LS1 4AP, UK
T+ 44 (0) 113 395 6200, F+ 44 (0) 113 395 6201
wsp.com

CLIENT: KIRKLEES COUNCIL

ARCHITECT: SGP

SITE/PROJECT: HECKMONDWIKE BUS STATION
RIBA4

TITLE: BUS HUB RAMP AND STEPS
CONSTRUCTION DETAILS

SCALE @ A1: #####	CHECKED: SG	APPROVED: DB
PROJECT NO: 70097732	DESIGNED: CC	DRAWN: CC
DRAWING NO: TCF-WSP-KIR-HECK-DR-CH-1102	DATE: May 26	REV: C02

© WSP UK Ltd