


File name: \\UK.WSPGROUP.COM\CENTRAL_DATA\PROJECTS\0097732-HECKMONDWIKE BS-REBA\03-MP\CV\ENGINEERING\03 DRAWINGS\TCF-WSP-KIR-HECK-DR-CH-0400.DWG, printed on 17 June 2026 12:15:11, by Cooper, Chris

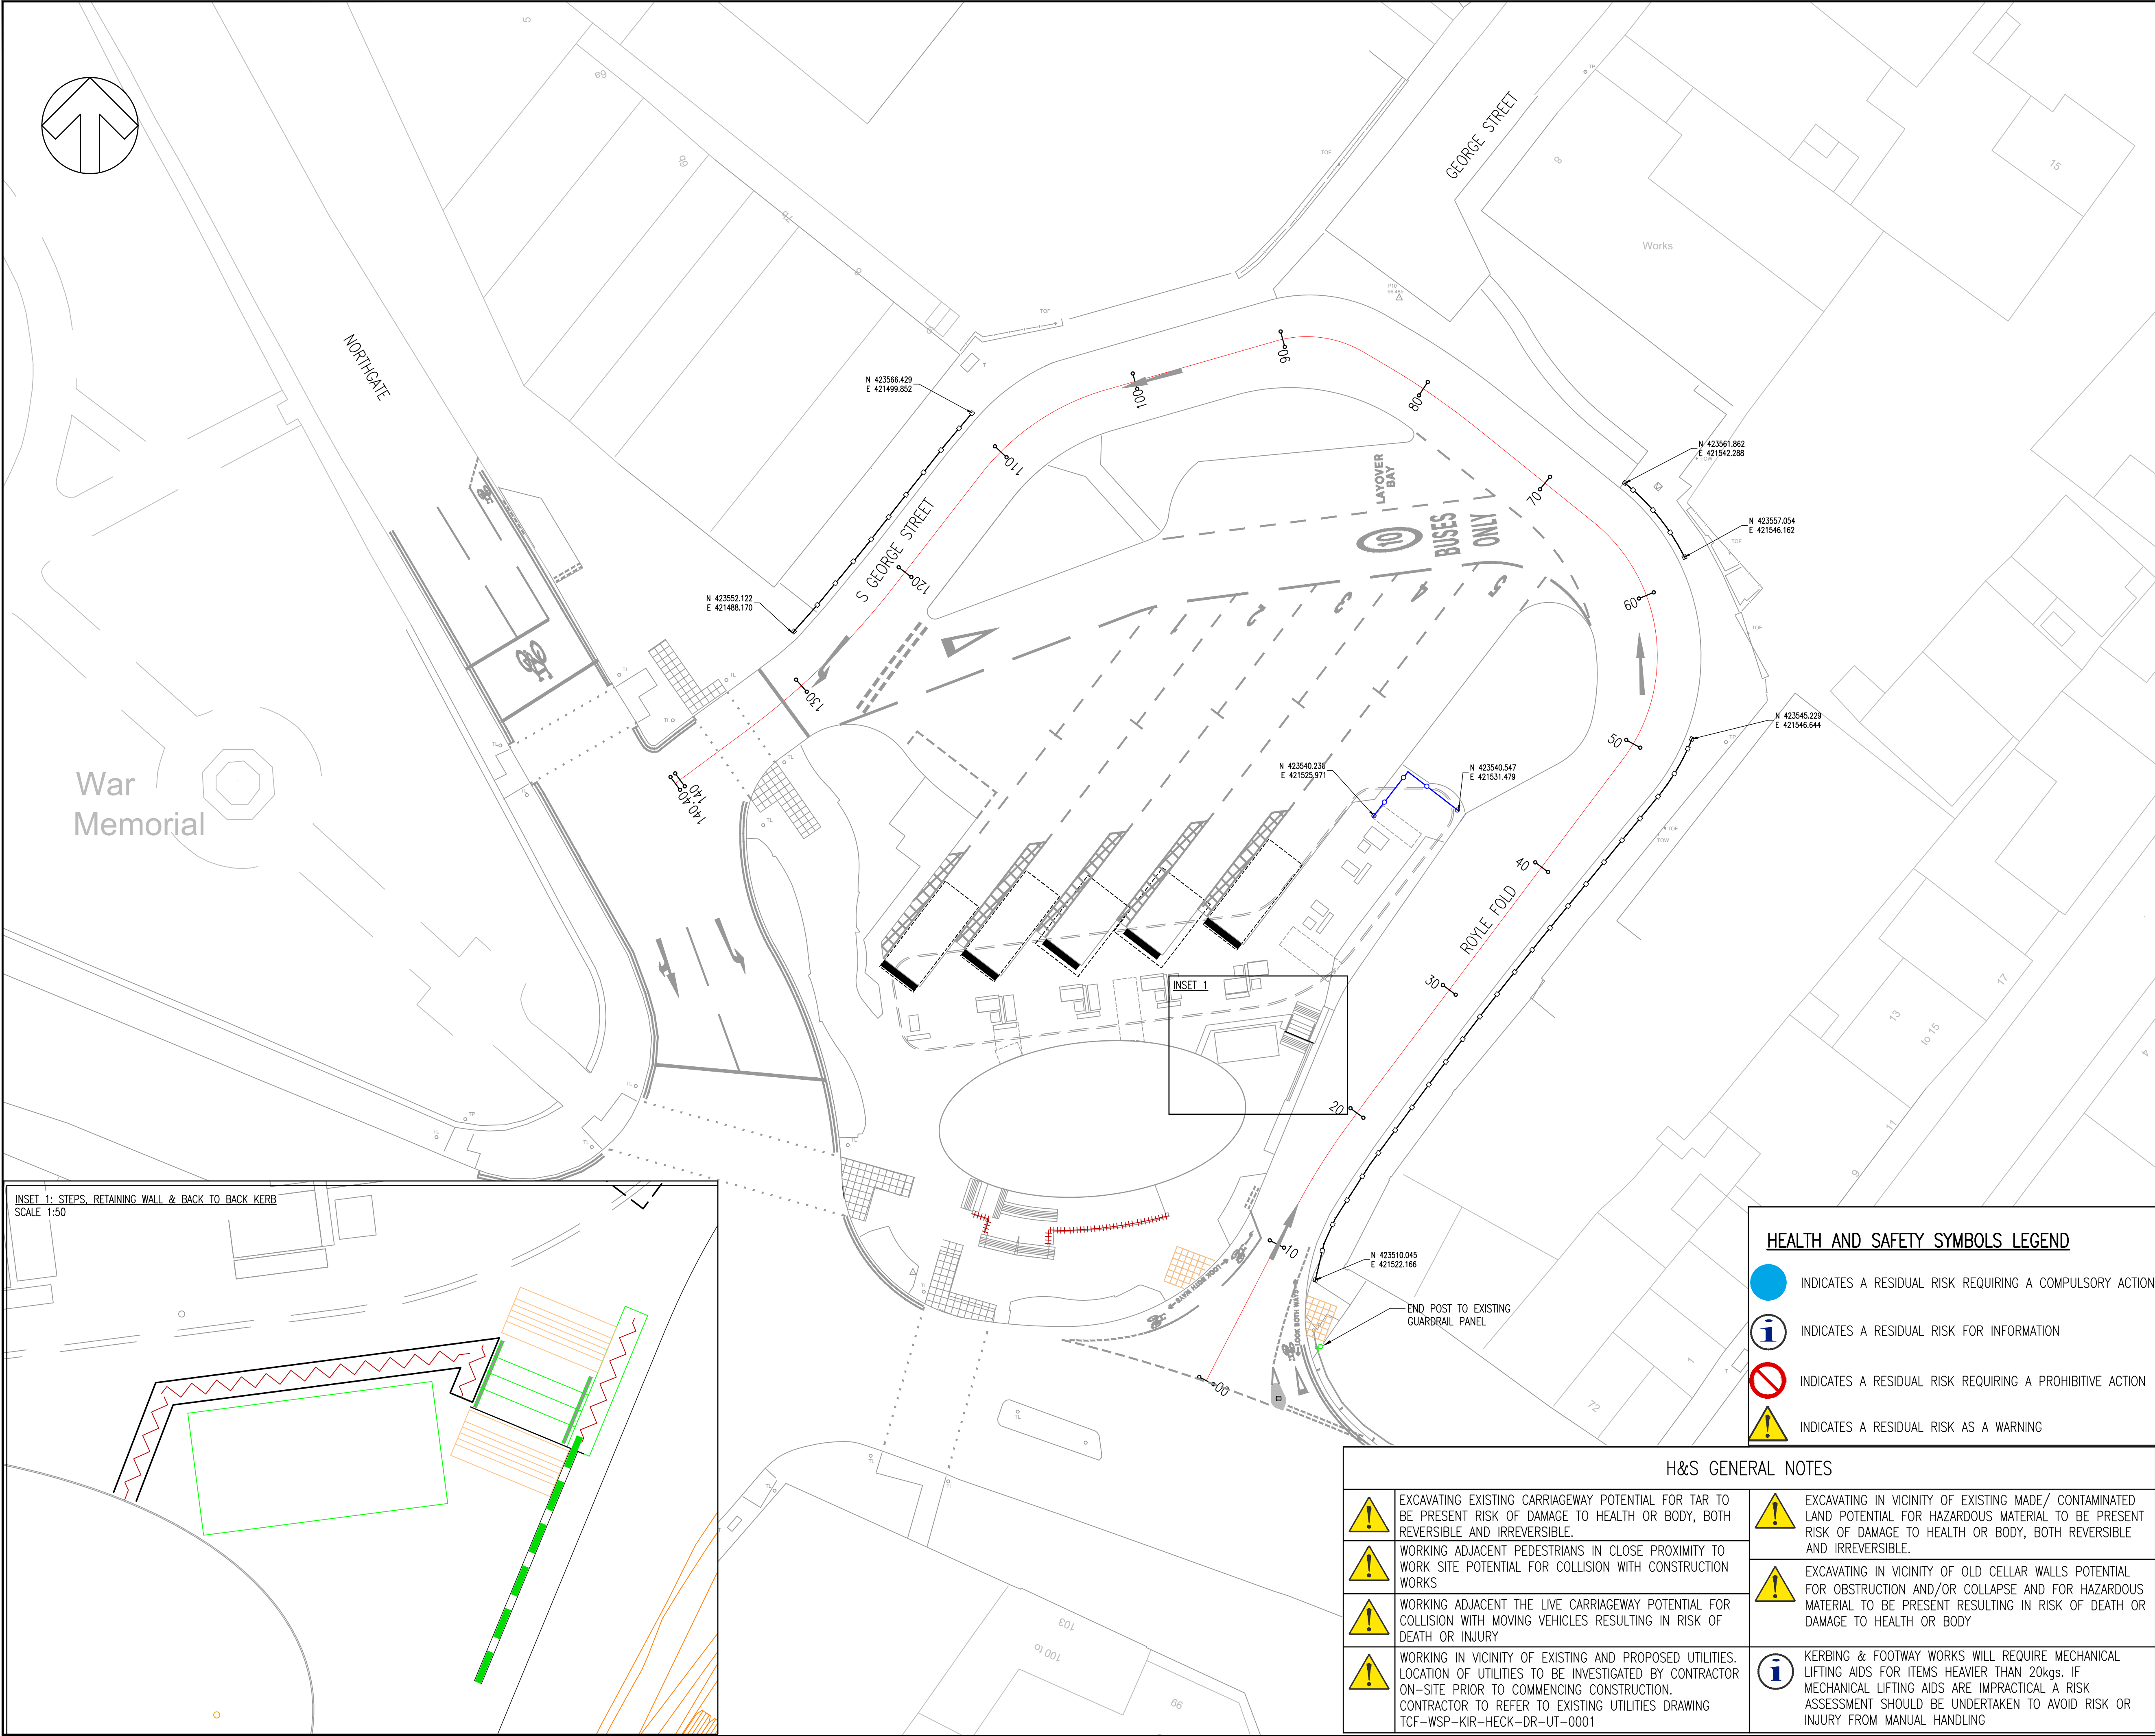

INSET 1: STEPS, RETAINING WALL & BACK TO BACK KERB
SCALE 1:50

HEALTH AND SAFETY SYMBOLS LEGEND

- INDICATES A RESIDUAL RISK REQUIRING A COMPULSORY ACTION
- INDICATES A RESIDUAL RISK FOR INFORMATION
- INDICATES A RESIDUAL RISK REQUIRING A PROHIBITIVE ACTION
- INDICATES A RESIDUAL RISK AS A WARNING

H&S GENERAL NOTES

- EXCAVATING EXISTING CARRIAGEWAY POTENTIAL FOR TAR TO BE PRESENT RISK OF DAMAGE TO HEALTH OR BODY, BOTH REVERSIBLE AND IRREVERSIBLE.
- WORKING ADJACENT PEDESTRIANS IN CLOSE PROXIMITY TO WORK SITE POTENTIAL FOR COLLISION WITH CONSTRUCTION WORKS
- WORKING ADJACENT THE LIVE CARRIAGEWAY POTENTIAL FOR COLLISION WITH MOVING VEHICLES RESULTING IN RISK OF DEATH OR INJURY
- WORKING IN VICINITY OF EXISTING AND PROPOSED UTILITIES. LOCATION OF UTILITIES TO BE INVESTIGATED BY CONTRACTOR ON-SITE PRIOR TO COMMENCING CONSTRUCTION. CONTRACTOR TO REFER TO EXISTING UTILITIES DRAWING TCF-WSP-KIR-HECK-DR-UT-0001
- EXCAVATING IN VICINITY OF EXISTING MADE/ CONTAMINATED LAND POTENTIAL FOR HAZARDOUS MATERIAL TO BE PRESENT RISK OF DAMAGE TO HEALTH OR BODY, BOTH REVERSIBLE AND IRREVERSIBLE.
- EXCAVATING IN VICINITY OF OLD CELLAR WALLS POTENTIAL FOR OBSTRUCTION AND/OR COLLAPSE AND FOR HAZARDOUS MATERIAL TO BE PRESENT RESULTING IN RISK OF DEATH OR DAMAGE TO HEALTH OR BODY
- KERBING & FOOTWAY WORKS WILL REQUIRE MECHANICAL LIFTING AIDS FOR ITEMS HEAVIER THAN 20kgs. IF MECHANICAL LIFTING AIDS ARE IMPRACTICAL A RISK ASSESSMENT SHOULD BE UNDERTAKEN TO AVOID RISK OR INJURY FROM MANUAL HANDLING

DO NOT SCALE

NOTES

- DIMENSIONS ARE IN METRES UNLESS OTHERWISE STATED.
- THIS DRAWING IS TO BE READ IN CONJUNCTION WITH ALL RELEVANT SCHEME DRAWINGS AND SPECIFICATIONS.
- THIS DRAWING IS NOT TO BE REPRODUCED IN ANY PART OR FORM WITHOUT CONSENT OF WSP. ALL COPYRIGHT RESERVED.
- DO NOT SCALE. IF IN DOUBT CONTACT WSP.
- SERVICES ARE PRESENT IN THIS AREA. THE CONTRACTOR SHALL ESTABLISH THE LINE AND LEVEL OF EXISTING SERVICES PRIOR TO COMMENCING ANY EXCAVATION WORKS.
- THE LOCATION AND DEPTHS OF ALL EXISTING SERVICE APPARATUS SHOULD BE CONFIRMED WITH THE SERVICE AUTHORITIES PRIOR TO ANY EXCAVATION WORKS TAKING PLACE.
- THE CONTRACTOR SHALL CONDUCT THE WORKS WITH DUE REGARD TO THE ECOLOGICAL, ENVIRONMENTAL REQUIREMENTS OF THE SCHEME.
- DECORATIVE PEDESTRIAN GUARDRAIL PROVIDED BY ALPHA RAIL LTD AND INSTALLED TO MANUFACTURERS INSTRUCTIONS.

KEY:

- PROPOSED ALPHA RAIL DECORATIVE PEDESTRIAN GUARDRAIL (D61111) INSTALLED TO MANUFACTURERS INSTRUCTIONS
- PROPOSED RETAINING WALL DETAILS REFER TO WSP STRUCTURES DWG HBH-WSP-HB-XX-DR-S-249702 FOR WALL FINISHING DETAILS REFER TO LANDSCAPE DWG TCF-WSP-KHBH-XXX-DR-LE-000001 AND SGP DWG 20233-03-HEK-XX-DR-A-390100
- PROPOSED RETAINING WALL DETAILS REFER TO WSP STRUCTURES DWG HBH-WSP-HB-FN-DR-S-249701 FOR WALL FINISHING DETAILS REFER TO LANDSCAPE DWG TCF-WSP-KHBH-XXX-DR-LE-000001 AND SGP DWG 20233-03-HEK-XX-DR-A-390101
- PROPOSED BACK TO BACK KERB FOR CONSTRUCTION DETAILS REFER TO DWG TCF-WSP-KIR-HECK-DR-CH-0701
- PROPOSED END POST TO EXISTING GUARDRAIL PANEL

PLEASE NOTE: THIS DRAWING HAS BEEN ISSUED AS A RECORD OF DESIGN INFORMATION PROVIDED FOR CONSTRUCTION. IT SHOULD NOT BE RELIED UPON AS AN ACCURATE AS-BUILT RECORD OF THE COMPLETED WORKS.

CD4	17/06/2026	CHK	AS DESIGNED	CS	CC
CD3	19/01/2026	CC	REMOVAL OF LANDSCAPE WALL. CE108 REVISED KERB ALIGNMENT TO NORTHGATE. CE072 REALIGNMENT OF ROYLE FOLD KERB & PEDESTRIAN GUARDRAIL. CE108 REVISED ALIGNMENT OF WESTGATE KERB & LANDSCAPING. REVISION TO KEY. BUS HUB - REALIGNMENT OF PEDESTRIAN GUARDRAIL. ADDITIONAL NOTE #8 BUS BAY KERB REALIGNED FOR DRO BARRIER CE-111 PEDESTRIAN GUARDRAIL MATERIAL CHANGE FROM KC STANDARD GUARDRAIL TO ALPHA DECORATIVE GUARDRAIL - ROYLE FOLD & S GEORGE ST. PEDESTRIAN GUARDRAIL START AND END COORDINATES	CS	CC
CD2	05/02/2025	CC	NOTES ADDED TO DRAWING. AMENDMENT TO LANDSCAPE WALL	DPL	CC
CD1	06/09/2024	CC	FIRST ISSUE	SG	SG
REV	DATE	BY	DESCRIPTION	CHK	APP

DRAWING STATUS: CR - CONSTRUCTION RECORD

3 Wellington Place, Leeds, LS1 4AP, UK
T+ 44 (0) 113 395 6200, F+ 44 (0) 113 395 6201
wsp.com

CLIENT: KIRKLEES COUNCIL

ARCHITECT: SGP

SITE/PROJECT: HECKMONDWIKE BUS STATION
RIBA4

TITLE: PEDESTRIAN RESTRAINT SYSTEMS,
RETAINING WALL AND STEPS

SCALE @ A1: 1:200

CHECKED: SG

APPROVED: DB

PROJECT NO: 70097732

DESIGNED: CC

DRAWN: CC

DATE: June 26

DRAWING NO: TCF-WSP-KIR-HECK-DR-CH-0400

REV: C04

© WSP UK Ltd