


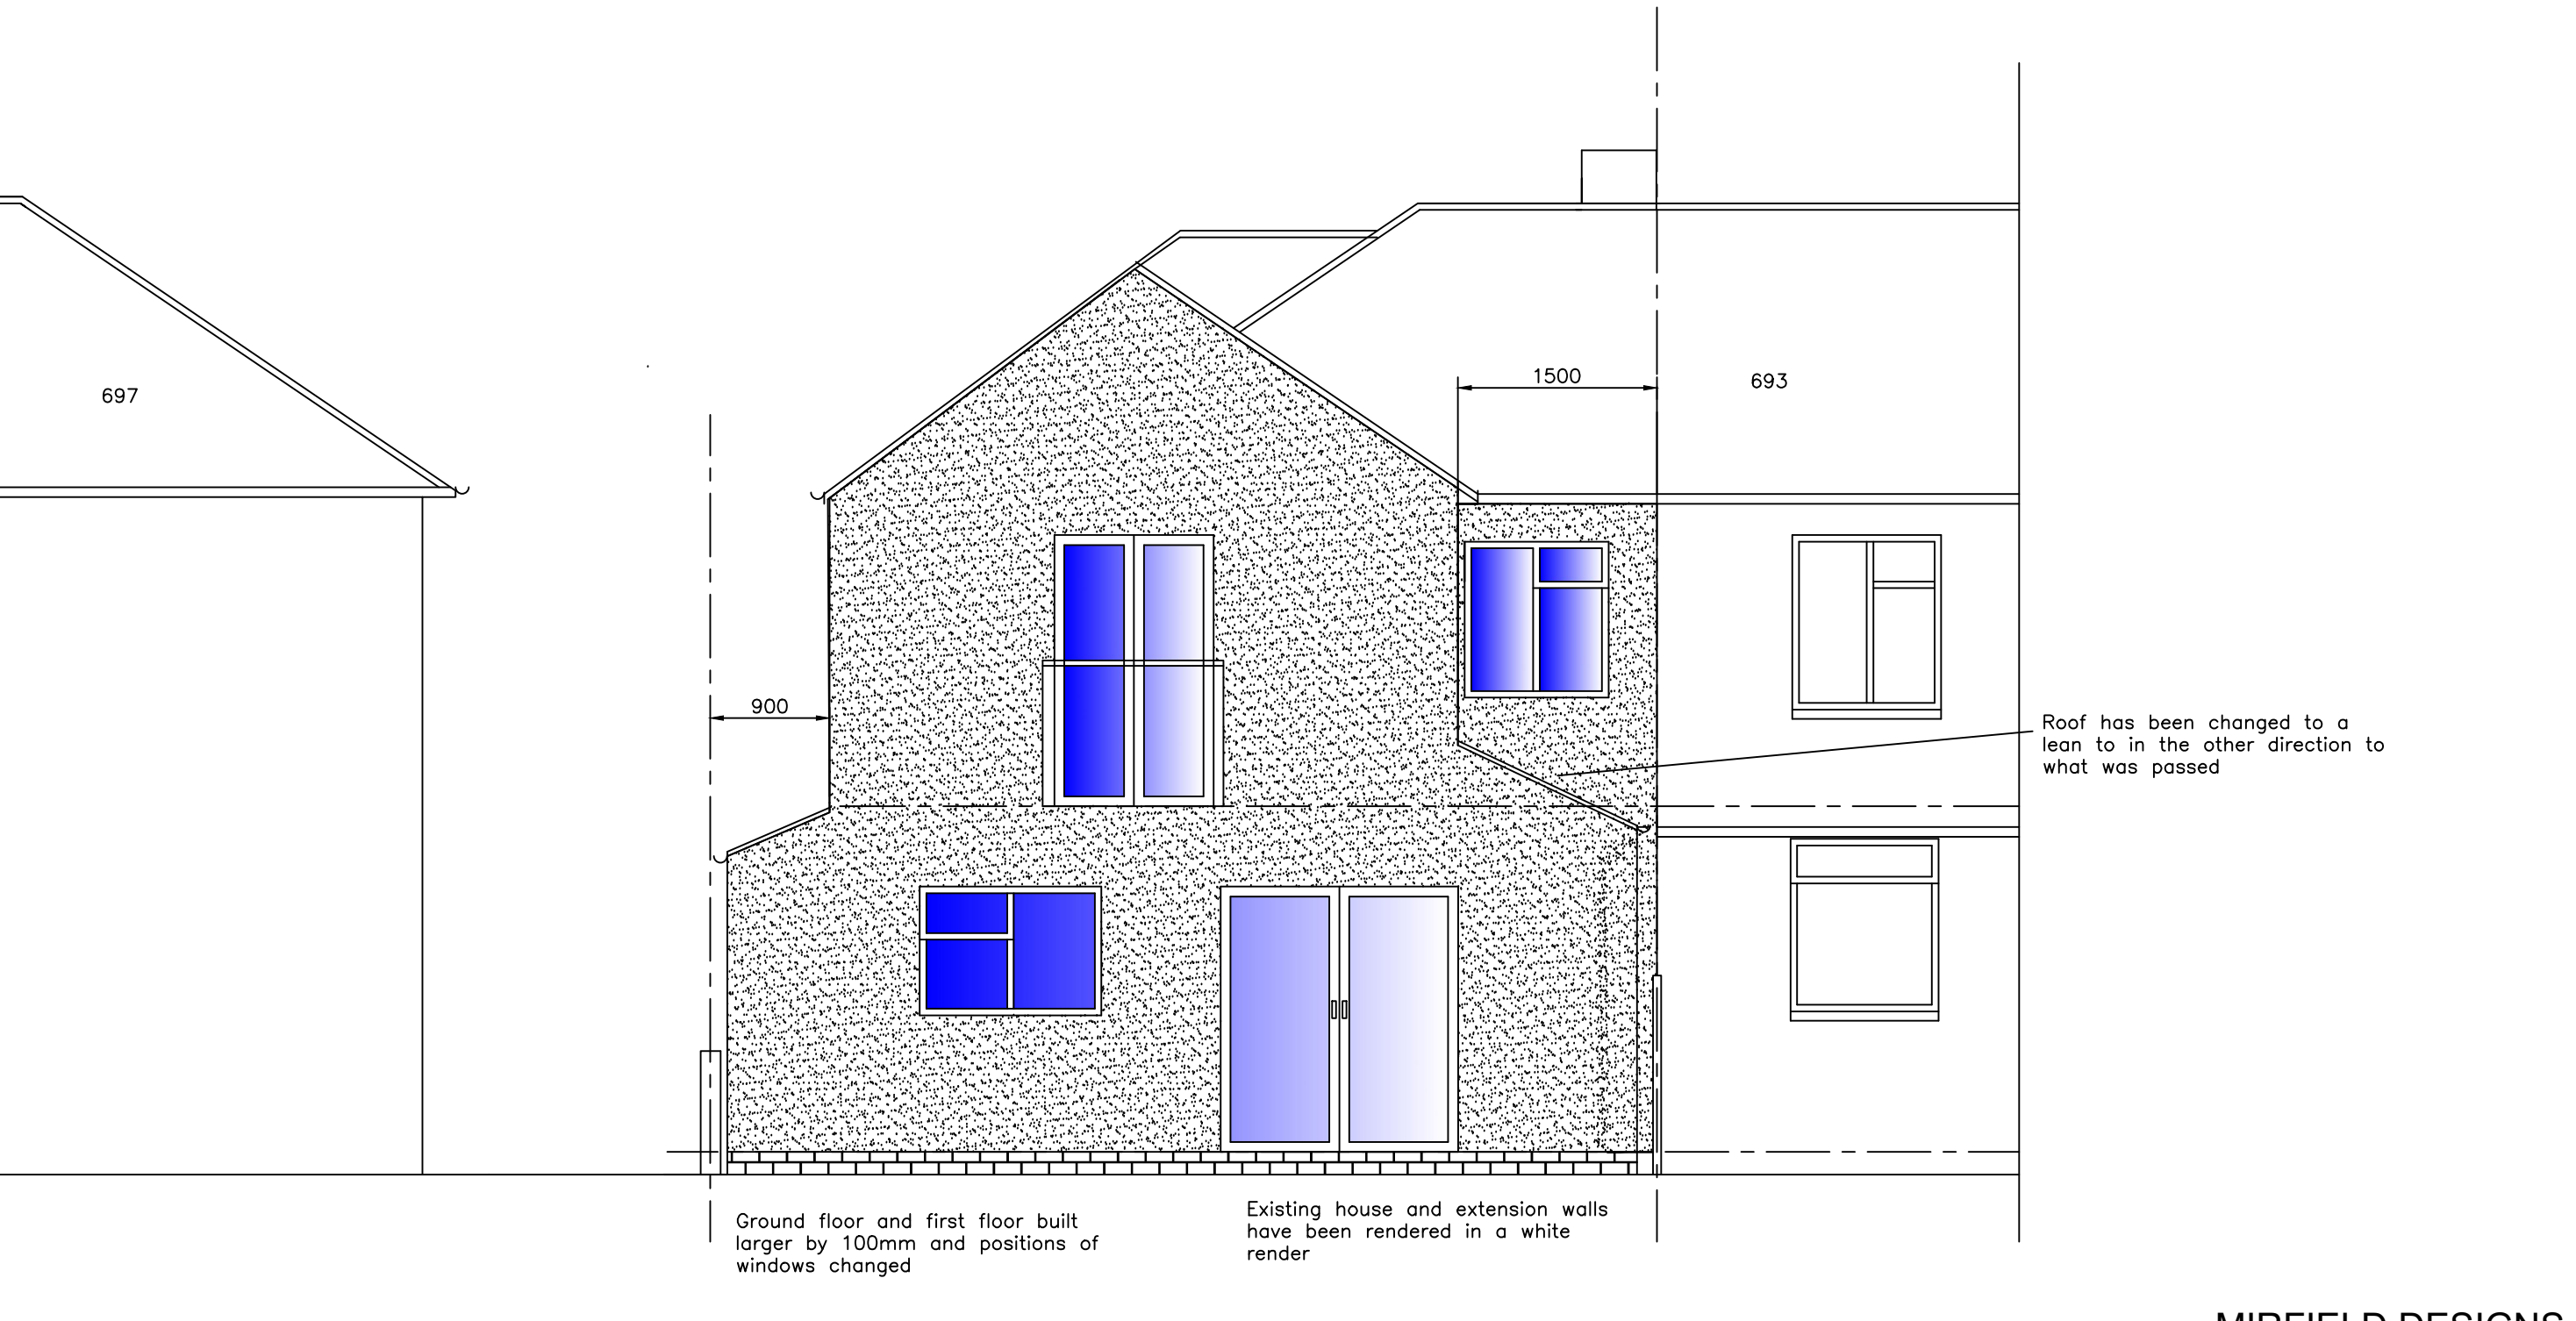

Existing Rear Elevation as built -  
South 1:50

**MIRFIELD DESIGNS**  
Planning & Building Control Service

Tel: 07877959728  
Email: mirfielddesigns@gmail.com

|                 |    |                                     |           |
|-----------------|----|-------------------------------------|-----------|
| Client          |    | Mr & Mrs Monga                      |           |
| Job             |    | 695 Leeds Road<br>Huddersfield      |           |
| Title           |    | Existing Rear Elevation<br>as built |           |
| Drawn By        | RK | Date                                | Sept 2026 |
| Eng. Check      |    | Scale                               | 1:50      |
| Tech. Check     |    |                                     |           |
| Drawing No.     |    | Rev.                                |           |
| 2025 / 486 / 03 |    |                                     |           |